
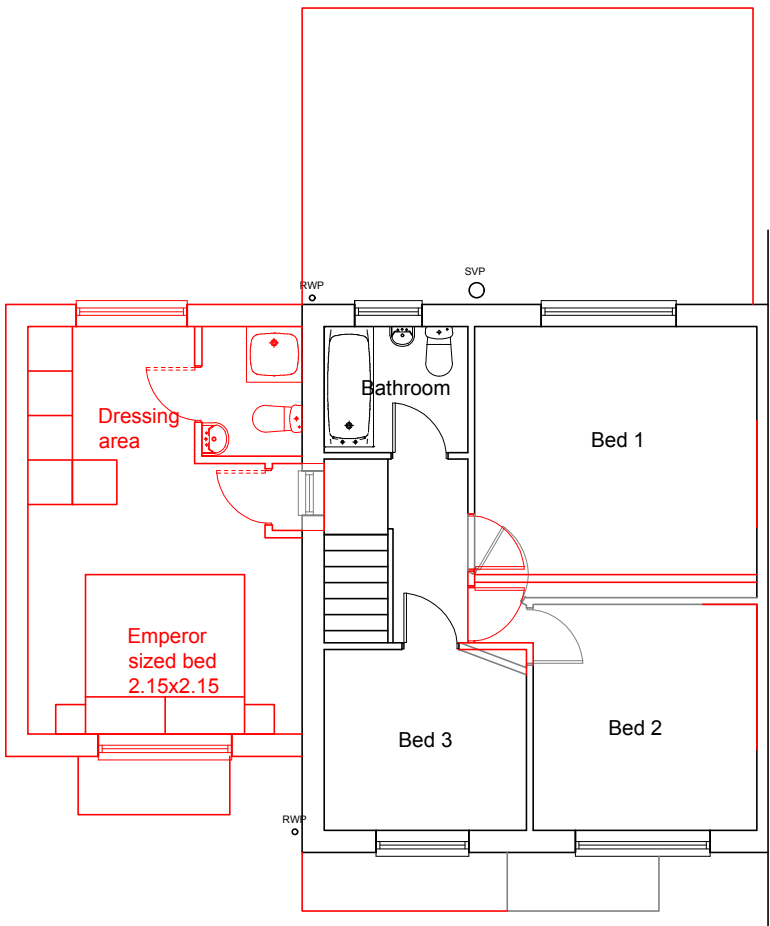


GROUND FLOOR

FIRST FLOOR

PROPOSED WORK
SHOWN IN RED

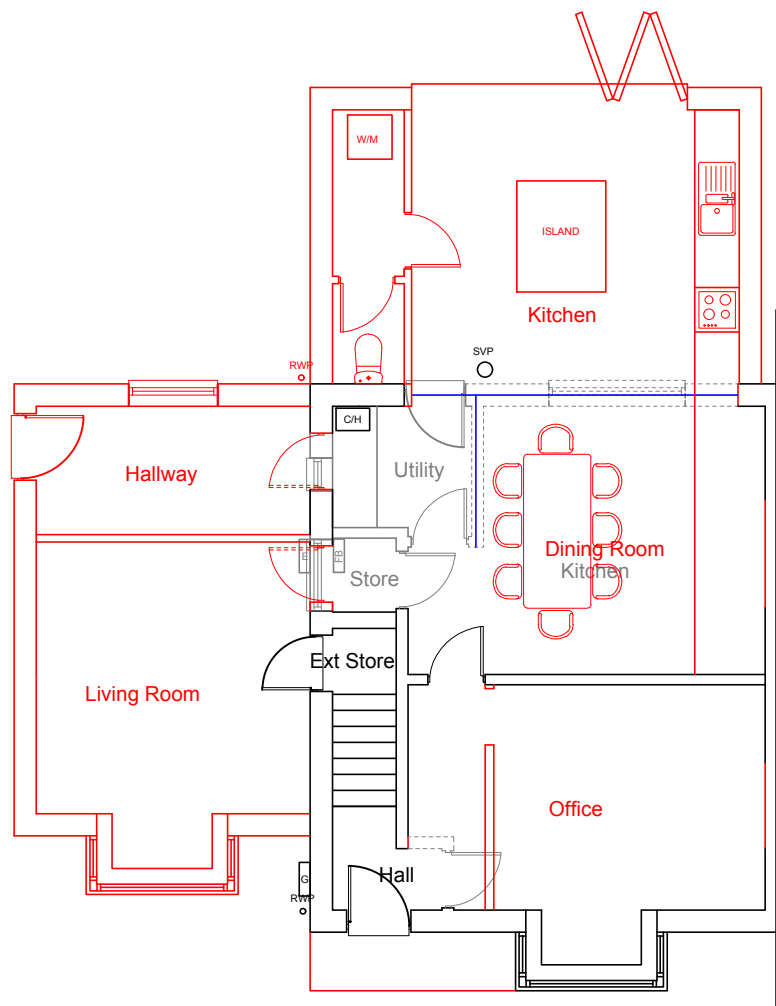

<u>Address</u> 21 Gray Street, Elsecar, S74 8JR		<u>O.S.Ref</u> se3800	<u>Date</u> Aug 22
<u>Scale</u> 1:100 @A3		<u>Drawn By</u> TE	<u>Plan No.</u> 0147-5d

PROPOSED FLOORPLANS