



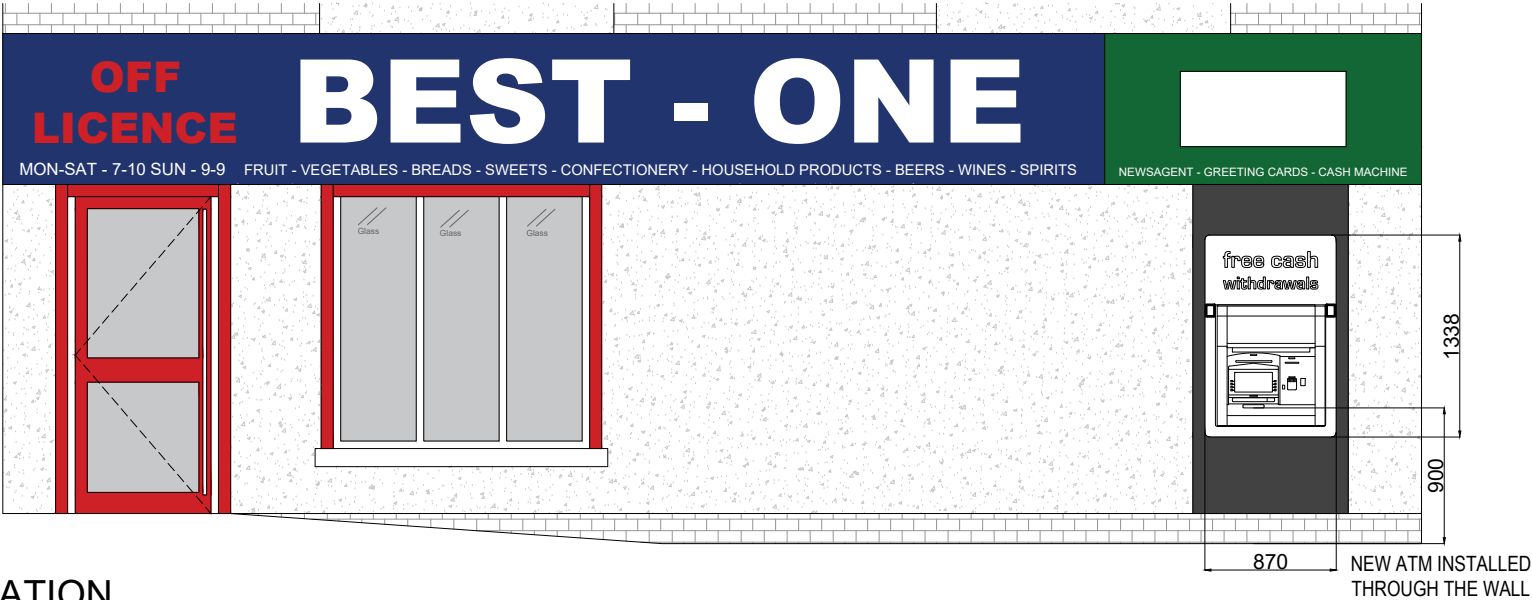

AS-INSTALLED FRONT ELEVATION
Scale 1:50

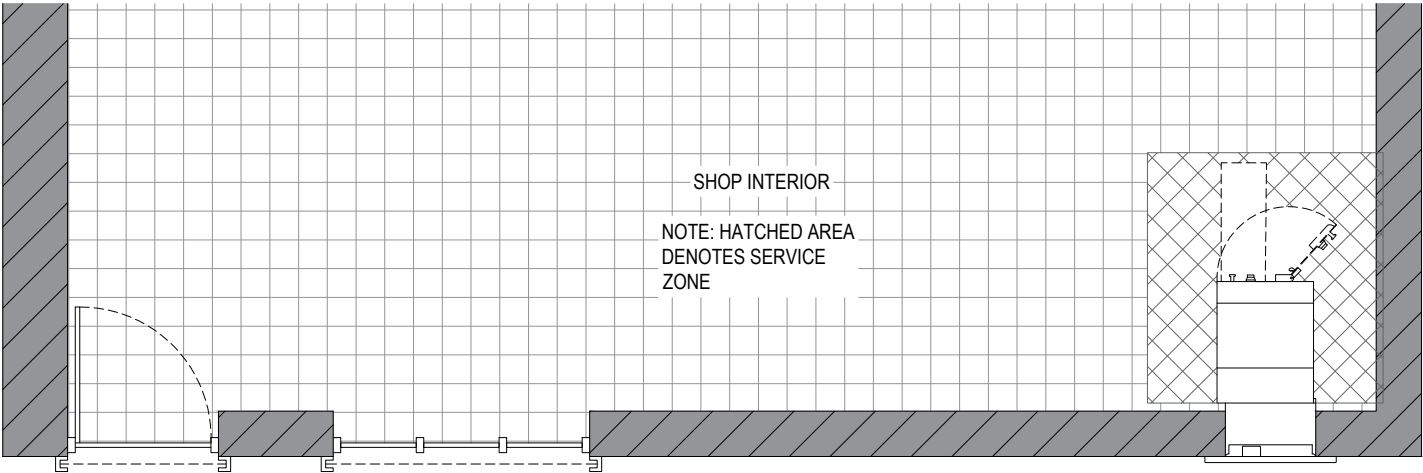

AS-INSTALLED PART PLAN
Scale 1:50

Date: Comments: By:

GENERAL NOTES:
1) All dimensions in millimeters unless otherwise stated.

Site:
Best One,
343-345 Pontefract Road,
Barnsley,
S71 5HS

Drawing Title:
As-Installed Plan and Elevation

Ref: T019293_AI	Date: 23/08/2019	Rev:
Scale: 1:50	Paper: A3	Date Rev: