


KEY PLAN



Notes:

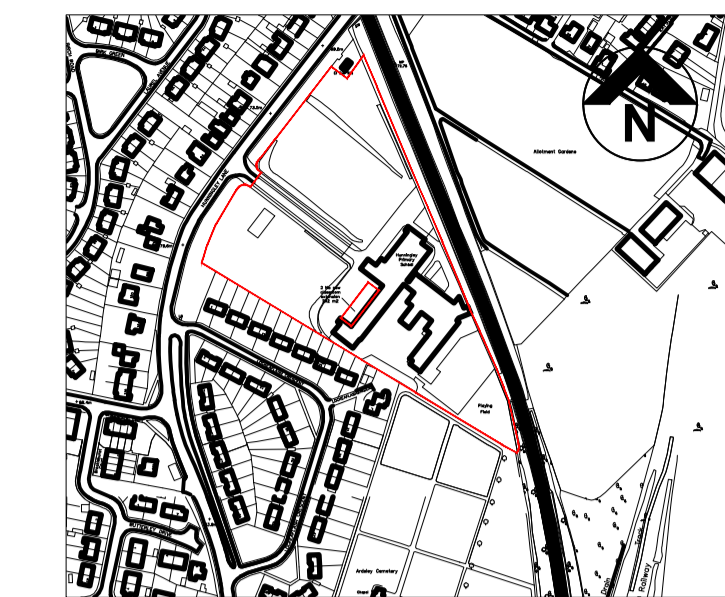

Block Plan @ 1:500

As Built					
C2	SBL	07.09.15			
Contract Issue					
C1	SBL	09.07.15			
COMMENT					
REV	DRAWN	DATE	CHECKED	DATE	APPROVED

THIS DRAWING IS PRODUCED FOR USE IN THIS PROJECT ONLY AND MAY NOT BE USED FOR ANY OTHER PURPOSE. NPS PROPERTY CONSULTANTS LTD ACCEPT NO LIABILITY FOR THE USE OF THIS DRAWING OTHER THAN THE PURPOSE FOR WHICH IT WAS INTENDED IN CONNECTION WITH THIS PROJECT AS RECORDED IN THE PURPOSE FOR ISSUE AND FILE STATUS CODE.

THIS DRAWING MAY NOT BE REPRODUCED IN ANY FORM WITHOUT PRIOR WRITTEN AGREEMENT OF NPS PROPERTY CONSULTANTS LTD.

© CROWN COPYRIGHT AND DATABASE RIGHTS 2016 ORDNANCE SURVEY LICENCE NUMBER 100022264

RESPONSIBILITY IS NOT ACCEPTED FOR OTHERS SCALING DIRECTLY FROM THIS DRAWING. DO NOT SCALE FROM THIS DRAWING. USE WRITTEN DIMENSIONS ONLY.

0m 12 25 37.5 75m ORIGINAL SHEET SIZE **A1**

1:1250

CLIENT
Education

TITLE
Block plan

PROJECT
Proposed 2 no classrooms and internal alterations

STATUS CODE
D2

PURPOSE OF ISSUE
TENDER

DRAWN BY
Phepp

	SCALES 1:500	DISCIPLINE ARCHITECT	PROJECT NUMBER 17-1-1051
	DRAWING NUMBER NPS-DR-A-(00)-016		REV CODE P 1
STATUS CODE D2		PURPOSE OF ISSUE TENDER	DRAWN BY Phepp