





NOTES


- \* DEPTH FROM U/SIDE OF SKID TO F.F.L. = 338mm
- \* EXTERNAL DECORATION SITE APPLIED RED BRICK SLIPS ON 25mm SYROFOAM BACKING
- \* TIMLOC AIRBRICKS OR SIMILAR TO PROVIDE 6500mm<sup>2</sup> AIRFLOW PER BRICK TO POSITIONS AS SHOWN ON ELEVATIONS. WIDTHS TO BE 2025mm MAX. BETWEEN CENTRES (WHERE POSSIBLE) HEIGHTS TO BE 150mm MIN. - 215mm MAX. TO CENTRE
- \* ALL FLIGHTS 1000mm WIDE (UNOBSTRUCTED)
- \* PLEASE NOTE ALL HEIGHTS ARE INDICATIVE ONLY

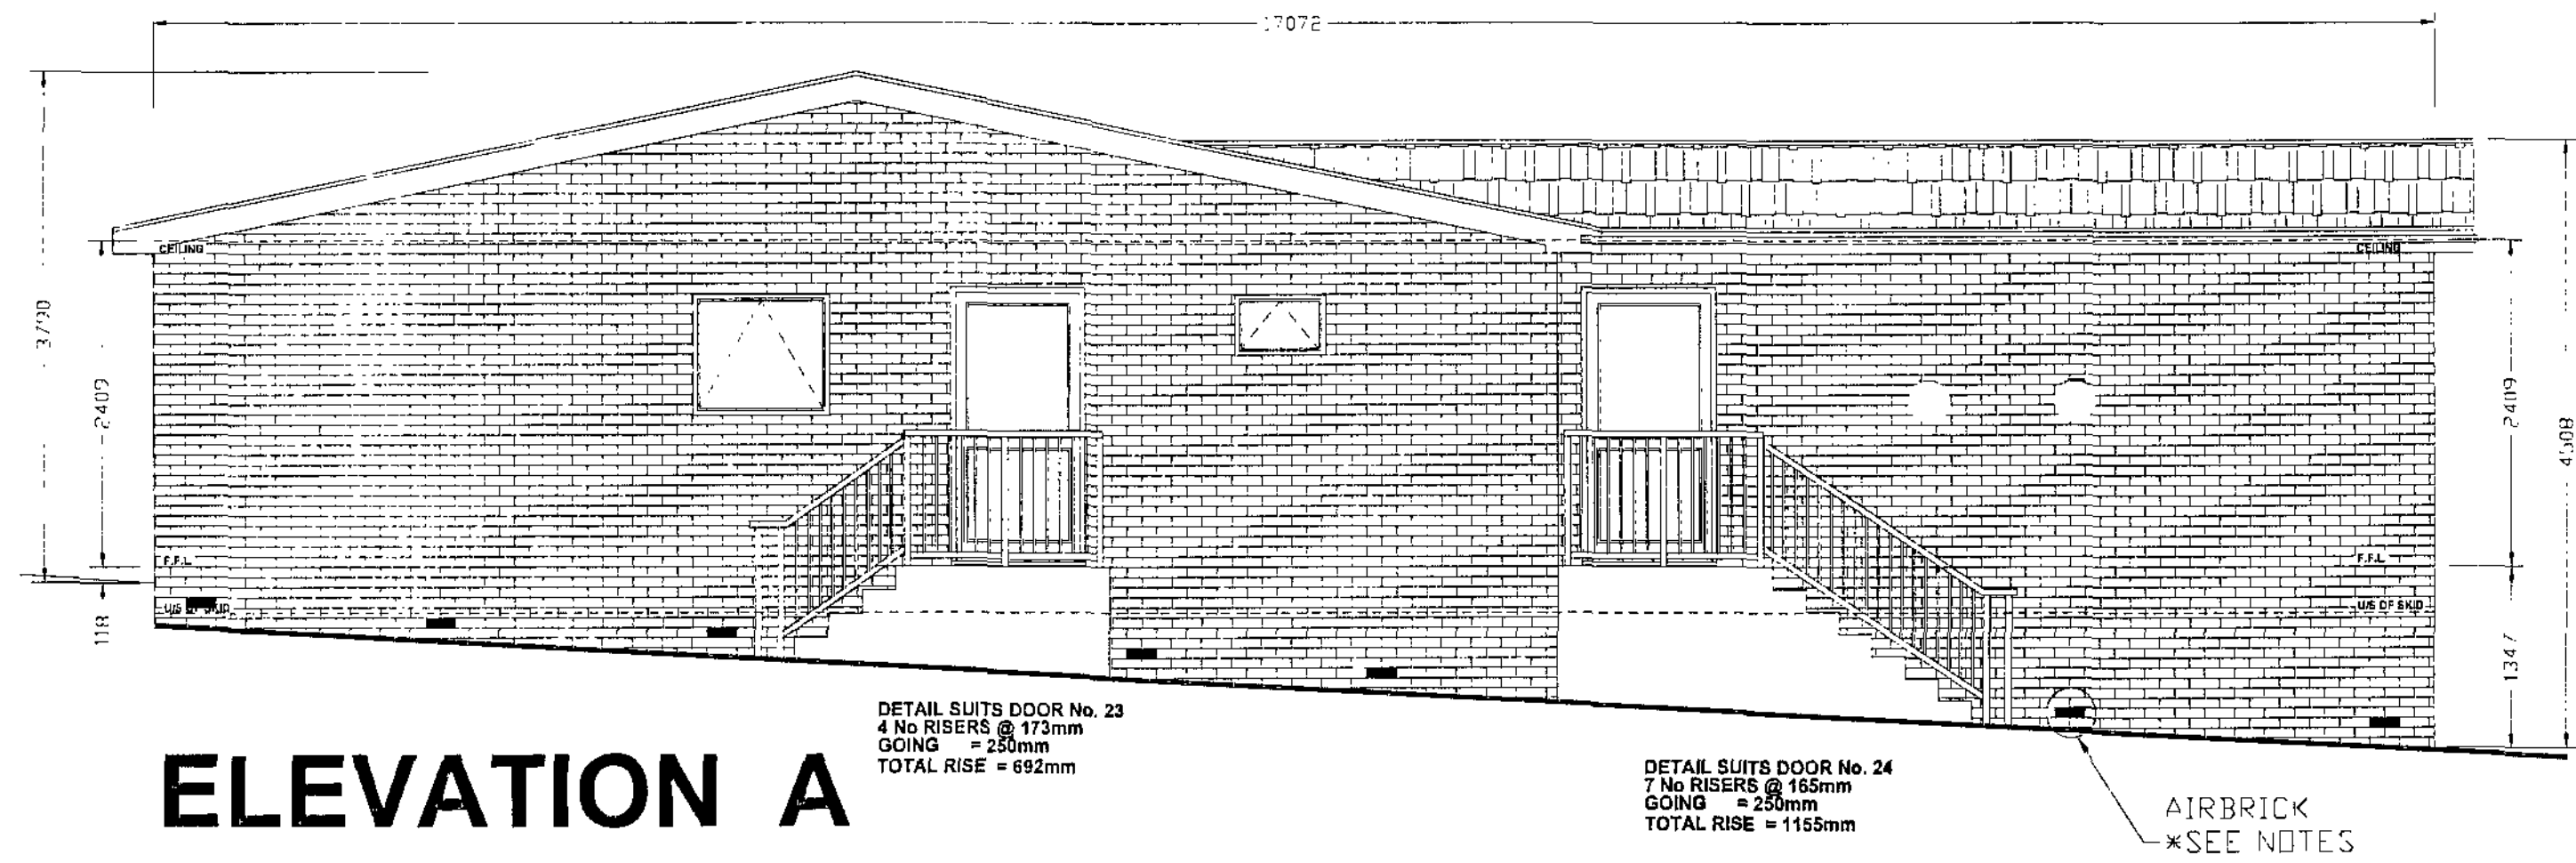


ELEVATION A

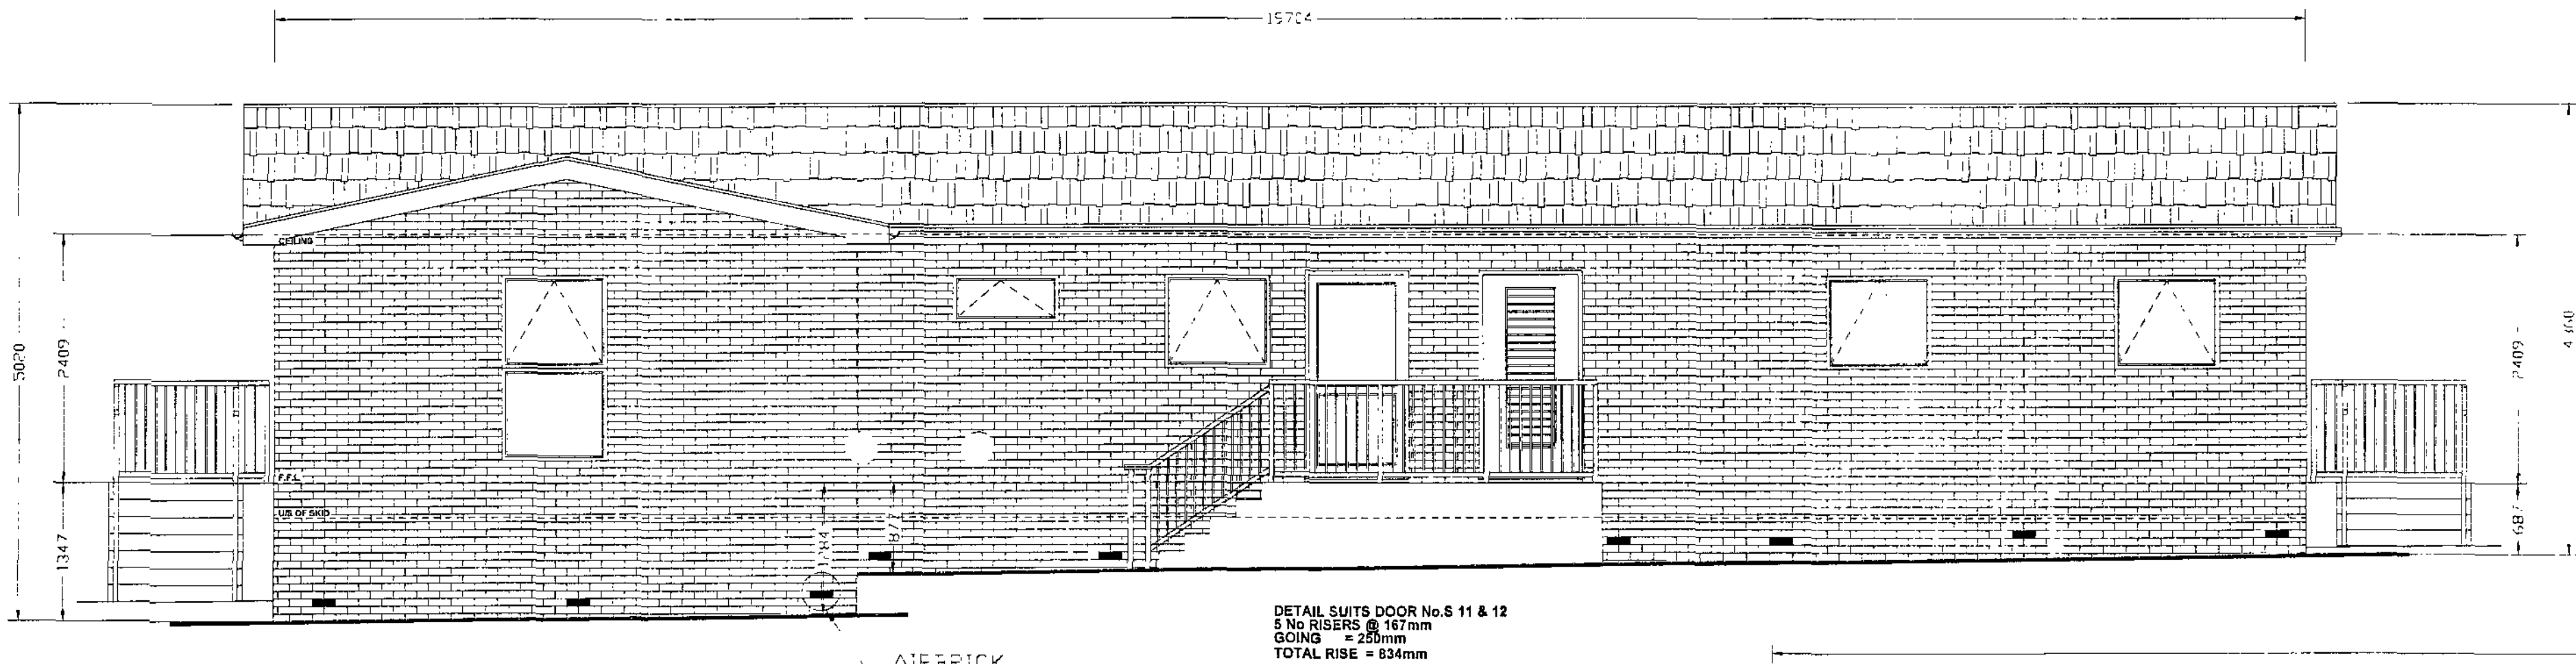

ELEVATION B

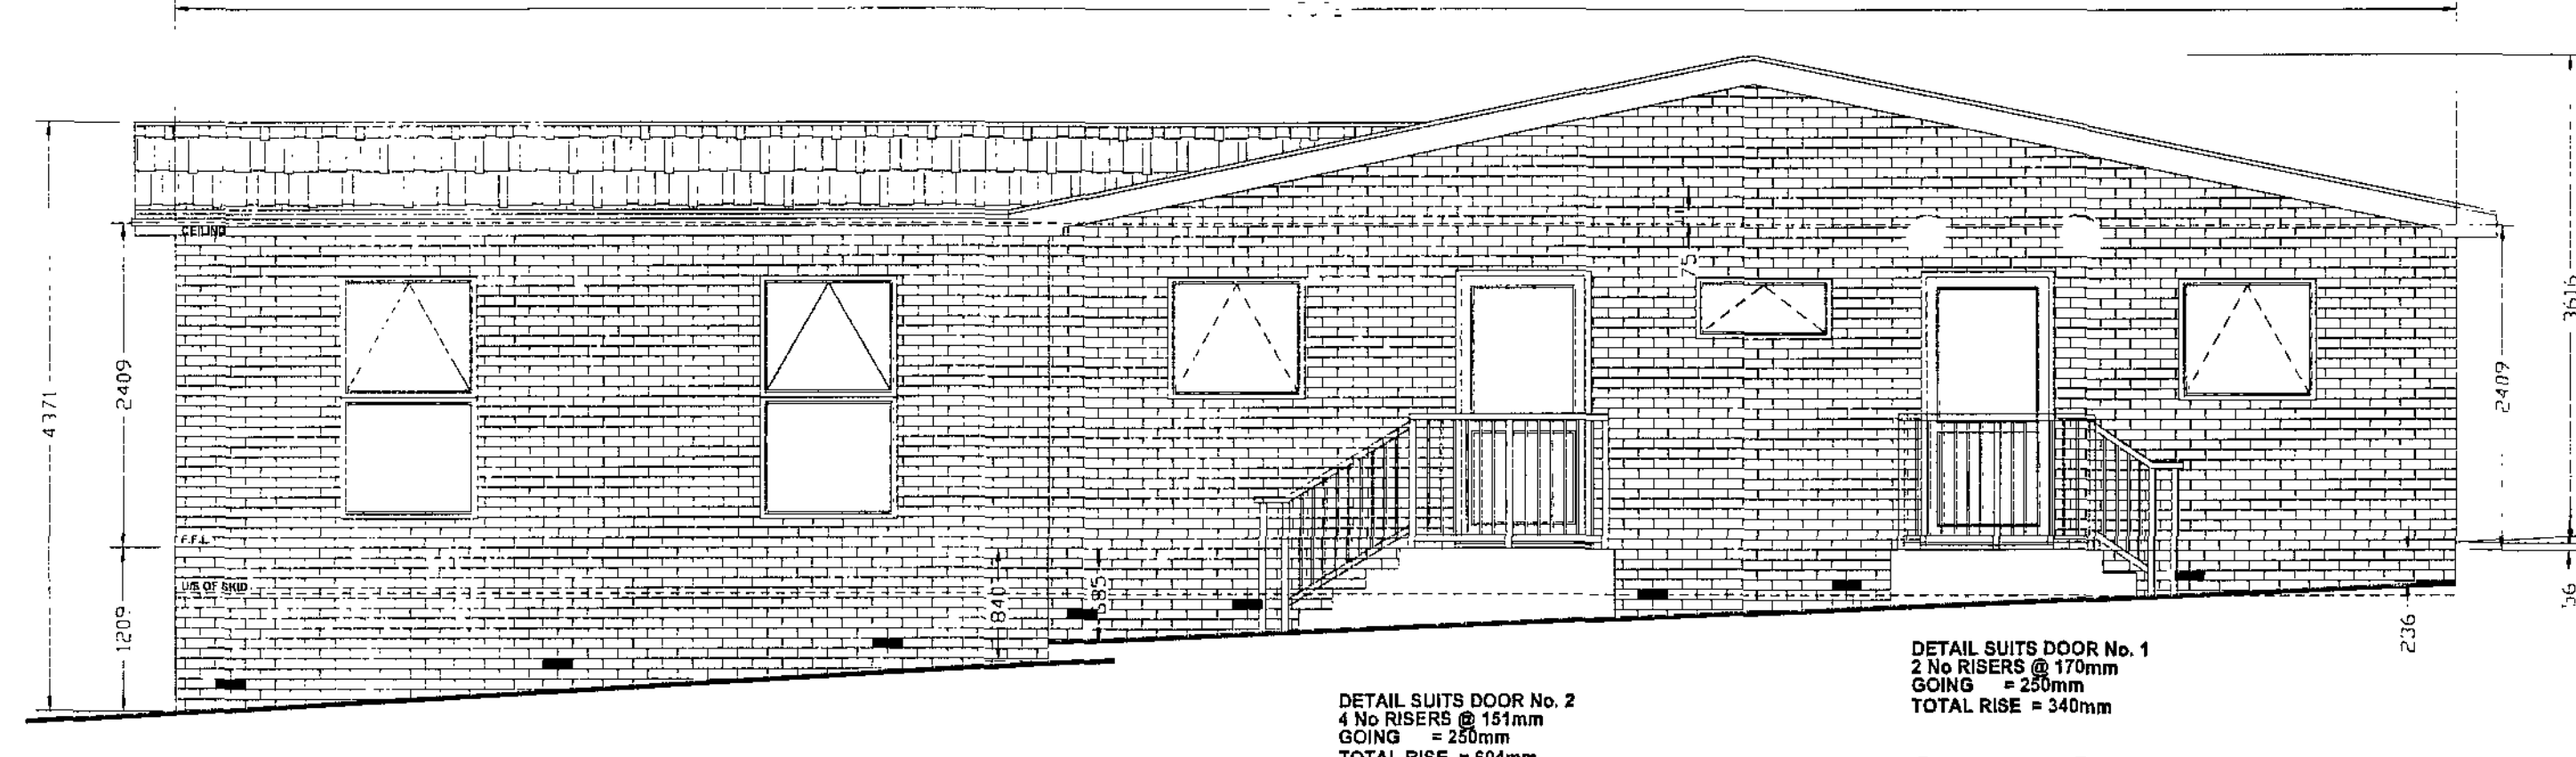

ELEVATION C

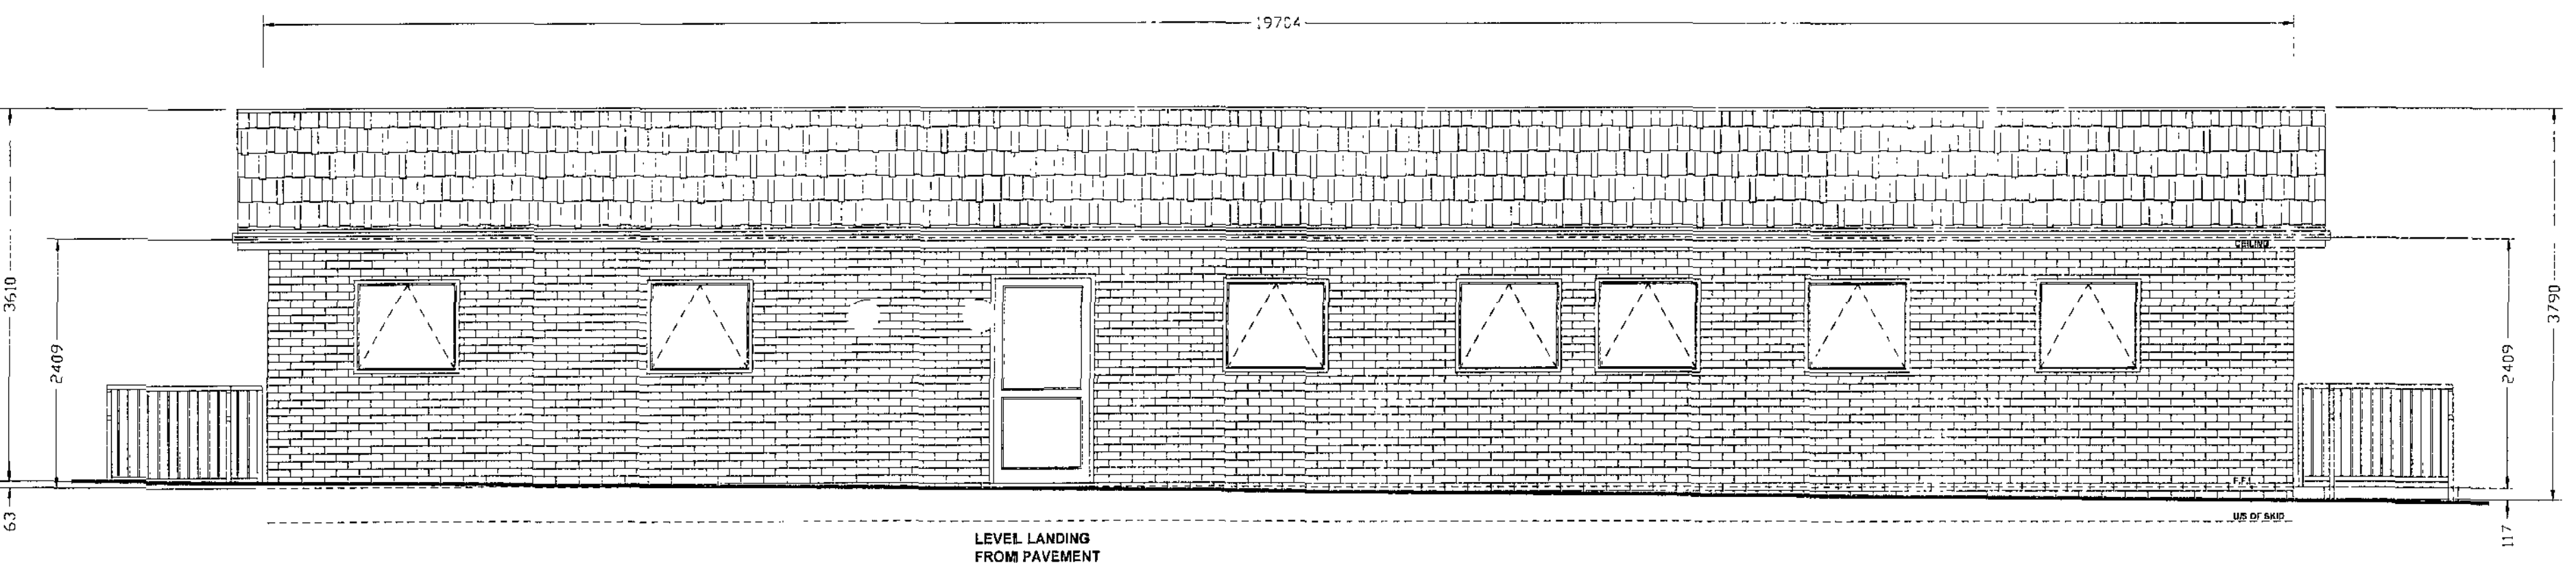

ELEVATION D

CMR  
18 JUL 2008

| rev | code | description                             | by  | chk |
|-----|------|-----------------------------------------|-----|-----|
| 01  |      | 20/5/04 GROUND LEVELS                   | RJL |     |
| 02  |      | 27/4/04 AIRBRICKS AND DIMS              | RJL |     |
| 03  |      | 11/3/04 GROUND LEVELS & WINDOWS ALTERED | DR  |     |
| 04  |      | 16/2/04 OVER HANG ALTERED               | DR  |     |
| 05  |      | 13/2/04 WINDOWS ALTERED                 | DR  |     |

  
**PYRAMID**  
building  
systems

PYRAMID BUILDING SYSTEMS  
CRANWICK IND EST  
WITTEN CRANWICK  
EAST RIDING OF  
YORKSHIRE  
YO25 9PR

TEL (01377) 275100  
FAX (01377) 275101  
email info@pyramidcrux.com

CLIENT  
BARNSELEY NHS

PROJECT  
9 BAY MODULAR

TITLE  
ELEVATIONS

|                   |                 |
|-------------------|-----------------|
| SCALE<br>1:50 @A1 | DATE<br>12/2/04 |
| DRAWN BY<br>DR    | CHECKED BY      |

**AS BUILT**

|                          |          |
|--------------------------|----------|
| DRAWING No<br>03-0753-03 | REV<br>E |
|--------------------------|----------|