



 LidgetCompton
 Albion Drive, Lidget Lane Ind. Est.,
 Thurnscoe, Rotherham S63 0BA
 Tel: 01709 881844 / Fax: 01709 881015
 Web: www.lidget.co.uk
 Email: sales@lidget.co.uk
 Drawn by Brian Armstrong
 Questions/revisions to
 brian.armstrong@lidget.co.uk

Scale 1:50@ A3

Drawn: 23.07.13

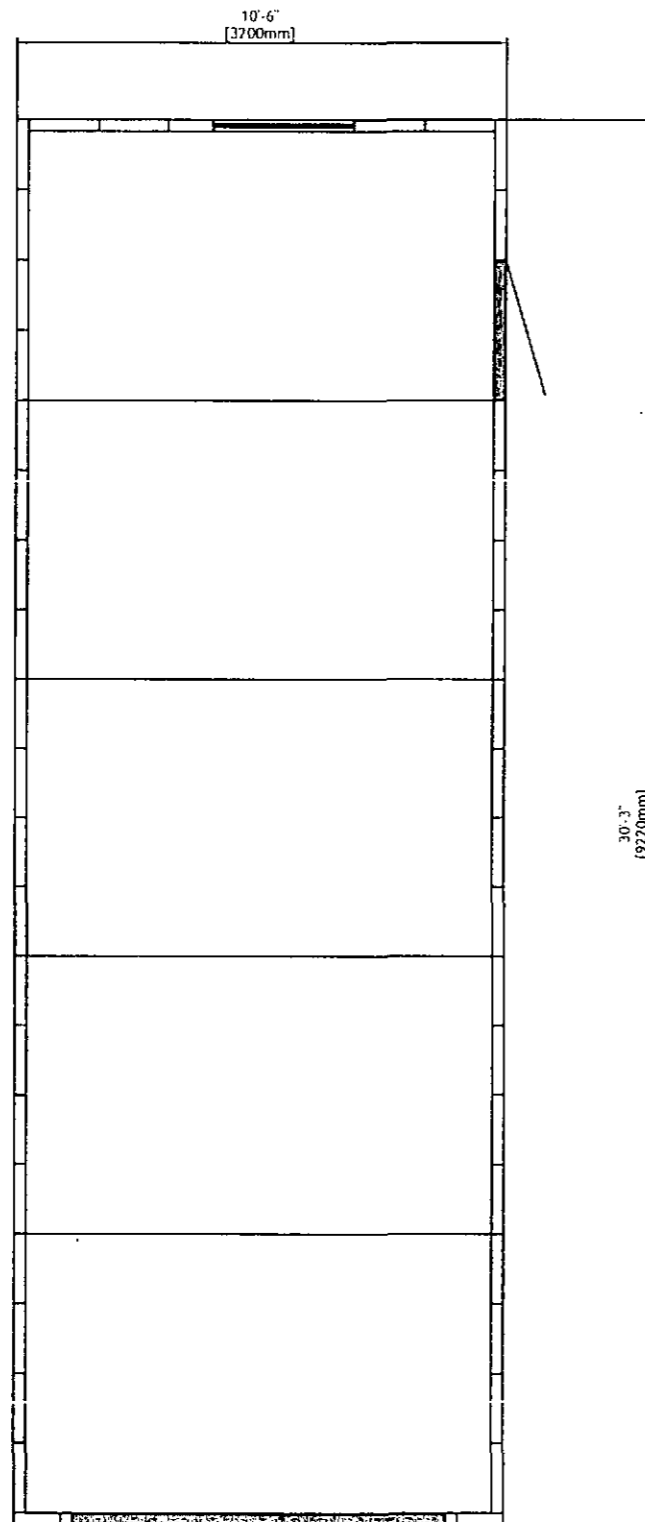

LidgetCompton Apex 30'3 x 10'6 Extra High garage

Walls - 3" thick, steel reinforced, machine vibrated pre-cast concrete panels with pebble dash exterior finish

Roof - Cembrit B5 corrugated fibre - cement sheeted roof in ~~green~~ ^{pebble dash} finish

Garage doors - 8' x 7'6 high, white vertically ribbed up and over doors with extra locking

Window - one 3' fixed treated timber window

Access door - 3' Treated timber access door

Fascias - treated timber fascias and trims

Gutters - ~~white~~ ^{PVCu} gutters both sides

Sand and cement fillet

Our buildings are constructed from pre-cast concrete panels which are secured together using bolts at three points per joint, which are then sealed with industrial mastic.

Our buildings carry a 10 year structural guarantee.

We recommend that our buildings are erected upon a permanent concrete base of suitable thickness. We recommend a minimum of 4" thickness throughout. The base should be flat, level and square, and at least 6" longer and 6" wider than the external dimensions of the building to be supplied



LidgetCompton
 Albion Drive, Lidget Lane Ind. Est.,
 Thurnscoe, Rotherham S63 0BA
 Tel: 01709 881844 / Fax: 01709 881015
 Web: www.lidget.co.uk
 Email: sales@lidget.co.uk

Drawn by Brian Armstrong
 Questions/revisions to
 brian.armstrong@lidget.co.uk

Scale 1:50@ A3

Drawn: 23.07.13