



Existing – Dilapidated Chainlink Fence

- Concrete Posts
- Crossed mesh wires, with green plastic coating

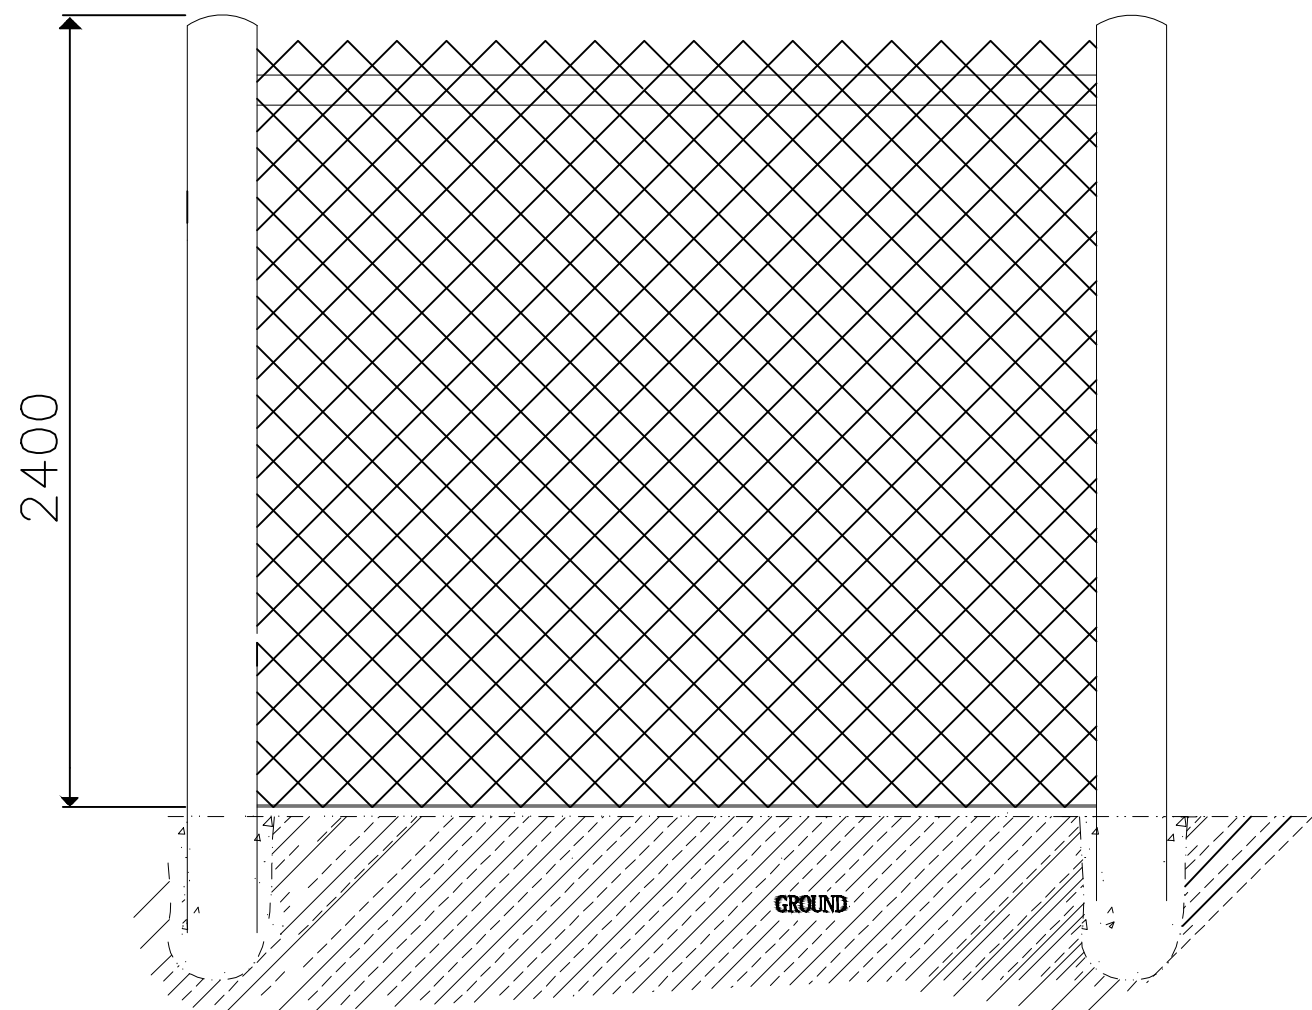

Proposed – Paladin Fencing

- 3.0mm 60 x 60 section posts
- Twin mesh horizontal and vertical wires, ~~red~~^{*} powder coated to BS 1722 Part 16 (BS 6497) (providing an architectural coating of 60 microns)

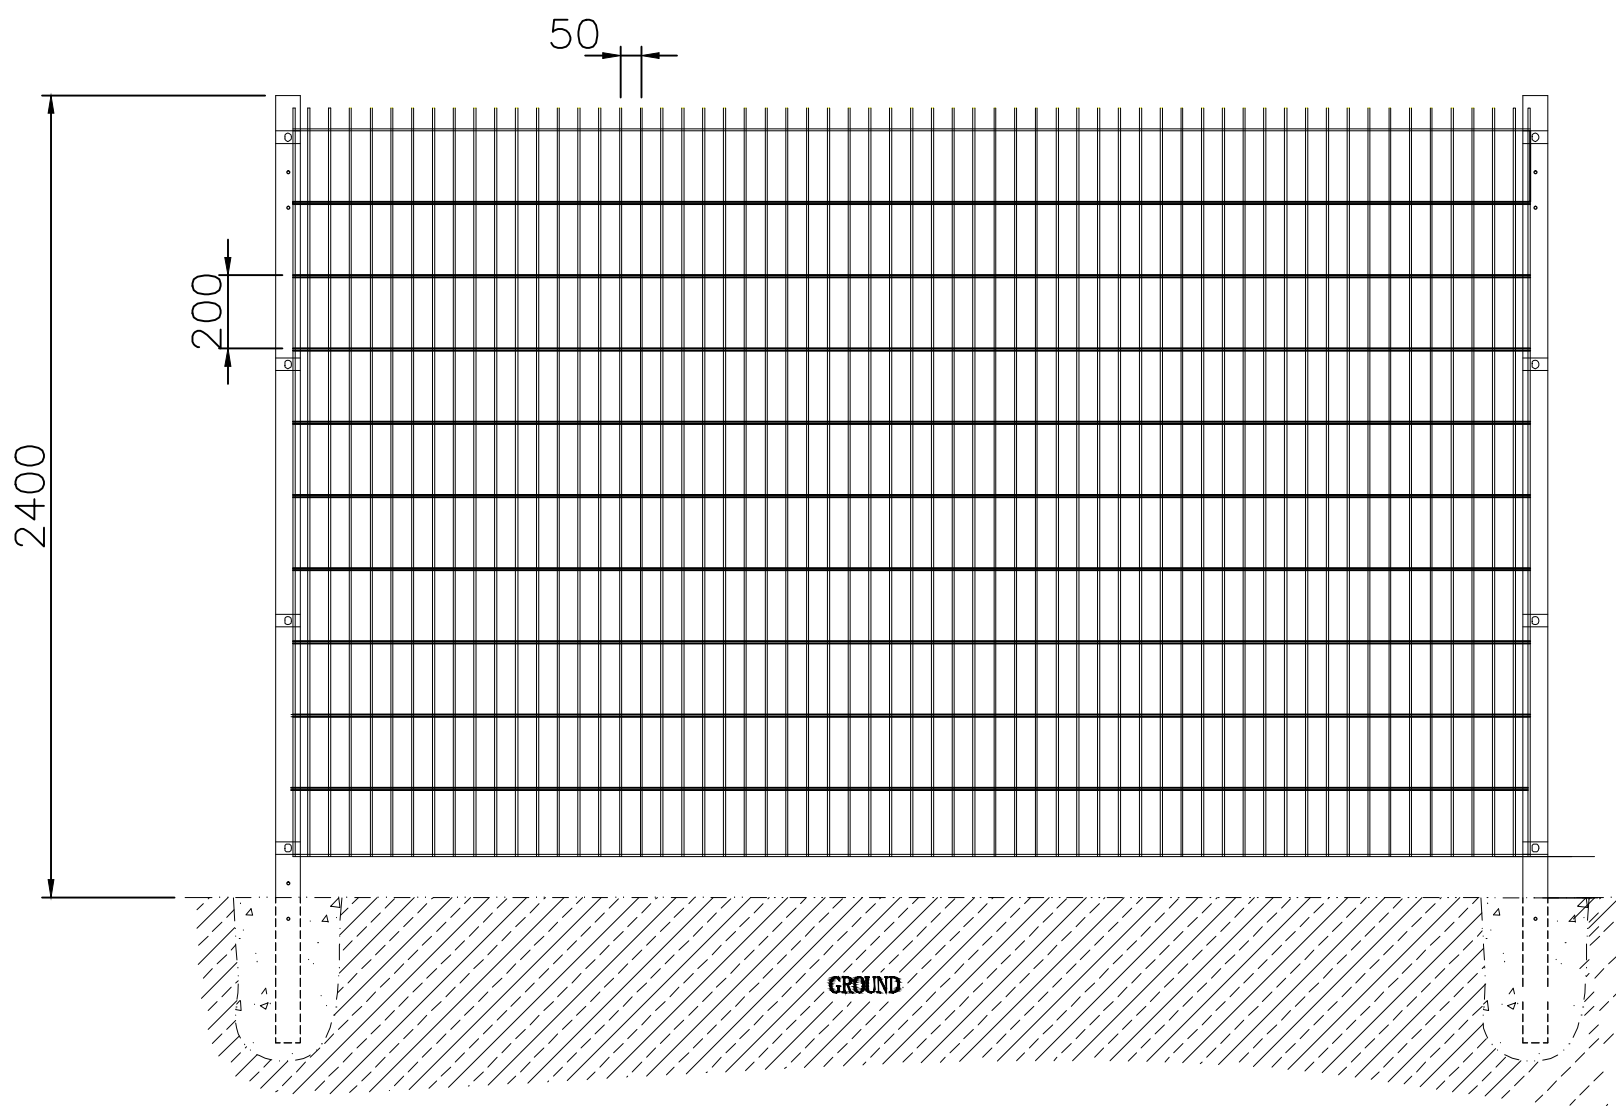

*amendment to colour of fence.

This application is to powder coat, to BS 1/22 Part 16 (BS 6497) (providing an architectural coating of 60 microns), the proposed fence in:


- RAL 9023, Pearl Dark Grey

- THIS DRAWING SHOULD NOT BE USED FOR THE PURPOSES OF SCALING.
- THE ACCURACY OF ANY DIMENSION INCLUDED WITHIN THE PLAN SHOULD BE ESTABLISHED PRIOR TO THE COMMENCEMENT OF WORKS.
- ANY INFORMATION INCLUDED WITHIN THE DRAWING FOUND TO BE INACCURATE OR TO CONFLICT WITH ACTUAL SITE ATTRIBUTES SHOULD BE REPORTED IMMEDIATELY TO THE APPOINTED PROJECT MANAGER FOR CLARIFICATION.
- ALL WORKS UNDERTAKEN SHOULD CONFORM FULLY WITH CURRENT BUILDING REGULATIONS, BRITISH STANDARDS, ALL APPLICABLE LEGISLATION, INDUSTRY GUIDELINES AND CODES OF BEST PRACTICE.
- ANY ADDITIONAL WORKS COMPLETED WITHOUT PRIOR APPROVAL FROM GROUP PROPERTY SERVICES WILL NOT BE CONSIDERED WITHIN THE FINAL ACCOUNT

Barnsley Buildbase - Elevations

1.0

Drawing Status:				
DRAFT ◊	APPROVED <1>	TENDER ◊	SITE ◊	AS-BUILT ◊

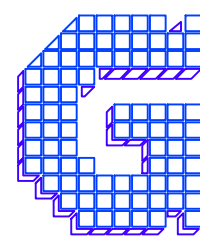 **GRAFTON GROUP plc**
Group Property Services
Gemini One,
5520 Oxford Business Park South,
Cowley, Oxford OX4 2LL
T : 07790 585 375
E : joe.white@graftonplc.com

Consultant Details: Not applicable			
Contractor Details: To be appointed			
Site Address: Barnsley Buildbase Wakefield Road Barnsley, S71 1NH			
Drawing Title: Existing/Proposed Plans			
DRAWN: SPC	CHECKED:	APPROVED:	Scale: 1:20@A1
Barnsley Buildbase - Elevation			1.0