
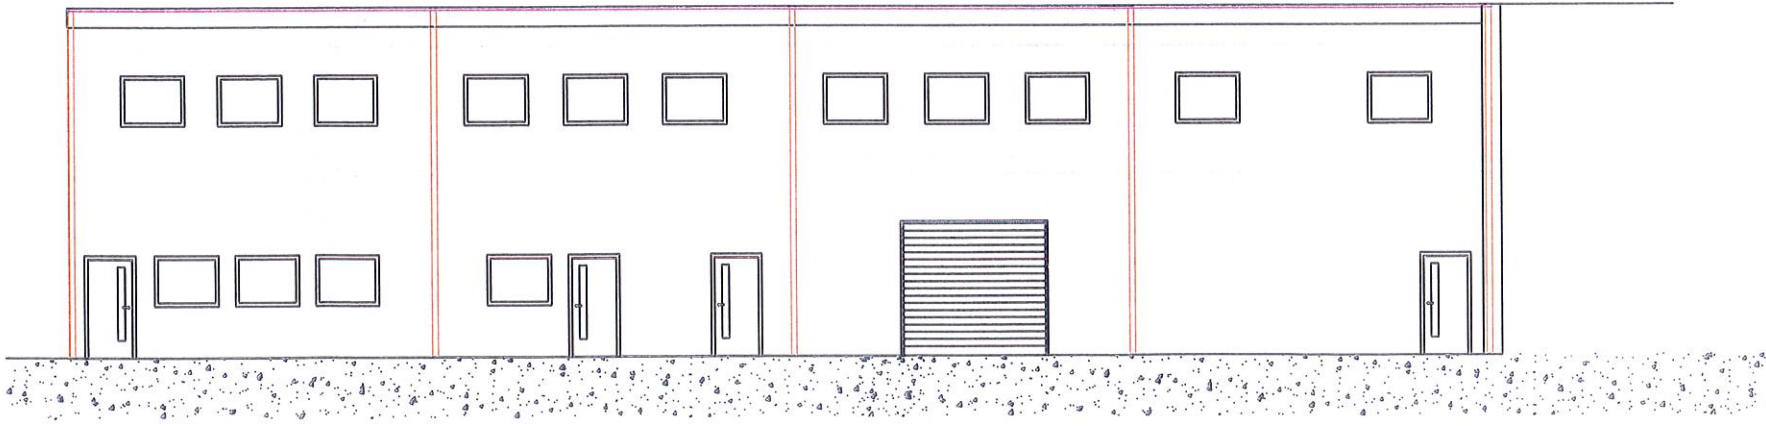
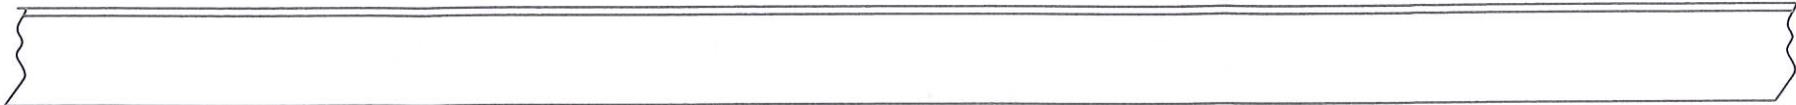


REV:	DATE:	BY:	DESCRIPTION:
00	03/04/2013	PJ	FIRST ISSUE

AS INSTALLED

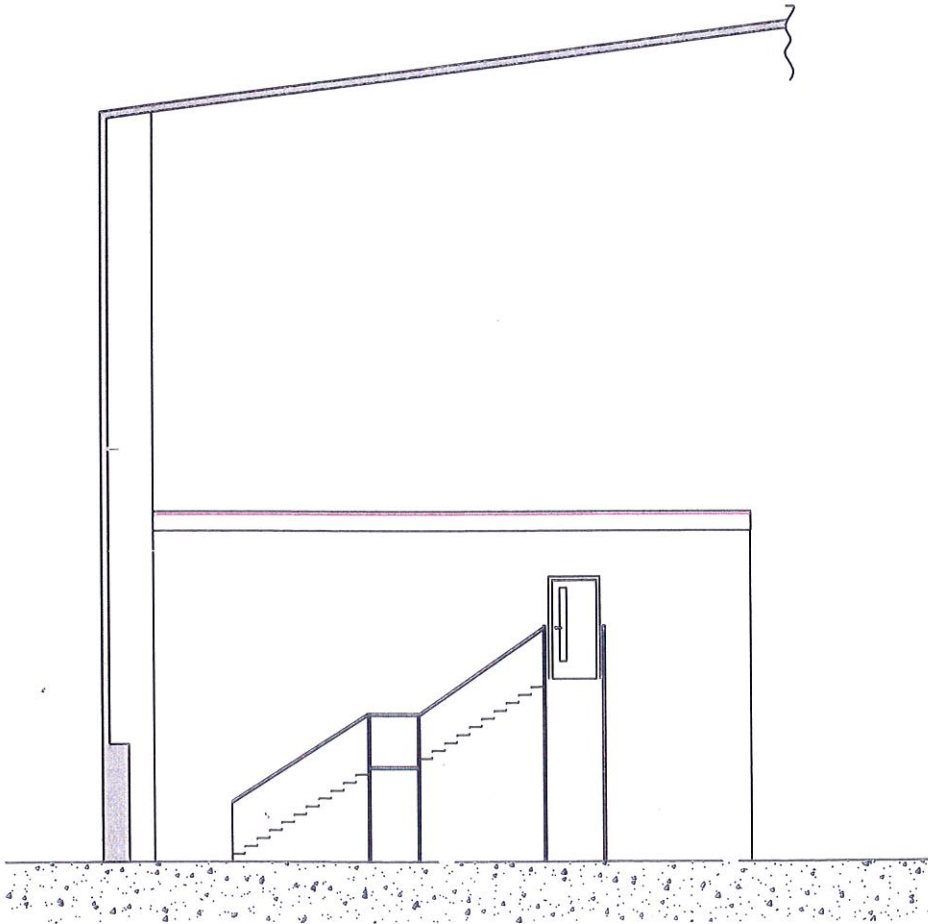


REV:	DATE:	BY:	DESCRIPTION:
00	03/04/2013	PJ	FIRST ISSUE

DRG No NX- 04-11

TITLE: NEXUS36 - OUTSIDE WINDOWS OF NEW OFFICE EXTENSION (FIRST FLOOR)



AS INSTALLED

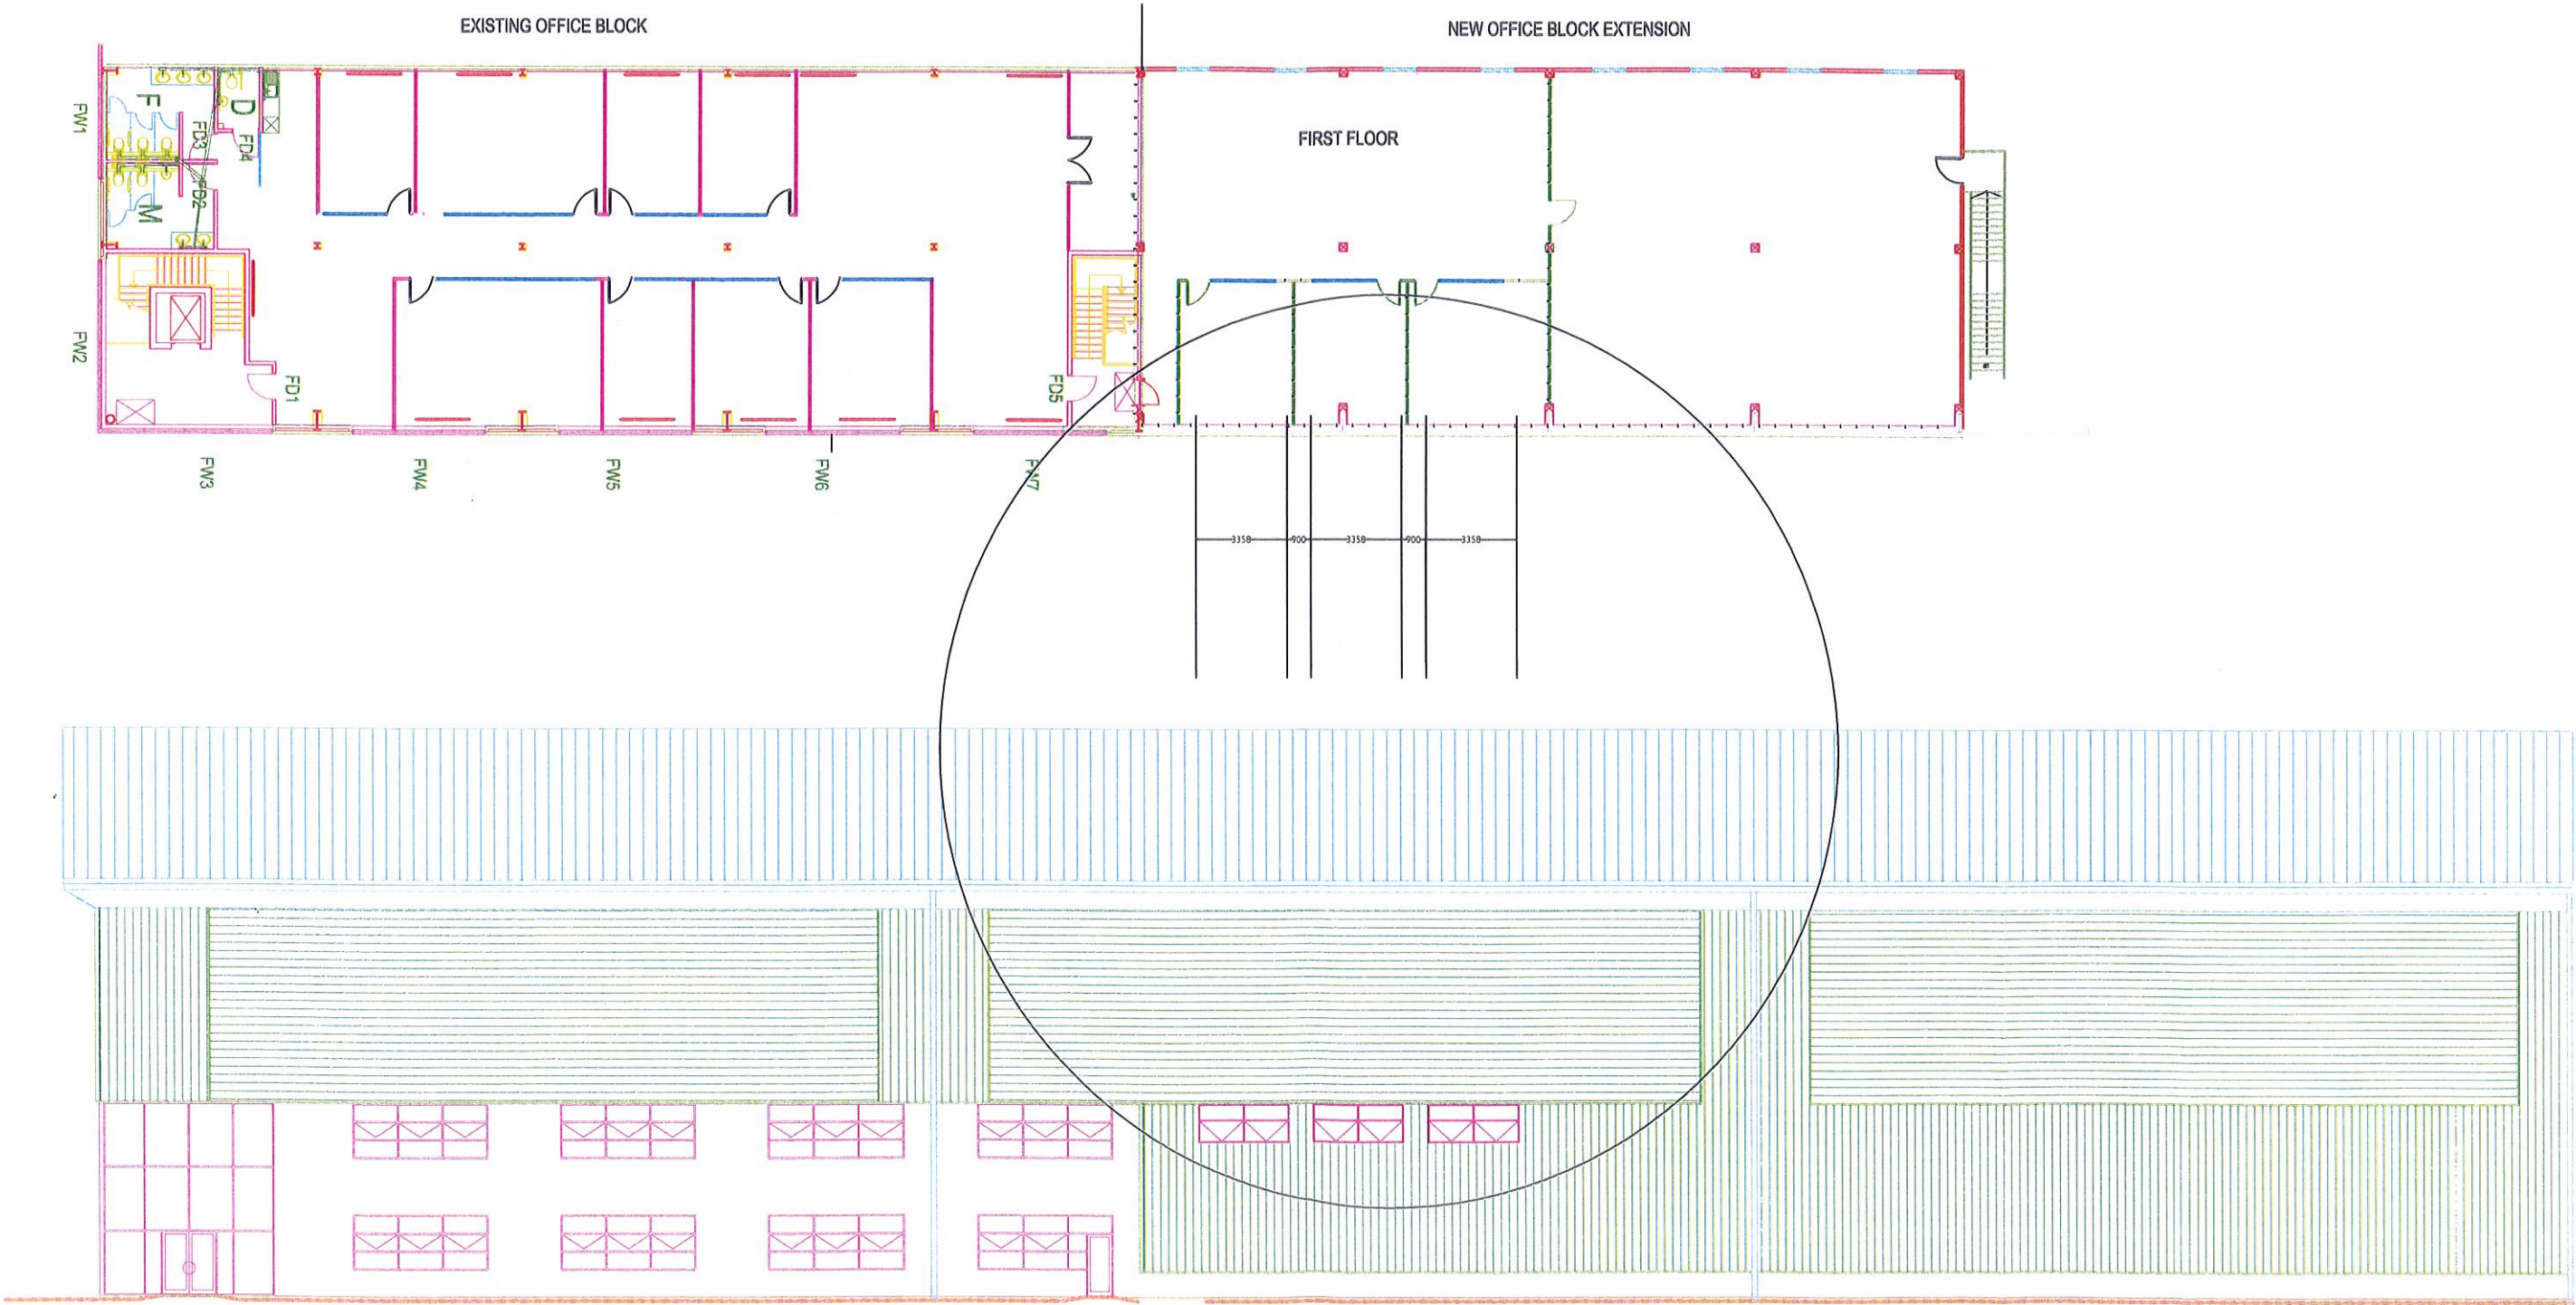

FRONT VIEW OF BUILDING/OFFICES

REV:	DATE:	BY:	DESCRIPTION:	DRG No NX- 04-04	TITLE:	NEXUS36 - OFFICE EXTENSION LAYOUT - DL COMPANY DRG	 ELLBEE
00	11/02/2013	PJ	FIRST ISSUE				

AS INSTALLED

