



PROPOSED PLAN FOR EXTRA CAR PARKING USING LAND
ON ATLAS, UNIT 5 MIDDLEWOODS WAY,
WHARFCLIFFE BUSINESS PARK, CARLTON, BARNSELY
SEL - 3HR.

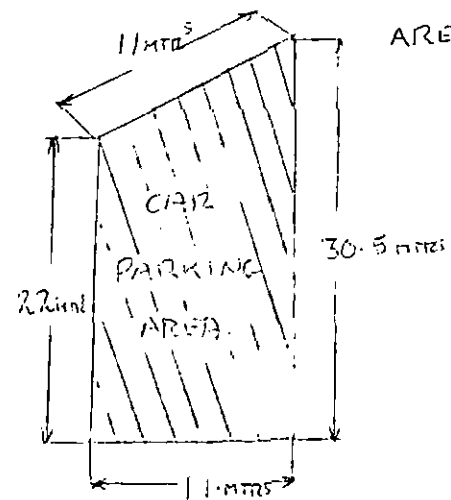

* NOT TO SCALE.
AREA IN RED, AFFECTED AREA.

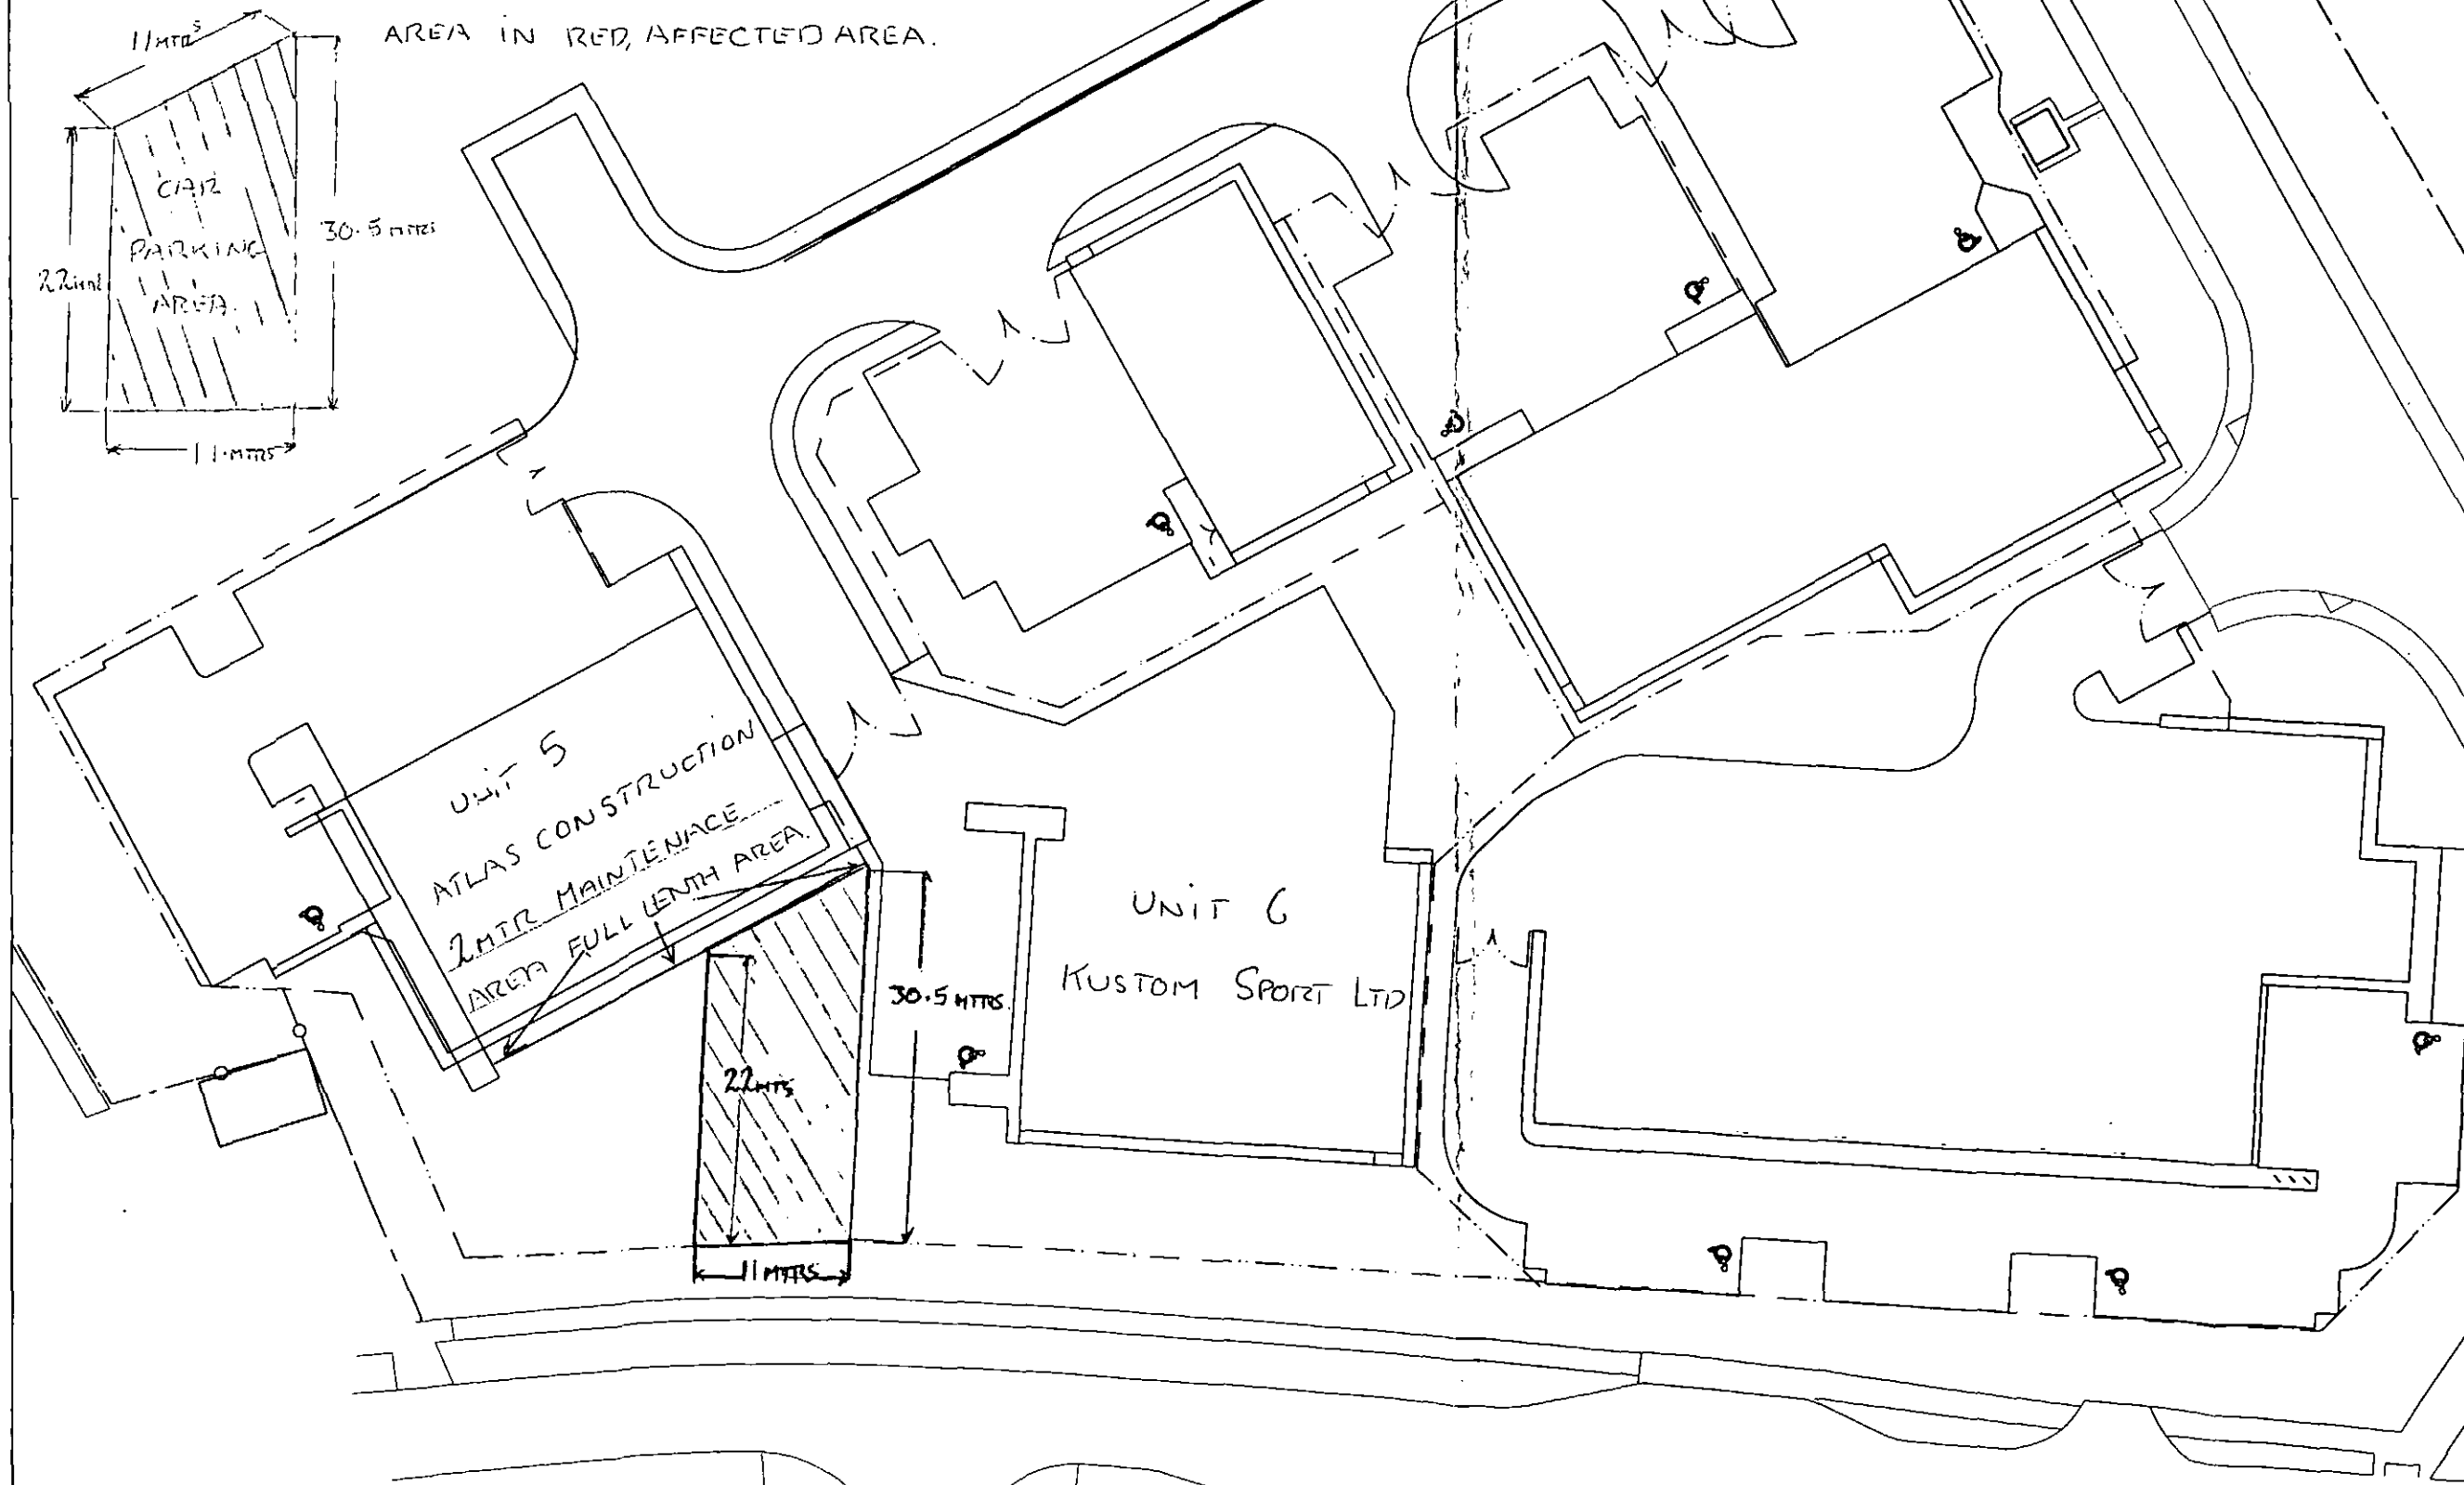

BRITCON

Old Engineering & Building Contractor
Britcon Ltd
Midland Road, Scarborough
North Lincolnshire, DN18 1DD
Telephone 01724 280022
Fax 01724 270516
IN ASSOCIATION WITH
GGP
GABBITAS GILL
PARTNERSHIP LIMITED

WHARFCLIFFE BUSINESS PARK
LAITHES LANE
BARNSELY


EXTERNAL WORKS
FENCING

AS BUILT

1-200 Dec2004

MJH ADS ADS

22601/105 8

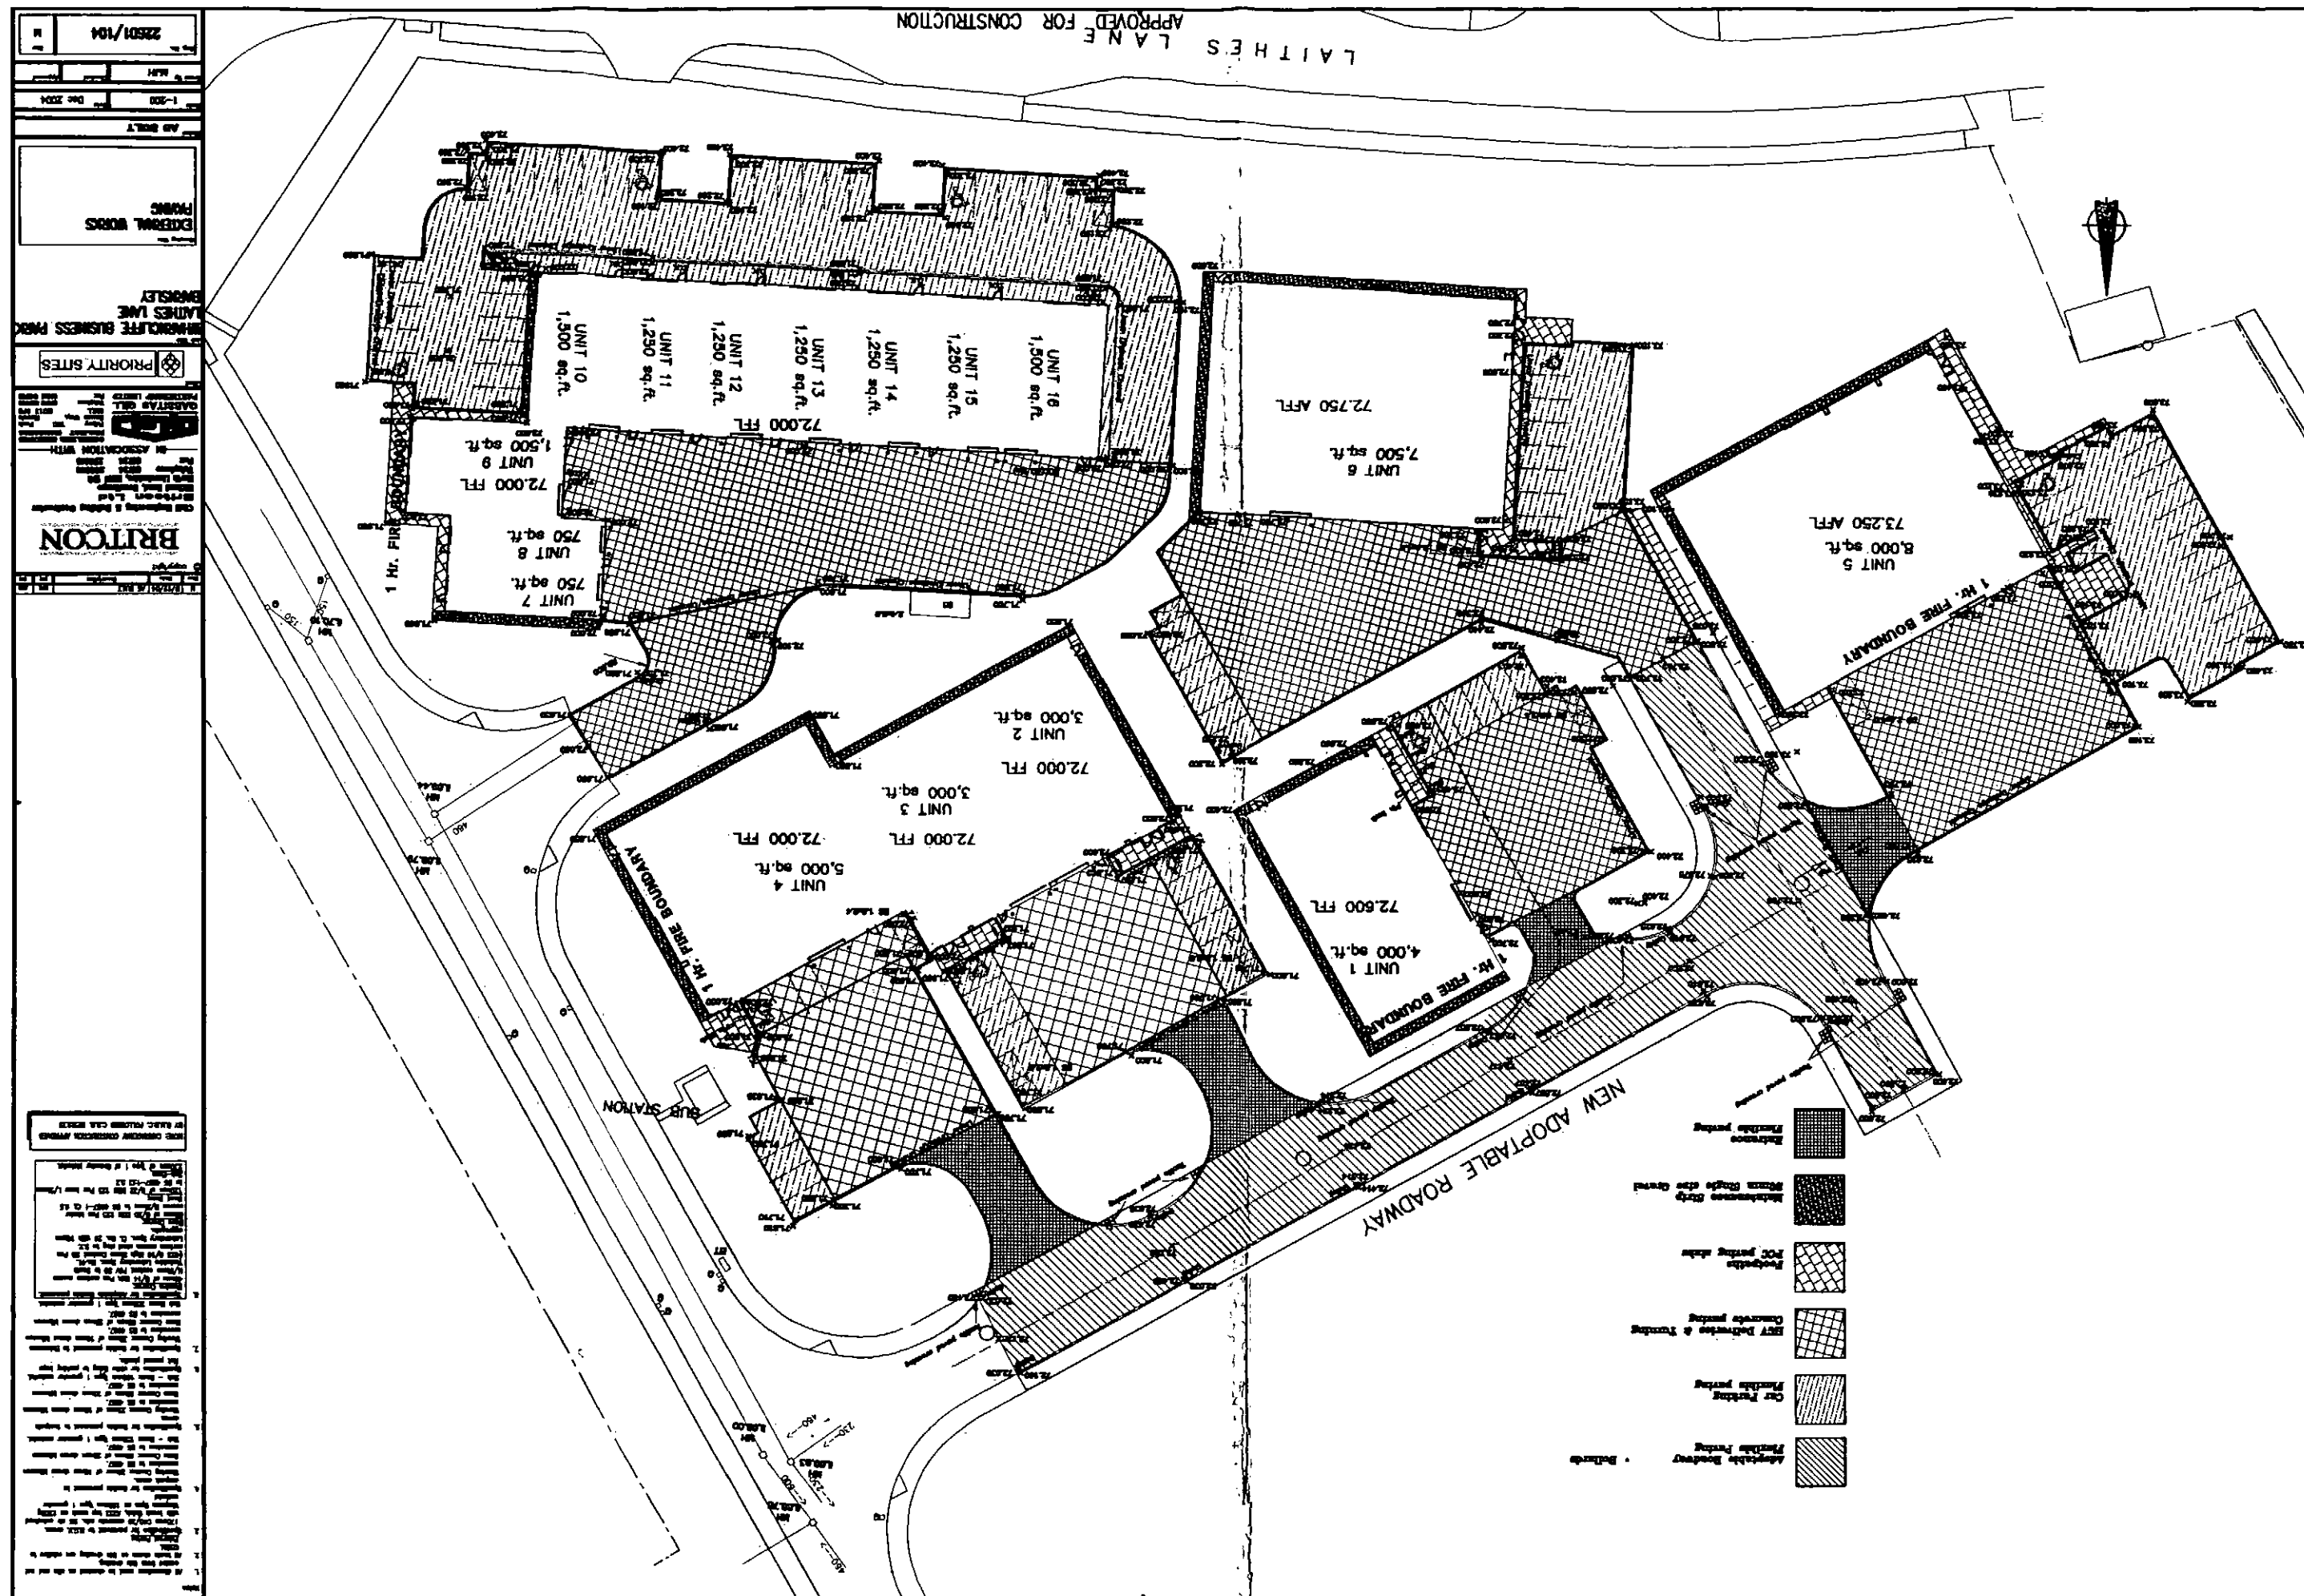


MANHOLE REFERENCE	CHAMBER SIZE & TYPE	COVER TYPE	COVER LEVEL (ft)	INVERT LEVEL (ft)	LAYOUT
SMH1	#1200 PCC	800mm GROUP 1 BS EN 124 CLASS A15	72.000	69.838	
SMH2	#1200 PCC	800mm GROUP 1 BS EN 124 CLASS A15	72.450	70.428	
SMH3	#1200 PCC	800mm GROUP 1 BS EN 124 CLASS A15	71.800	70.708	
SMH4	#1200 PCC	800mm GROUP 1 BS EN 124 CLASS A15	73.800	71.483	
SMH5	#1200 PCC	800mm GROUP 1 BS EN 124 CLASS A15	73.100	72.053	
SMH6	#1200 PCC	800mm GROUP 1 BS EN 124 CLASS A15	73.180	72.378	
SMH7	#1200 PCC	800mm GROUP 1 BS EN 124 CLASS A15	72.800	70.879	
SMH8	#1200 PCC	800mm GROUP 1 BS EN 124 CLASS A15	72.400	71.214	
SMH9	#1800 PCC	800mm GROUP 1 BS EN 124 CLASS A15	72.500	71.313	
SMH10	#1200 PCC	800mm GROUP 4 BS EN 124 CLASS A15	72.270	69.800	
SMH11	#1200 PCC	800mm GROUP 4 BS EN 124 CLASS A15	72.340	70.300	
SMH12	#1200 PCC	800mm GROUP 4 BS EN 124 CLASS A15	72.440	70.833	

MANHOLE REFERENCE	CHAMBER SIZE & TYPE	COVER TYPE	COVER LEVEL (ft)	INVERT LEVEL (ft)	LAYOUT
FMH1	#1800 PCC	800mm GROUP 1 BS EN 124 CLASS A15	72.000	69.550	
FMH2	#1800 PCC	800mm GROUP 1 BS EN 124 CLASS A15	72.100	70.408	
FMH3	#1200 PCC	800mm GROUP 1 BS EN 124 CLASS A15	72.800	70.780	
FMH4	#600 PCC	800mm GROUP 1 BS EN 124 CLASS A15	71.825	71.063	
FMH5	#600 PCC	800mm GROUP 1 BS EN 124 CLASS A15	71.825	71.134	
FMH6	#600 PCC	800mm GROUP 1 BS EN 124 CLASS A15	71.825	71.322	

MANHOLE REFERENCE	CHAMBER SIZE & TYPE	COVER TYPE	COVER LEVEL (ft)	INVERT LEVEL (ft)	LAYOUT
FMH7	#600 PCC	800mm GROUP 1 BS EN 124 CLASS A15	71.825	71.257	
FMH8	#600 PCC	800mm GROUP 1 BS EN 124 CLASS A15	71.825	71.304	
FMH9	#600 PCC	800mm GROUP 1 BS EN 124 CLASS A15	71.825	71.354	
FMH10	#600 PCC	800mm GROUP 1 BS EN 124 CLASS A15	71.850	70.803	

MANHOLE REFERENCE	CHAMBER SIZE & TYPE	COVER TYPE	COVER LEVEL (ft)	INVERT LEVEL (ft)	LAYOUT
FMH11	#1800 PCC	800mm GROUP 1 BS EN 124 CLASS A15	72.450	70.778	
FMH12	#1800 PCC	800mm GROUP 1 BS EN 124 CLASS A15	72.800	71.200	
FMH13	#600 PCC	800mm GROUP 1 BS EN 124 CLASS A15	72.000	71.377	
FMH14	#1800 PCC	800mm GROUP 1 BS EN 124 CLASS A15	71.850	71.300	
FMH15	#600 PCC	800mm GROUP 1 BS EN 124 CLASS A15	72.400	72.880	
FMH16	#600 PCC	800mm GROUP 1 BS EN 124 CLASS A15	72.800	72.378	
FMH17	#600 PCC	800mm GROUP 1 BS EN 124 CLASS A15	73.100	72.340	
FMH18	#600 PCC	800mm GROUP 1 BS EN 124 CLASS A15	71.850	71.143	
FMH19	#600 PCC	800mm GROUP 1 BS EN 124 CLASS A15	71.850	71.143	

1. All dimensions shall be checked on site and not relied upon for construction.
2. All work shown on this drawing is subject to the following conditions:
3. The design is based on the following assumptions:
4. The design is based on the following assumptions:
5. The design is based on the following assumptions:
6. The design is based on the following assumptions:
7. The design is based on the following assumptions:
8. The design is based on the following assumptions:
9. The design is based on the following assumptions:
10. The design is based on the following assumptions:
11. The design is based on the following assumptions:
12. The design is based on the following assumptions:

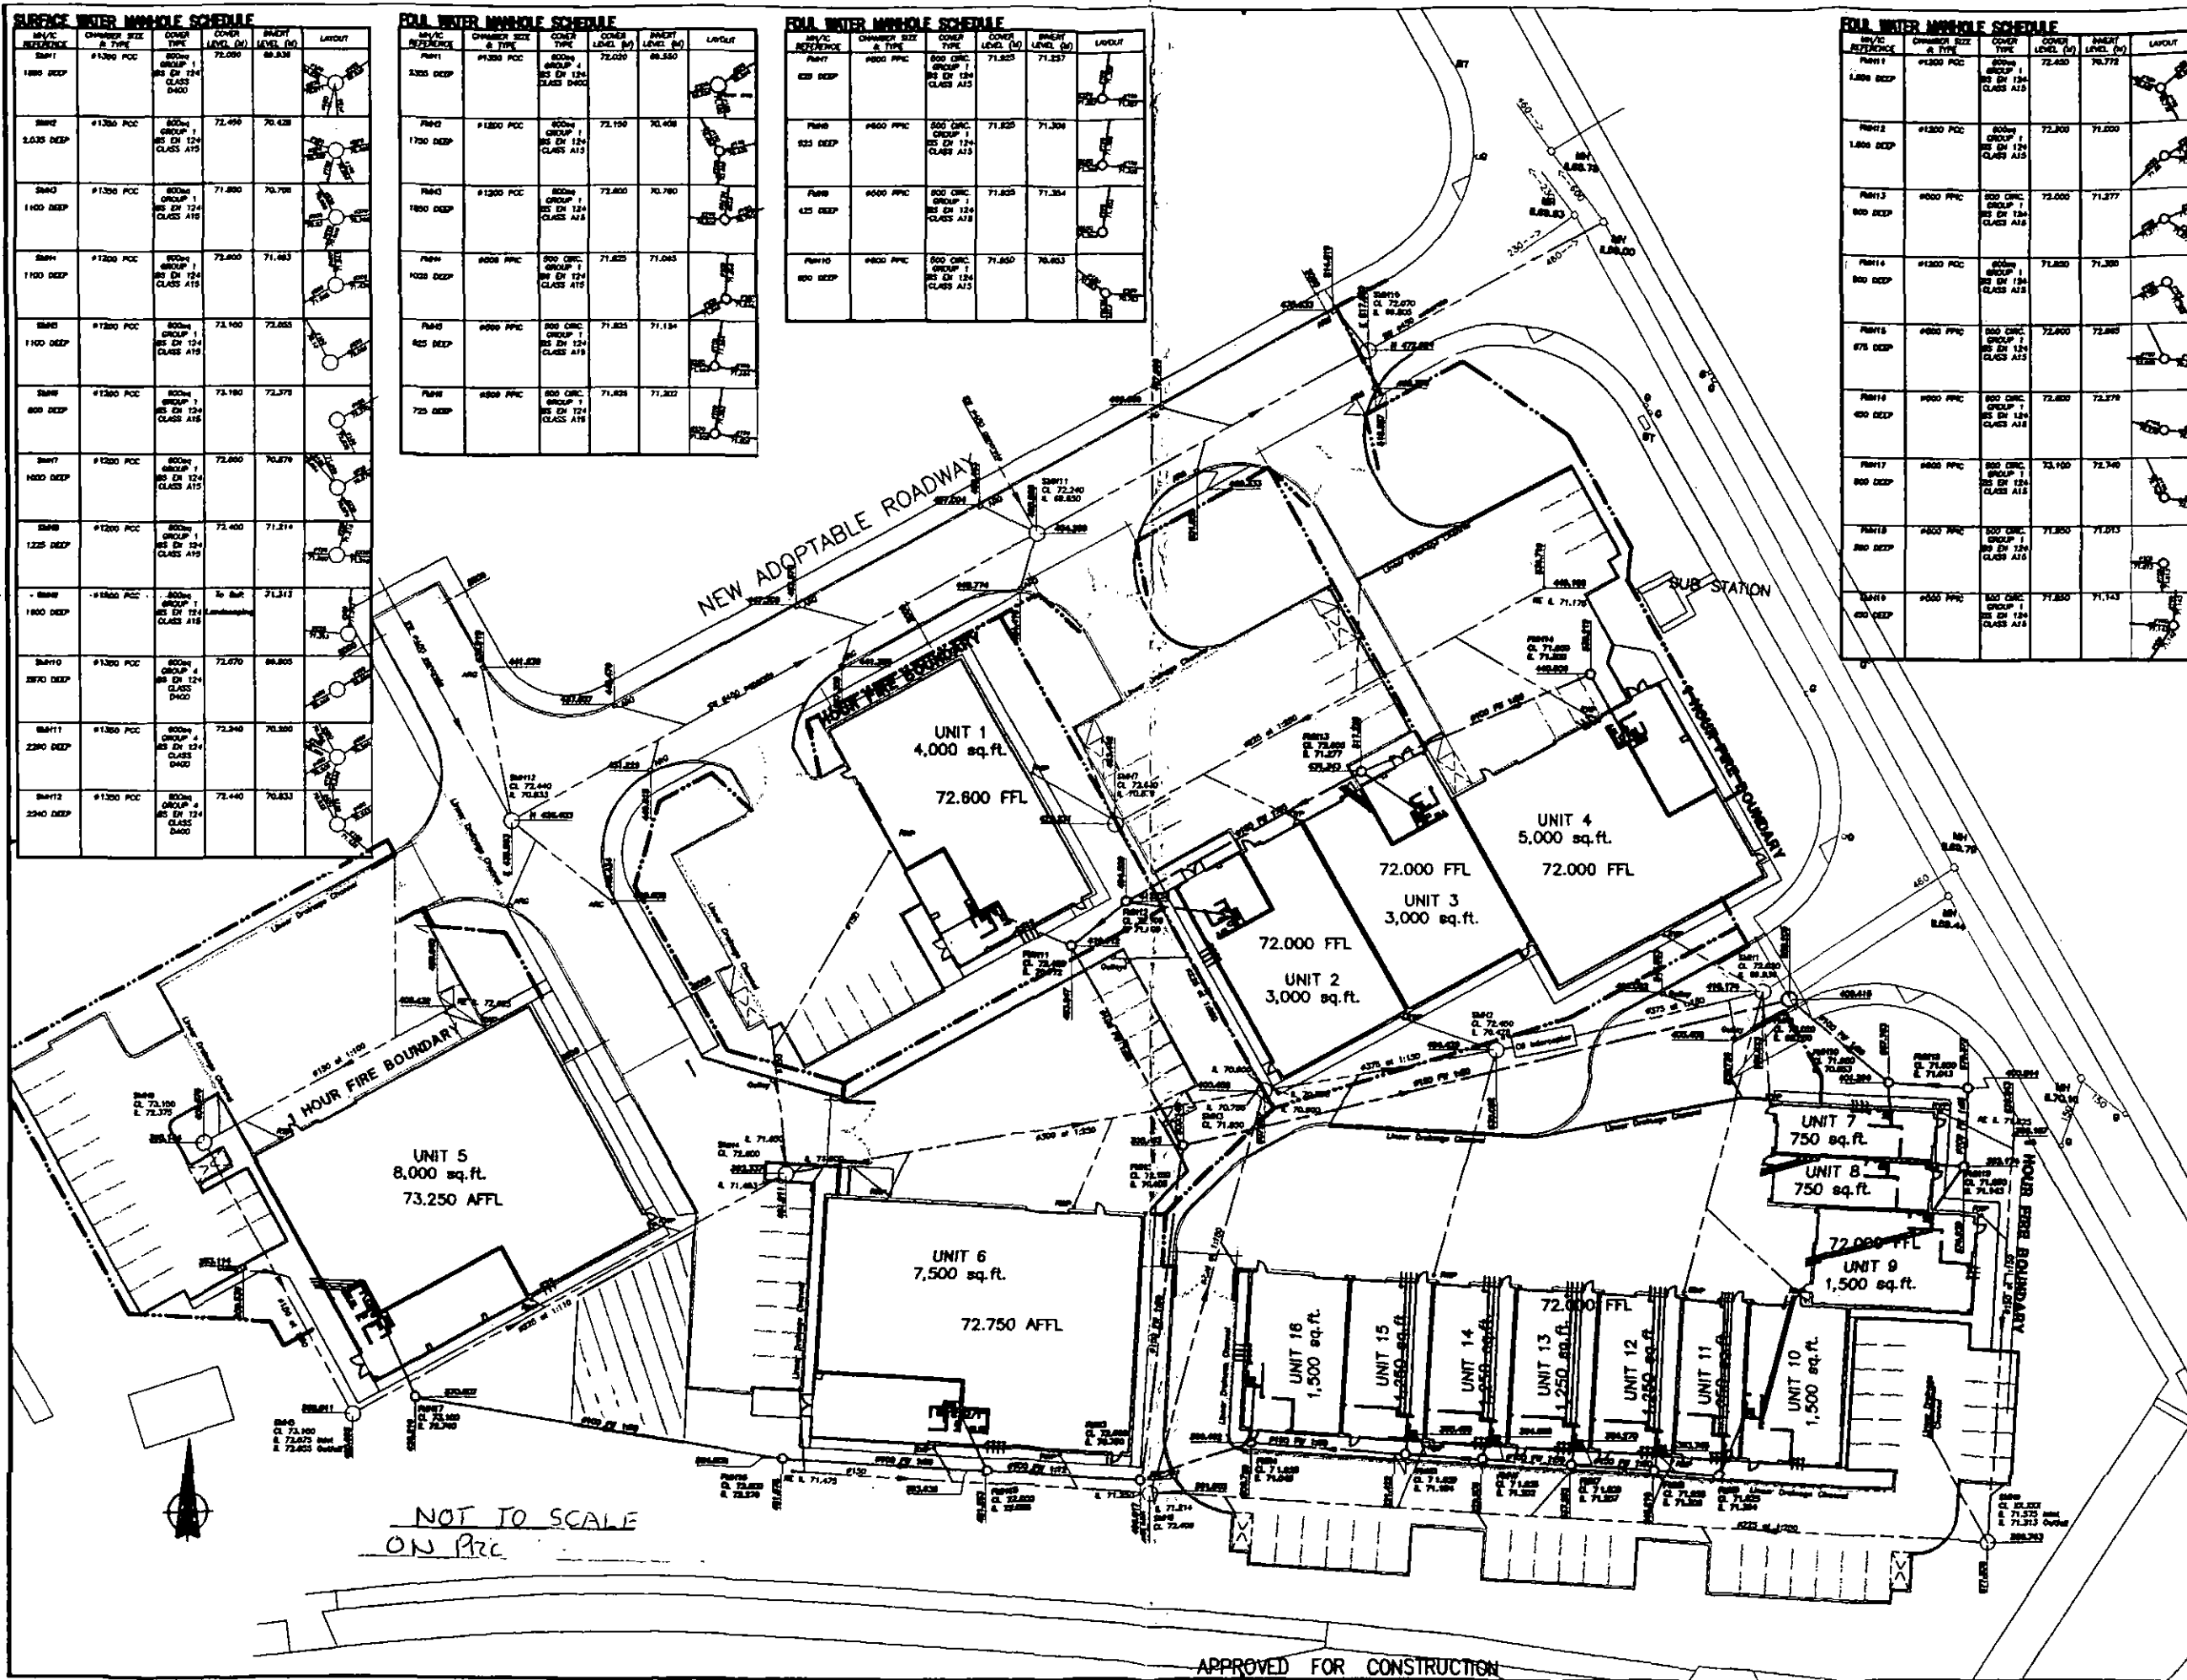

NOT TO SCALE
ON PRC

APPROVED FOR CONSTRUCTION

BRITCON
Civil Engineering & Building Construction
100 Years of Service
100 Years of Excellence
100 Years of Innovation
100 Years of Progress
100 Years of Growth
100 Years of Success
100 Years of Achievement
100 Years of Leadership
100 Years of Influence
100 Years of Impact
100 Years of Legacy

PRIORITY SITES
BRITCLIFFE BUSINESS PARK
LATHES LANE
BROOKLEY

**EXTERNAL WORKS
DRAINAGE**

AS BUILT
1-200
Dec2004
M.H.
22001/103