




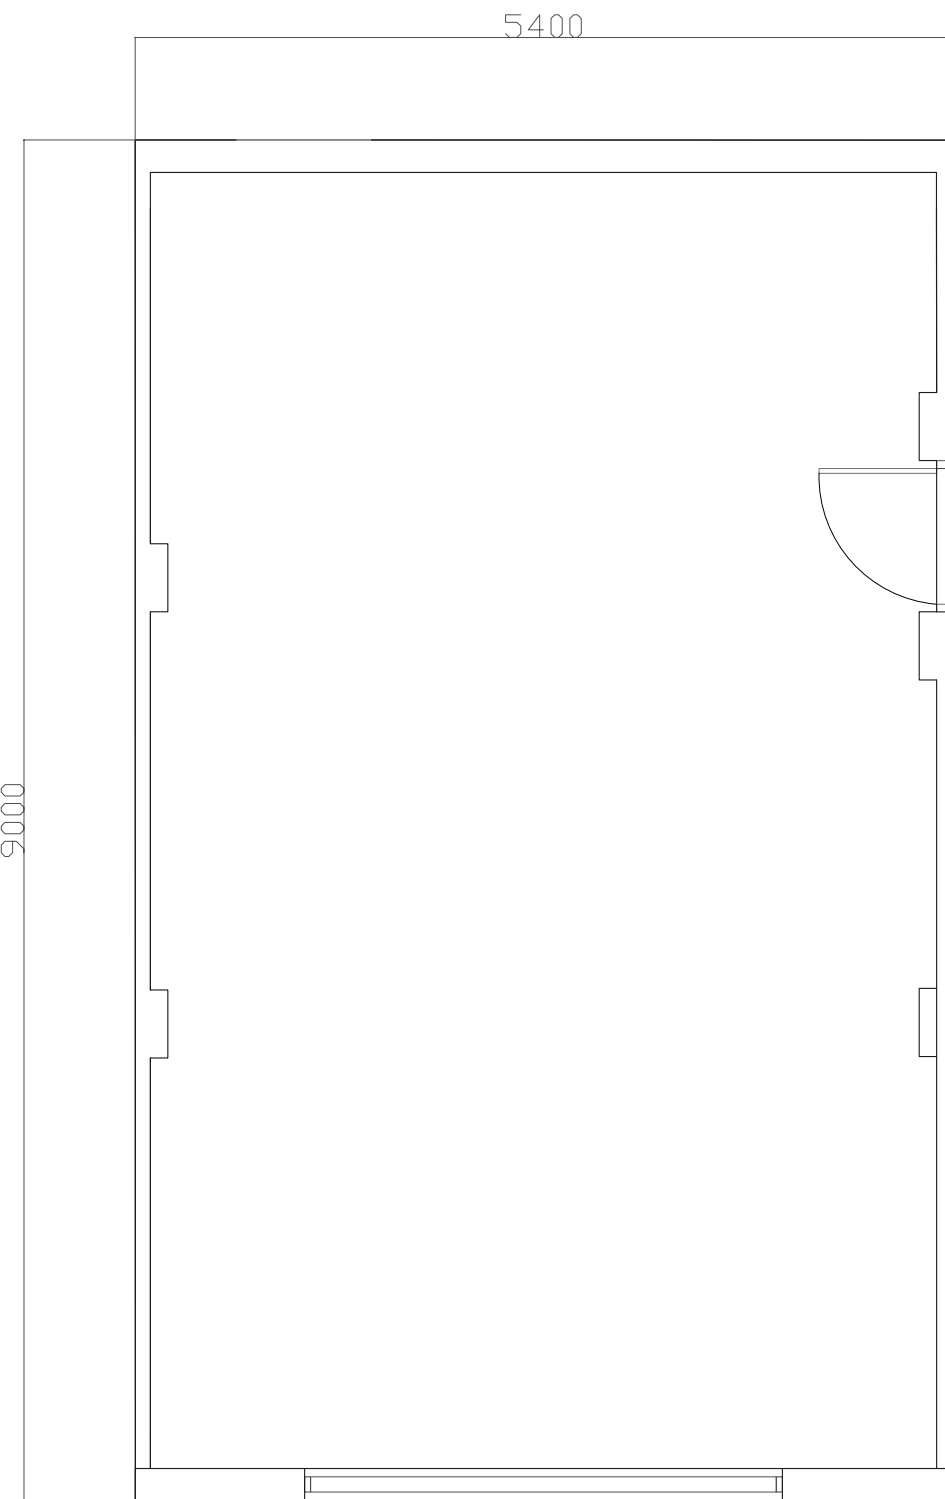


FLOOR PLAN AS BUILT
SCALE 1:50

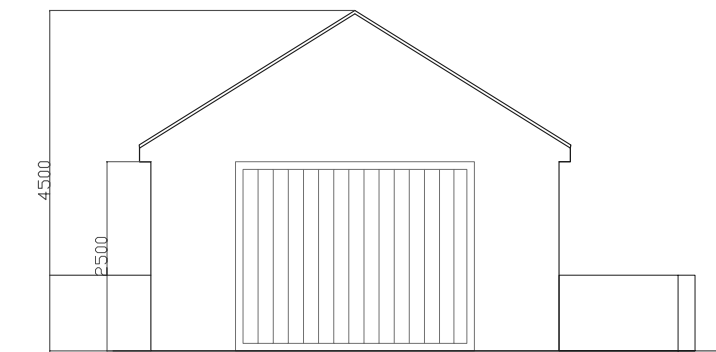


FRONT ELEVATION TO REAR OF PROPERTY
AND FACING ROAD

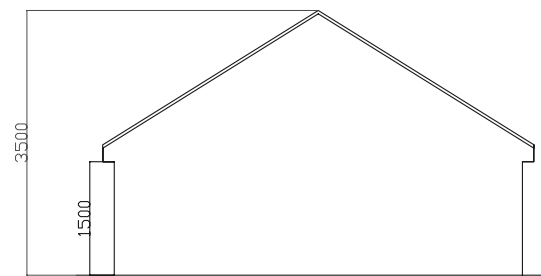

REAR ELEVATION TO GARDEN
WITH INCREASED GROUND LEVEL

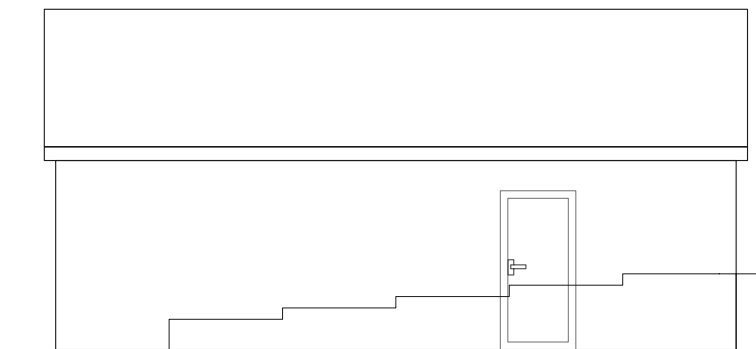

 RH SIDE ELEVATION TO GARDEN SHOWING RETAINING WALL



LH SIDE ELEVATION TO BOUNDARY

PROPOSED MATERIALS

FRONT ELEVATION TO BE RED
RENDER/BRICK SLIPS TO
IMITATE THE RED BRICK AND
MATCH THE EXISTING HOUSE

CREAM RENDER TO SIDE AND
REAR ELEVATIONS

CONCRETE INTERLOCKING
TILES TO MATCH EXISTING
DWELLING

UPVC DOOR TO MATCH THE
EXISTING DWELLING

ROLLER SHUTTER DOOR TO
FRONT

SITE
85 SHIELDS AVENUE,
WORSBROUGH. S70 5BL

CLIENT
MR CARL DENTON

DRAWING TITLE
PROPOSED PLANS & ELEVATIONS
FOR DETACHED GARAGE

DRAWING NO. 60.02 SCALE 1:100 @A3

DATE 01/10/2021 REVISION /