
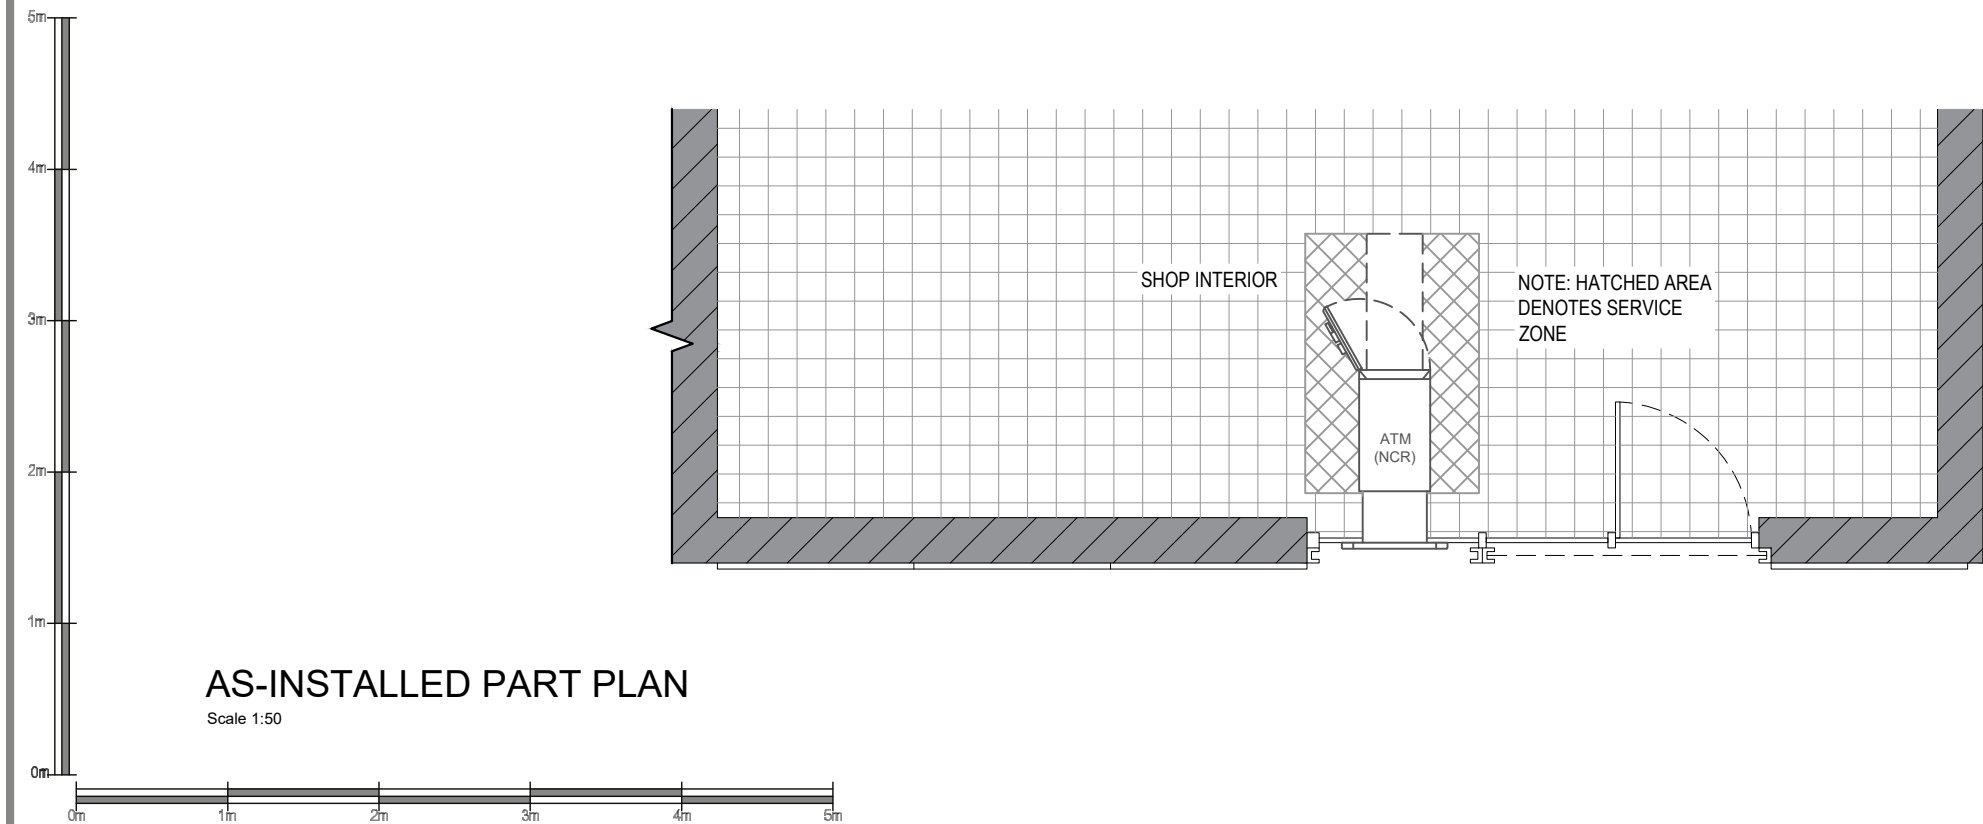


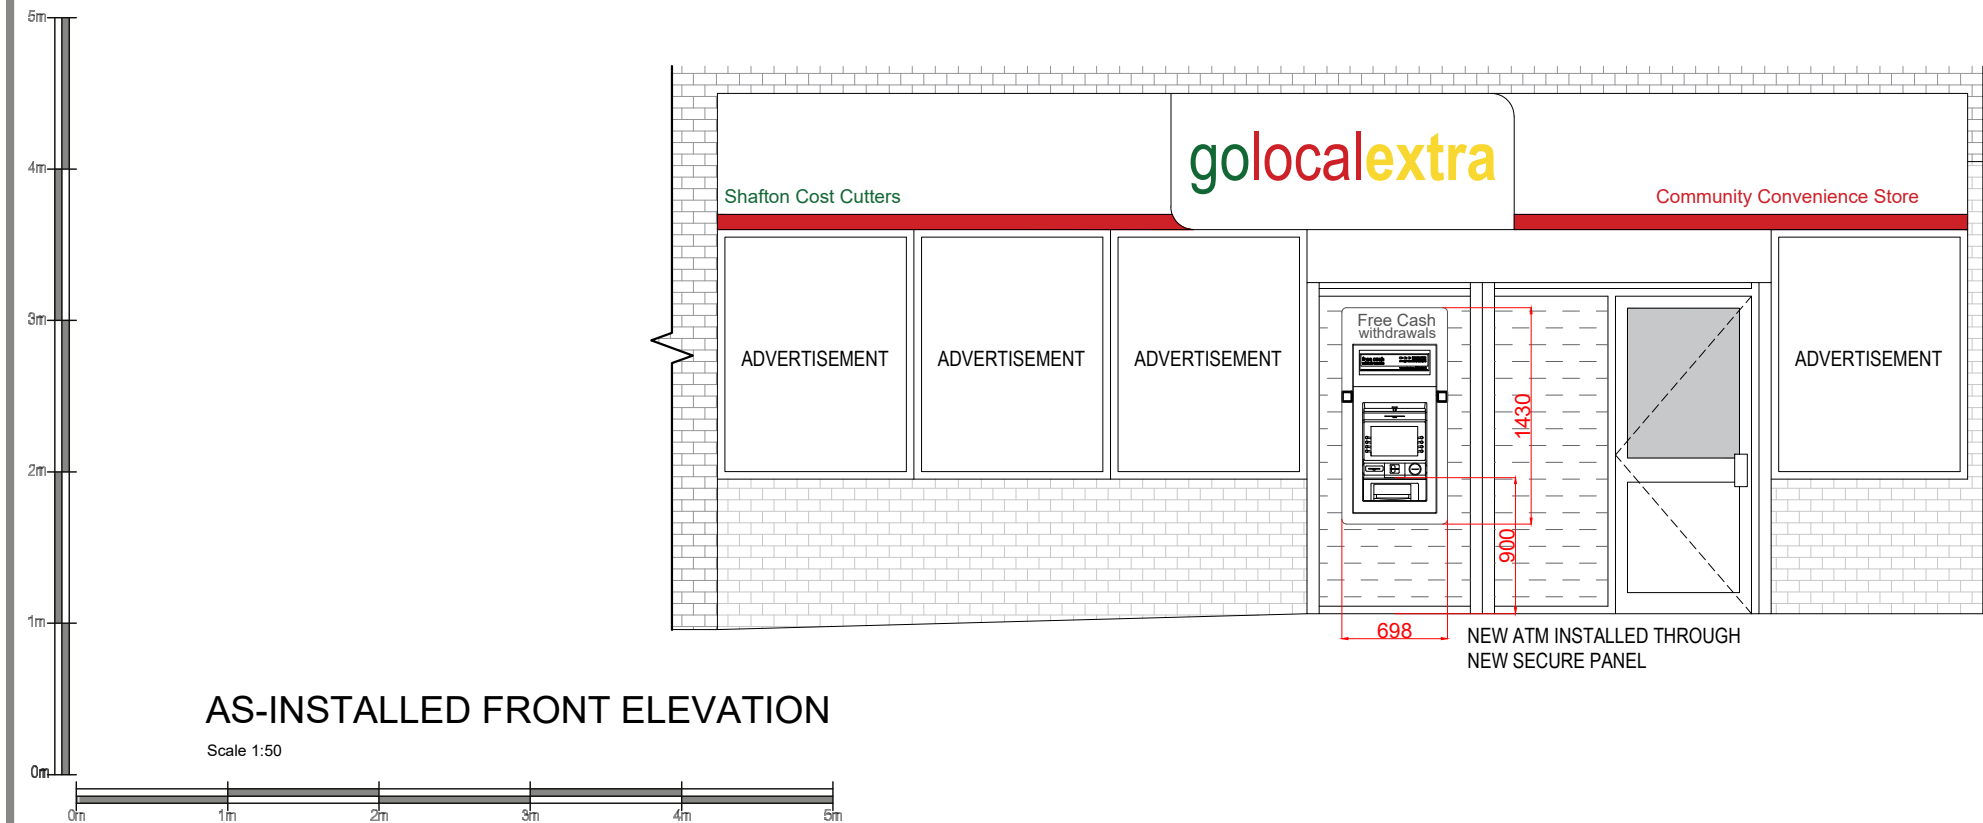

Date: Comments: By:

GENERAL NOTES:
1) All dimensions in millimeters unless otherwise stated.

Site:
Shafton Store (costcutter),
16-18 High Street,
Shafton,
Barnsley,
S72 8QB

Drawing Title:
As-Installed Plan and Elevation

Ref: 3477000_AI	Date: 31/08/2022	Rev:
Scale: 1:50	Paper: A3	Date Rev: