


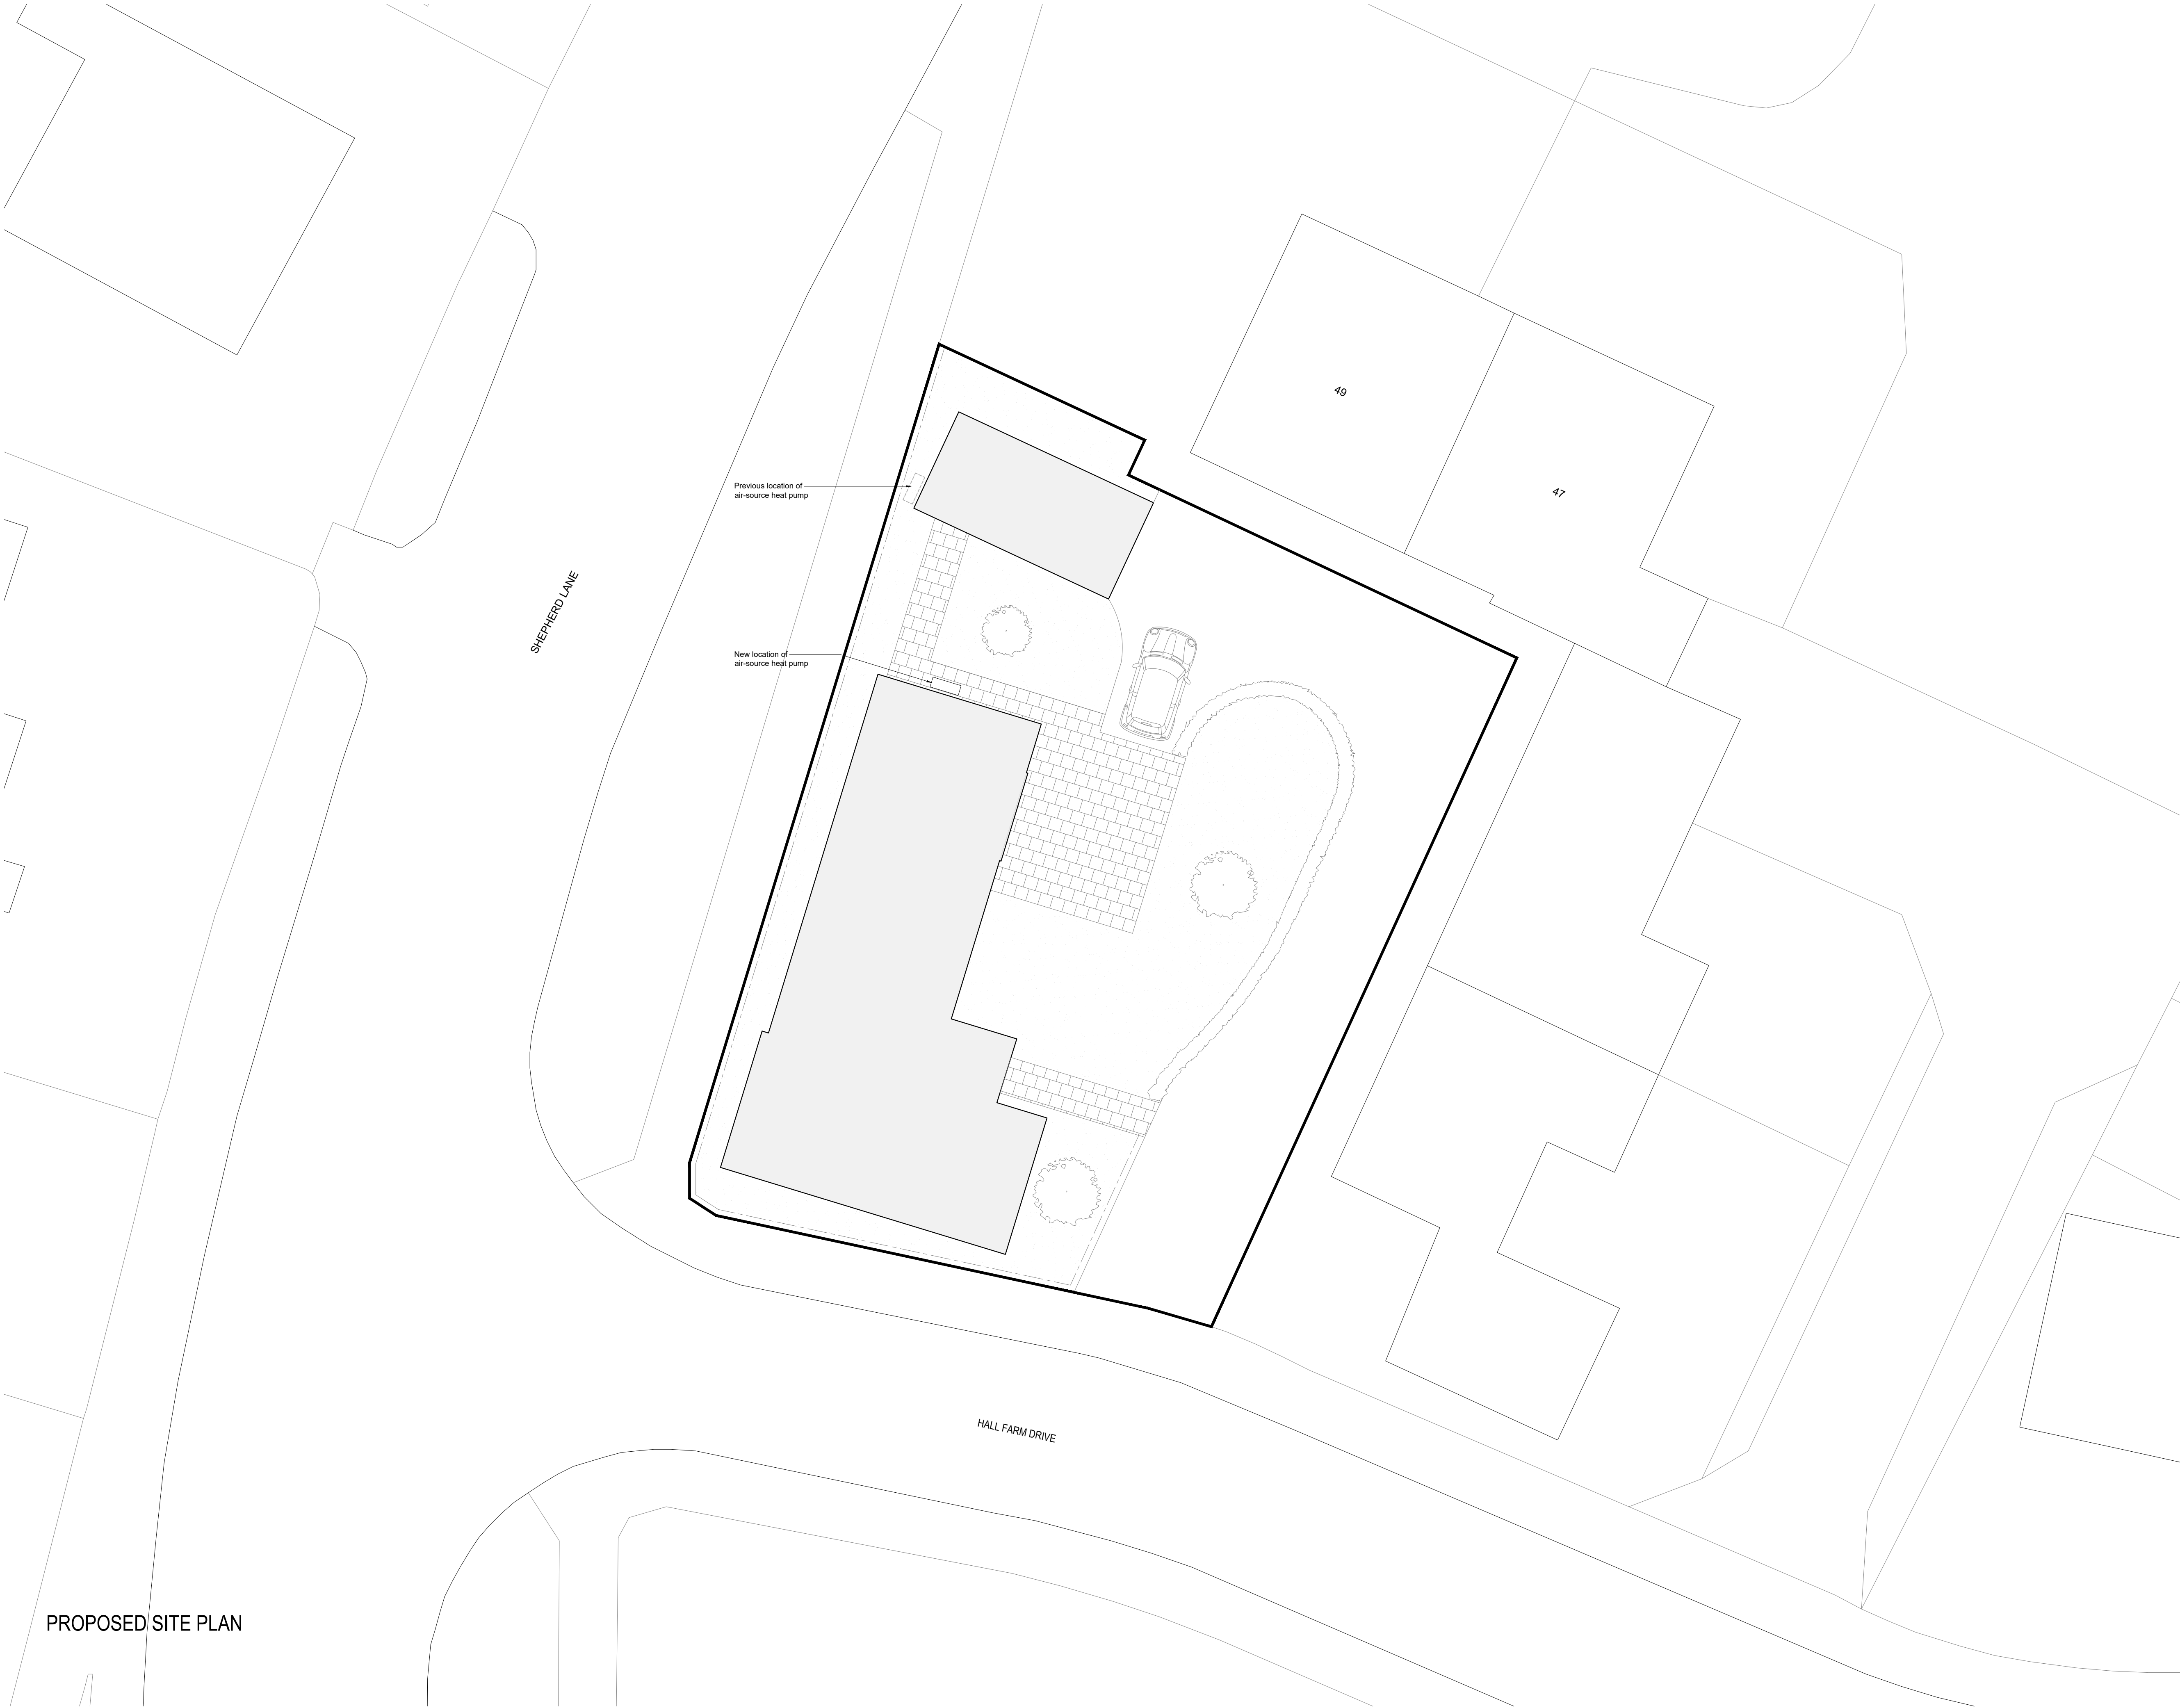

PROPOSED SITE PLAN

- Notes:**
- GENERAL NOTES
- G1 PLEASE READ THESE NOTES.
- G2 The existing drawings are generated from the client's as-built / record drawing and surveys by others. ALL DIMENSIONS MUST BE CHECKED AND VERIFIED ON SITE. Anomalies should be reported to Castle Owen Construction & Property Consultants Ltd prior to works progressing.
- G3 Do not scale off this drawing
- G4 This drawing is to be read in conjunction with all relevant architectural drawing and specifications, and all specialist consultants and / or sub-contractors drawings and designs. Further reference is to be made to existing as built records, site surveys and maintenance logs / registers.
- G5 Comply in all respects with the current Building Regulations, whether or not specifically stated on these drawings. If in doubt ask Castle Owen Construction & Property Consultants Ltd. All materials and workmanship shall comply with the relevant current Building Regulations and remain the responsibility of the Contractor.
- G6 The design does not indicate or co-ordinate direct supply elements, fittings, and/or furniture. Specific details of these installations should be obtained from the Project Manager, and co-ordinated on site.
- G7 Refer to the clients pre-construction information, and specifically the asbestos register and RAD survey PRIOR to undertaking works.

Note:

All existing soft landscaping and boundary treatments (unless stated otherwise) to be removed

P3	23-Sep-20	Revised air source heat pump location	JH
P2	24-May-19	Soft & hard landscaping details added	JMS
P1	09-Apr-19	Garage dimensions changed following comments from Highways	JMS

revisions

PLANNING



Unit 1, Hussar Court, Hillsborough Barracks, Sheffield S6 2GZ
T: 0114 233 1126 W: www.castleowen.com
E: contact@castleowen.com

P	- preliminary	T	- tender	R	- record
D	- design	C	- construction		

MR J WRIGHT & MISS L WHALE
NEW DWELLING SHEPHERD LANE - HALL
FARM DRIVE, THURNSCOE

PROPOSED SITE PLAN

scale	sheet	drawn	checked	date
1:100	A1	JMS	RO	28-Jan-19

job no	(category) dwg no	revision
--------	-------------------	----------

OP18-021 (06)001 P3

This drawing is the © of Castle Owen Construction and Property Consultants Ltd. If in doubt ASK. Drawing measurements must not be obtained by scaling. Verify all dimensions prior to construction. Immediately report any discrepancies on this drawing to Castle Owen Construction and Property Consultants Ltd. This drawing shall be read in conjunction with associated specifications and related consultant's documents.