


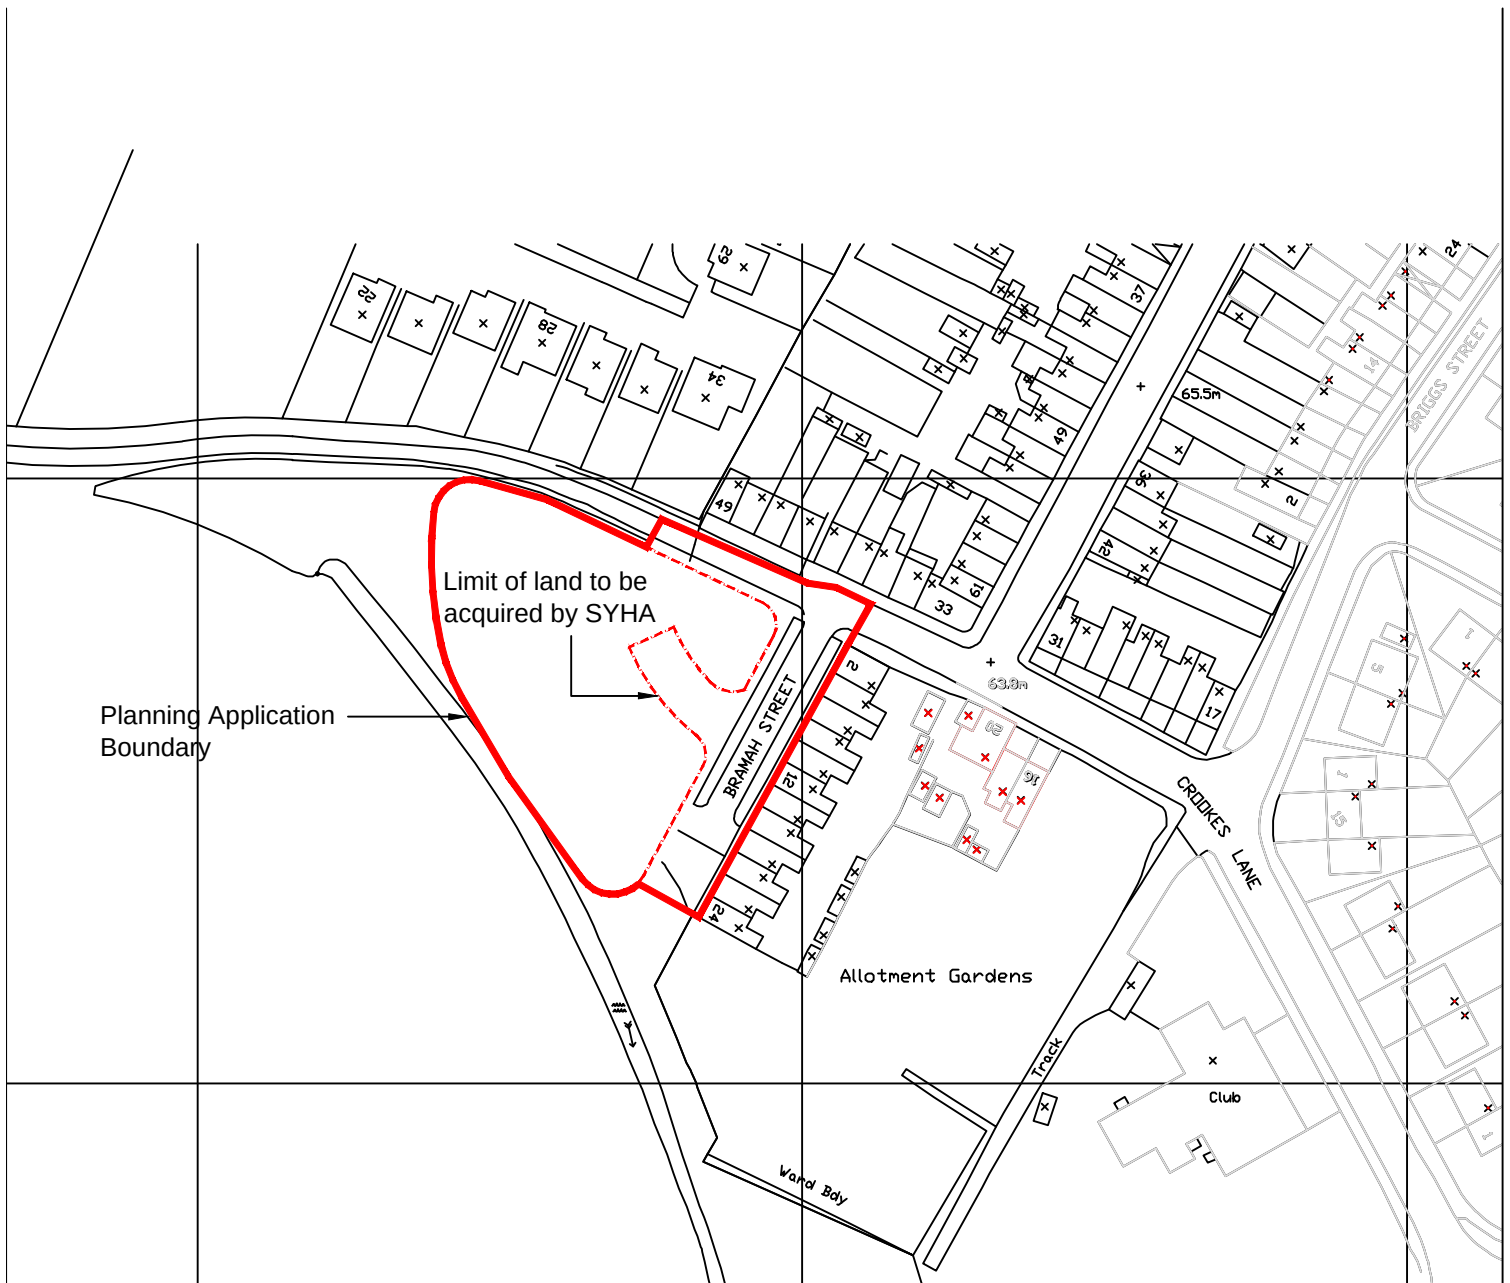

? Crown Copyright 2006. All rights reserved. Licence number 100020449

REVISION A - RED LINE AMENDED TO INCLUDE HIGHWAY
BROKEN LINE ADDED TO SHOW LAND ACQUIRED BY SYHA 14.12.09

General Notes

- 1) To be read in conjunction with specification / project drawings
- 2) Do not scale from this drawing. Check all dimensions on site and report any discrepancies to the architect.
- 3) All structural and drainage work to be to the satisfaction of DBS on site.
- 4) If in doubt, ask.

SYHA DRAWING CONTROL

Red by - STUART KING

Red on - 14/12/2009 15:51:25

Copyright: All rights reserved

SYHA Architects

43-47 Wellington Street tel: 0114 2900 278
Sheffield fax: 0114 2900 290
South Yorkshire web: www.syha.co.uk
S1 4HF

Creation Date 02/12/09	Job Bramah Street, Carlton, Barnsley
By RW	Client SYHA Development Section
Scale	Size Title



Dwg No
999 - 000