


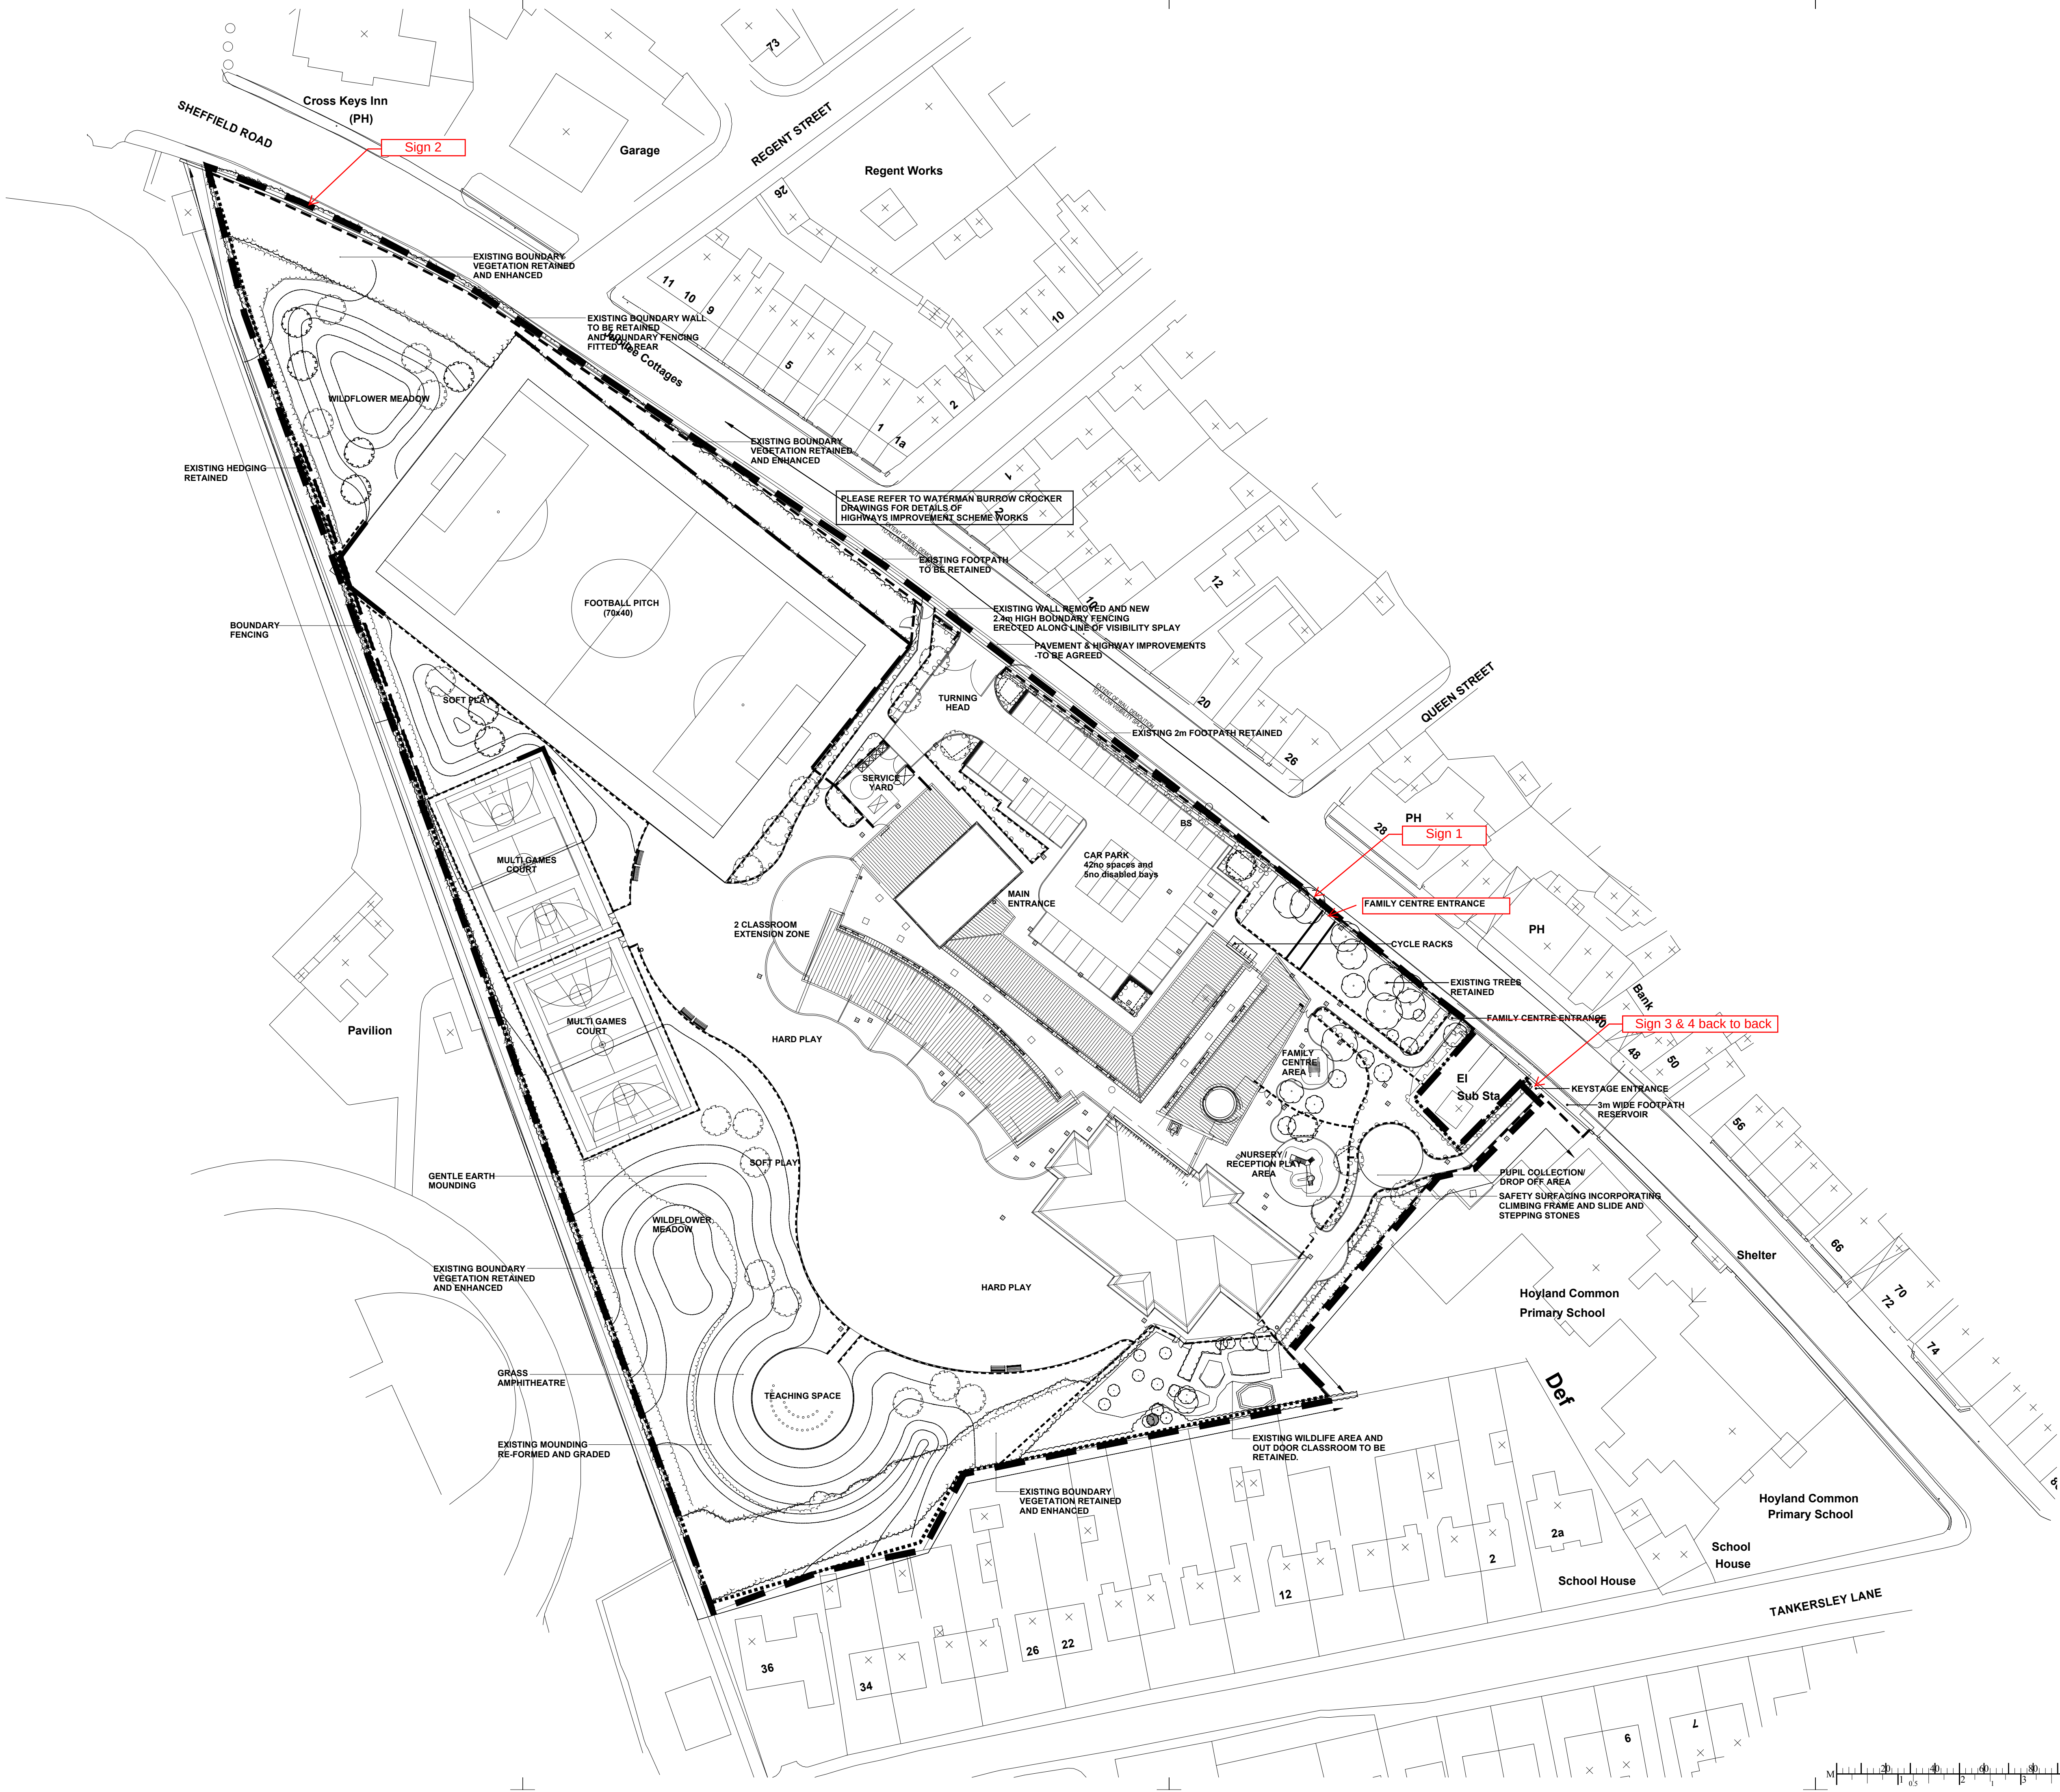

NOTES
Check all dimensions on site
Do not scale from this drawing
Report any discrepancies and omissions to HLM Architects
This Drawing is Copyright © HLM Architects

RECORD DRAWING
This issue records the latest revision of this drawing as prepared for construction purposes for architectural information only, amended relying upon information provided to HLM Architects by:
MOWLEM PLC
HLM Architects have had no inspection duties in this respect and cannot confirm the project was constructed entirely as shown and accept no liability for losses arising from any errors in, or omissions from the information provided.
For areas and sizes, any dimensions shown for construction should be checked on site.
For alterations, this drawing must be read in conjunction with the Health and Safety File, and the drawings of other consultants and specialists, and details checked on site prior to commencement."

R RECORD DRAWING - PHASE 1
STATUS NOTE ADDED

REVISIONS

title

GENERAL LANDSCAPE ARRANGEMENT

scale @ A1	1:500	drawn	AKO	R
date	17/01/2006	checked	ajt	
		date plotted	Fri Jan 19 16:22:08 2007	


project

**BARNSELY SCHOOLS
PFI**

school

HOYLAND COMMON

client

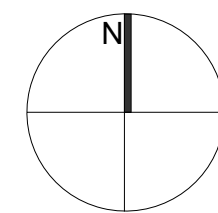

HLM ARCHITECTS

2nd Floor, The Ruskin Building,
Tudor Square, SHEFFIELD S1 2LA
Tel: 0114 263 9600 Fax: 0114 263 9650

LONDON GUILDFORD SHEFFIELD GLASGOW BELFAST

HLMAD LTD

