
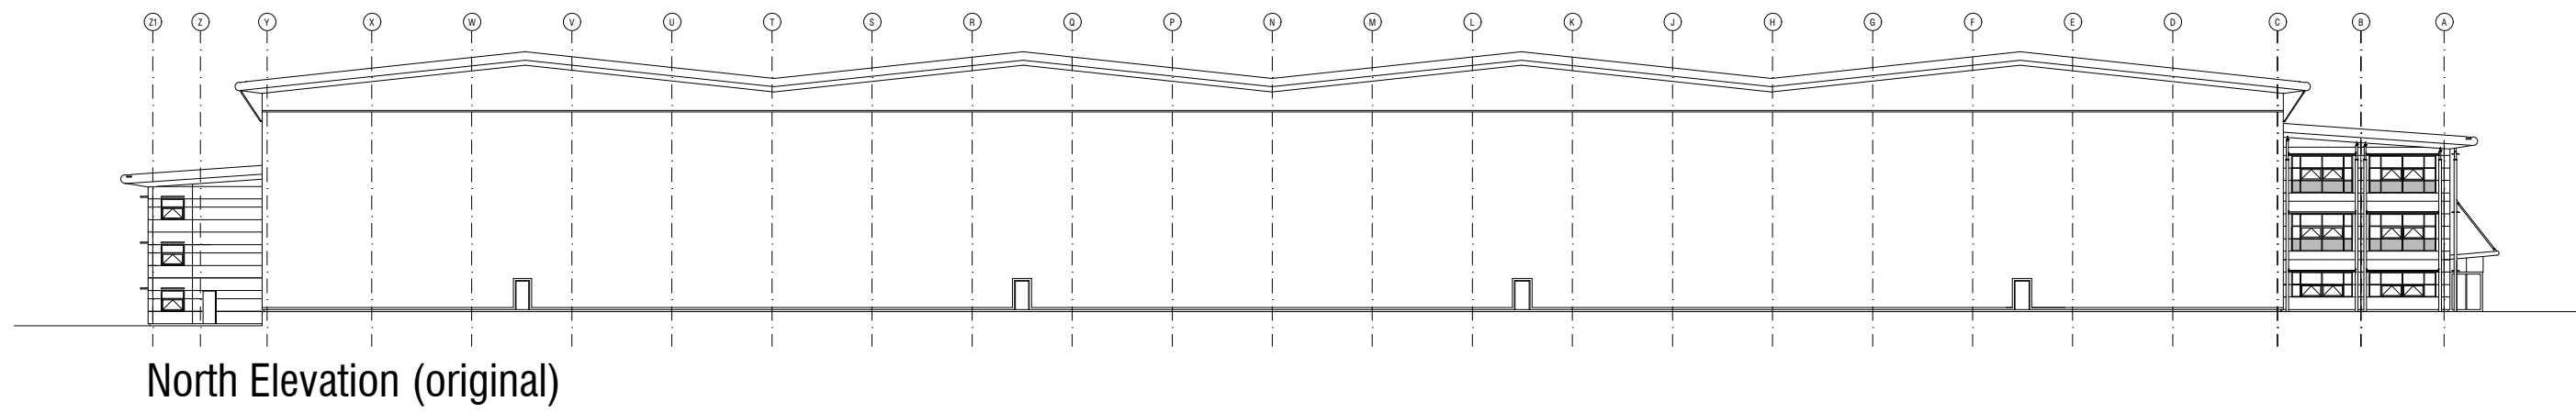
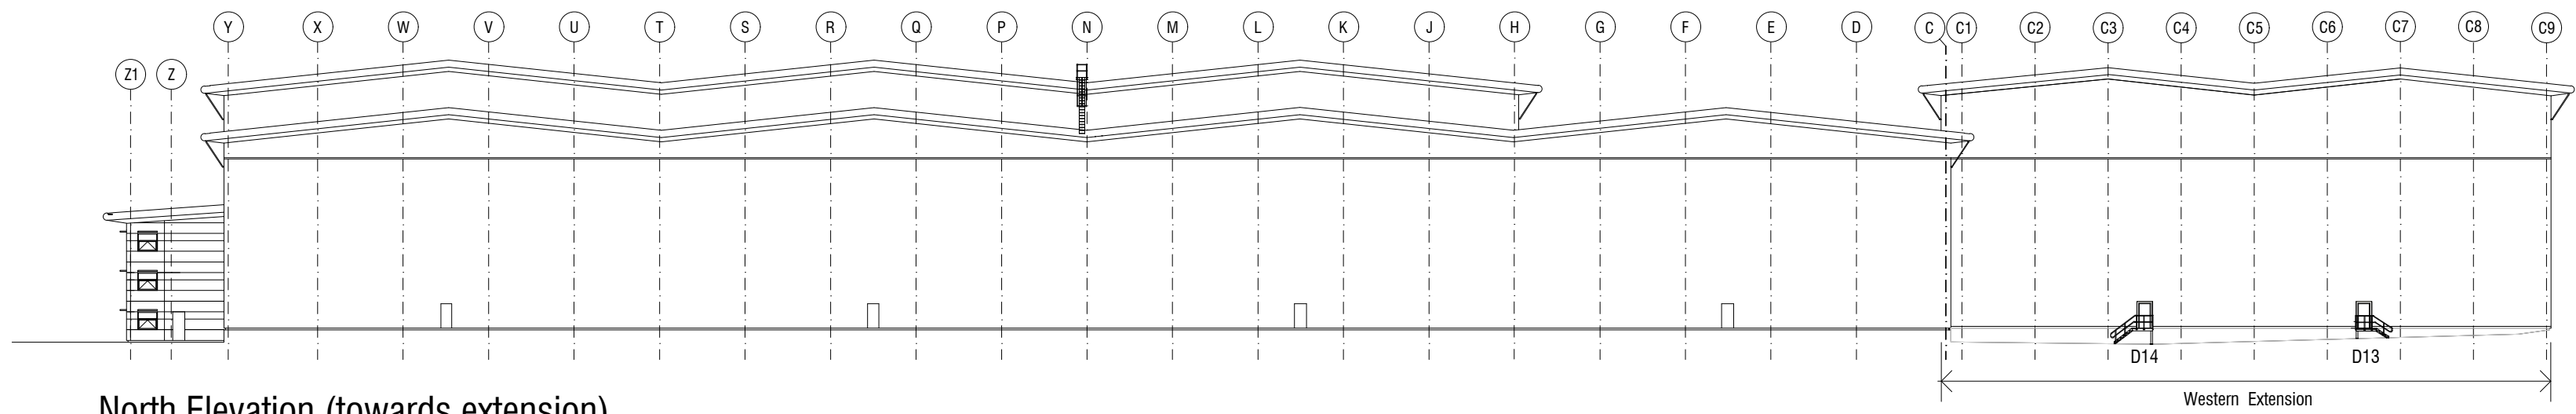
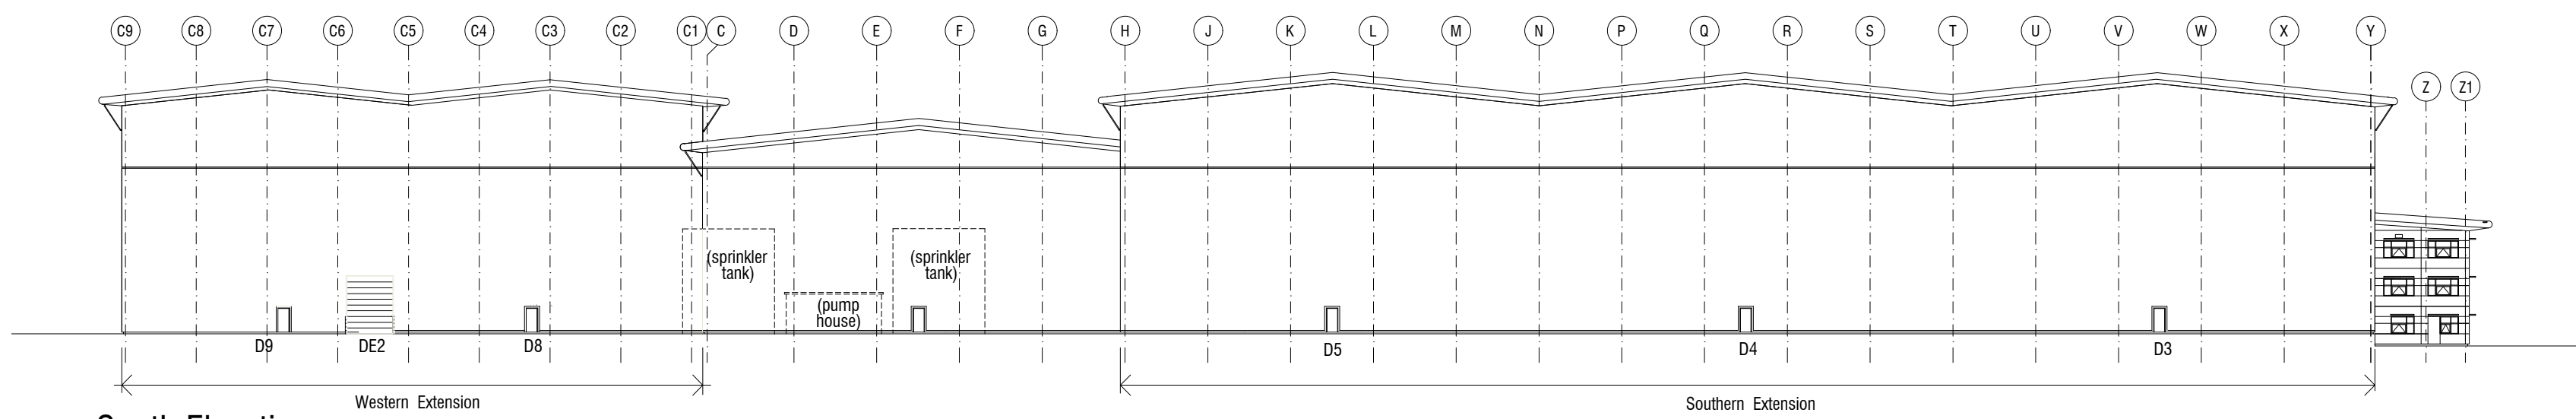
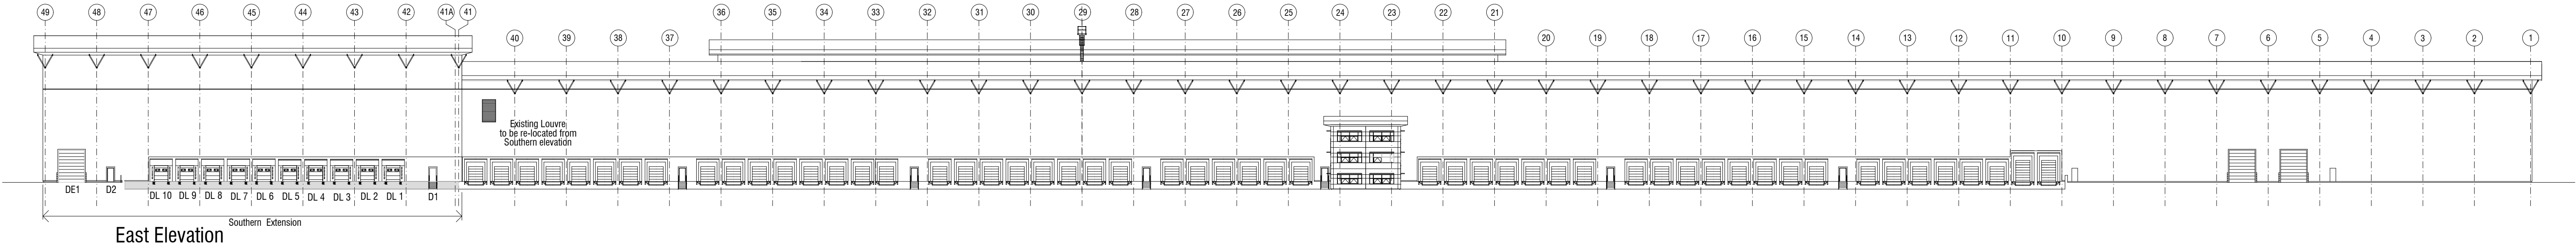


IF IN DOUBT PLEASE ASK!

notes:
this drawing and design is the copyright of aja architects llp and must not be reproduced in part or in whole without prior written consent. contractors must verify all dimensions on site before commencing work or preparing shop drawings

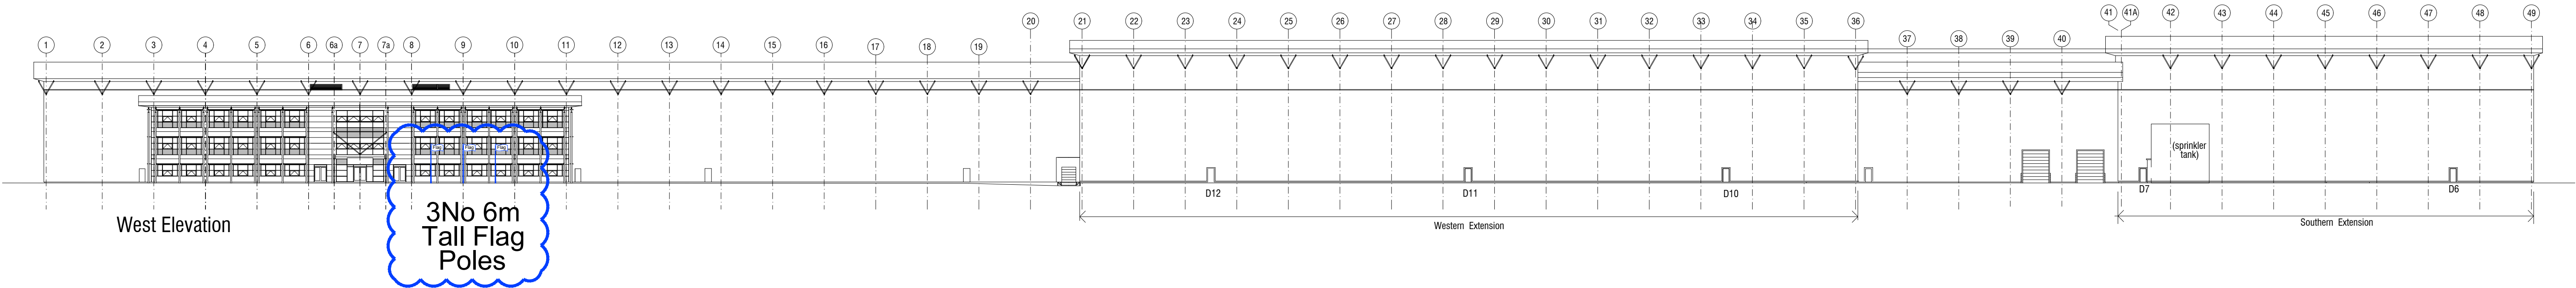

COLOUR LEGEND:

- New Additions
- Previous Objects Now Different (dashed line)
- Proposed Flag Poles
- Denotes Site Boundary

R1:06.01.16: Signage omitted for purpose of Flag Pole Only
Planning Application

no. date revision by



aja architects llp
1170 Elliott Court
Herald Avenue
Coventry Business Park
COVENTRY CV5 6UB
T: 024 7625 3200
F: 024 7625 3210
E: aja@aja-architects.com
W: www.aja-architects.com

aja architects llp is a limited liability partnership registered in England No. OC326721
client



project
LICENCE TO ALTER
ASOS.COM
HOULTON MAIN
SOUTH YORKSHIRE
drawing title

EXTERNAL ELEVATIONS

Sheet 1 of 1

scale 1:500@A1 drawn RPW

checked date 22.12.15

drawing no

5742 - 1011 - R1

RECORD DRAWING