


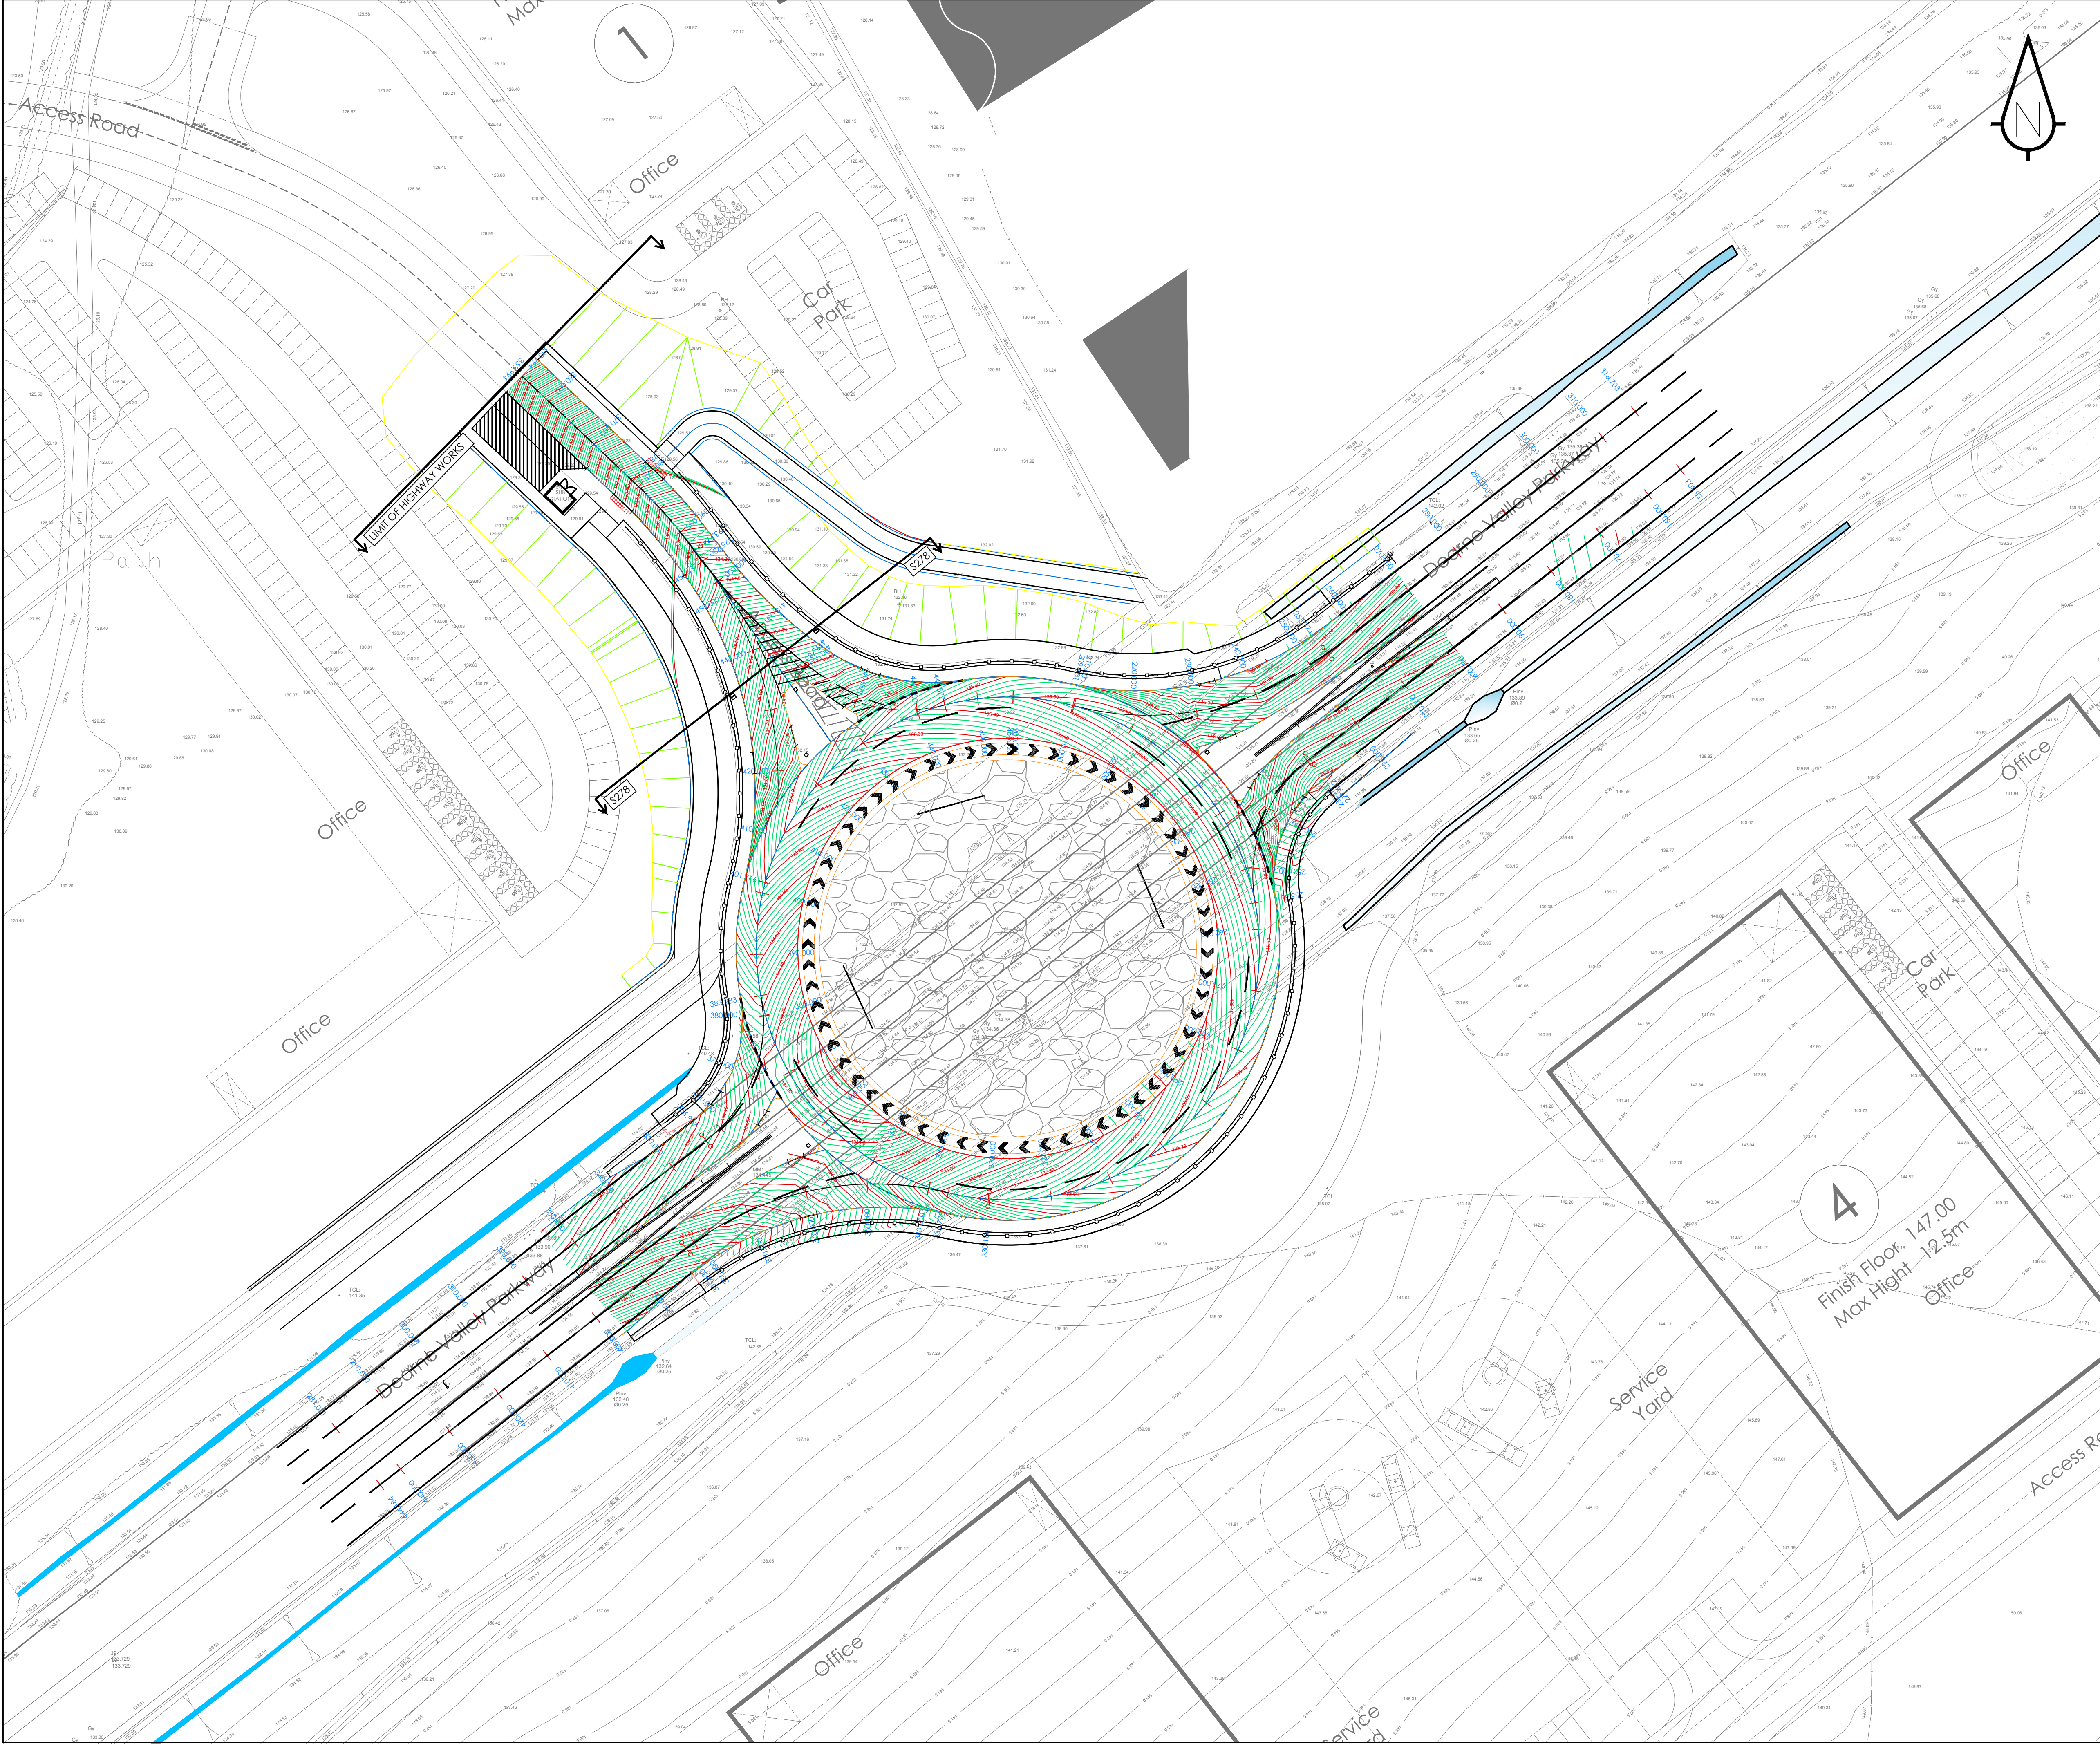

GENERAL NOTES

1. ALL MATERIALS AND WORKMANSHIP IS TO COMPLY WITH SA CONSULTANTS STANDARD SPECIFICATION & ALL RELEVANT BRITISH & EUROPEAN STANDARDS.
2. THIS DRAWING IS TO BE READ IN CONJUNCTION WITH ALL RELEVANT ARCHITECTS, M & E CONSULTANTS AND SA CONSULTANTS DRAWINGS.
3. ANY DISCREPANCIES SHOULD BE REPORTED TO THE ENGINEER IMMEDIATELY SO THAT CLARIFICATION CAN BE SOUGHT PRIOR TO COMMENCEMENT OF WORKS.
4. THE TOPOGRAPHICAL SURVEY INFORMATION USED IN PREPARATION OF THIS AND ALL OTHER SA DESIGNS AND DRAWINGS IS NOT WARRANTED. IT SHALL BE THE RESPONSIBILITY OF THE CONTRACTOR TO VERIFY ALL SURVEY INFORMATION PROVIDED AND REPORT ANY ANOMALIES TO SA.

Rev	Amendment	Drawn	Date	Checked
D	AS BUILT LAYOUT AND CONTOURS UPDATED	TOD	01/04/22	PJM
C	LAYOUT AND CONTOURS UPDATED	LOB	19/05/21	PJM
B	LAYOUT AND CONTOURS UPDATED	LOB	21/05/21	PJM
A	LAYOUT AND CONTOURS UPDATED	LOB	21/01/21	PJM

AS BUILT
DRAWING



Client
Harworth Group

Project Title
Rockingham Phase 2A & 2B,
Hoyland

Drawing Title
Section 278 Contours

Scale	1:500	Drawn By	LOB
Drawing Size	A1	Checked By	PJM
Date	24/11/2020	Approved By	KS

Drawing Number	Rev
11700-S278-004	D