
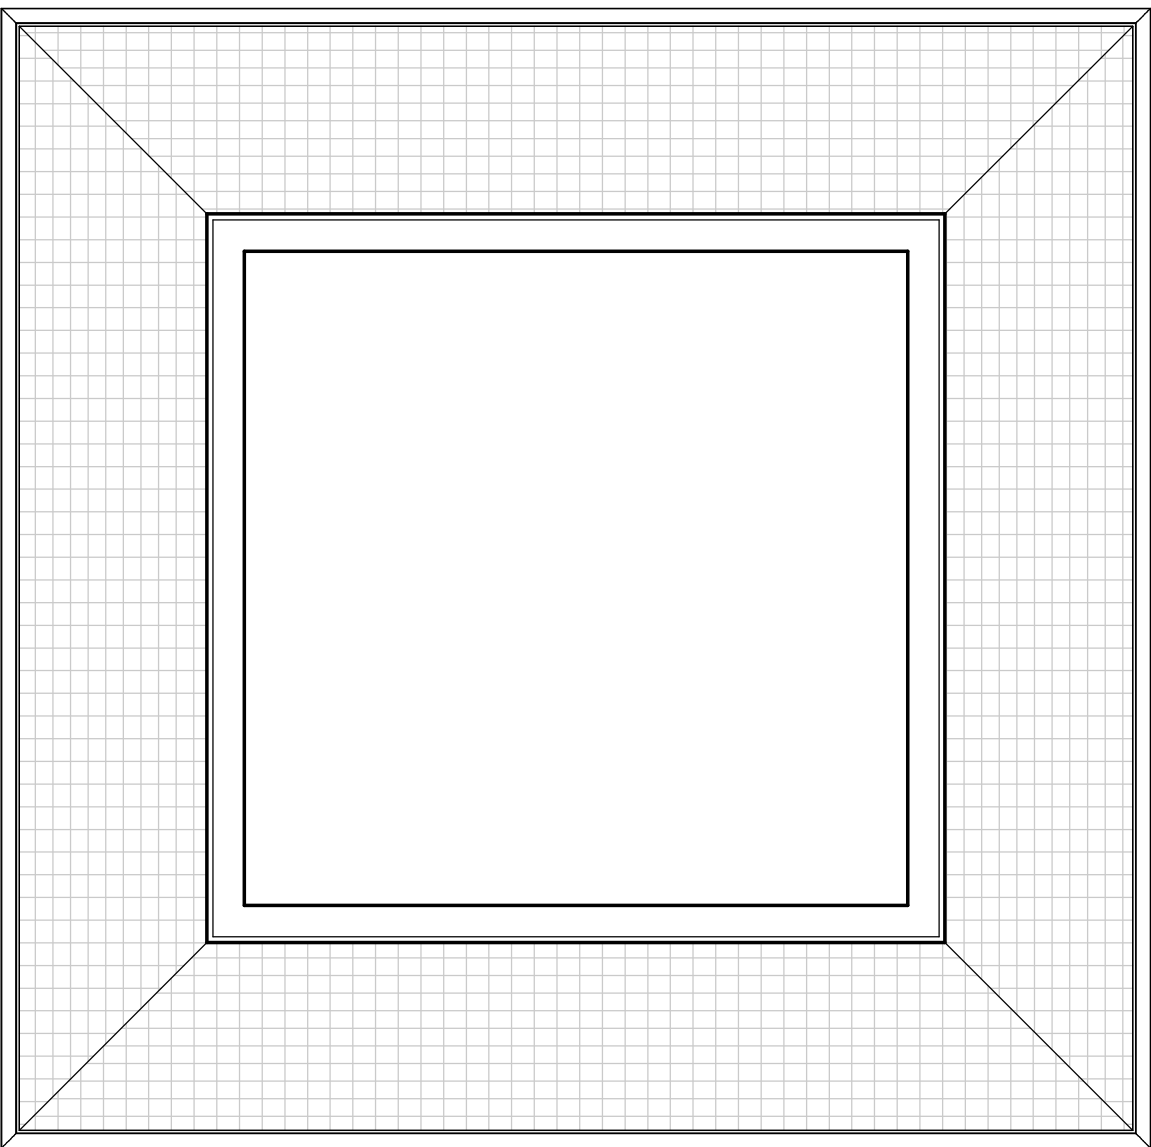
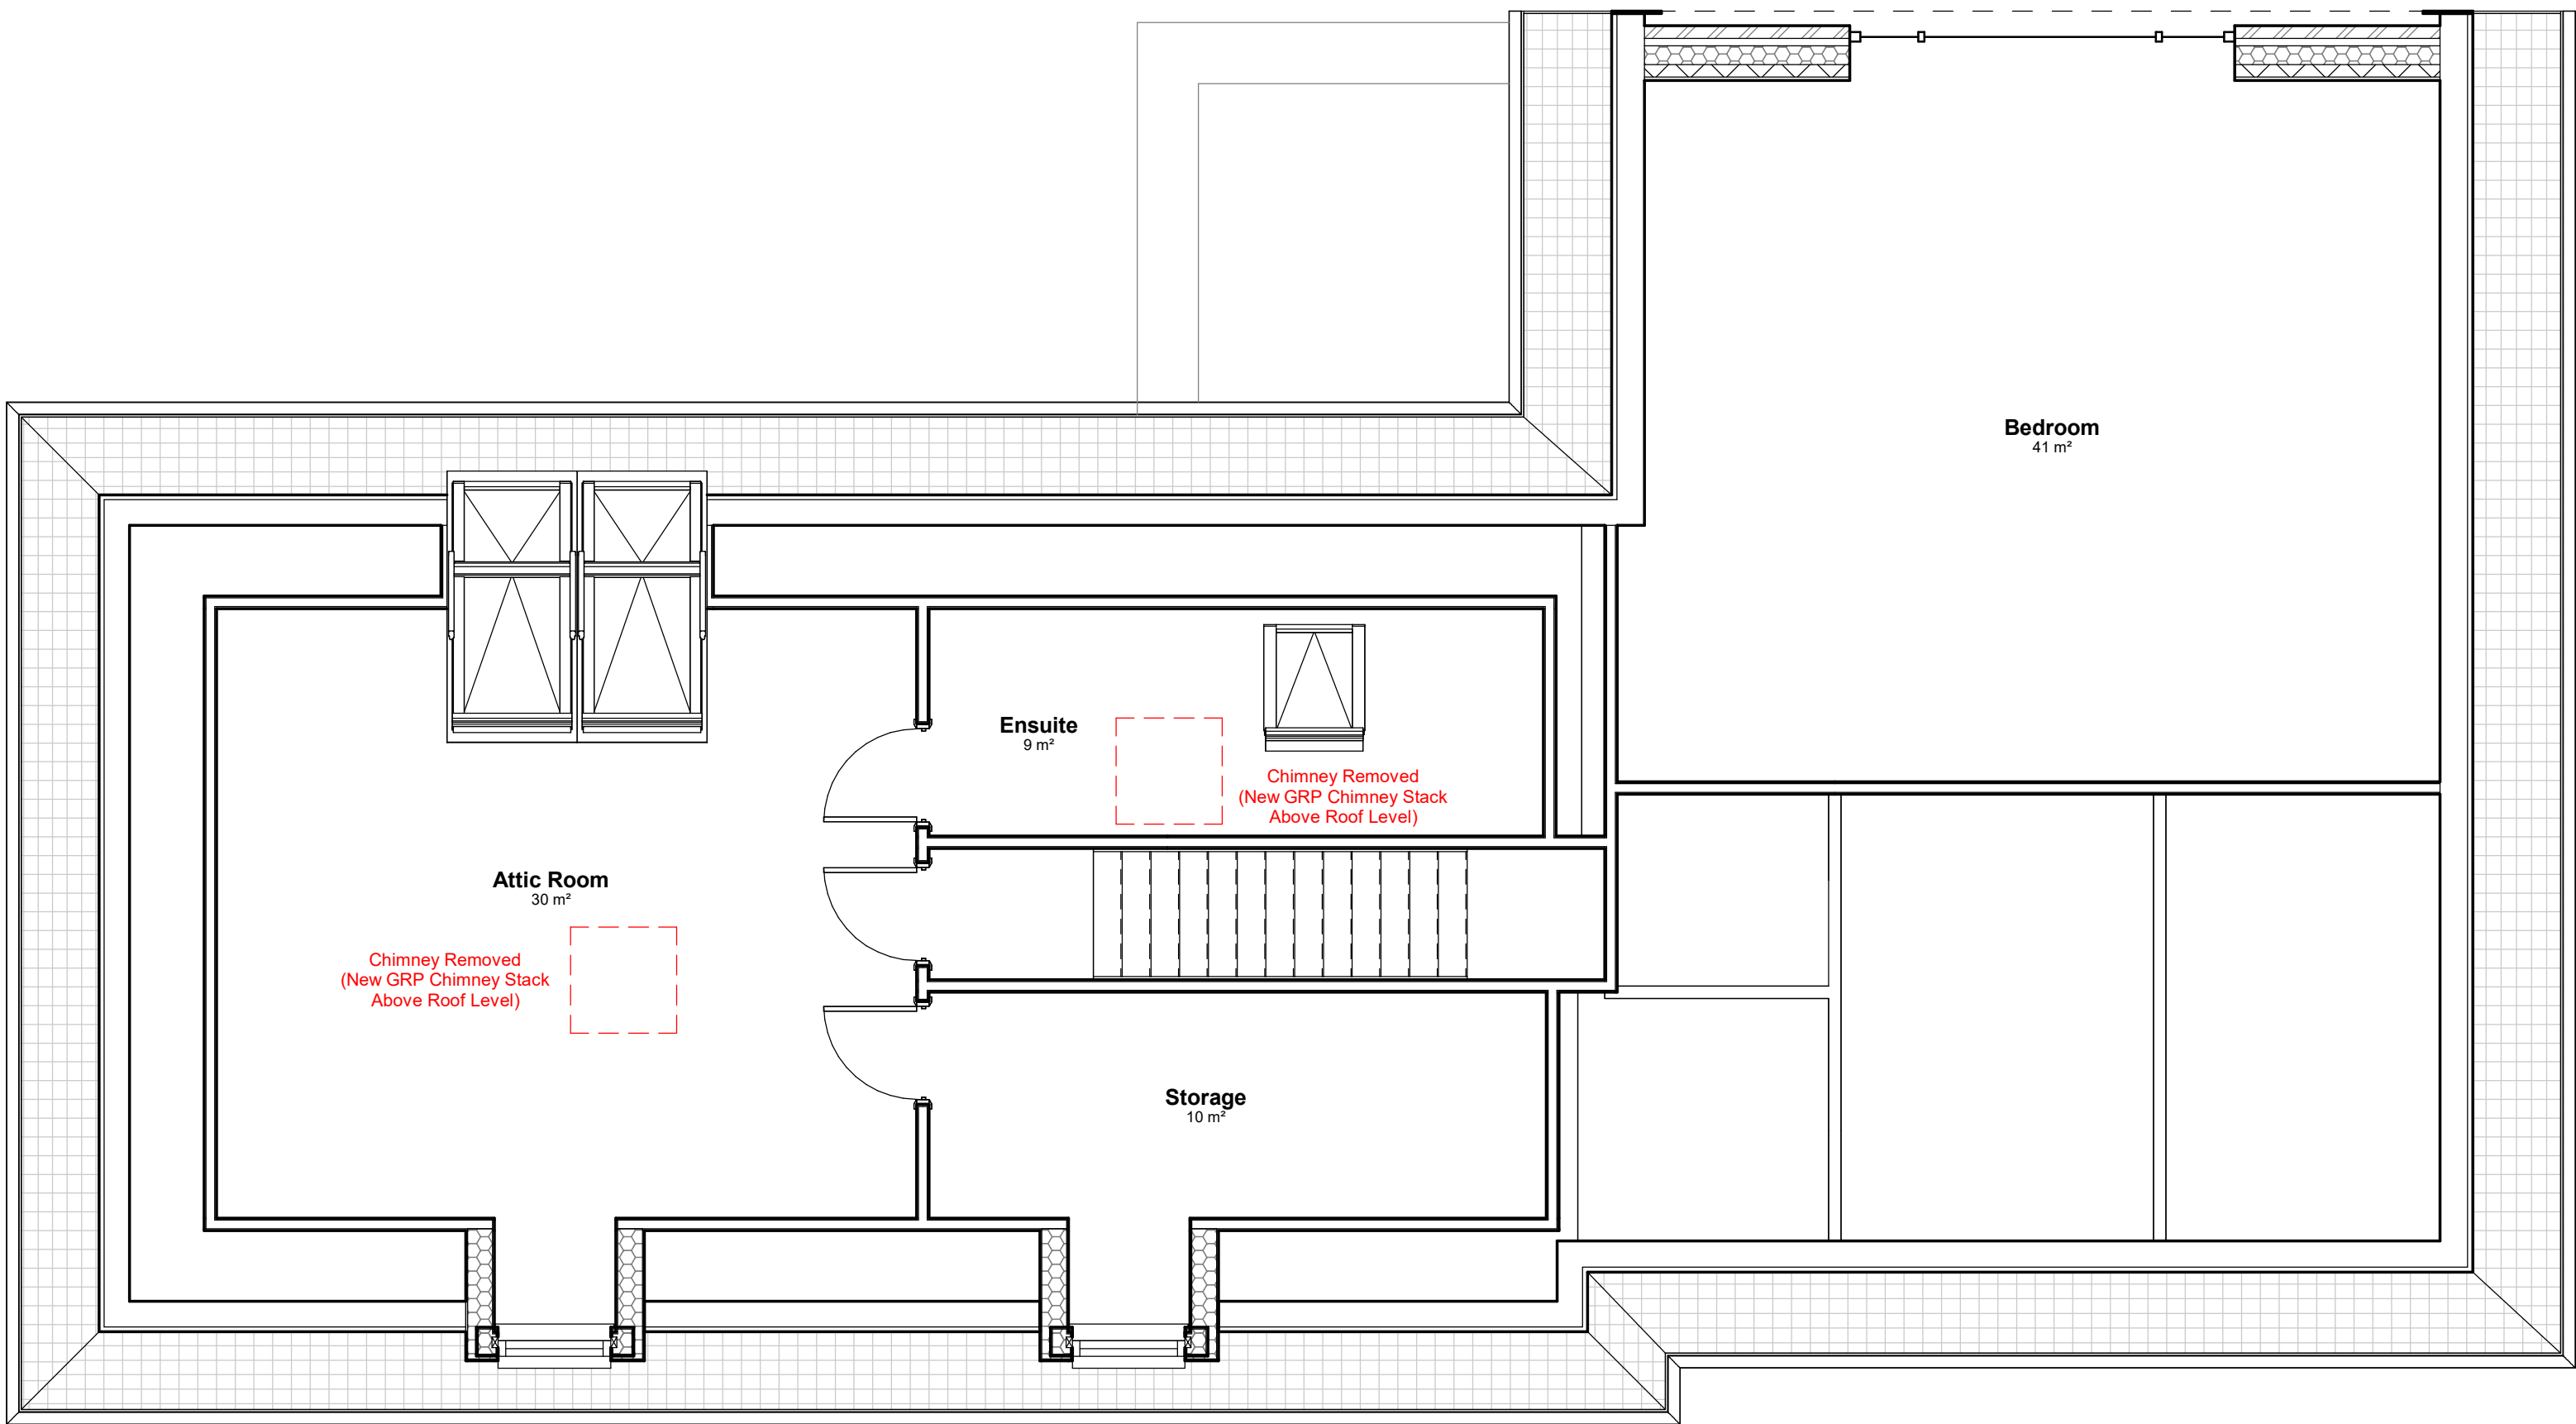


Do not scale from this drawing.
The contractor is to check all dimensions on site and report any discrepancies to the designer.
All rights described in chapter IV of the copyright, designs and patents act 1988 have been generally asserted.

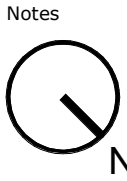

1 Attic
1 : 50

P3	Drawing issued for dormer window planning application.	22.09.26	CJR	JL
P2	Drawings/model updated following receipt of structural engineers markup.	27.08.26	CJR	JL
P1	Initial Issue	12.06.26	CJR	JL
Rev	Description	Date	By	Chk

STUDIO SEVENTY FIVE
www.studioseventyfive.co.uk
hello@studioseventyfive.co.uk

Project
53 Keresforth Hall Road,
Barnsley S70 6NL

Drawing
Proposed Attic Floor Plan

Scale 1 : 50 @ A1	Drawn CJR	Date 23/04/26
Drawing Purpose PLANNING APPLICATION		Status
Drawing Number 2605-S75-XX-02-DR-A-20000		Rev. P3