


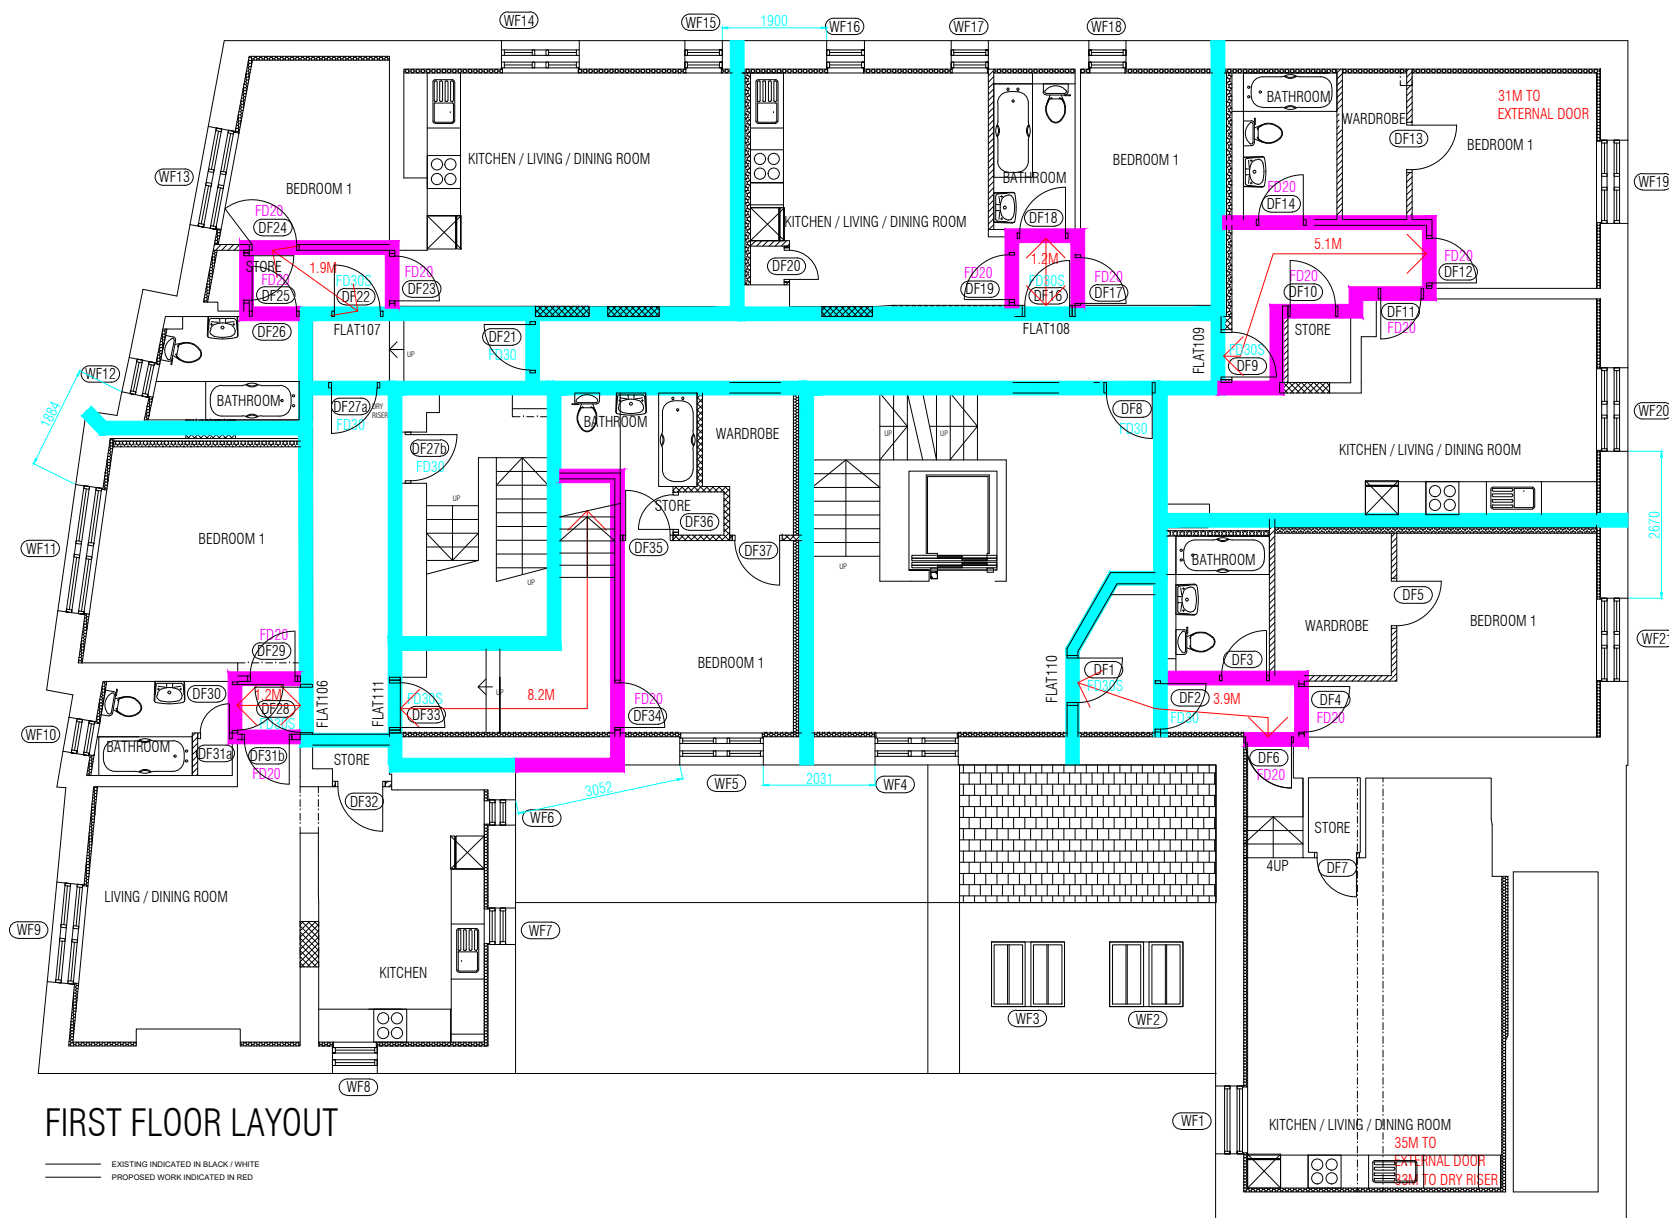

FIRST FLOOR LAYOUT

EXISTING INDICATED IN BLACK / WHITE
PROPOSED WORK INDICATED IN RED

FIRE RESISTANCE KEY

60 MINUTE FIRE RESISTANCE;
ENSURE / UPGRADE WALL FULL
HEIGHT COMPARTMENT WALL

30 MINUTE FIRE RESISTANCE;
ENSURE / UPGRADE WALL

60 MINUTE FIRE RESISTANCE TO
ALL CEILINGS AT GROUND, FIRST,
SECOND & THIRD (INCLUDING
WHERE SPACE DIRECTLY
ADJACENT IS TO AN INTERNAL
VOID)

COMMUNAL AREA DOORS, STAFF
DOORS & FLAT ENTRANCE
DOORS TO HAVE SELF CLOSERS



ARCUS CONSULTING LLP
Walsley 0192 486 8000 Manchester 0161 955 3222 London 0208 8742 2612
Liverpool 0151 708 1080 Newcastle 0191 272 5761 Rugby 01788 251 127
info@arcus.co.uk www.arcus.co.uk

Client
RIVERSIDE

Project
BEDSITS TO FLATS
HOLDEN HOUSE, 2 RACE STREET, BARNSELY, S70 1BG

Title
FIRE STRATEGY (SUBJECT TO APPROVAL BY BUILDING CONTROL)
FIRST FLOOR LAYOUT

Scale	Date	Stage
1:50	NOV 19	WORKING DWG
Job No	Drawing No	Rev
6078	32	AS INDICATED
Drawn	Approved	
NW	AR	

This drawing is the copyright of Arcus. Contractors must check all dimensions on site. Do not scale the drawings. Only figured dimensions are to be worked to.