



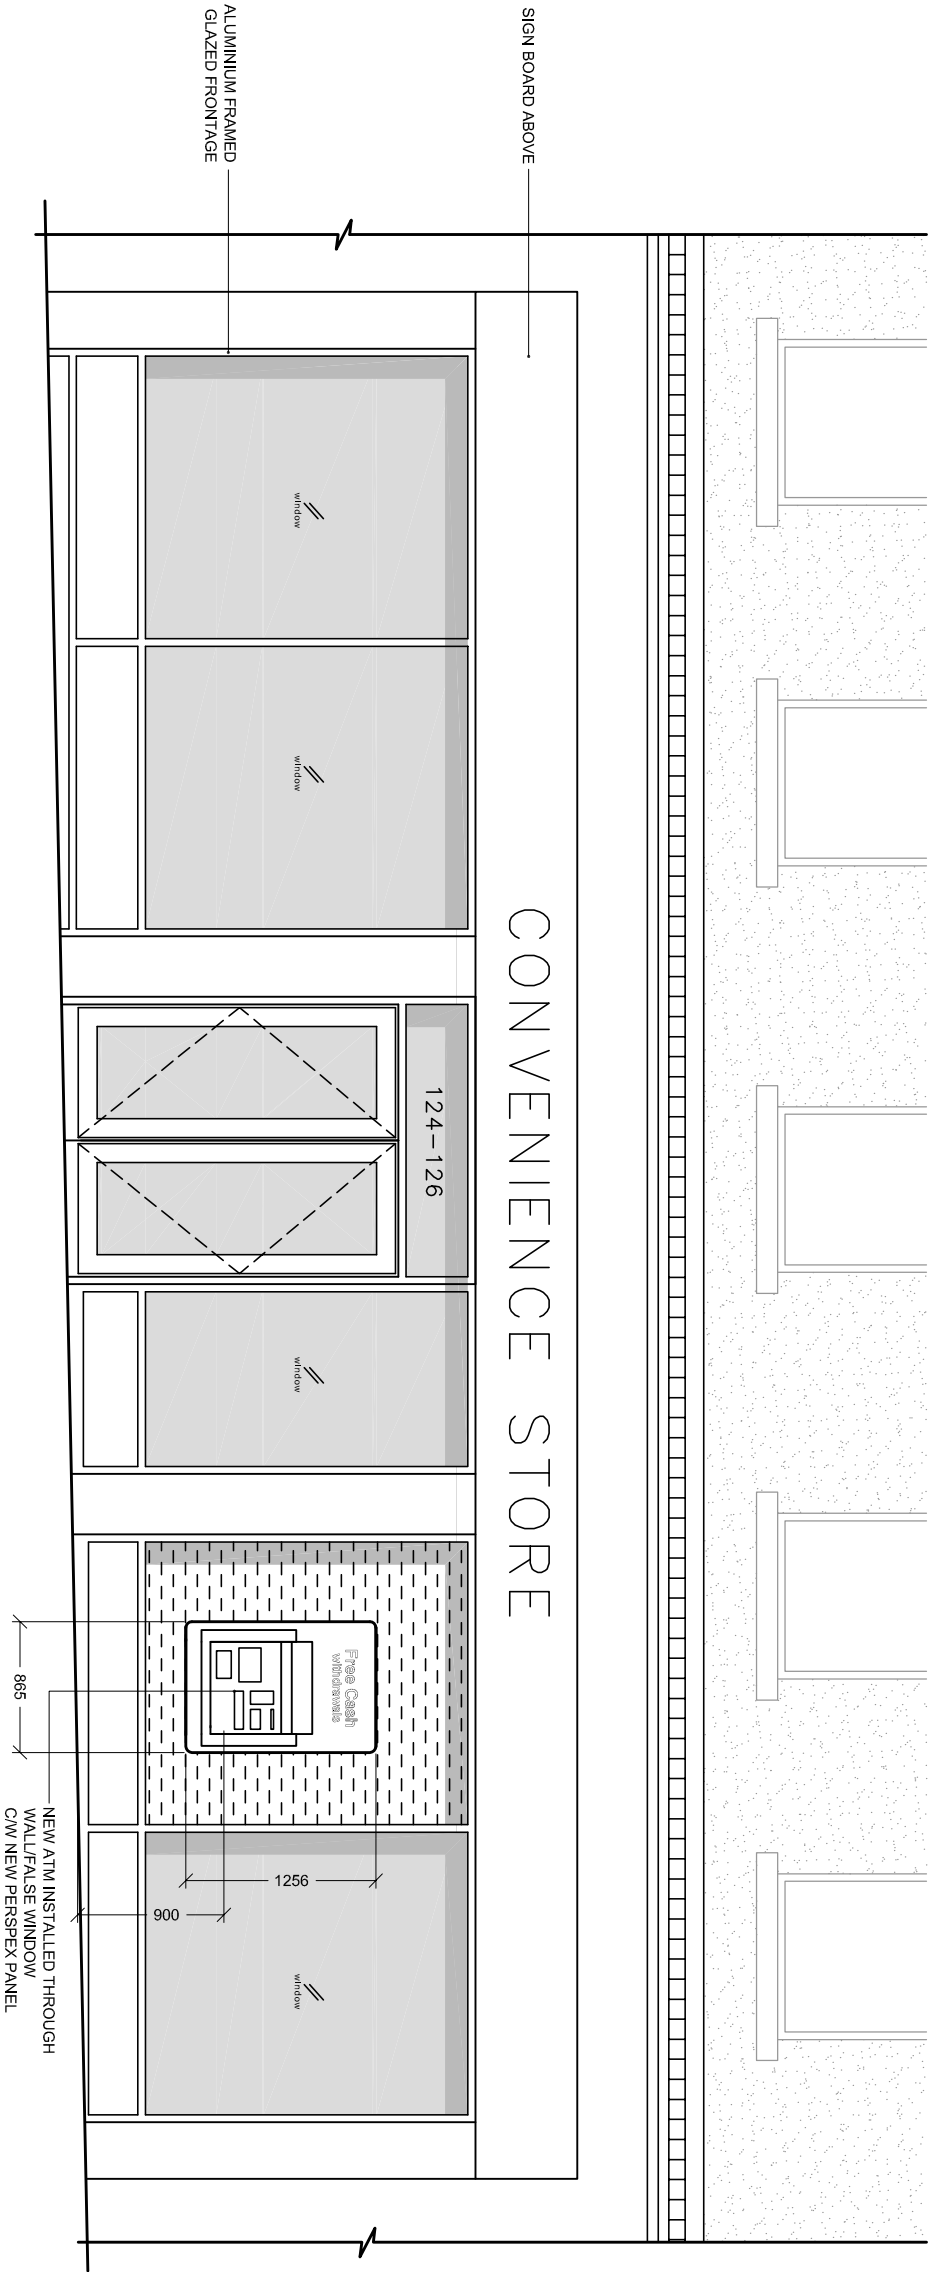

AS INSTALLED FRONT ELEVATION
Scale 1:50

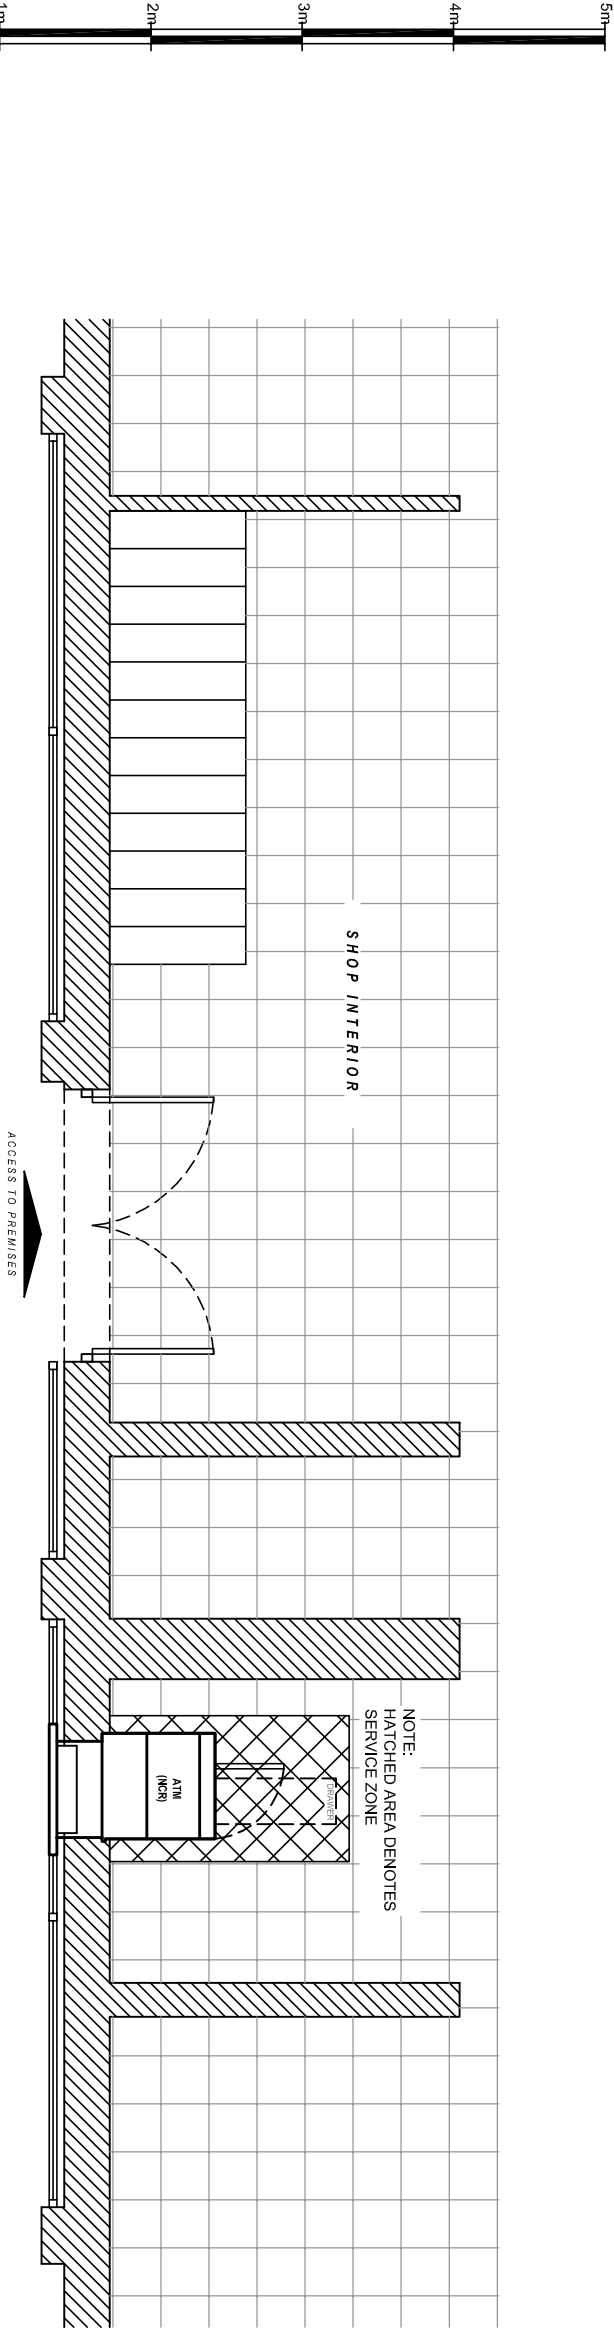

AS INSTALLED PART PLAN
Scale 1:50

Date:		Comments:		By:	
GENERAL NOTES:					
1) All dimensions in millimeters unless otherwise stated					
Site: FAMILY SHOPPER Princess Theatre, West Street, Hoyland, Barnsley, S74 9DU					
Drawing Title: As Installed Elevation and Plan					
Ref:	Date:	Rev:			
NM-12-2014-19-1	10-12-2014				
Scale:	Paper:	Date Rev:			
1:50	A3				