


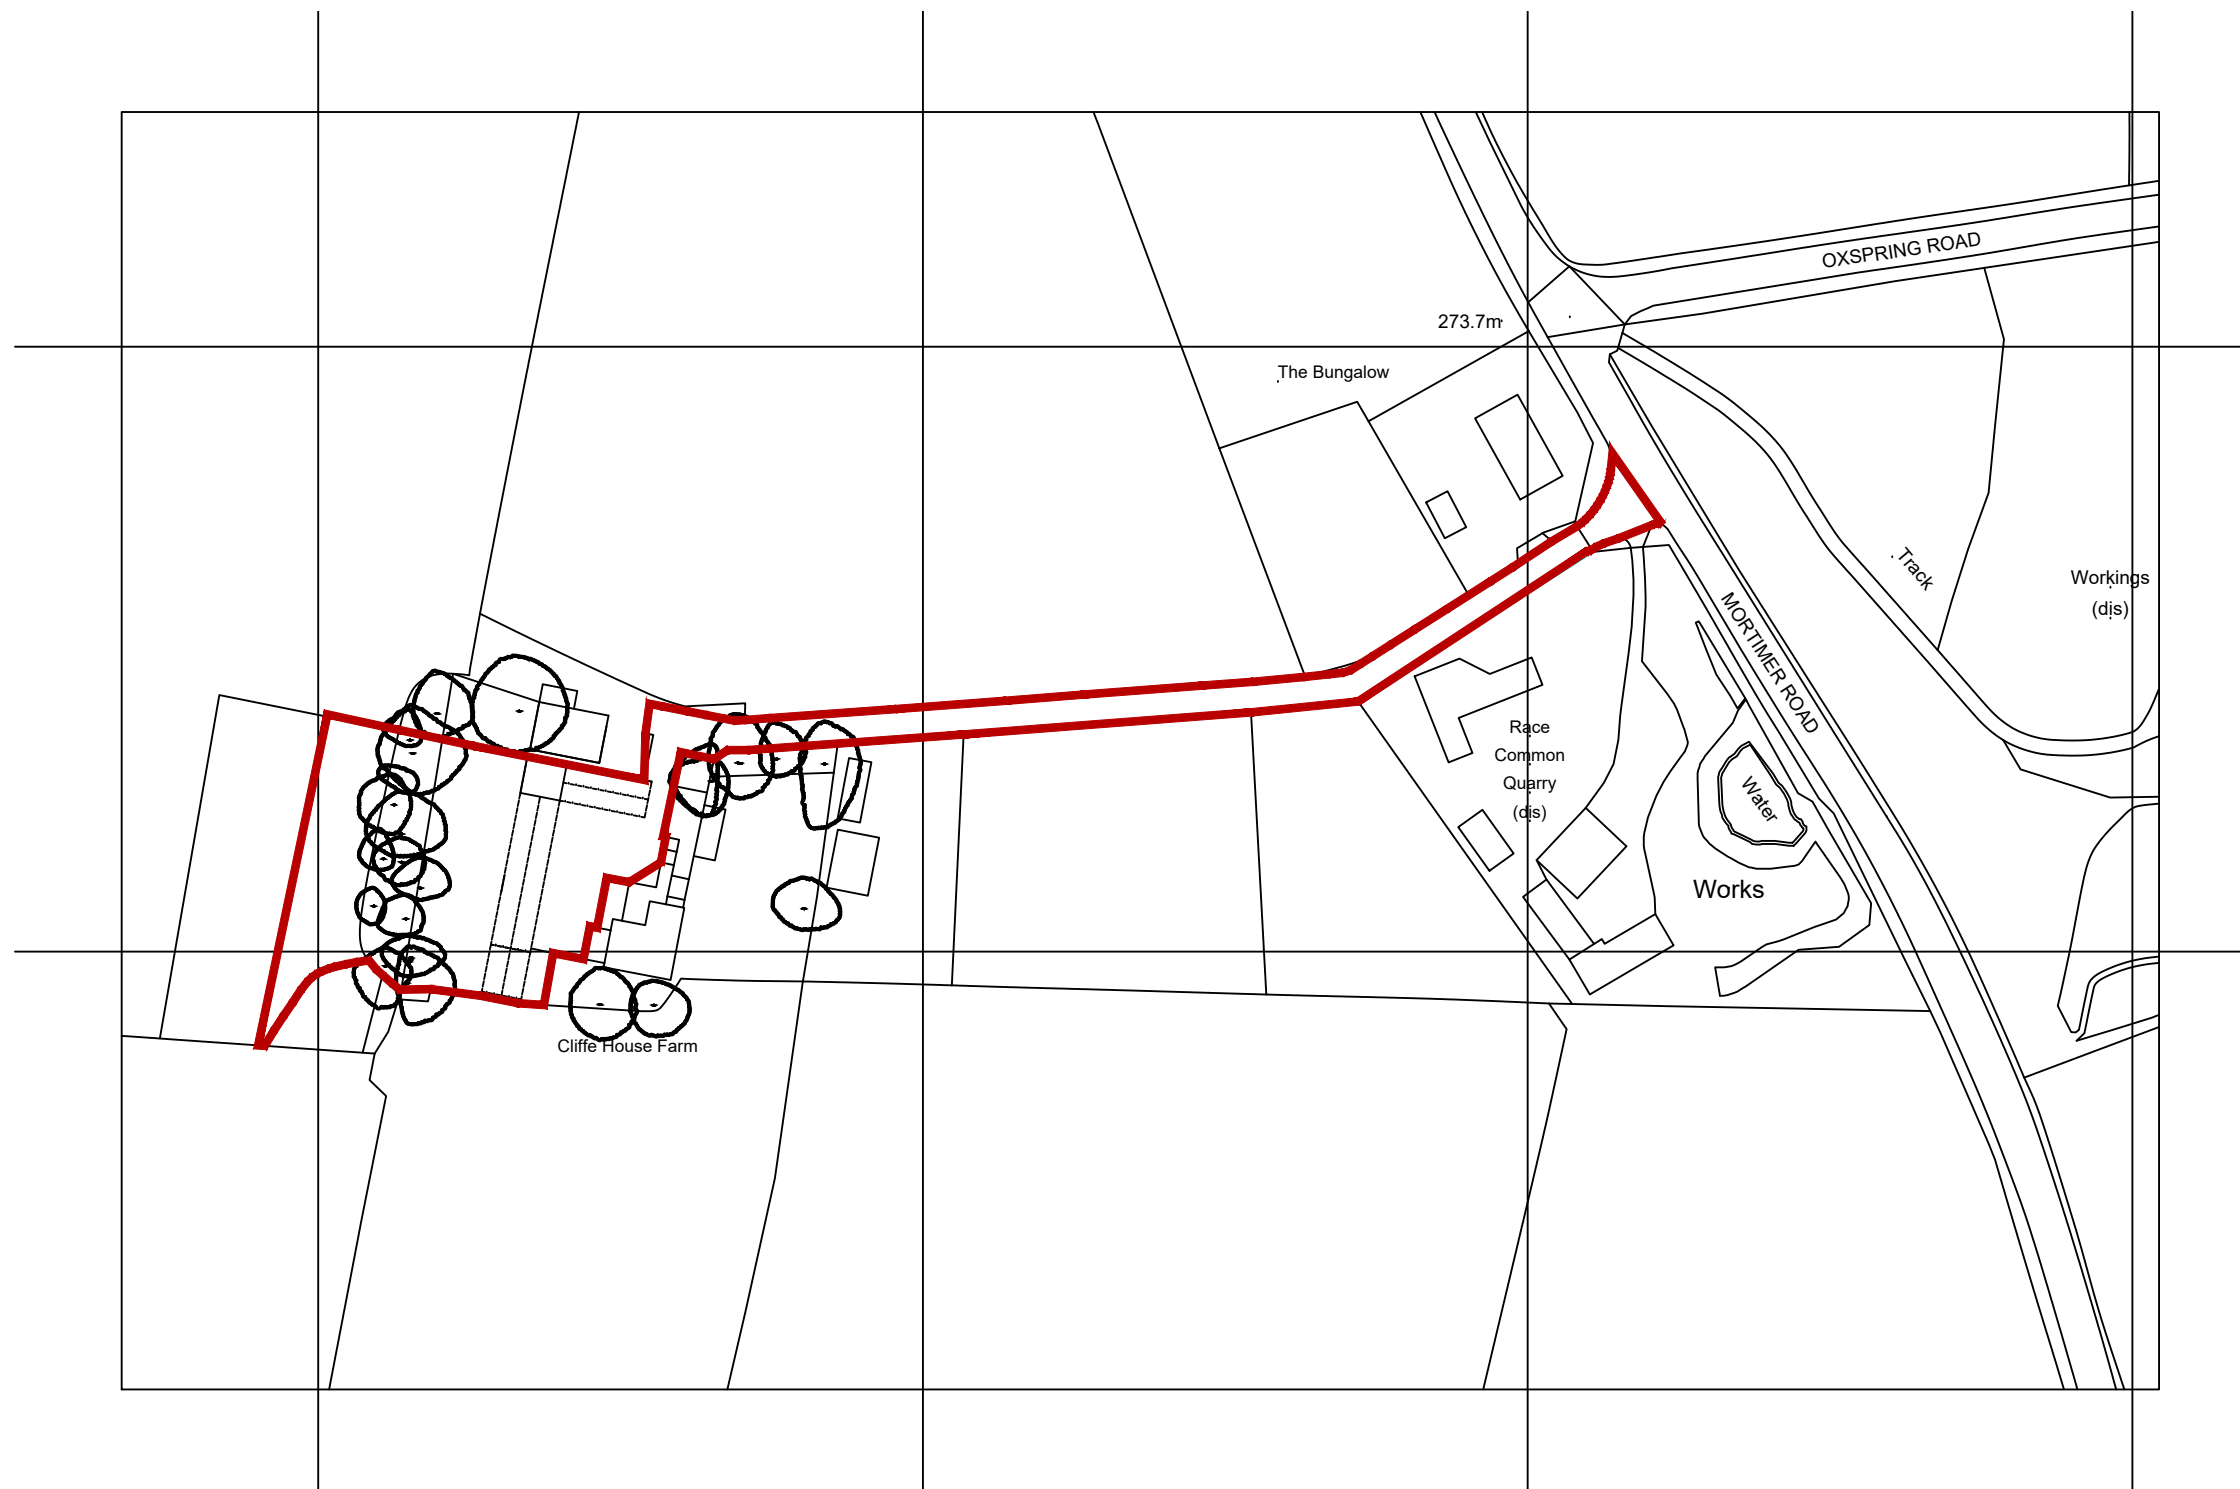

*** inc. architecture ltd**

the barn, mock hall farm, 63 leeds road, mirfield, wf14 0da, west yorkshire
tel: 07831 275394, e-mail: mail@inc-architecture.co.uk, www.inc-architecture.com

© 2017

project	THE BARN, CLIFFE HOUSE FARM, CUBLEY, PENISTONE S36 9FR	status	PLANNING		
client	GEMMA GARNHAM & KEVIN COOPER	date	APRIL 2017	scale	1:1250
dwg title	EXISTING LOCATION PLAN	dwg no.	097/P/100	rev.	A

revision notes: REV A (29/11/17): RED LINE EXTENDED DOWN TO MORTIMER ROAD TO INCLUDE ACCESS LANE