



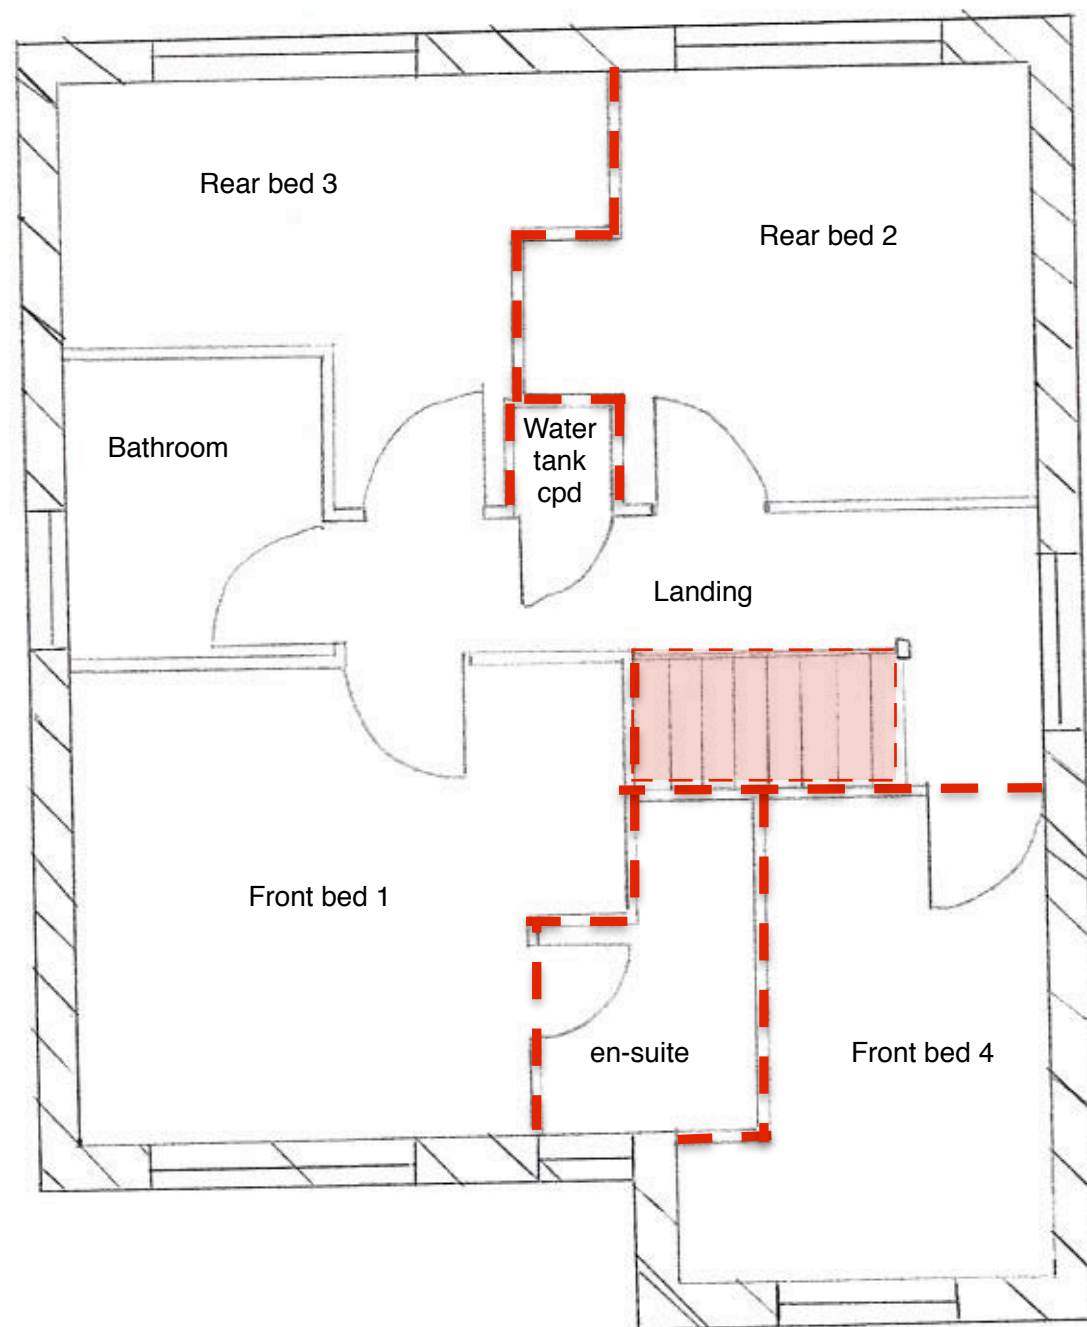

Scale 1:50

Existing first floor plan.
Dashed red lines indicate walls to be removed
Red transparant box indicates removal of stairs

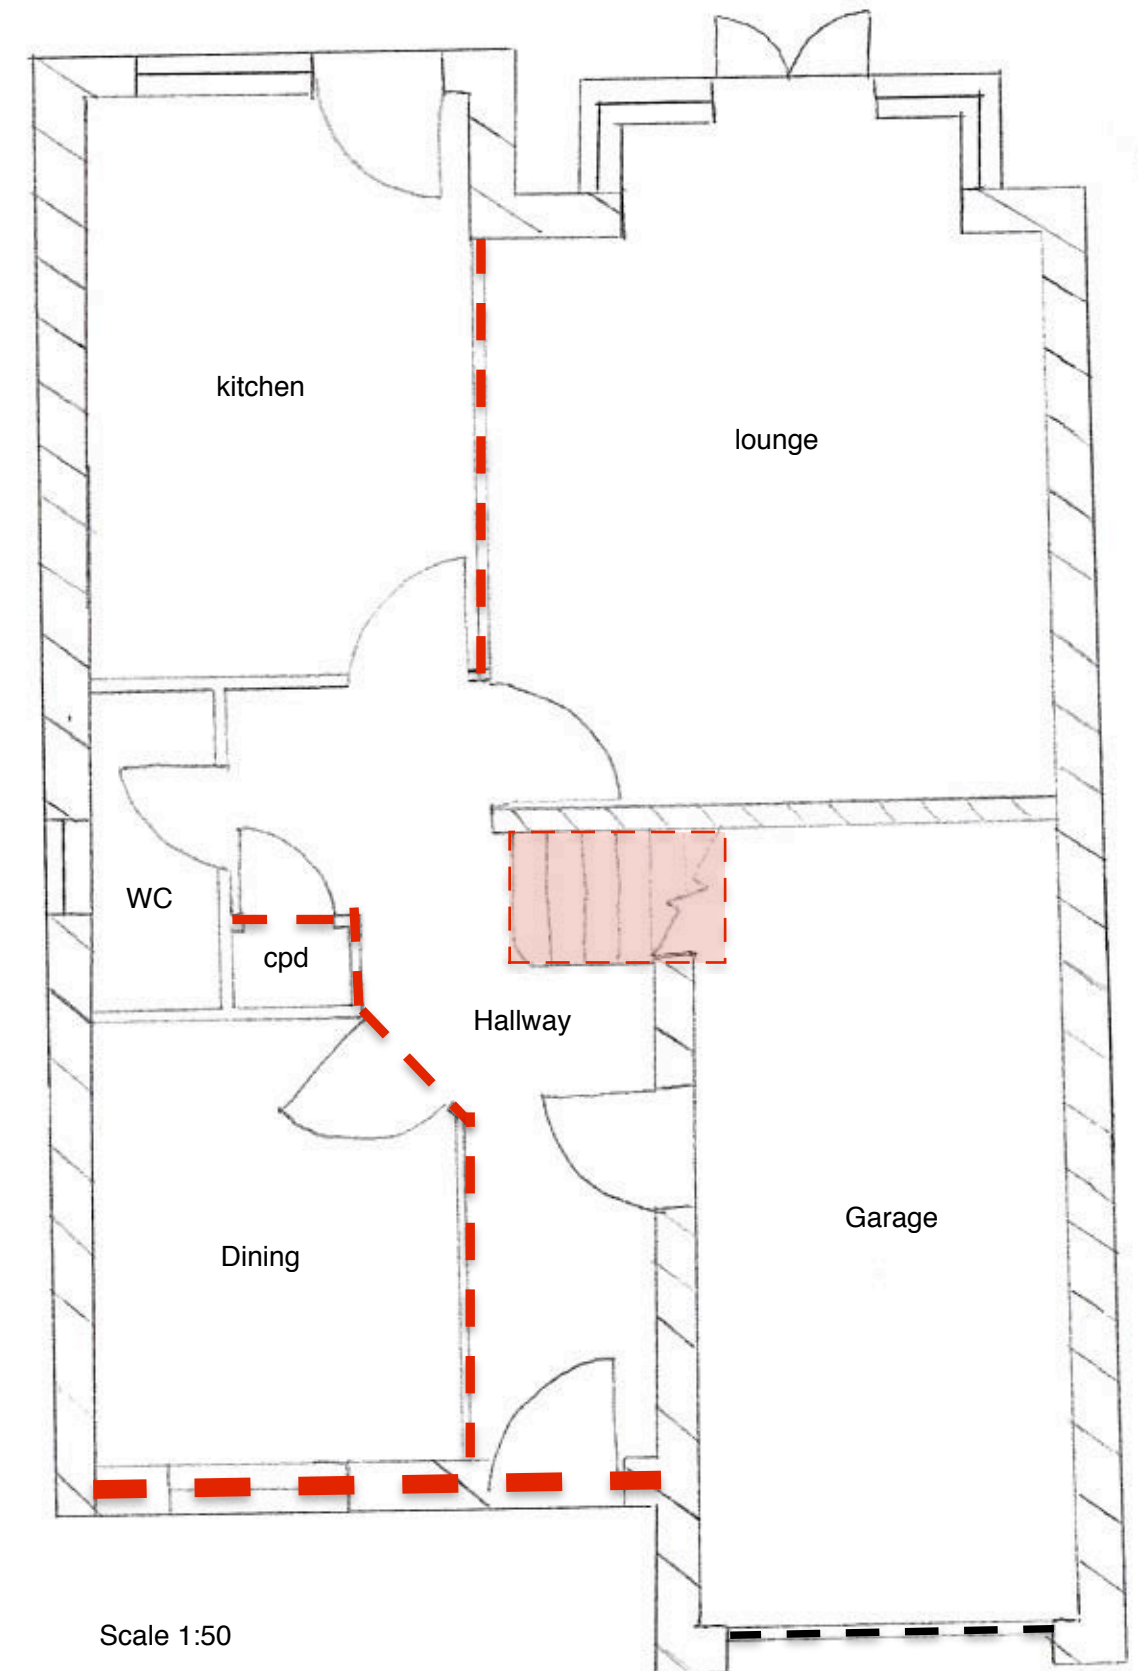

Scale 1:50

Existing first floor plan.
Dashed red lines indicate walls to be removed
Red transparant box indicates removal of stairs
Black dashed line indicates removal of Garage door