

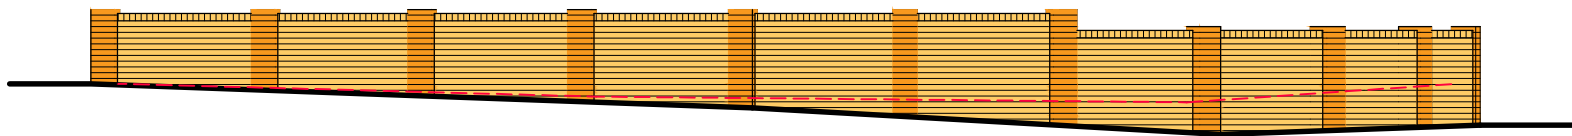


ELEVATION A
SCALE 1:100

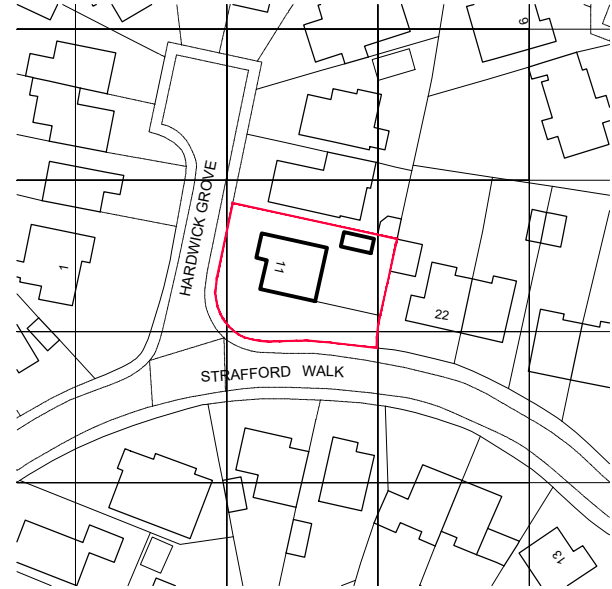

ELEVATION B
SCALE 1:100

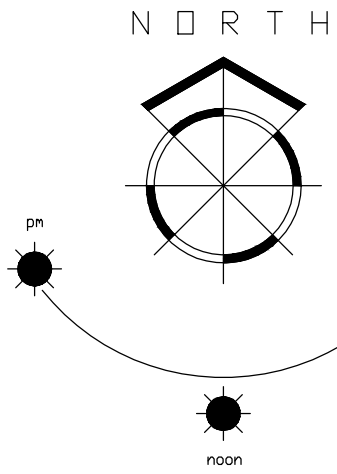


LOCATION PLAN
SCALE 1:1250

- THIS DRAWING AND THE COPYRIGHTS AND PATENTS THEREIN ARE THE PROPERTY OF NYP ARCHITECTURAL LTD. REGISTERED IN ENGLAND AND WALES No. PENDING AND MAY BE USED OR REPRODUCED ONLY UNDER CONTRACT.
- CONTRACTORS AND SUB-CONTRACTORS MUST CHECK AND AGREE ALL DIMENSIONS BEFORE PREPARING SHOP DRAWINGS OR COMMENCING WORK ON SITE.
- CONTRACTORS ARE RESPONSIBLE FOR INFORMING THE DESIGNER OF ANY DISCREPANCY DISCOVERED ON THIS DRAWING OR BETWEEN THIS DRAWING AND ANY OTHER RELATED DOCUMENT ISSUED UNDER THE STANDARD FORM OF CONTRACT IN RESPECT OF THE WORK.
- WRITTEN DIMENSIONS ONLY ARE TO BE USED FROM THIS DRAWING. IF IN ANY DOUBT ASK FOR CLARIFICATION.

Revisions.		
Date	Suffix	Description

Notes.

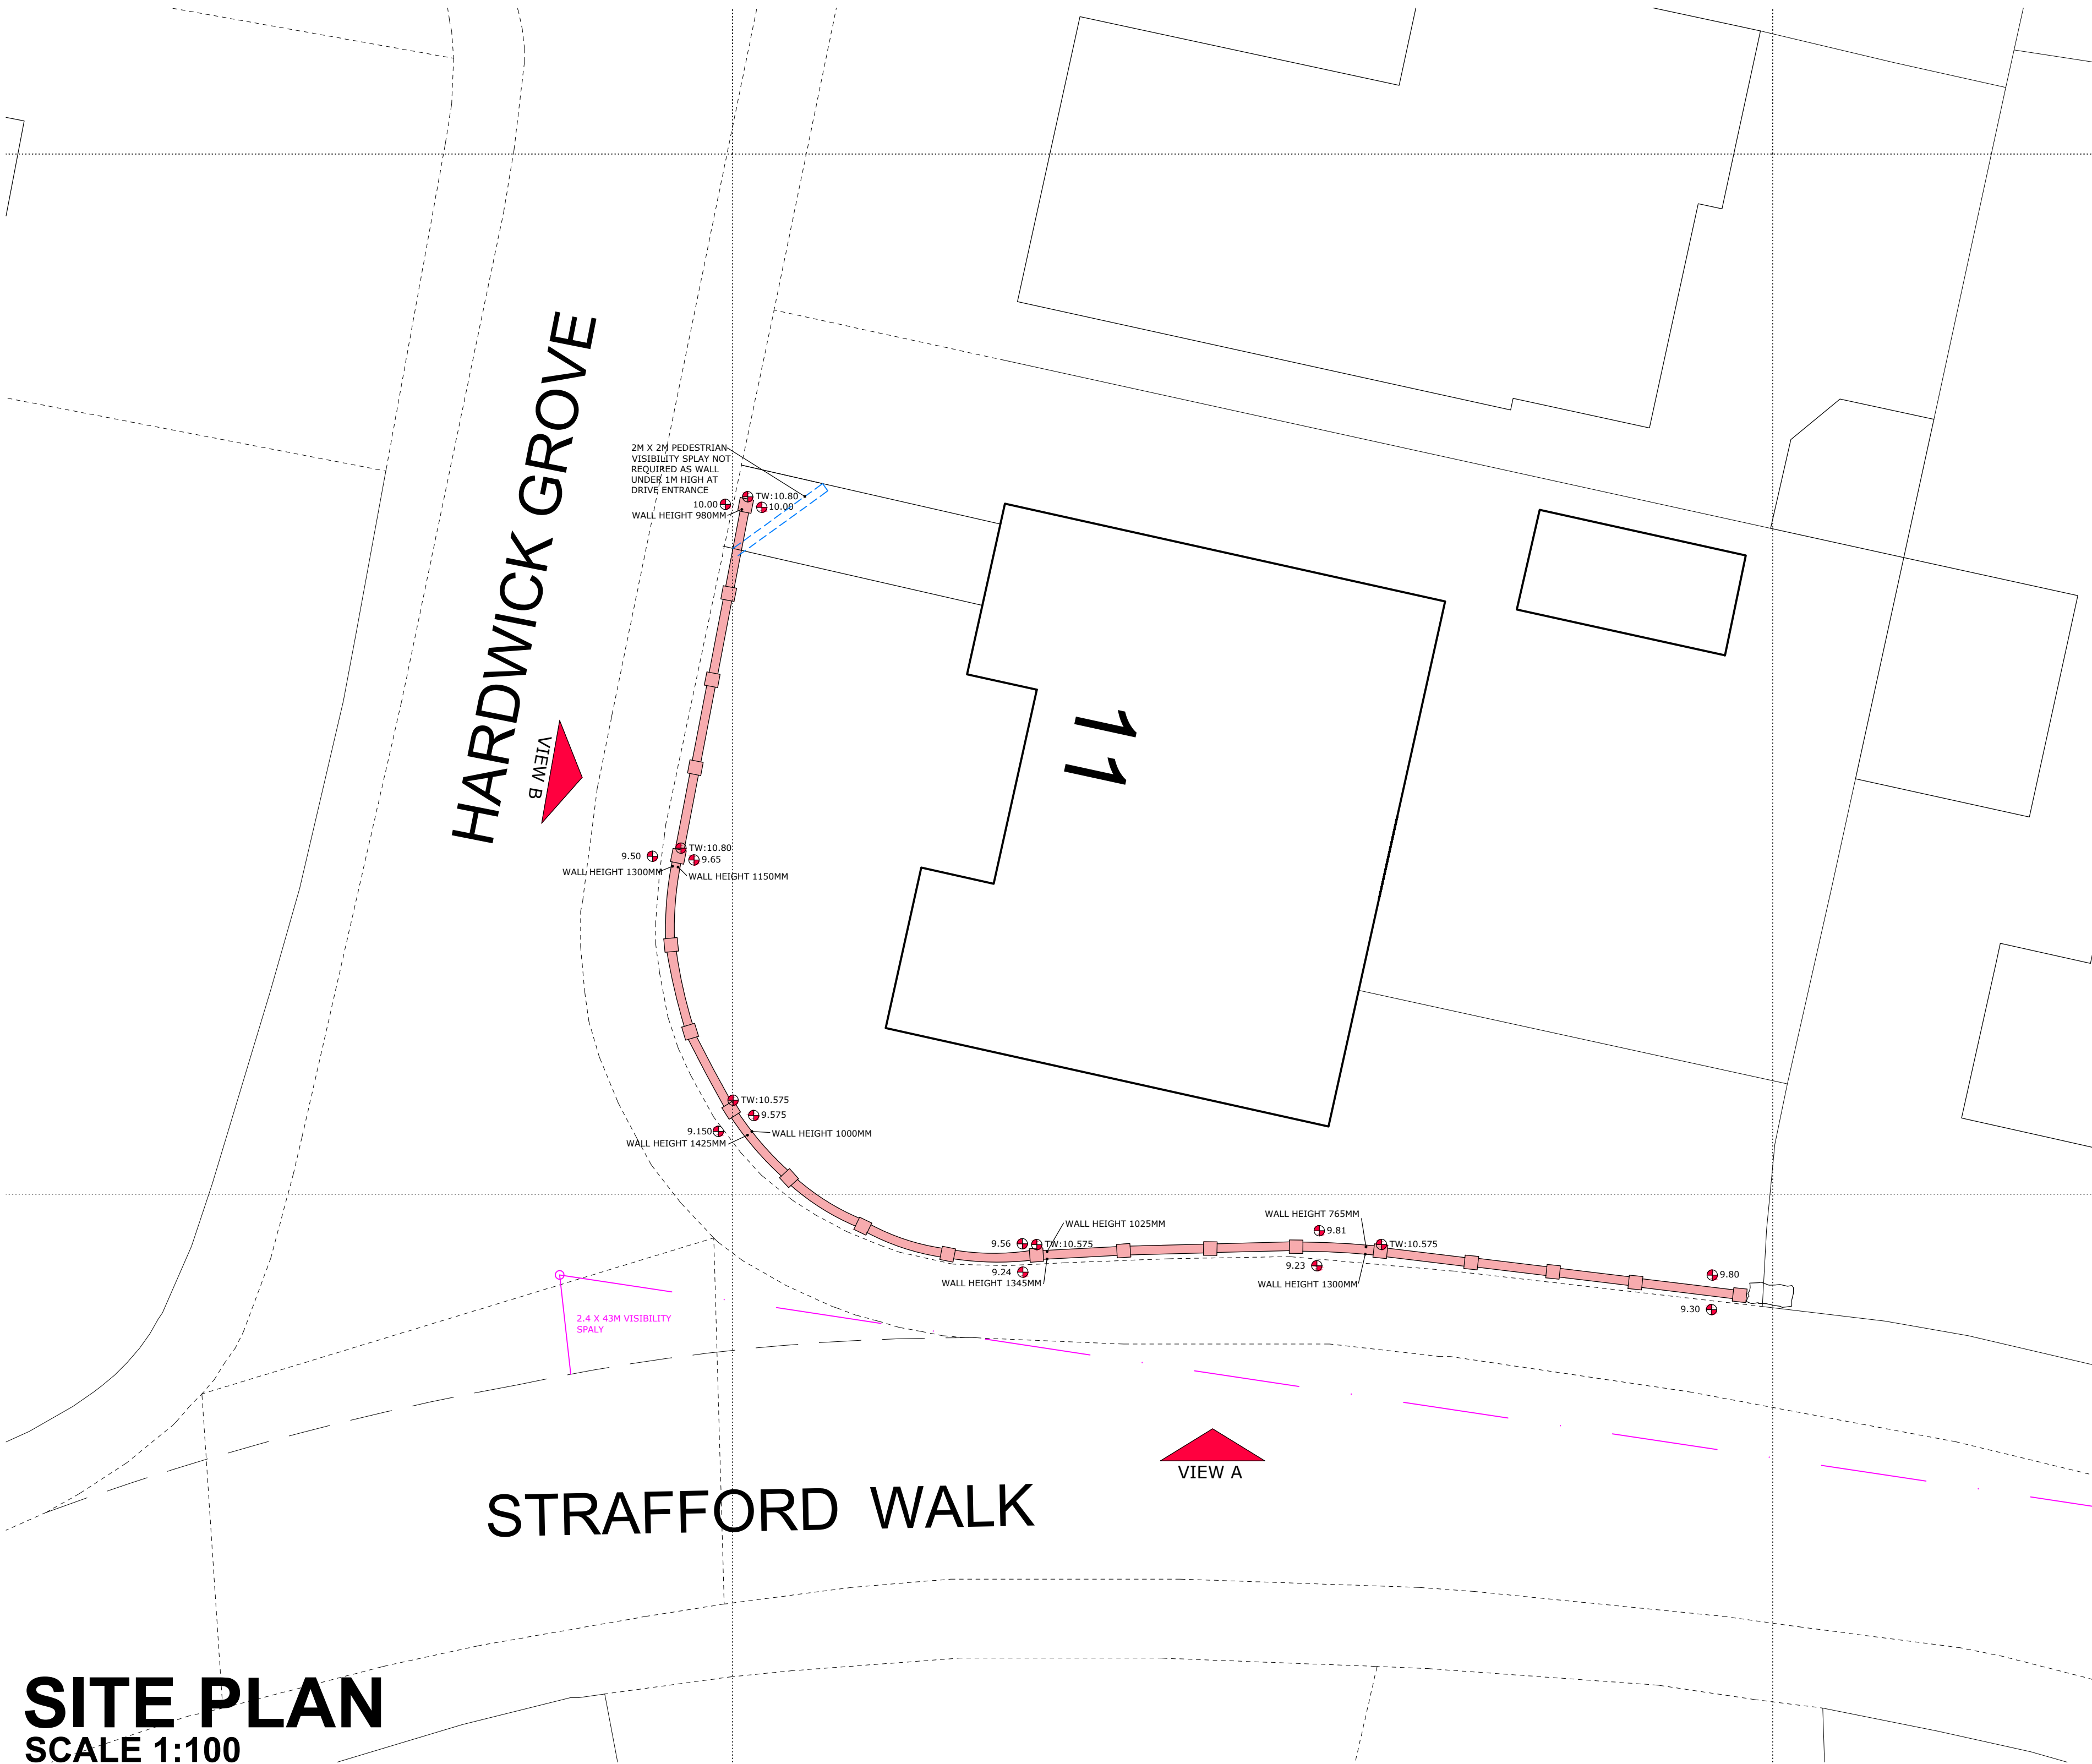

SITE PLAN
SCALE 1:200

SITE PLAN
SCALE 1:100

NYP
ARCHITECTURAL
LTD

BBIC, INNOVATION WAY, BARNSELEY, S75 1JL.
Tel: 01226 200989. E: scott@nypas.co.uk

Project.
**11 HARDWICK GROVE
DODWORTH
BARNSELEY
S75-3SS**

Drawing Title.
**PLANS & ELEVATIONS
AS BUILT**

**RETROSPECTIVE
PLANNING APP**

Client.
MRS C. CROSSLEY

Date.
MAY 2025

Scale.
AS INDICATED

Ref.	Dwg. No.	Rev.
2026/70	02	A