


IF IN DOUBT PLEASE ASK!

notes:
this drawing and design is the copyright of aja architects llp and must not be reproduced in part or in whole without prior written consent. contractors must verify all dimensions on site before commencing work or preparing shop drawings

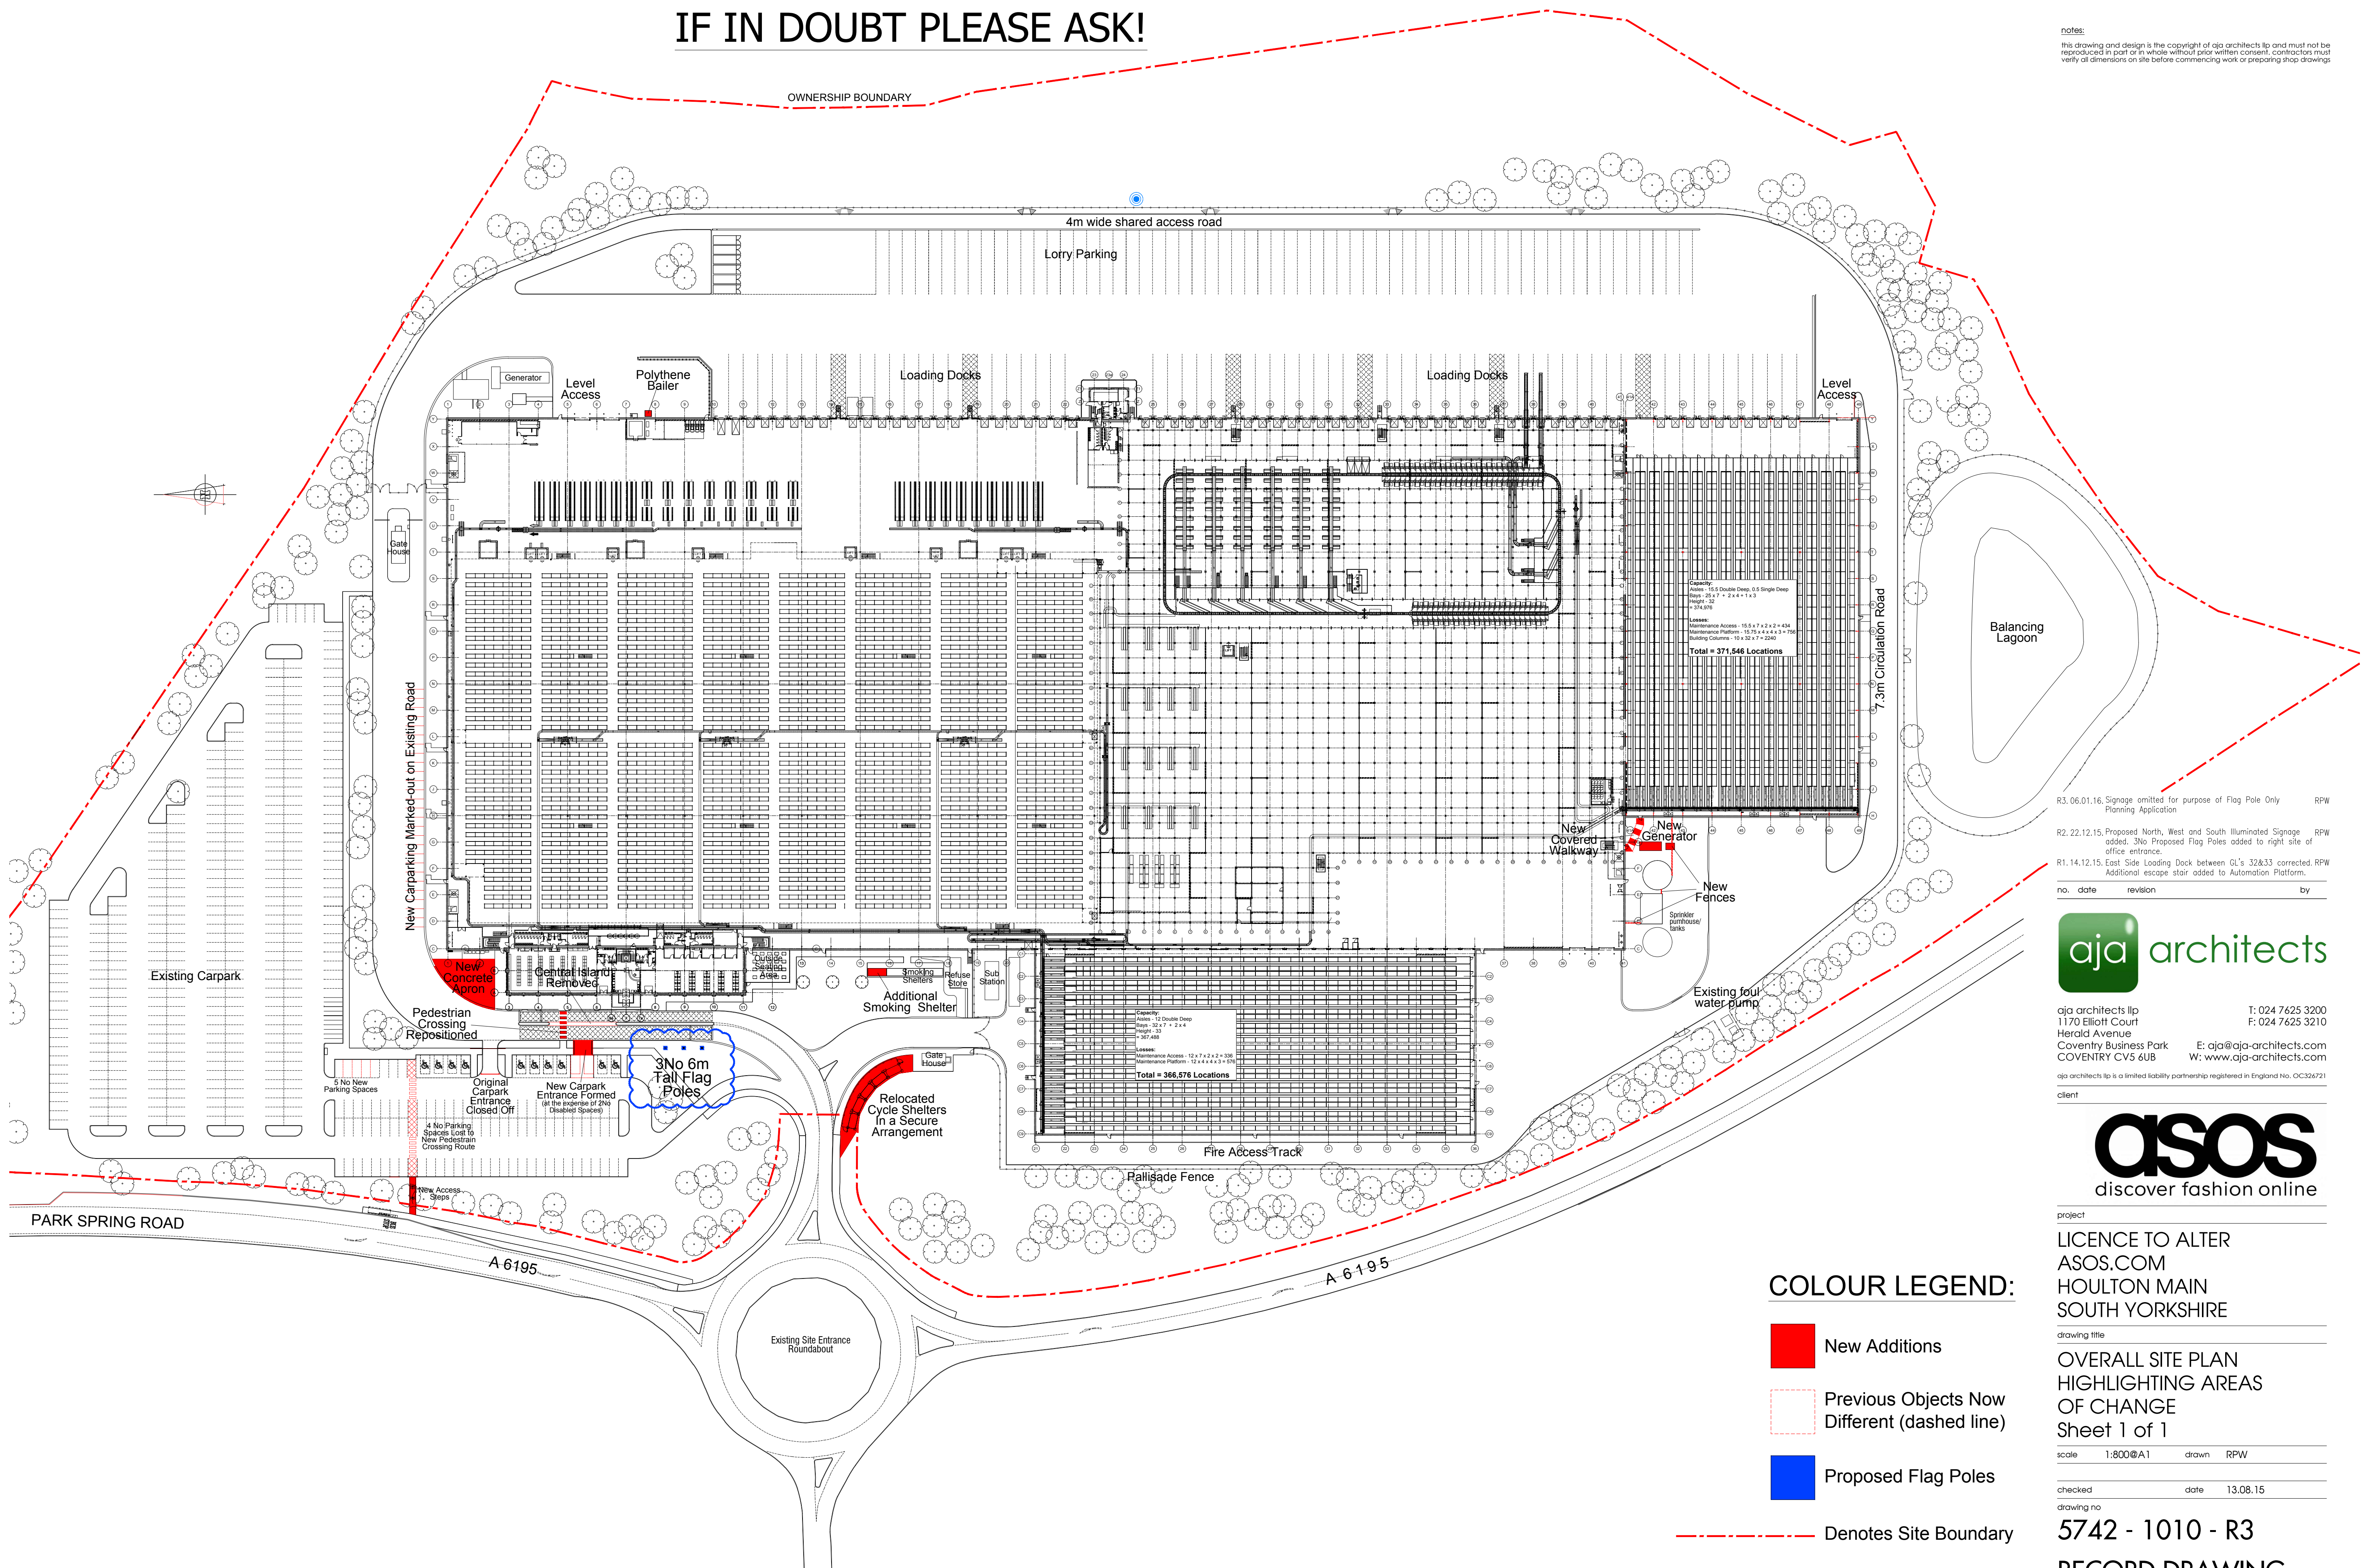

R3.06.01.16. Signage omitted for purpose of Flag Pole Only Planning Application RPW

R2.22.12.15. Proposed North, West and South Illuminated Signage added. 3No Proposed Flag Poles added to right site of office entrance. RPW

R1.14.12.15. East Side Loading Dock between GL's 32&33 corrected. RPW Additional escape stair added to Automation Platform.

no.	date	revision	by
-----	------	----------	----



aja architects llp
1170 Elliott Court
Herald Avenue
Coventry Business Park
COVENTRY CV5 6UB
E: aja@aja-architects.com
W: www.aja-architects.com

aja architects llp is a limited liability partnership registered in England No. OC326721
client



project
LICENCE TO ALTER
ASOS.COM
HOULTON MAIN
SOUTH YORKSHIRE

drawing title
OVERALL SITE PLAN
HIGHLIGHTING AREAS
OF CHANGE
Sheet 1 of 1

scale	1:800@A1	drawn	RPW
-------	----------	-------	-----

checked	date	13.08.15
---------	------	----------

drawing no

5742 - 1010 - R3
RECORD DRAWING

COLOUR LEGEND:

New Additions

Previous Objects Now
Different (dashed line)

Proposed Flag Poles

Denotes Site Boundary