





EXISTING
FRONT ELEVATION
SCALE 1:100



EXISTING
SIDE ELEVATION
SCALE 1:100

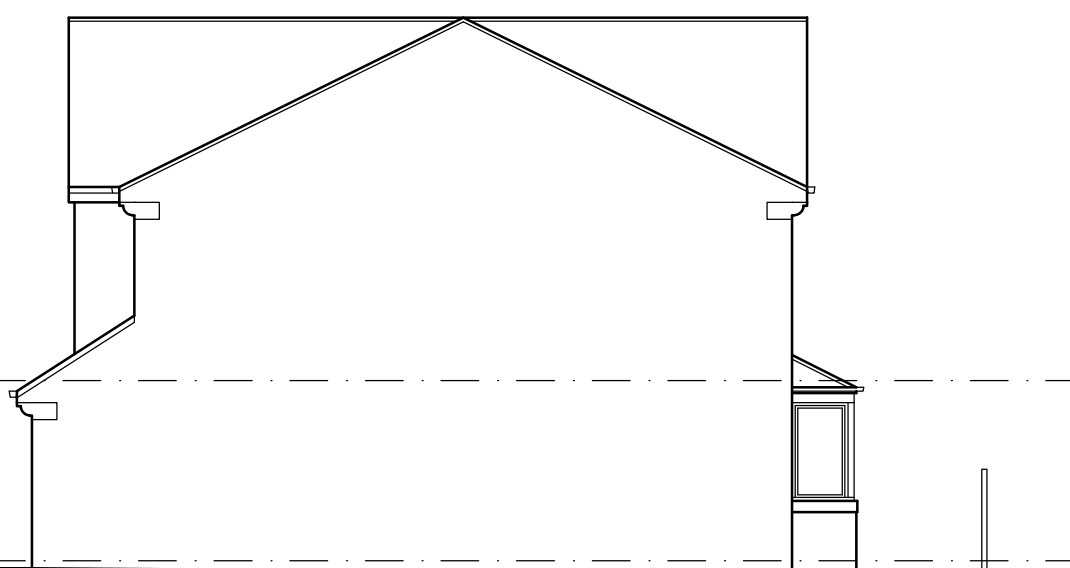


EXISTING
REAR ELEVATION
SCALE 1:100

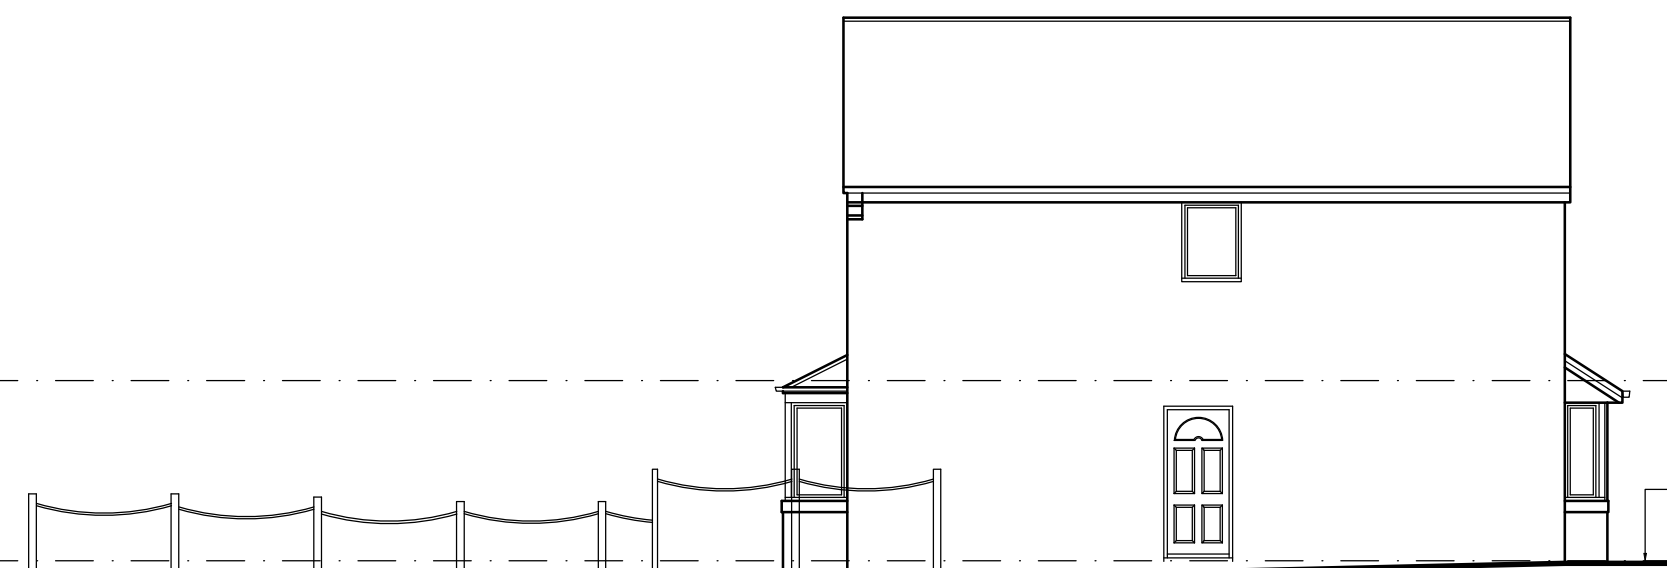

EXISTING
SIDE ELEVATION
SCALE 1:100




PROPOSED
FRONT ELEVATION
SCALE 1:100

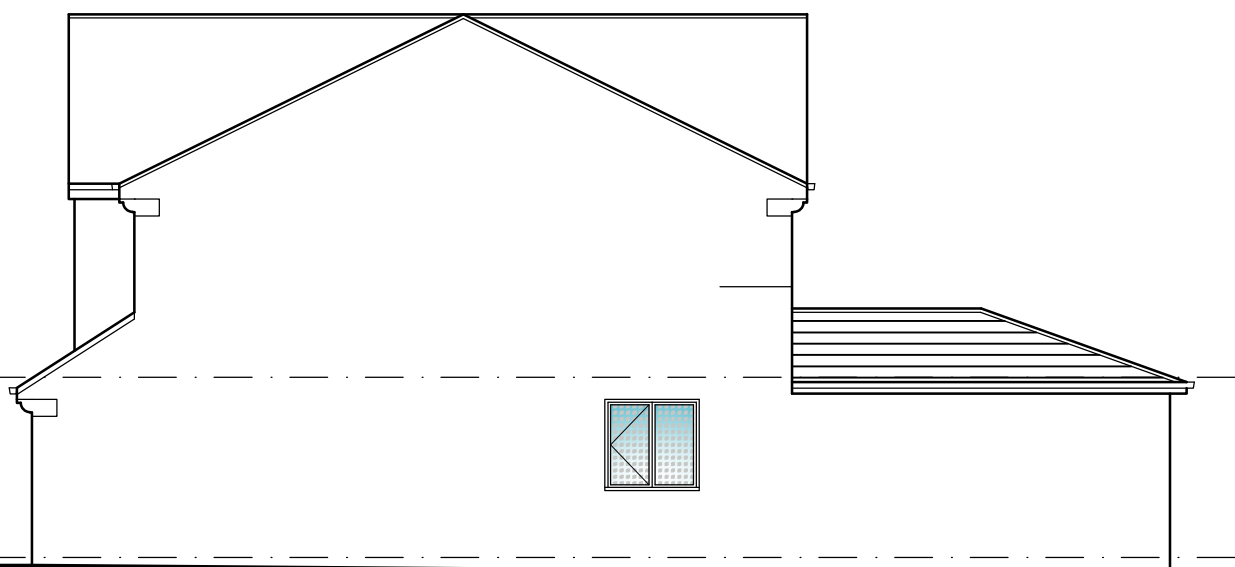


PROPOSED
SIDE ELEVATION
SCALE 1:100





PROPOSED
REAR ELEVATION
SCALE 1:100

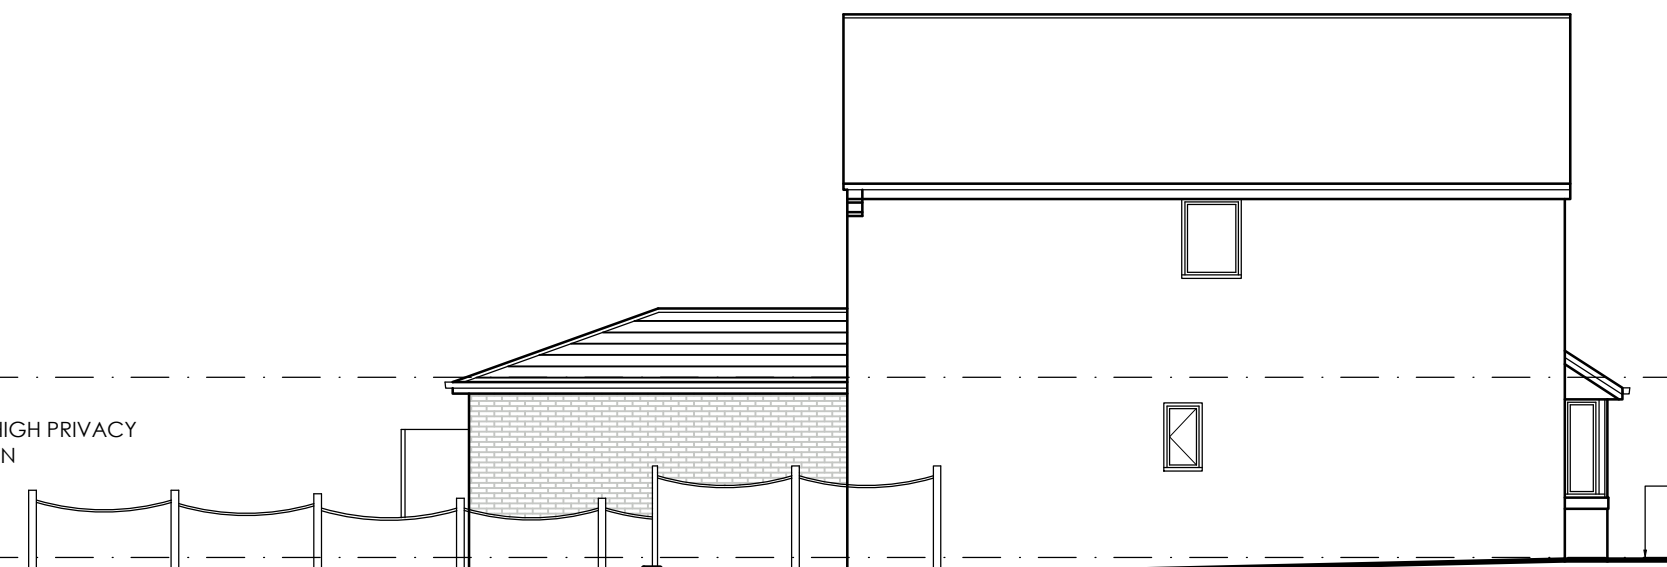


PROPOSED
SIDE ELEVATION
SCALE 1:100

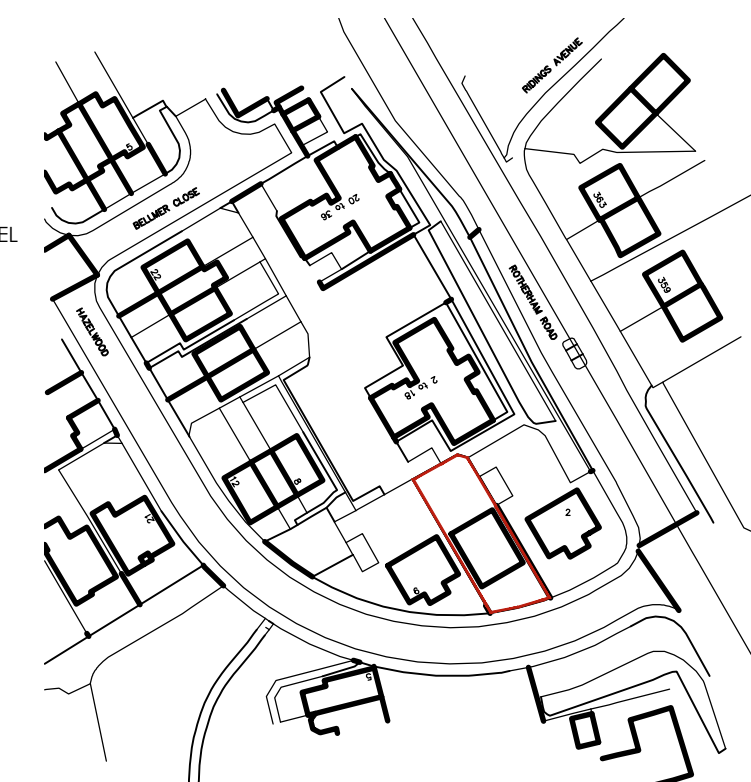


LOCATION PLAN
SCALE 1:1250

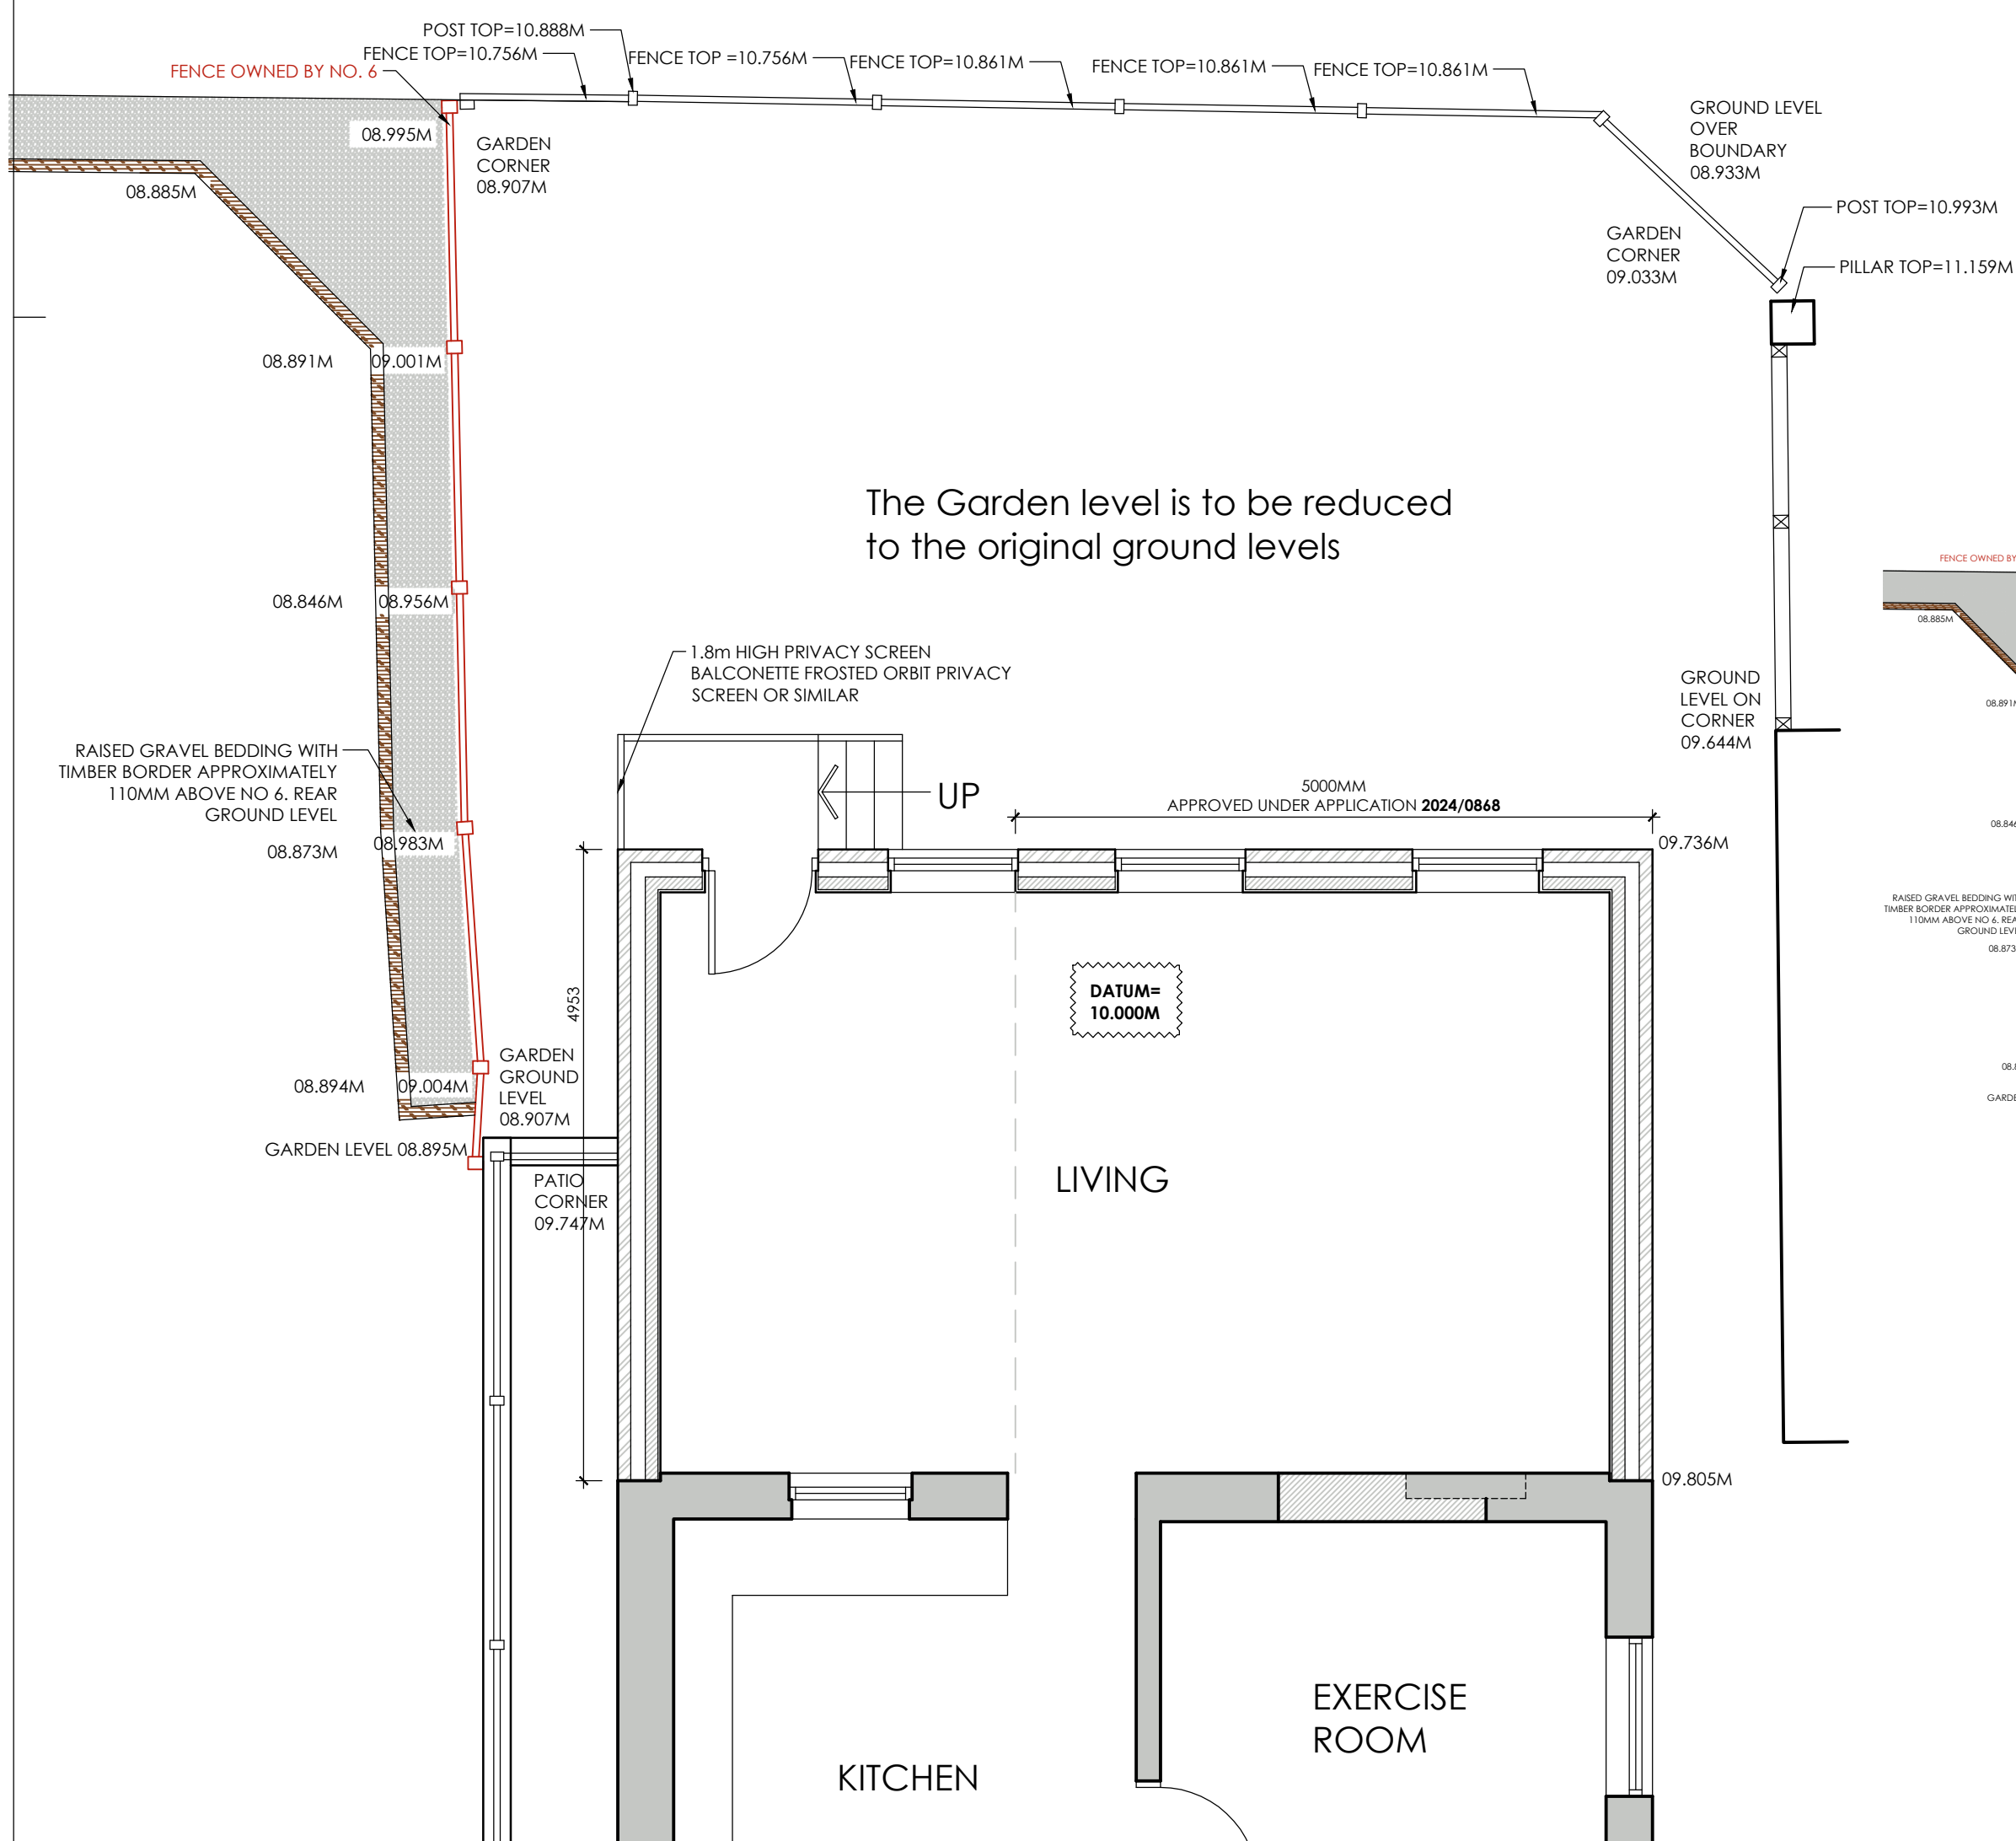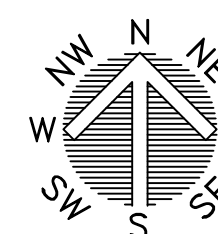


AS BUILT EXTENSION AND PROPOSED LEVELS
SCALE 1:50

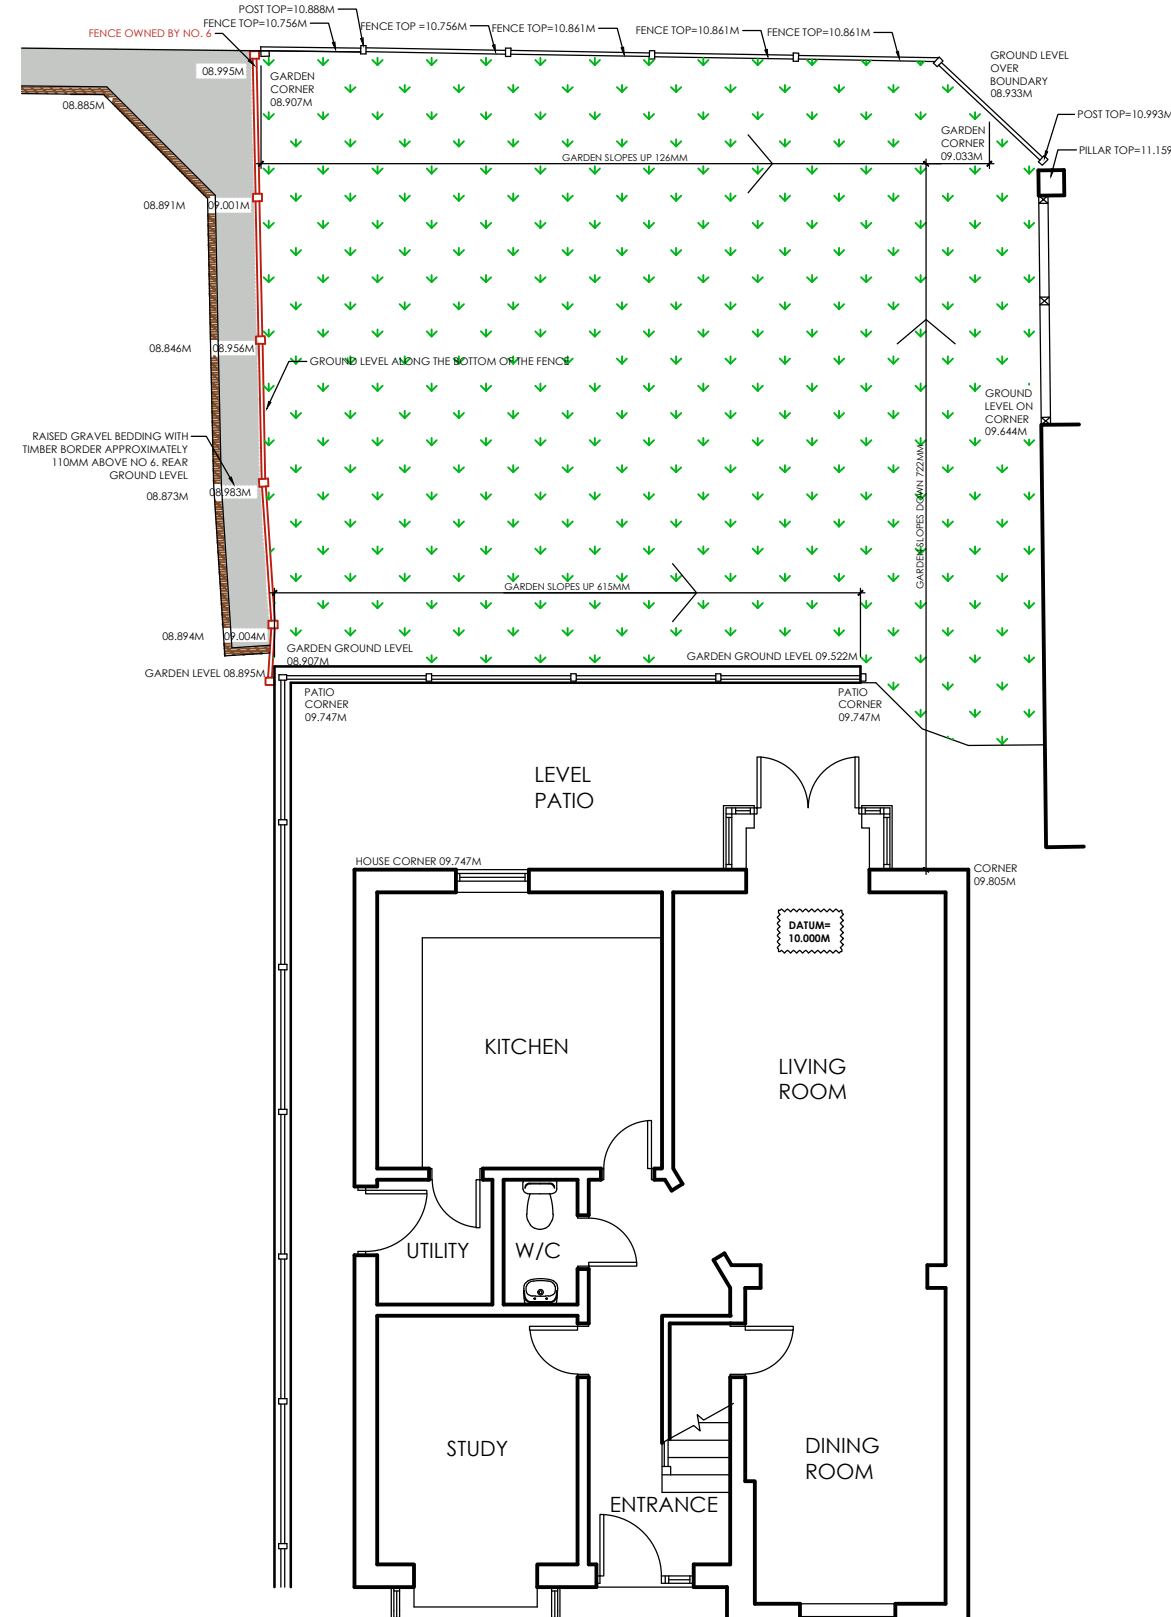

PRE-DEVELOPMENT
GROUND FLOOR PLAN
SCALE 1:100

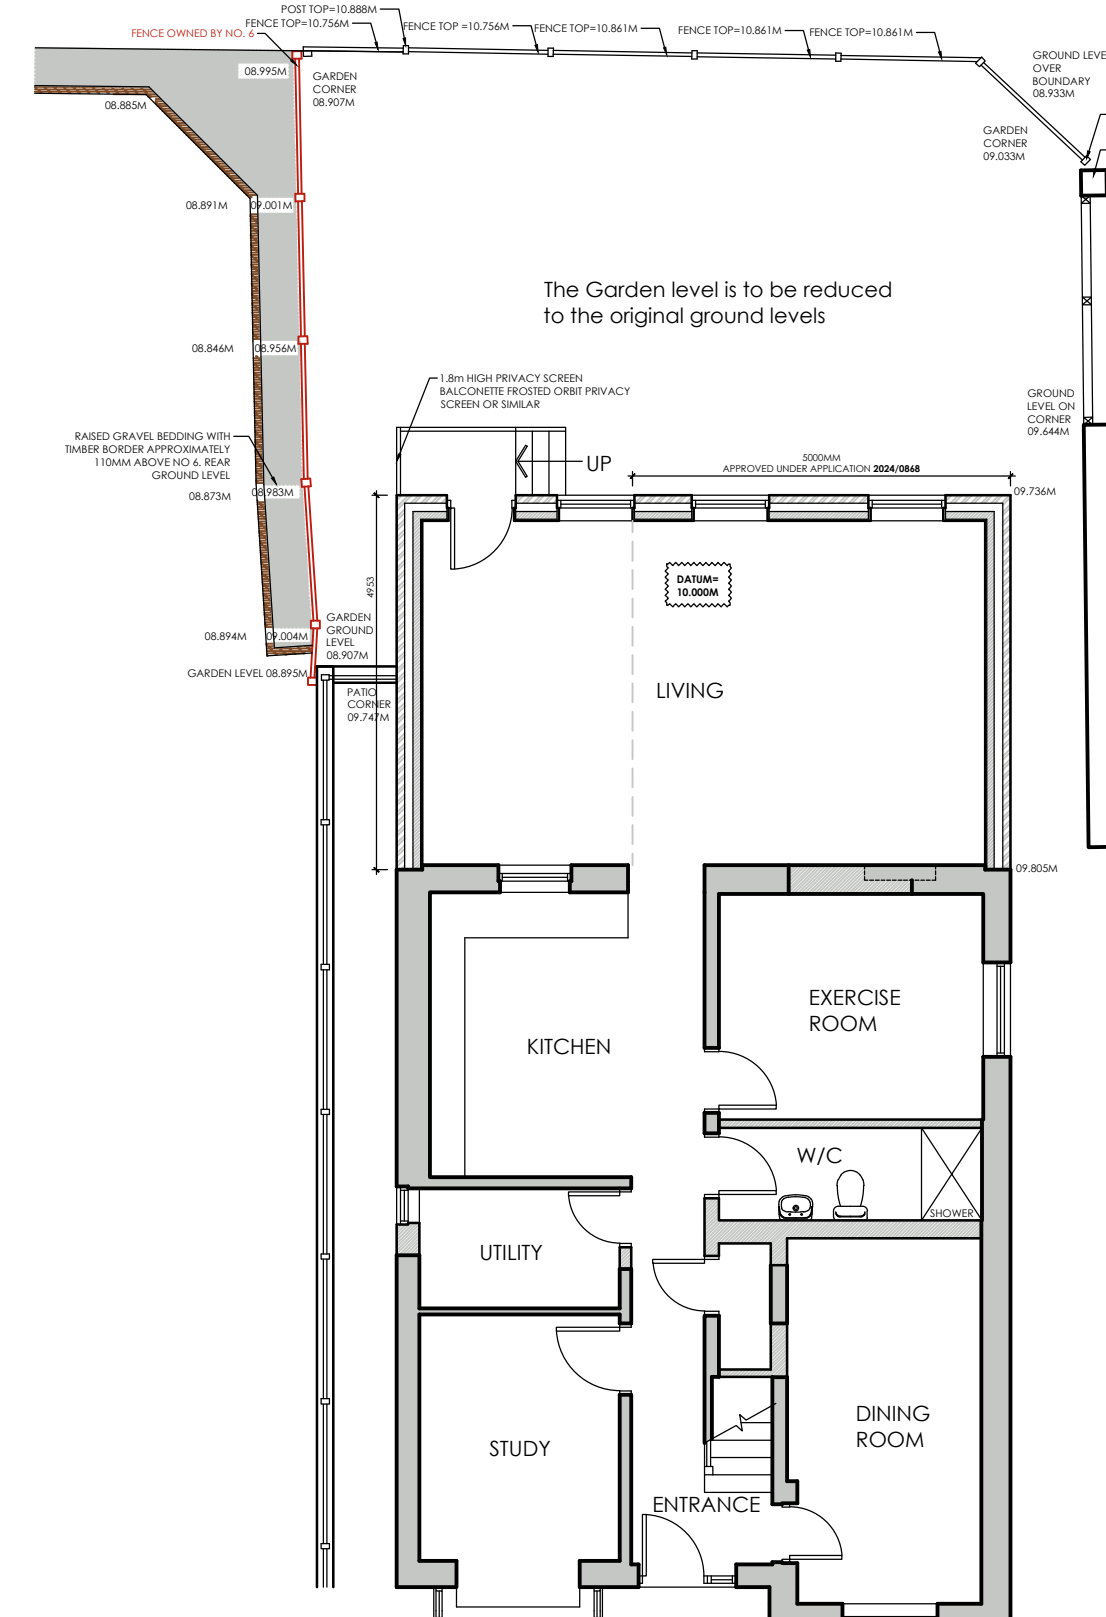

AS BUILT EXTENSION AND PROPOSED LEVELS
SCALE 1:100

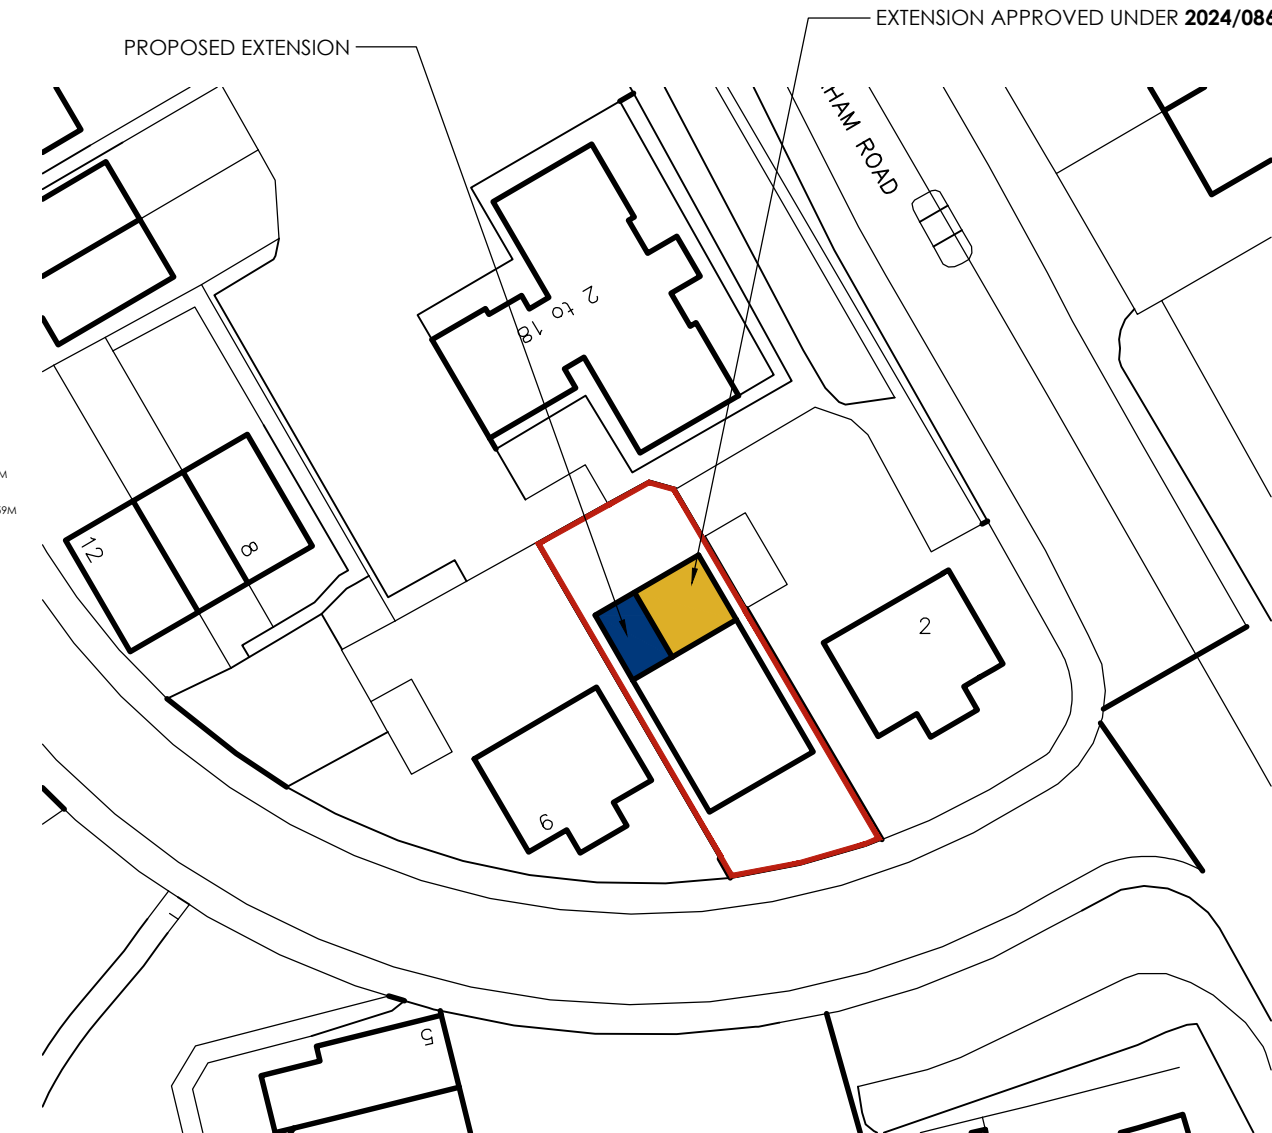

BLOCK PLAN
SCALE 1:500

		OFFICE ONE, DRILL HALL, 11 EASTGATE, BARNLEY, S70 2EU		Phone: 01226 208482 Email: info@whiteagus.co.uk Web: www.whiteagus.co.uk	
Project:		EXTENSION AT 4 HAZELWOOD, SMITHIES BARNLEY, S71 2GE		Client:	
Drawing Title:		PLANS AND ELEVATIONS		MR SINGH	
Date	Suffix	Description	Date	Suffix	Description
09/09/2026		DETAILS CLARIFIED FOR PLANNING			