
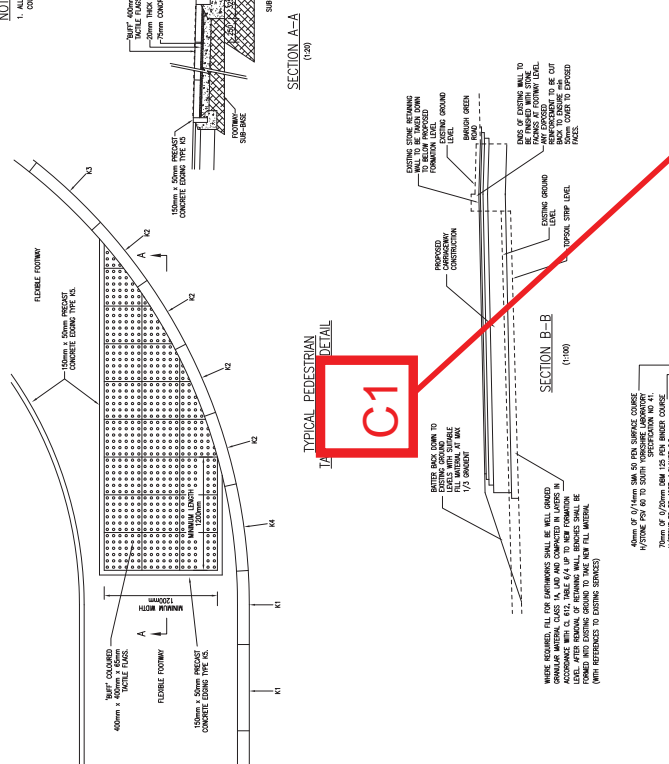
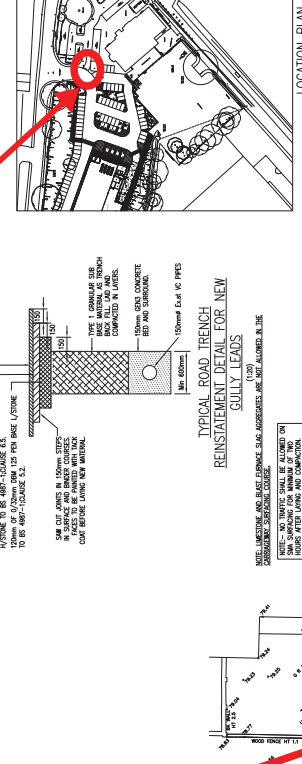
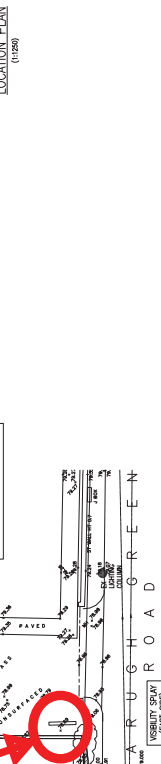
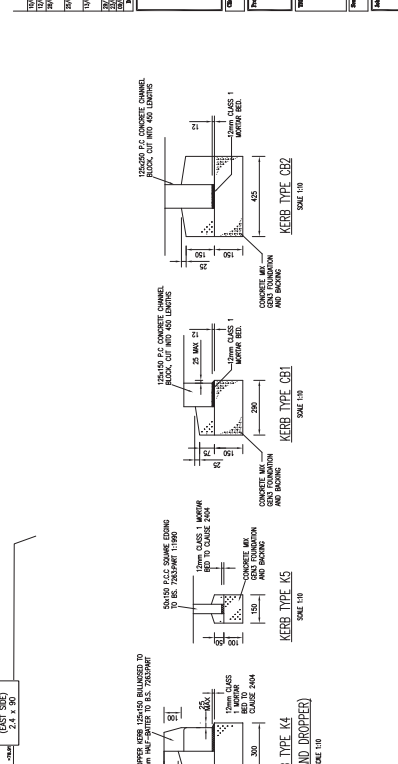
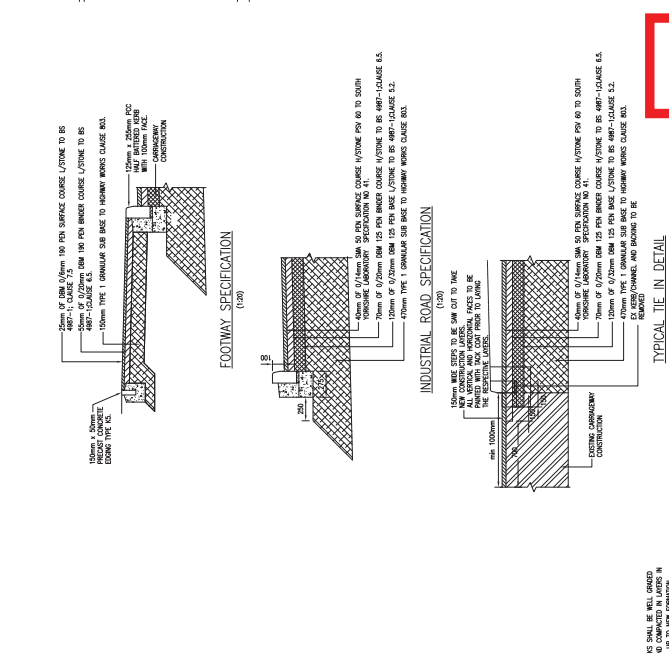
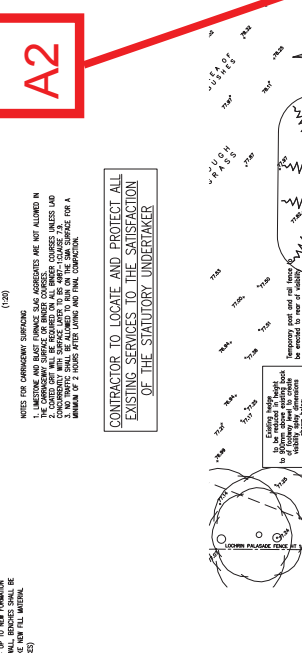
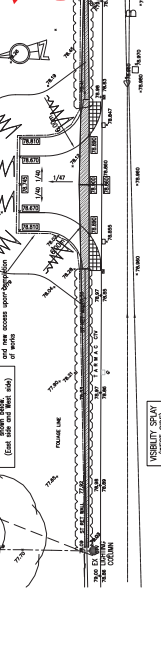
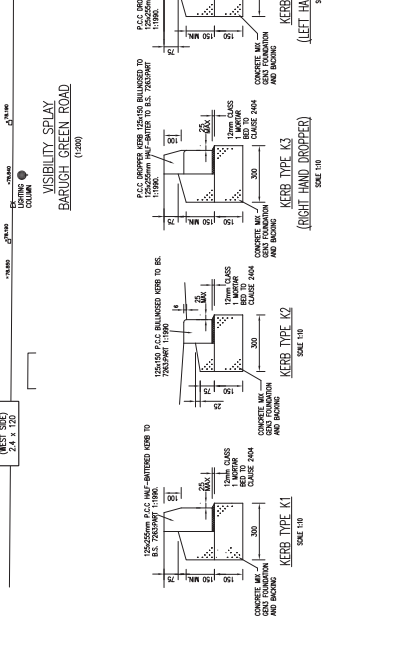
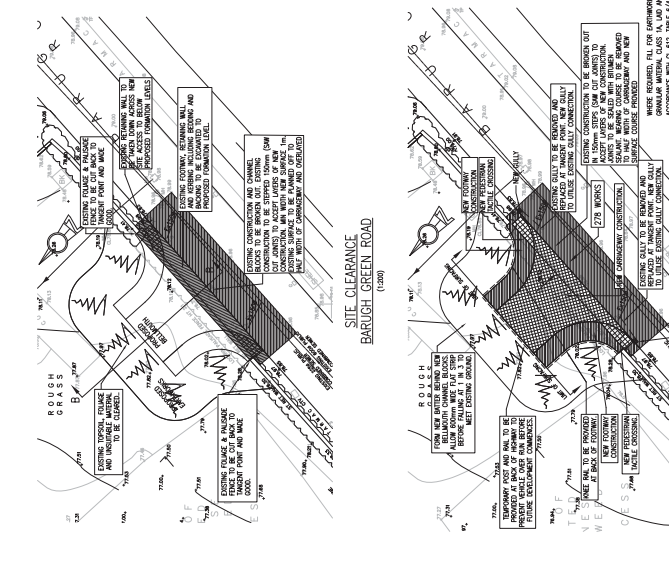
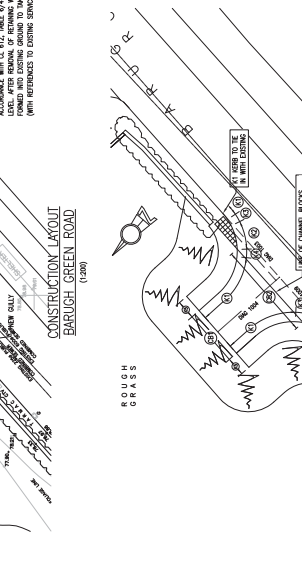
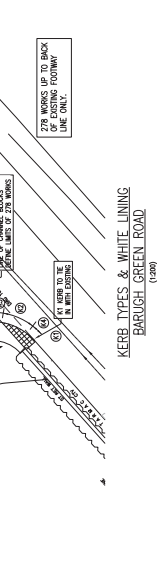


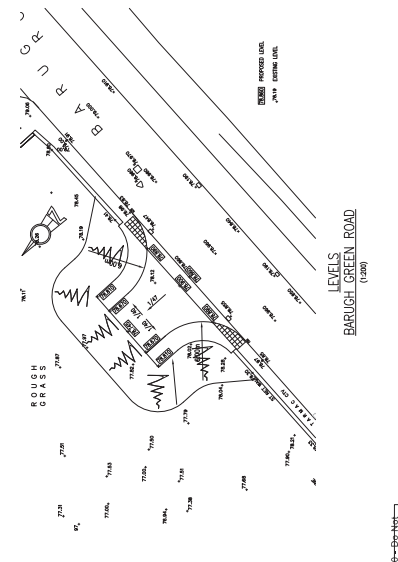

Designer Response to Road Safety Audit

Scheme: Barugh Green, Barnsley
 Stage: Stage 3 Road Safety Audit
 Drawing Issue:

Designers comments on the RSA

Ref	Accepted	Brief Description	Comments
A1	Yes	Vegetation clearance required to avoid potential collisions.	TPL instructed the planting to be cut back as agreed. This has now been undertaken.
A2	Partially	Misleading arrow sign at the future access/egress on Barugh Green Road.	Aldi have agreed to install some reflective strips to the gate access and to monitor for customers attempting to use this access.
B1	Yes	Inadequate pedestrian crossing facility.	The dropped kerb was installed within Aldi ownership, since this time the adjacent land owner has refused to install the opposite crossing point. As such the, if the crossing point appears to be a hazard, the one on the Aldi side will be removed.
C1	N/A	Insufficient road markings.	The off highway car park markings are to Aldi approval and specification, if the arrangement becomes an issue we will ask the store team to consider addressing the lining.

Drawings

ALDI STORE, CLAYCLIFFE ROAD, BARUGH GREEN, BARNSELEY - FRIDAY 11 APRIL 2014

In						Out					Occ.	% Cap.
Time	Car	LGV	OGV1	M/C	Total	Car	LGV	OGV1	M/C	Total		
8:00	17	1	1	0	19	6	0	1	0	7	13	17
8:15	16	1	0	0	17	14	1	0	0	15	25	33
8:30	20	1	0	0	21	13	1	0	0	14	27	36
8:45	26	0	0	0	26	15	2	0	0	17	34	45
9:00	28	0	0	0	28	16	0	0	0	16	43	57
9:15	31	1	0	0	32	24	0	0	0	24	55	72
9:30	30	1	0	0	31	28	2	0	0	30	63	83
9:45	34	2	0	0	36	30	1	0	0	31	64	84
10:00	37	1	0	0	38	30	1	0	0	31	69	91
10:15	31	0	0	0	31	29	1	0	0	30	76	100
10:30	31	1	0	0	32	38	0	0	0	38	77	101
10:45	33	0	0	0	33	37	1	0	0	38	71	93
11:00	32	1	0	0	33	27	0	0	0	27	66	87
11:15	30	0	0	0	30	36	1	0	0	37	72	95
11:30	33	1	0	0	34	26	1	0	0	27	65	86
11:45	34	1	0	0	35	44	0	0	0	44	72	95
12:00	33	3	0	0	36	39	0	0	0	39	63	83
12:15	34	1	0	0	35	33	0	0	0	33	60	79
12:30	43	0	0	0	43	37	2	0	0	39	62	82
12:45	26	0	0	0	26	29	2	0	0	31	66	87
13:00	25	1	0	0	26	30	1	0	0	31	61	80
13:15	36	0	0	0	36	37	0	0	0	37	56	74
13:30	40	1	0	0	41	28	0	0	0	28	55	72
13:45	30	0	0	0	30	36	1	0	0	37	68	89
14:00	25	1	0	0	26	34	1	0	0	35	61	80
14:15	28	1	0	0	29	29	0	0	0	29	52	68
14:30	27	1	0	0	28	25	0	0	0	25	52	68
14:45	30	0	0	0	30	24	0	0	0	24	55	72
15:00	29	1	0	0	30	33	3	0	0	36	61	80
15:15	31	1	0	0	32	28	2	0	0	30	55	72
15:30	38	1	0	0	39	35	1	0	0	36	57	75
15:45	43	3	0	0	46	46	0	0	0	46	60	79
16:00	25	0	0	0	25	33	1	0	0	34	60	79
16:15	14	0	0	0	14	35	0	0	0	35	51	67
16:30	12	1	0	0	13	20	1	0	0	21	30	39
16:45	18	0	0	0	18	18	0	0	0	18	22	29
17:00	36	2	0	0	38	18	2	0	0	20	22	29
17:15	41	1	0	0	42	28	1	0	0	29	40	53
17:30	41	1	0	0	42	46	1	0	0	47	53	70
17:45	42	2	0	0	44	45	3	0	0	48	48	63
18:00	31	0	0	0	31	39	2	0	0	41	44	58
18:15	34	1	0	0	35	30	1	0	0	31	34	45
18:30	24	3	0	0	27	28	1	0	0	29	38	50
18:45	33	1	0	0	34	37	2	0	0	39	36	47
19:00	19	1	0	0	20	20	1	0	0	21	31	41
19:15	18	2	0	0	20	23	2	0	0	25	30	39
19:30	22	1	0	0	23	23	1	0	0	24	25	33
19:45	19	0	0	0	19	20	0	0	0	20	24	32
Total	1410	43	1	0	1454	1399	44	1	0	1444	23	-

08:00 - 12 + 1 LGV = 13.

20:00 - 23 Cars.

Total	65	4	7	76
-------	----	---	---	----


ALDI STORE, CLAYCLIFFE RD, BARUGH GREEN, BARNSELEY - SATURDAY 12 APRIL 2014

In						Out					Occ.	% Cap.
Time	Car	LGV	OGV1	M/C	Total	Car	LGV	OGV1	M/C	Total		
8:00	16	2	1	0	19	6	0	0	0	6	32	42
8:15	15	1	0	0	16	20	1	0	0	21	45	59
8:30	14	3	0	0	17	20	3	0	0	23	40	53
8:45	21	0	0	0	21	20	1	1	0	22	34	45
9:00	28	0	0	0	28	13	1	0	0	14	33	43
9:15	24	1	0	0	25	17	0	0	0	17	47	62
9:30	31	0	0	0	31	21	1	0	0	22	55	72
9:45	38	0	0	0	38	28	0	0	0	28	64	84
10:00	31	0	0	0	31	32	0	0	0	32	74	97
10:15	39	1	0	0	40	37	0	0	0	37	73	96
10:30	28	0	0	0	28	35	0	0	0	35	76	100
10:45	31	1	0	0	32	40	1	0	0	41	69	91
11:00	35	0	0	0	35	32	0	0	0	32	60	79
11:15	42	1	0	0	43	34	0	0	0	34	63	83
11:30	38	1	0	0	39	43	1	0	0	44	72	95
11:45	32	0	0	0	32	36	0	0	0	36	67	88
12:00	38	0	0	0	38	34	0	0	0	34	63	83
12:15	43	1	0	0	44	45	1	0	0	46	67	88
12:30	31	2	0	0	33	32	0	0	0	32	65	86
12:45	33	0	0	0	33	29	1	0	0	30	66	87
13:00	29	0	0	0	29	34	2	0	0	36	69	91
13:15	36	1	0	0	37	25	1	0	0	26	62	82
13:30	32	0	0	0	32	24	0	0	0	24	73	96
13:45	20	3	0	0	23	33	1	0	0	34	81	107
14:00	24	2	0	0	26	29	2	0	0	31	70	92
14:15	37	1	0	0	38	33	1	0	0	34	65	86
14:30	29	1	0	0	30	33	1	0	0	34	69	91
14:45	35	2	0	0	37	40	1	0	0	41	65	86
15:00	30	1	0	0	31	33	4	0	0	37	61	80
15:15	53	0	0	0	53	47	1	0	0	48	55	72
15:30	29	0	0	0	29	36	1	0	0	37	60	79
15:45	28	0	0	0	28	35	1	0	0	36	52	68
16:00	46	2	0	0	48	34	1	0	0	35	44	58
16:15	31	0	1	0	32	33	1	0	0	34	57	75
16:30	41	3	0	0	44	35	1	1	0	37	55	72
16:45	27	2	0	0	29	32	0	0	0	32	62	82
17:00	29	2	0	0	31	36	0	0	0	36	59	78
17:15	40	3	0	0	43	29	3	0	0	32	54	71
17:30	36	1	0	0	37	37	2	0	0	39	65	86
17:45	29	0	0	0	29	38	2	0	0	40	63	83
18:00	20	0	0	0	20	37	1	0	0	38	52	68
18:15	17	0	0	0	17	25	0	0	0	25	34	45
18:30	23	0	0	0	23	27	0	0	0	27	26	34
18:45	14	0	0	0	14	14	0	0	0	14	22	29
19:00	17	0	0	0	17	14	0	0	0	14	22	29
19:15	16	0	0	0	16	20	0	0	0	20	25	33
19:30	13	0	0	0	13	12	0	0	0	12	21	28
19:45	9	1	0	0	10	11	0	0	0	11	22	29
Total	1398	39	2	0	1439	1410	38	2	0	1450	21	-


08:00 - 32 Cars.

20:00 - 20 + 1 LGV's = 21.

Total	65	4	7	76
-------	----	---	---	----

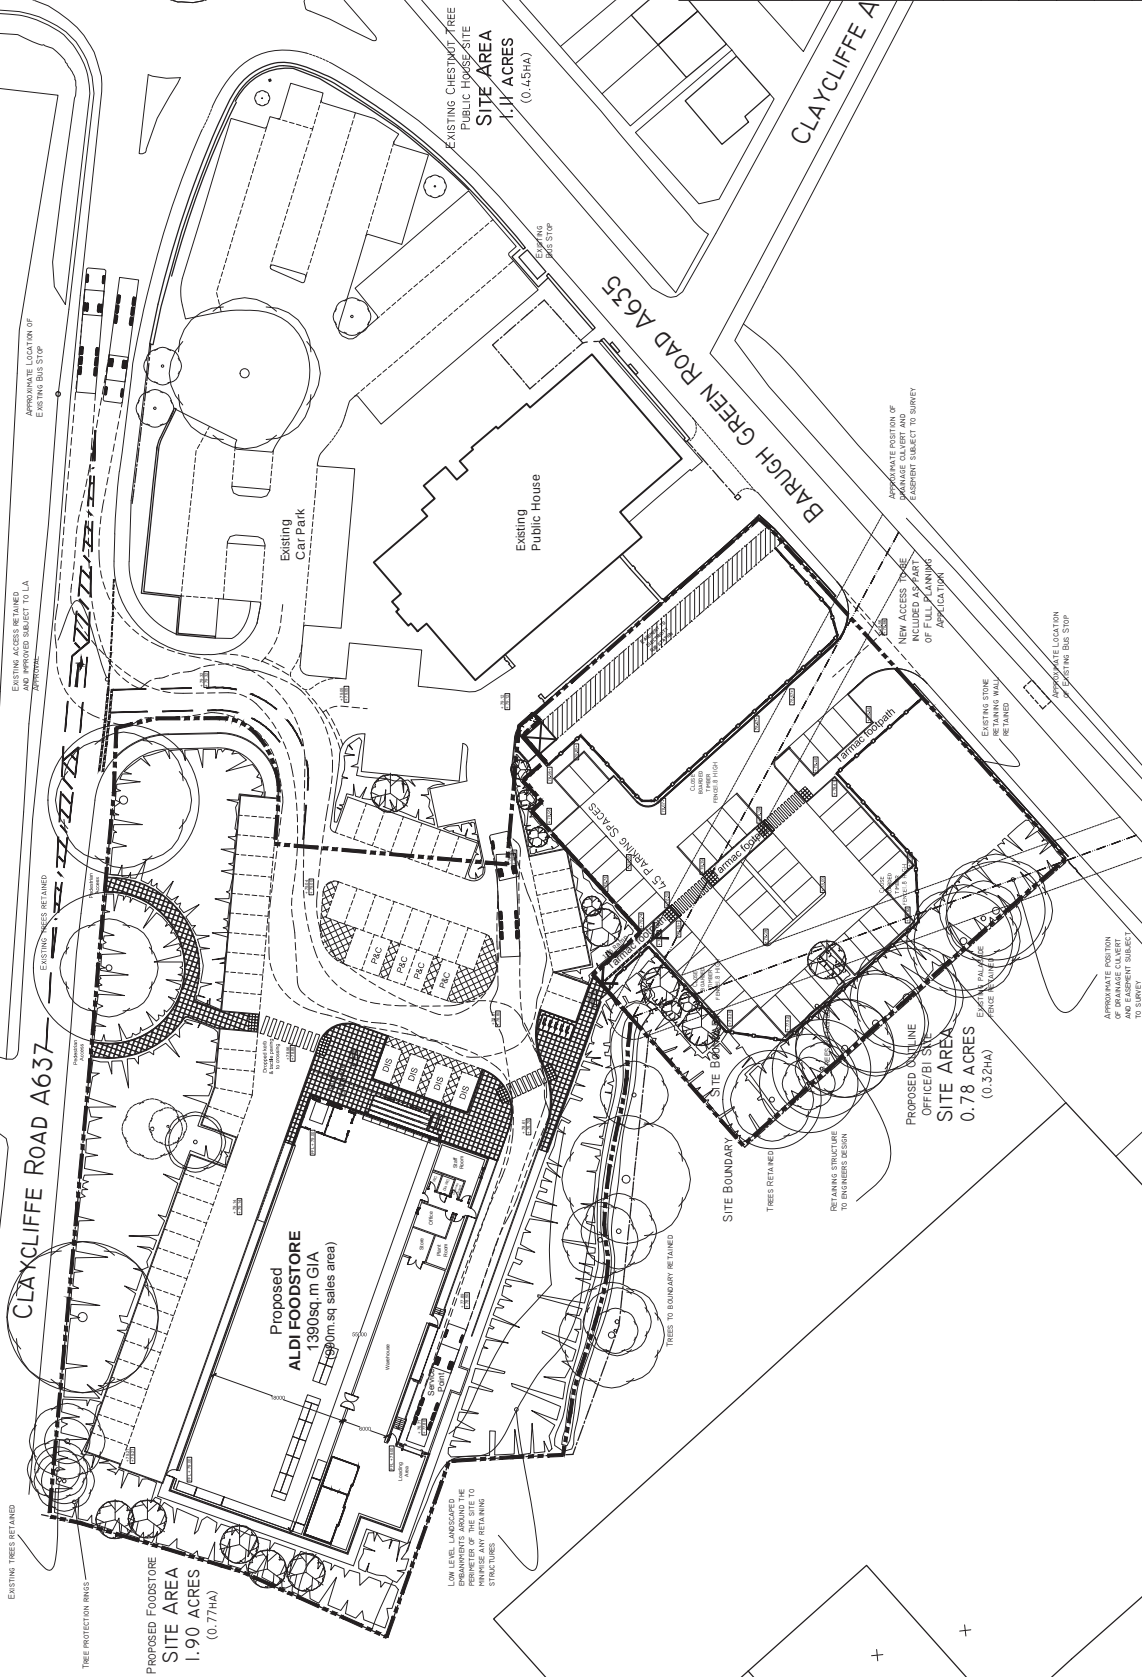

- 15.08.12 GH
03.05.11 NC
13.10.10 JB
11.10.10 JB
22.06.10 JB
- E Updated site plan
F Updated site plan
D Proposed site plan
C Outline site unit text updated
B Outline site unit text updated
A Outline site units updated
- Revisions

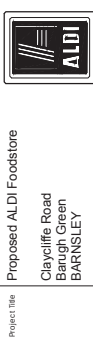

Project Title	Proposed ALDI Foodstore
Client	Claycliffe Road Barugh Green BARNESLEY
Client	ALDI Stores
Status	PLANNING
Scale	1:500
Drawn By	JDB
Checked By	NUC
Date	06-2010
Drawing Size	A2

Drawing Title	Proposed Site Layout
Job/Dwg No	0454-15
Rev	F

THE HARRIS PARTNERSHIP WARRICK
7, THE HARRIS PARTNERSHIP WARRICK
T. 01824 291 800 F. 01824 290 072
WARRICK, STAFFORDSHIRE ST16 2JH

THE HARRIS PARTNERSHIP MANCHESTER
MANCHESTER, MANCHESTER
T. 0161 238 8555 F. 0161 244 9009
MANCHESTER, MANCHESTER

THE HARRIS PARTNERSHIP MILTON KEYNES
MILTON KEYNES, MILTON KEYNES
T. 01908 211 577 F. 01908 211 722
MILTON KEYNES, MILTON KEYNES

THE HARRIS PARTNERSHIP NEWCASTLE
NEWCASTLE, NEWCASTLE
T. 0118 850 7700 F. 0118 856 8642
NEWCASTLE, NEWCASTLE

THE HARRIS PARTNERSHIP
ARCHITECTS
www.harrispartnership.com