


XPO ASOS lightboxes



IF IN DOUBT PLEASE ASK!

This drawing and design is the copyright of aja architects & must not be reproduced or put in public without prior written consent. Contractors must verify all dimensions on site before commencing work or preparing final drawings.

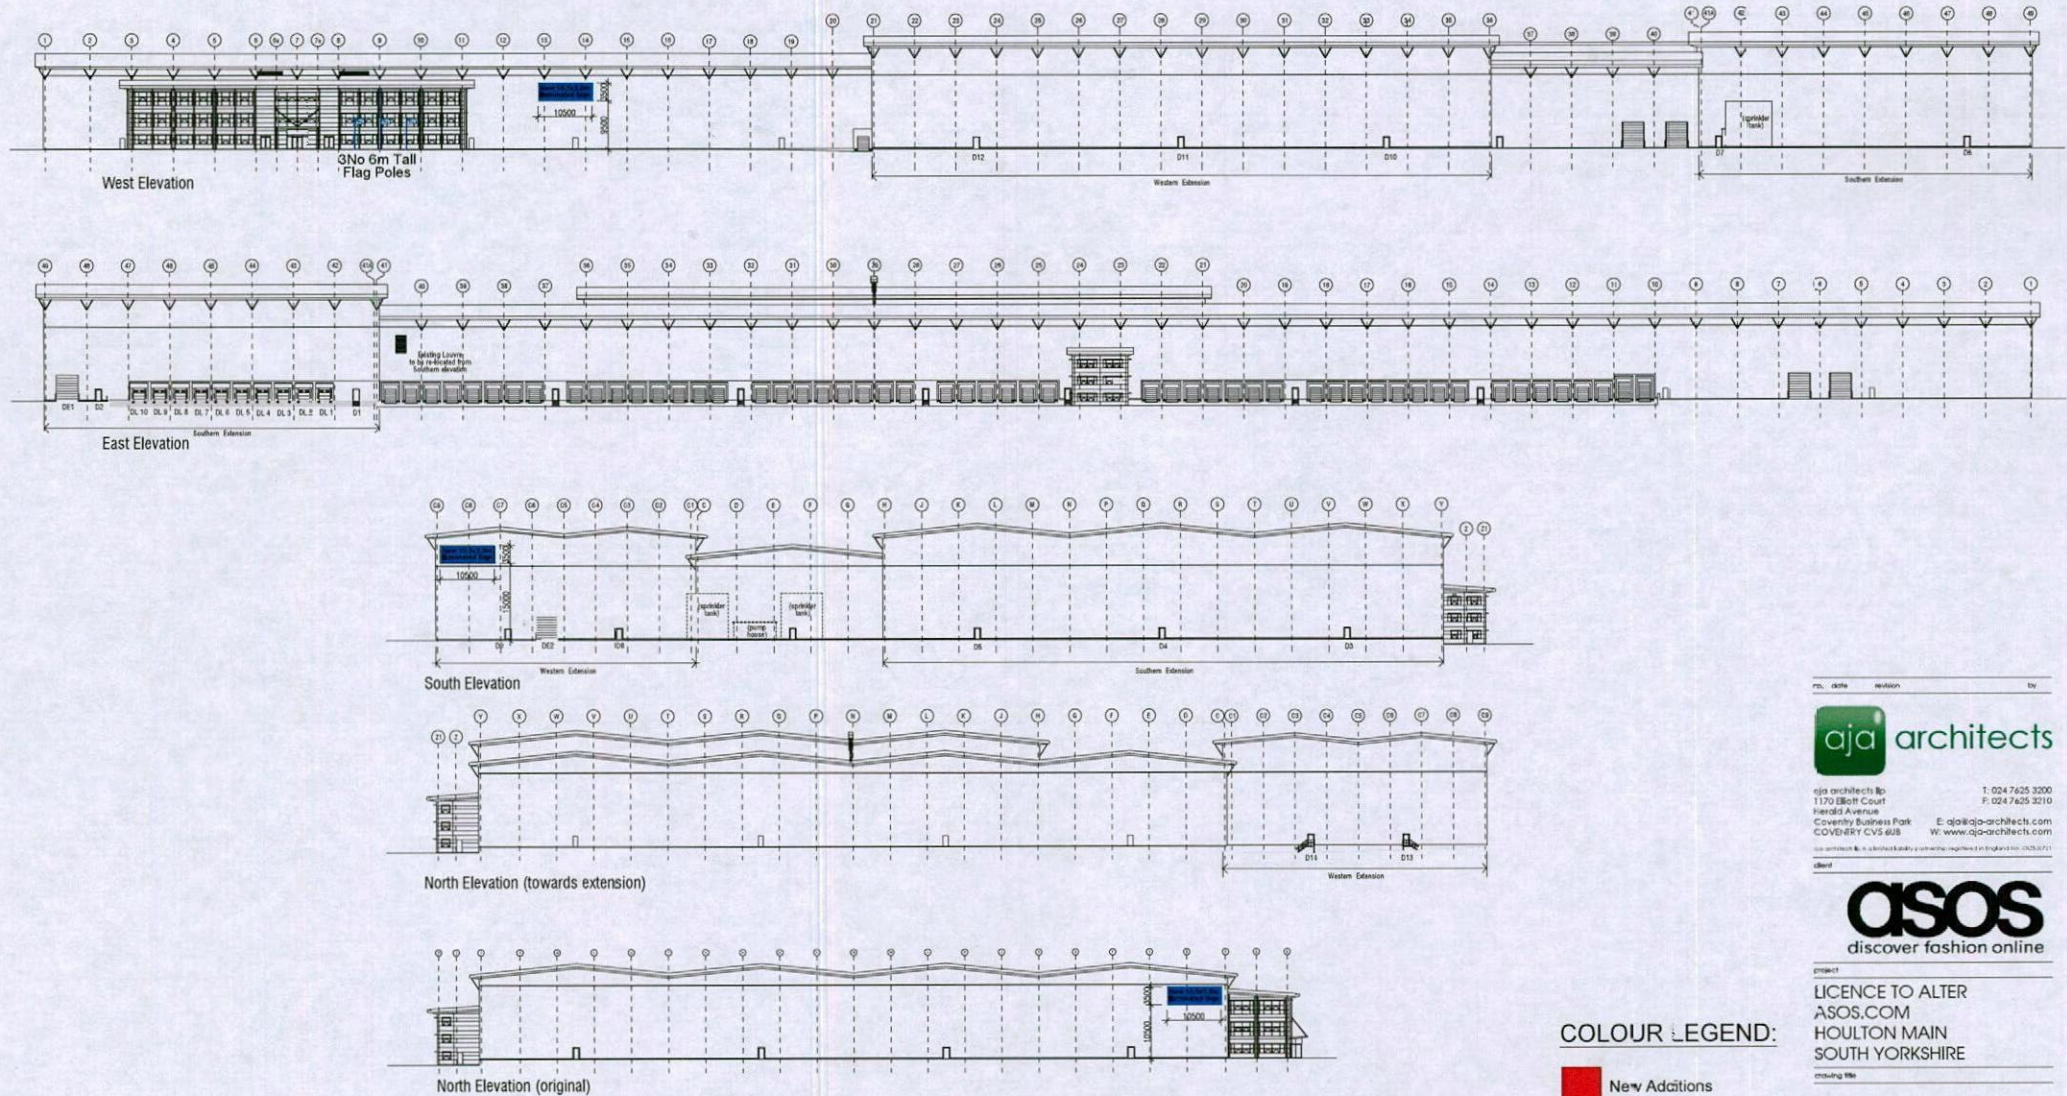

COLOUR LEGEND:

- New Additions
- Previous Objects Now Different (dashed line)
- Proposed Signage and Flag Poles
- Denotes Site Boundary

no. date revision by

aja architects

aja architects ltd
1170 Eltham Court
Herald Avenue
Coventry Business Park
COVENTRY CV3 6JH
E: aja@aja-architect.com
W: www.aja-architect.com

aja architects is a limited liability partnership registered in England no. 02531711

asos
discover fashion online

project
LICENCE TO ALTER
ASOS.COM
HOULTON MAIN
SOUTH YORKSHIRE
drawing title

EXTERNAL ELEVATIONS

Sheet 1 of 1

scale 1:500 @ A1 drawn SPW

checked date 22.12.15


drawing no.

5742 - 1011

RECORD DRAWING

IF IN DOUBT PLEASE ASK!

This drawing and design is the copyright of aja architects and must not be reproduced or used in any way without the prior written consent of aja architects. All dimensions are in metres unless otherwise stated. All dimensions are to be taken from the centre of the drawing.

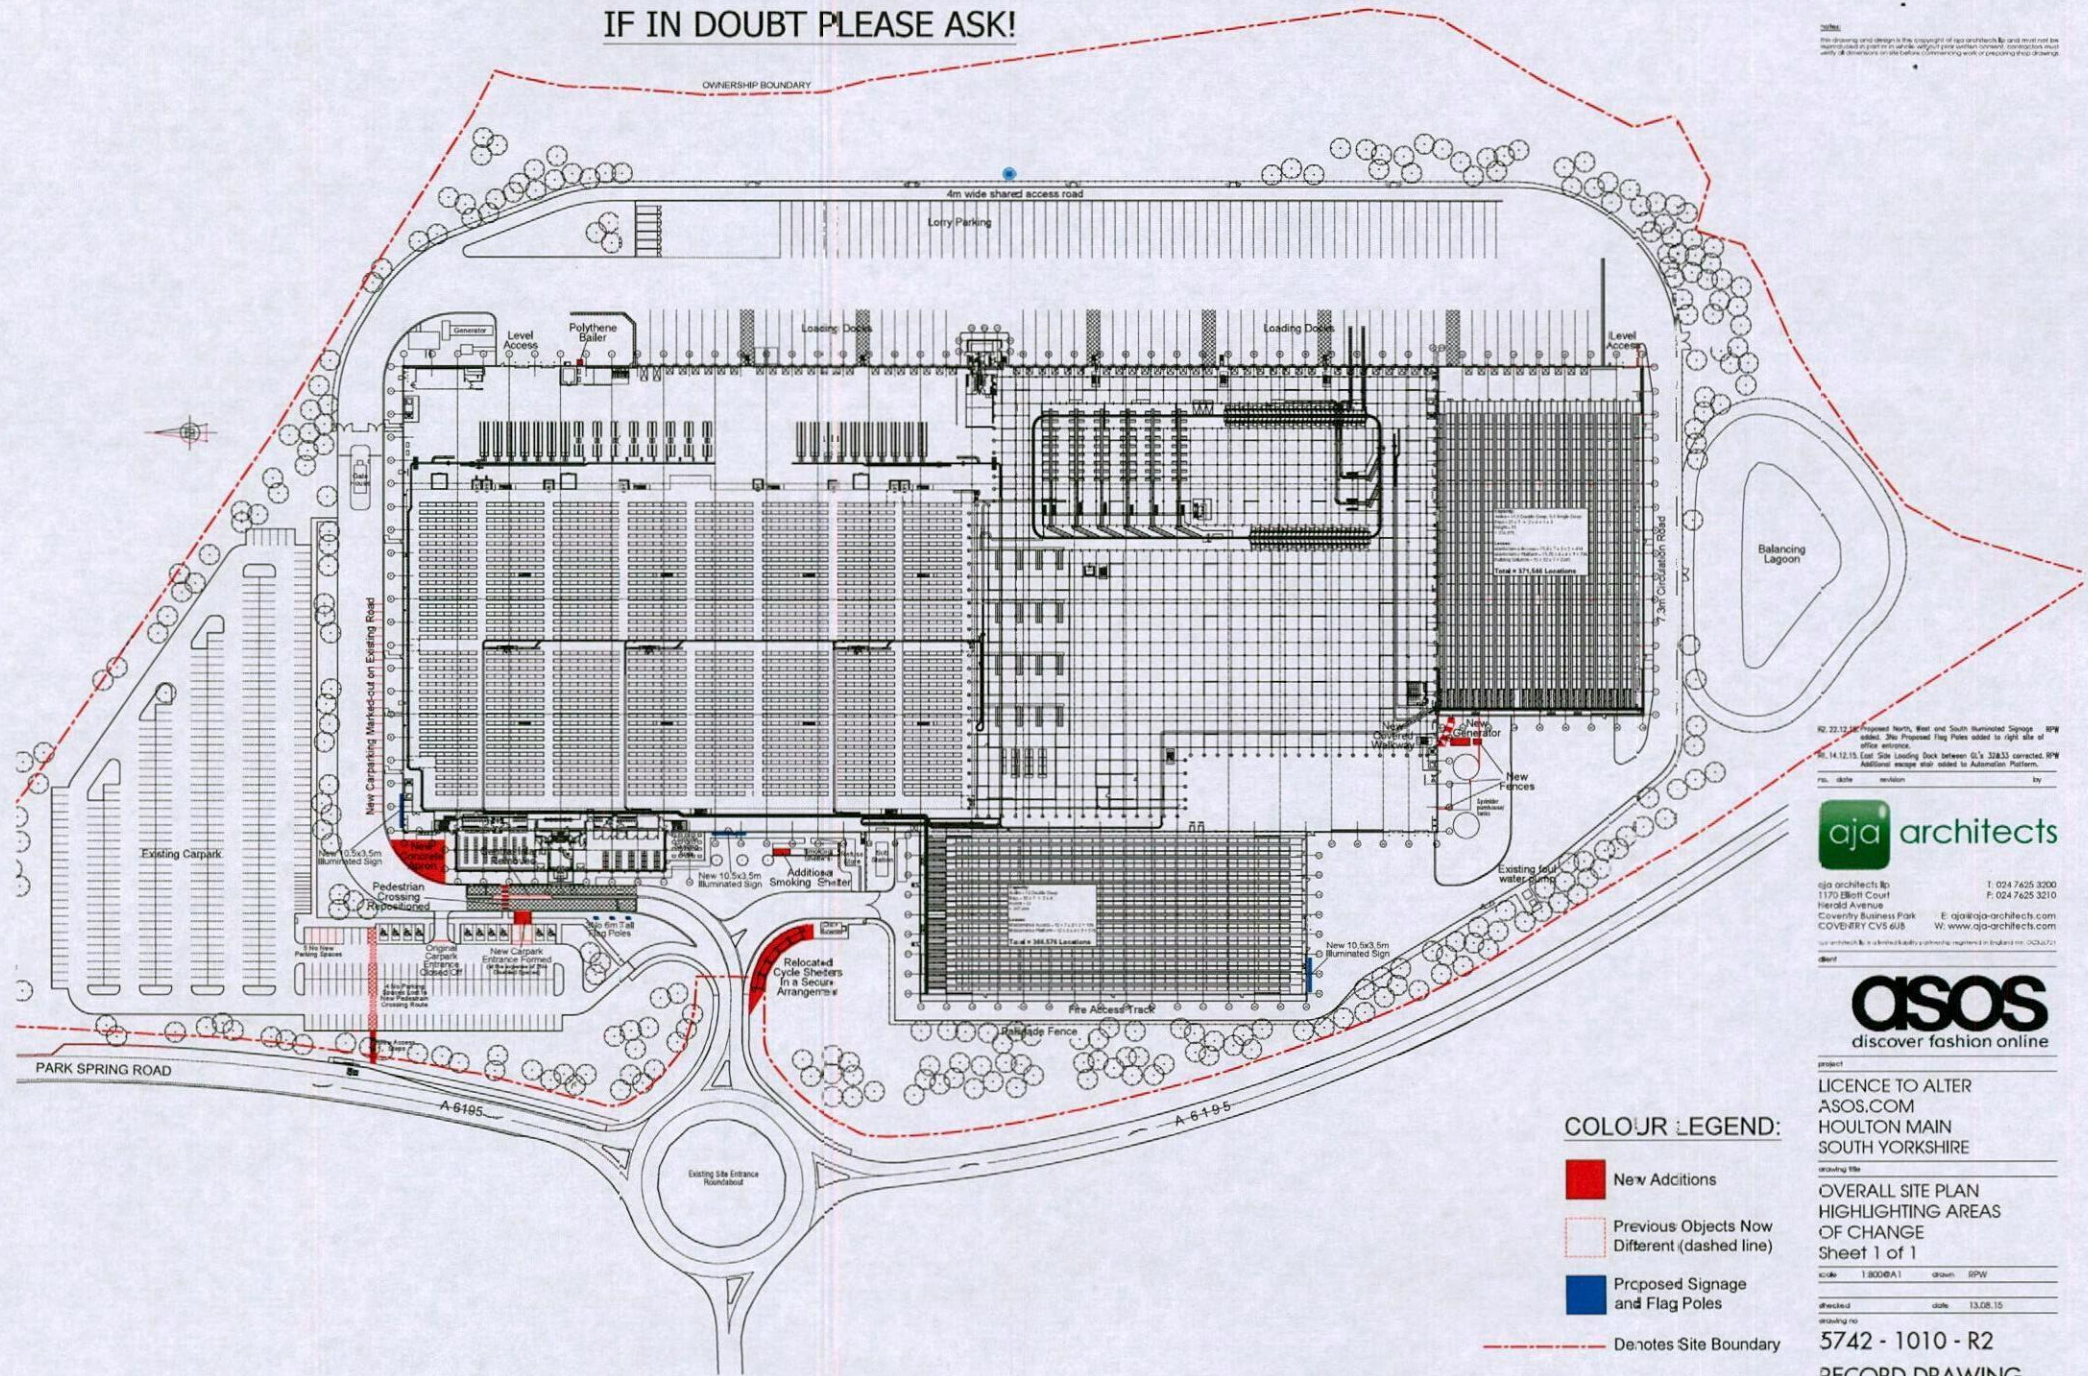

R2, R2.12, R2.13 Proposed North, West and South Illuminated Signage - R/W added. See Proposed Flag Poles added to right side of office entrance.
 R2, R2.12, R2.13 East Side Loading Dock between G/L's 328.33 corrected. R/W added. See also added to Automation Platform.

aja architects
 aja architects ltd
 1170 Bluff Court
 Herald Avenue
 Coventry Business Park
 COVENTRY CV5 6UB
 T: 024 7625 3200
 F: 024 7625 3210
 E: aja@aja-architects.com
 W: www.aja-architects.com

asos
 discover fashion online

COLOUR LEGEND:

- New Additions
- Previous Objects Now Different (dashed line)
- Proposed Signage and Flag Poles
- Denotes Site Boundary

project
 LICENCE TO ALTER
 ASOS.COM
 HOULTON MAIN
 SOUTH YORKSHIRE

drawing title
 OVERALL SITE PLAN
 HIGHLIGHTING AREAS
 OF CHANGE
 Sheet 1 of 1

scale 1:8000A1 drawn GPW
 checked date 13.08.15
 drawing no 5742 - 1010 - R2
 RECORD DRAWING