



ELEVATION A  
SCALE 1:100

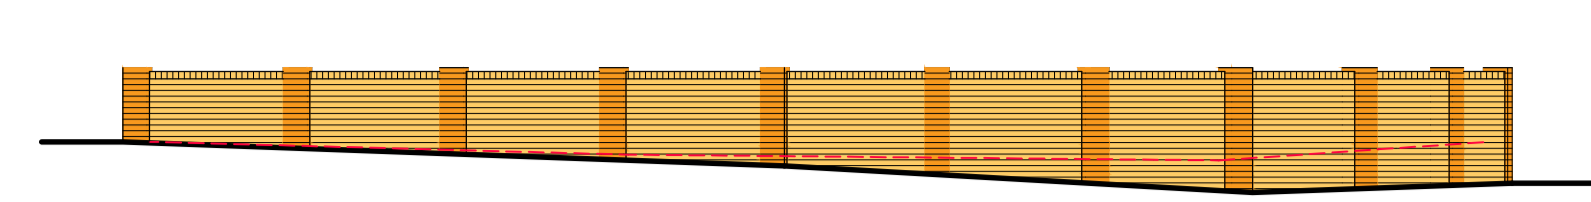

ELEVATION B  
SCALE 1:100

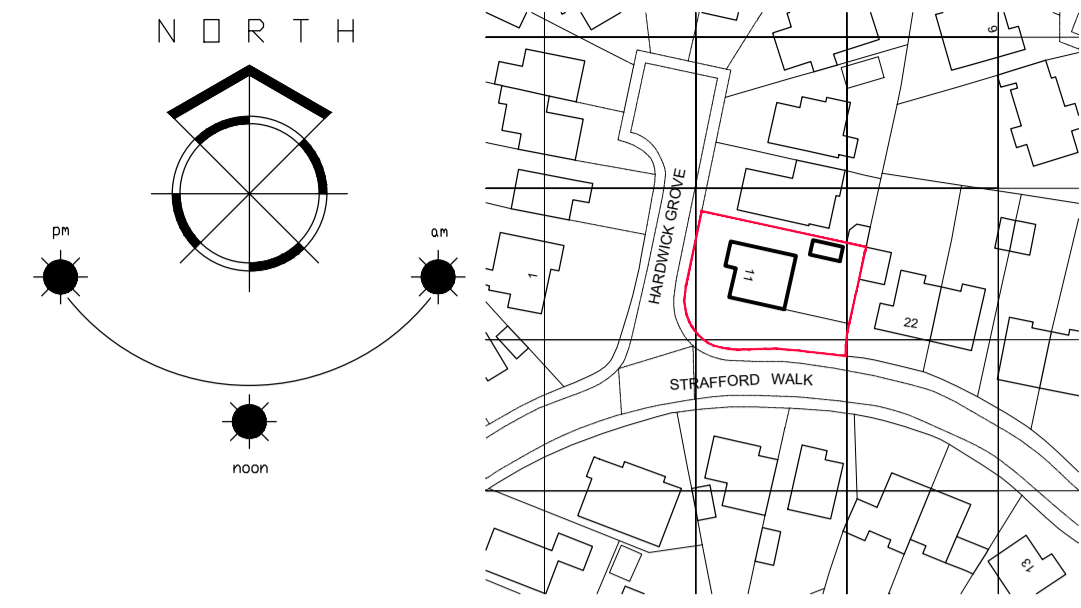

LOCATION PLAN  
SCALE 1:1250

1. THIS DRAWING AND THE COPYRIGHTS AND PATENTS THEREIN ARE THE PROPERTY OF NYP ARCHITECTURAL LTD. REGISTERED IN ENGLAND AND WALES No. PENDING AND MAY BE USED OR REPRODUCED ONLY UNDER CONTRACT.
2. CONTRACTORS AND SUB-CONTRACTORS MUST CHECK AND AGREE ALL DIMENSIONS BEFORE PREPARING SHOP DRAWINGS OR COMMENCING WORK ON SITE.
3. CONTRACTORS ARE RESPONSIBLE FOR INFORMING THE DESIGNER OF ANY DISCREPANCY DISCOVERED ON THIS DRAWING OR BETWEEN THIS DRAWING AND ANY OTHER RELATED DOCUMENT ISSUED UNDER THE STANDARD FORM OF CONTRACT IN RESPECT OF THE WORK.
4. WRITTEN DIMENSIONS ONLY ARE TO BE USED FROM THIS DRAWING. IF IN ANY DOUBT ASK FOR CLARIFICATION.

Revisions.

Date	Suffix	Description

Notes.



SITE PLAN  
SCALE 1:200

SITE PLAN  
SCALE 1:100



BBIC, INNOVATION WAY, BARNSELEY, S75 1JL  
Tel: 01226 200989, E: scott@nypas.co.uk

Project.  
**11 HARDWICK GROVE  
DODWORTH  
BARNSELEY  
S75-3SS**

Drawing Title.  
**PLANS & ELEVATIONS  
AS BUILT**

**RETROSPECTIVE  
PLANNING APP**

Client.  
**MRS C. CROSSLEY**

Date.  
**MAY 2025**

Scale.  
**AS INDICATED**

Ref.	Dwg. No.	Rev.
2026/70	02	.