
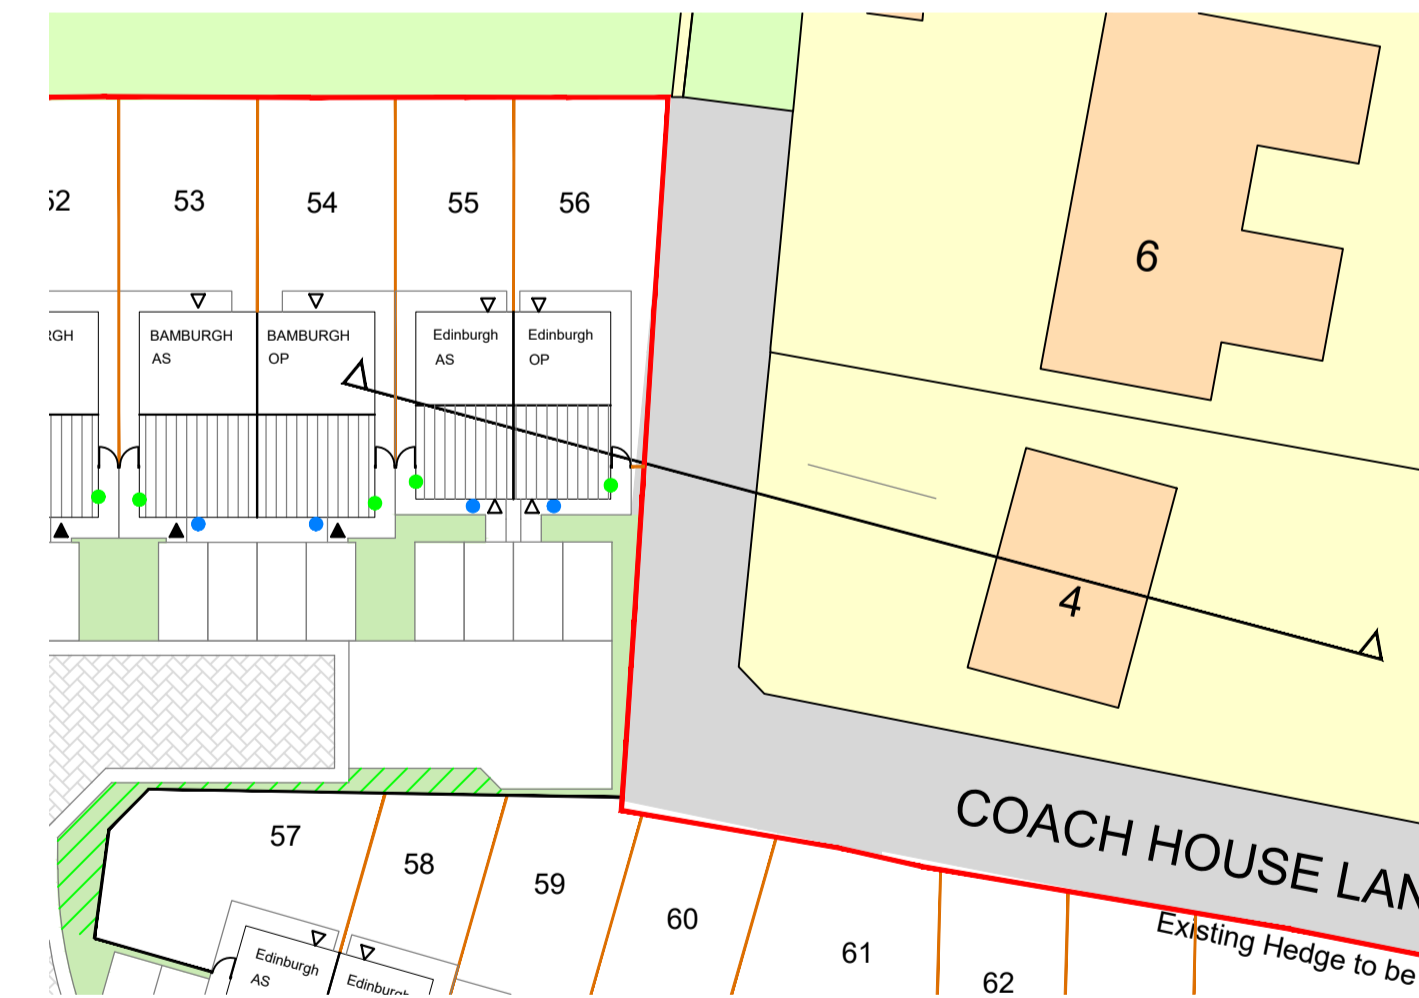


Mount Vernon Road, Barnsley - Site Sections

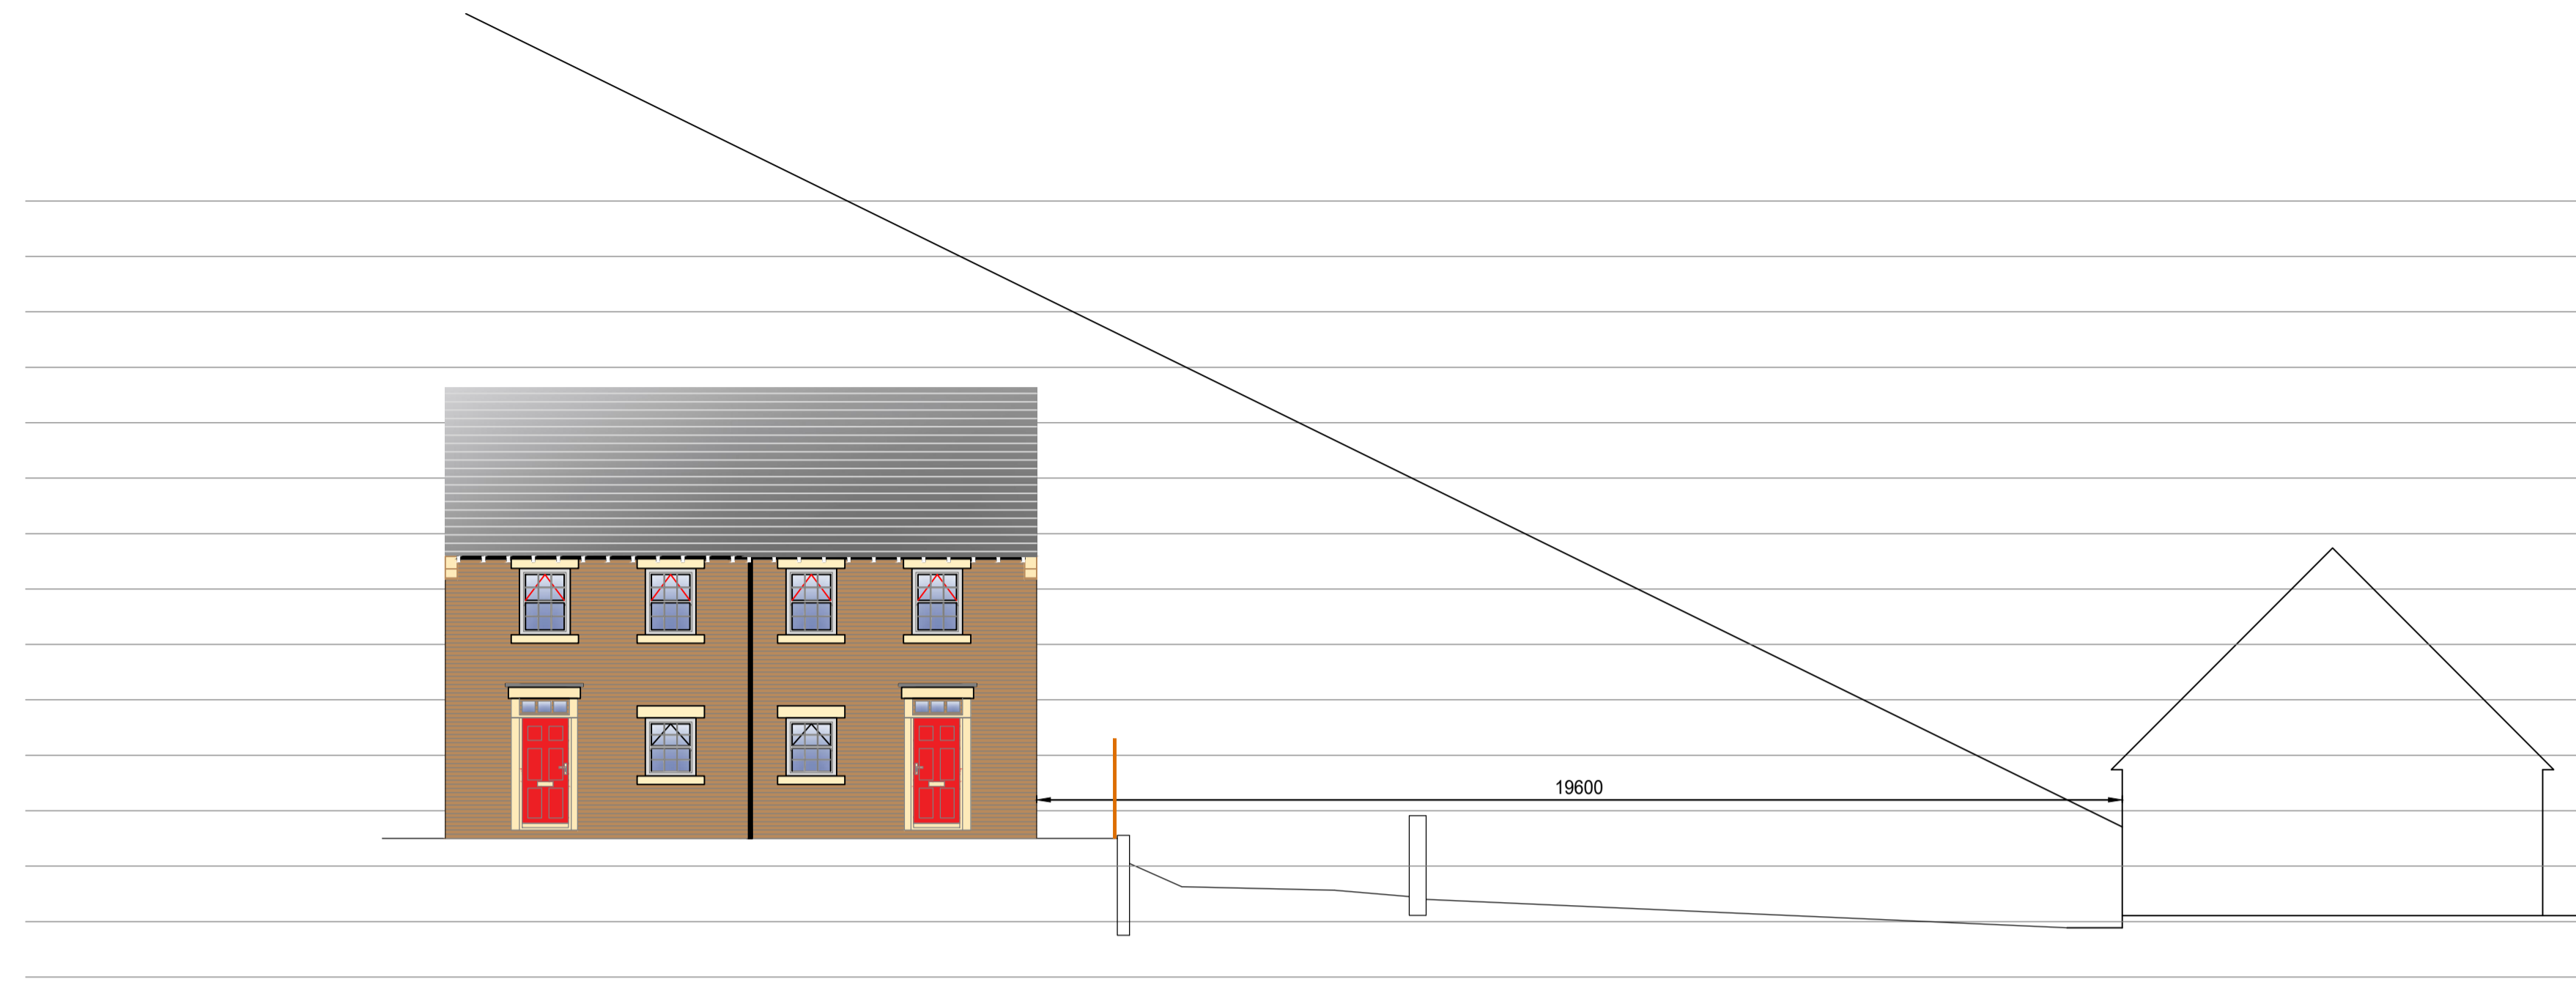

Revision notes:		
Rev:	Date:	Notes:
A	29.11.19	House Types and plot numbers amended to suit revised Site Layout - CD
B	09.01.20	House Types and plot numbers amended to suit revised Site Layout - CD
C	26.09.23	As built dim added to section - CD

Revision notes:		
Rev:	Date:	Notes:
..

Revision notes:		
Rev:	Date:	Notes:
..

Date: 20.12.18	Project: Mount Vernon Road, Barnsley
Scale @ A1: 1:100	Drawing Number: Site Sections - 4 2019/115
Drawn By: CD	Revision: C

OrionHomes 

SO GOOD TO COME HOME TO

Unit 5, Benton Office Park, Bennett Avenue,
Horbury, Wakefield, WF4 5RA, Tel: 01924 831030