







SITE PLAN
SCALE 1:1250

BLOCK PLAN
SCALE 1:500

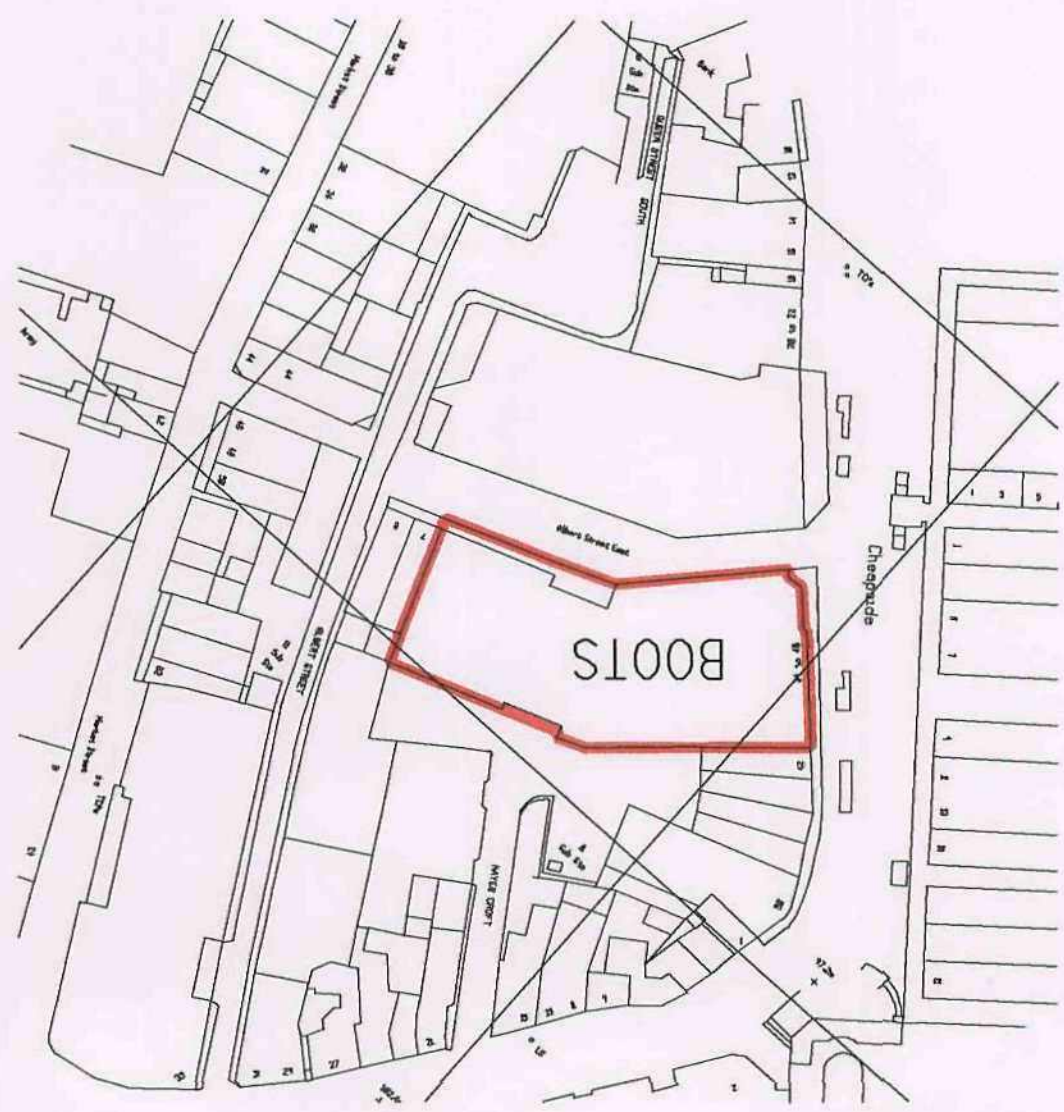

SITE & BLOCK PLAN

© Crown Copyright 2006. All rights reserved. Licence number 100020449

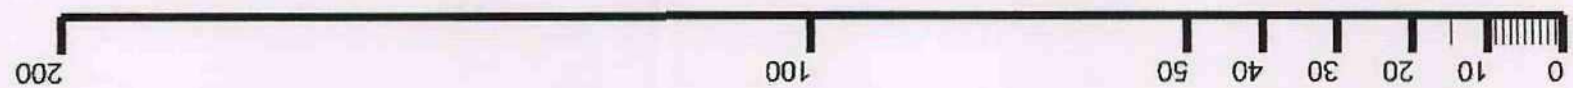

Rev	Dwg No
-	0045/45003/190


Project Name
BTC CHS ROOMS
ST 0045
BARNSELEY
Drawing Title
SITE PLAN
BLOCK PLAN
AS BUILT
Dept
Approved JH
Date 19:01:09
Scale 1:500/1250

H&L
Architects
11 Garsington Road
Reading RG1 2AA
Tel: 0118 952 9988
Fax: 0118 952 9989
www.hickley.com

HICKEY
Architects
11 Garsington Road
Reading RG1 2AA
Tel: 0118 952 9988
Fax: 0118 952 9989
www.hickley.com

NOTTINGHAM NG90 1BS
Tel No 0115 9506111



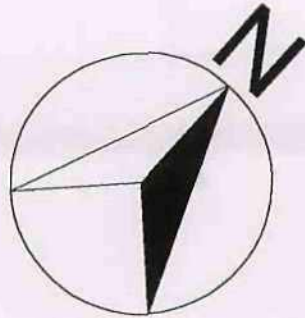

NOTES
Do not scale this drawing