





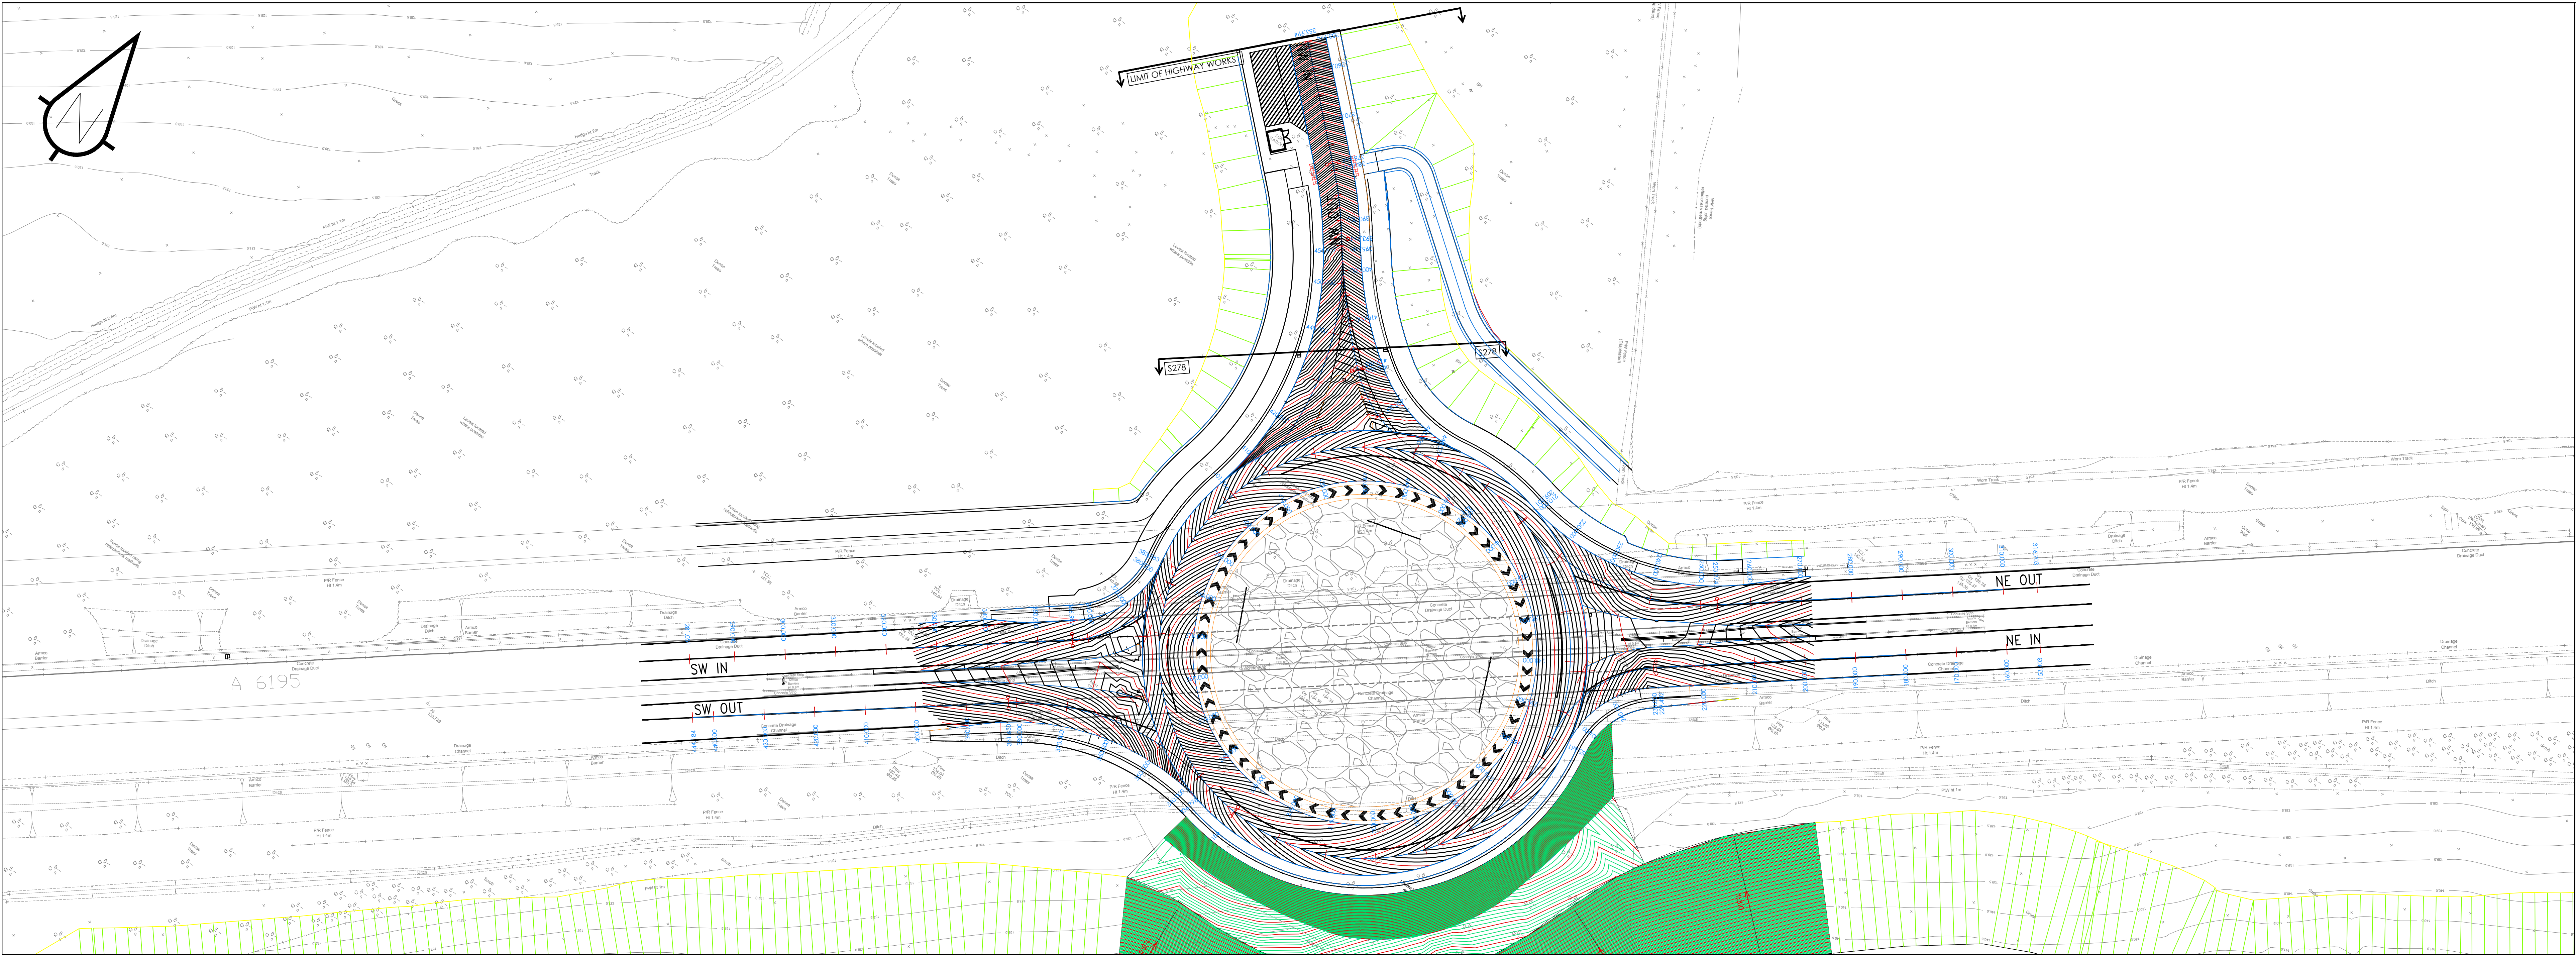


### GENERAL NOTES

1. ALL MATERIALS AND WORKMANSHIP IS TO COMPLY WITH JPG CONSULTANTS STANDARD SPECIFICATION & ALL RELEVANT BRITISH & EUROPEAN STANDARDS.
2. THIS DRAWING IS TO BE READ IN CONJUNCTION WITH ALL RELEVANT ARCHITECTS, M & E CONSULTANTS AND JPG CONSULTANTS DRAWINGS.
3. ANY DISCREPANCIES SHOULD BE REPORTED TO THE ENGINEER IMMEDIATELY SO THAT CLARIFICATION CAN BE SOUGHT PRIOR TO COMMENCEMENT OF WORKS.
4. THE TOPOGRAPHICAL SURVEY INFORMATION USED IN PREPARATION OF THIS AND ALL OTHER JPG DESIGNS AND DRAWINGS IS NOT WARRANTED. IT SHALL BE THE RESPONSIBILITY OF THE CONTRACTOR TO VERIFY ALL SURVEY INFORMATION PROVIDED AND REPORT ANY ANOMALIES TO JPG.

#### KEY

- PROPOSED LEVELS
- EXISTING LEVELS

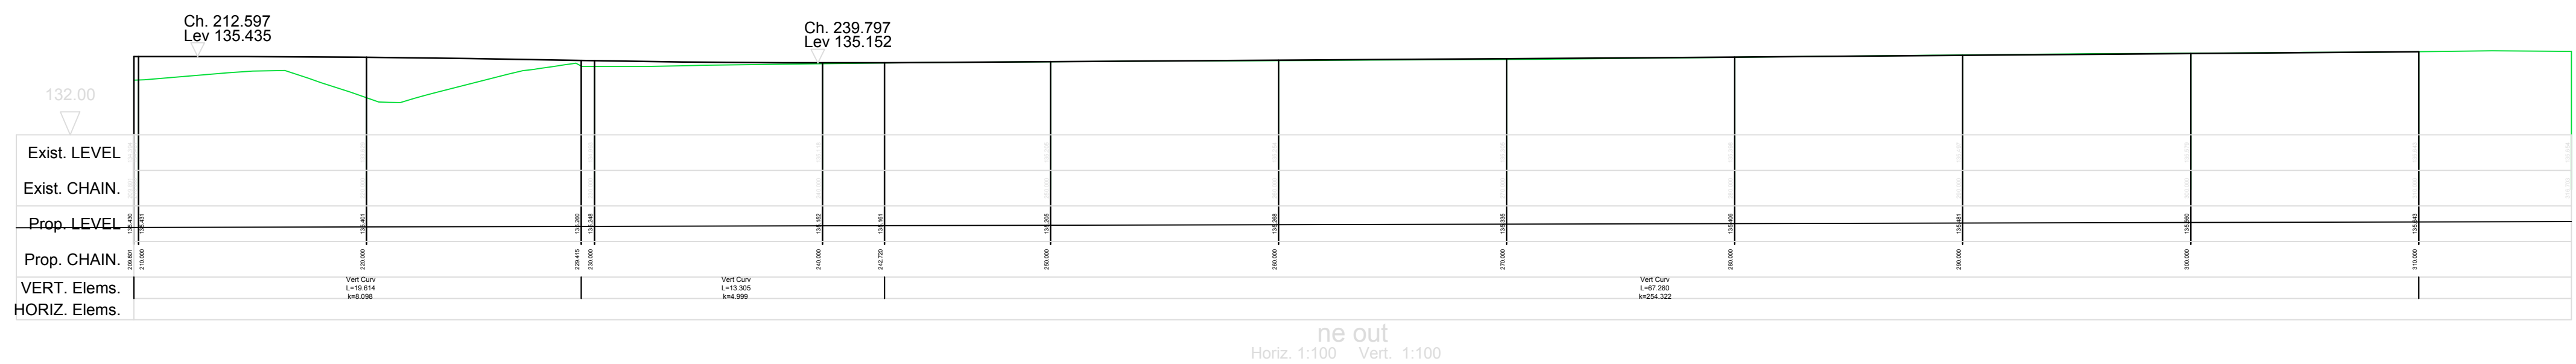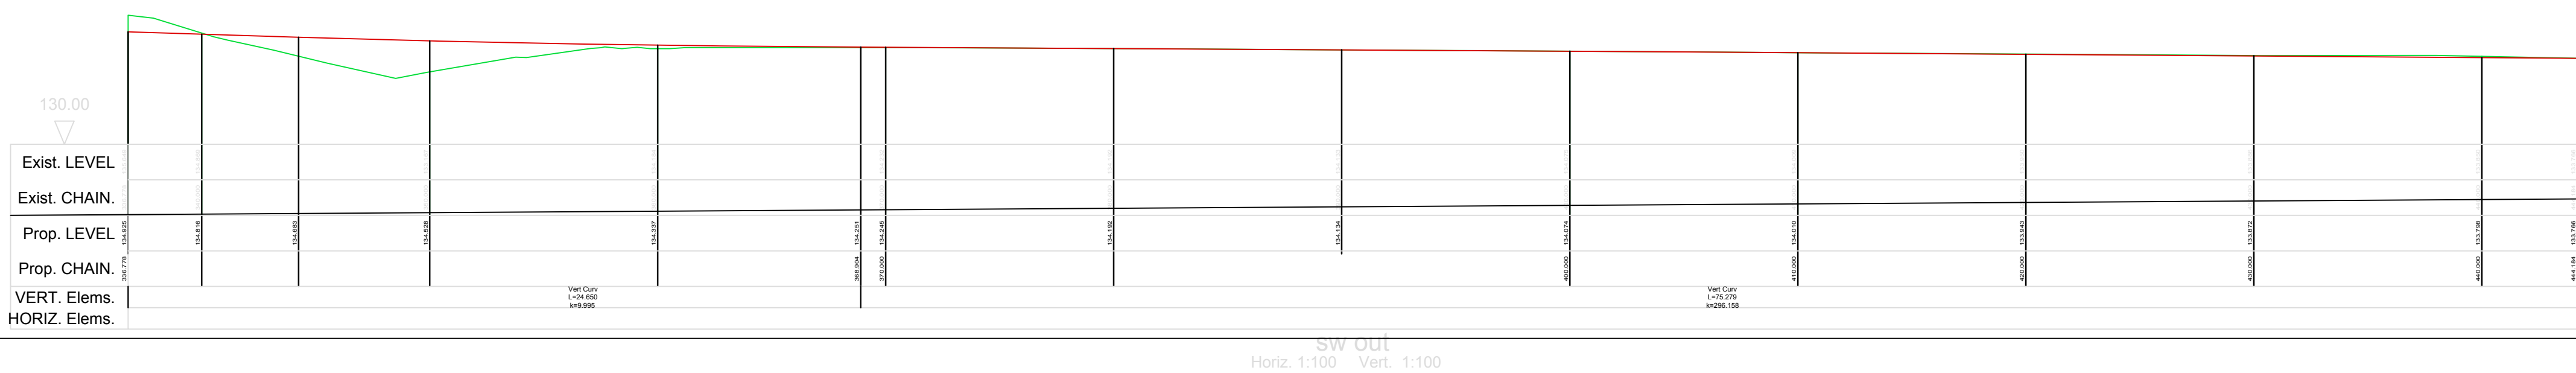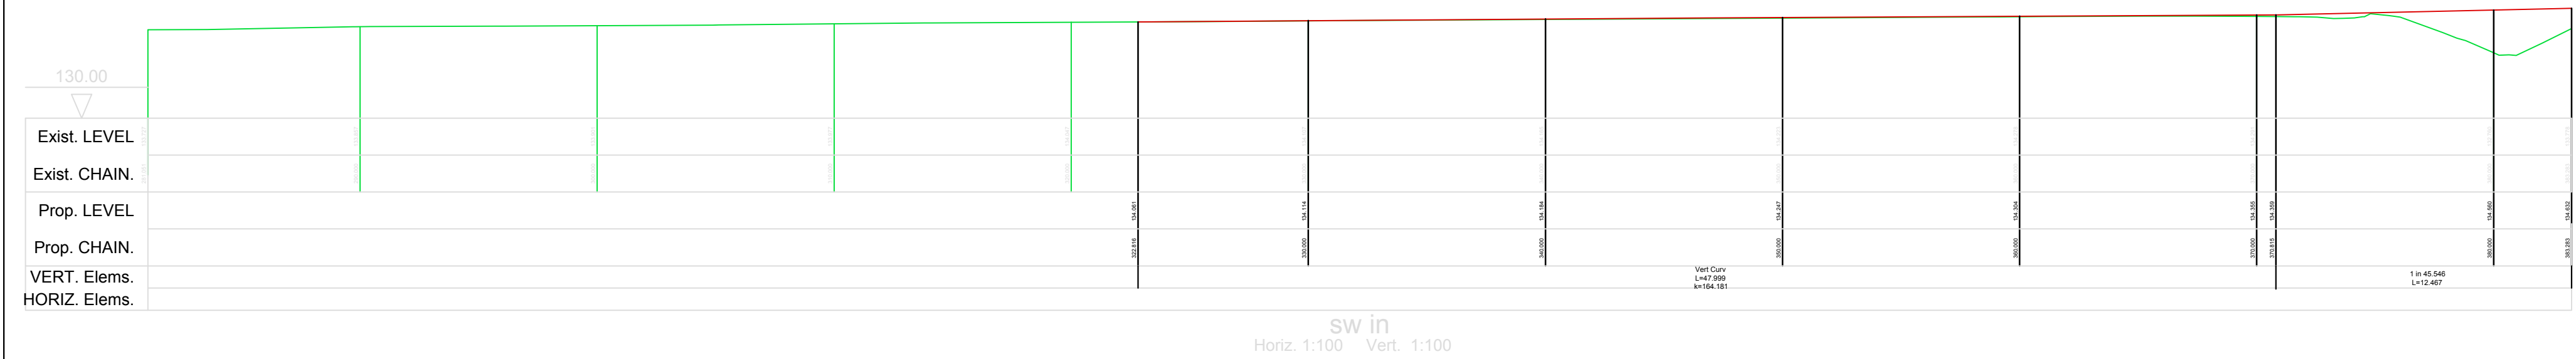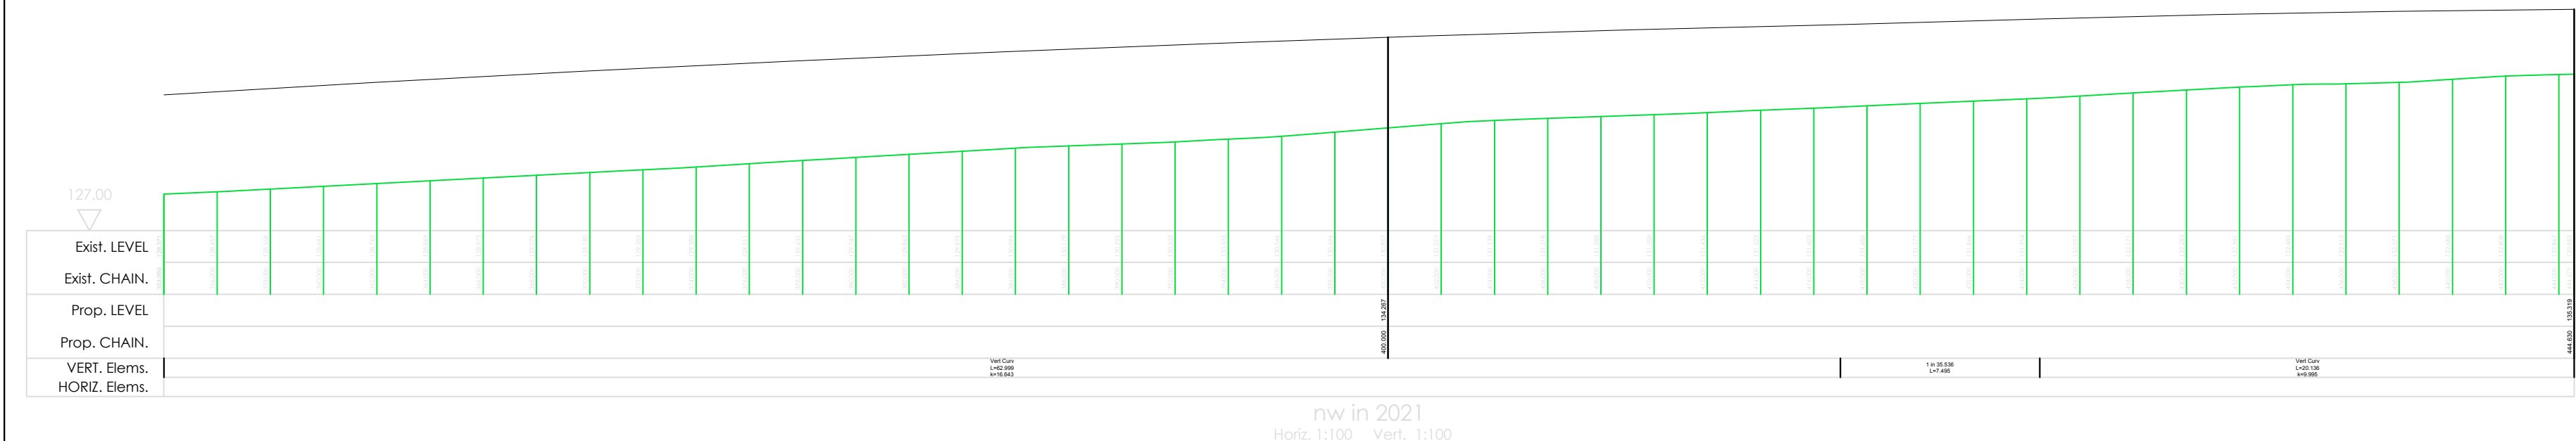

|   |                                   |     |            |     |
|---|-----------------------------------|-----|------------|-----|
| 8 | AS BUILT                          | 100 | 13/02/2022 | PJM |
| A | LAYOUT UPDATED AND SECTIONS ADDED | 108 | 24/05/2021 | PJM |

| Rev | Amendment | Drawn | Date | Checked |
|-----|-----------|-------|------|---------|
|-----|-----------|-------|------|---------|

AS BUILT  
DRAWING



Client  
Harworth Group

Project Title  
Rockingham Phase 2A & 2B,  
Hoyland

Drawing Title  
Section 278  
Longsections

Drawn By  
PJM

Checked By  
KS

Approved By  
KS

Scale  
1:500

Date  
22/12/20

Drawing Size  
A0

Drawing Number  
11700-S278-005

Rev  
B