
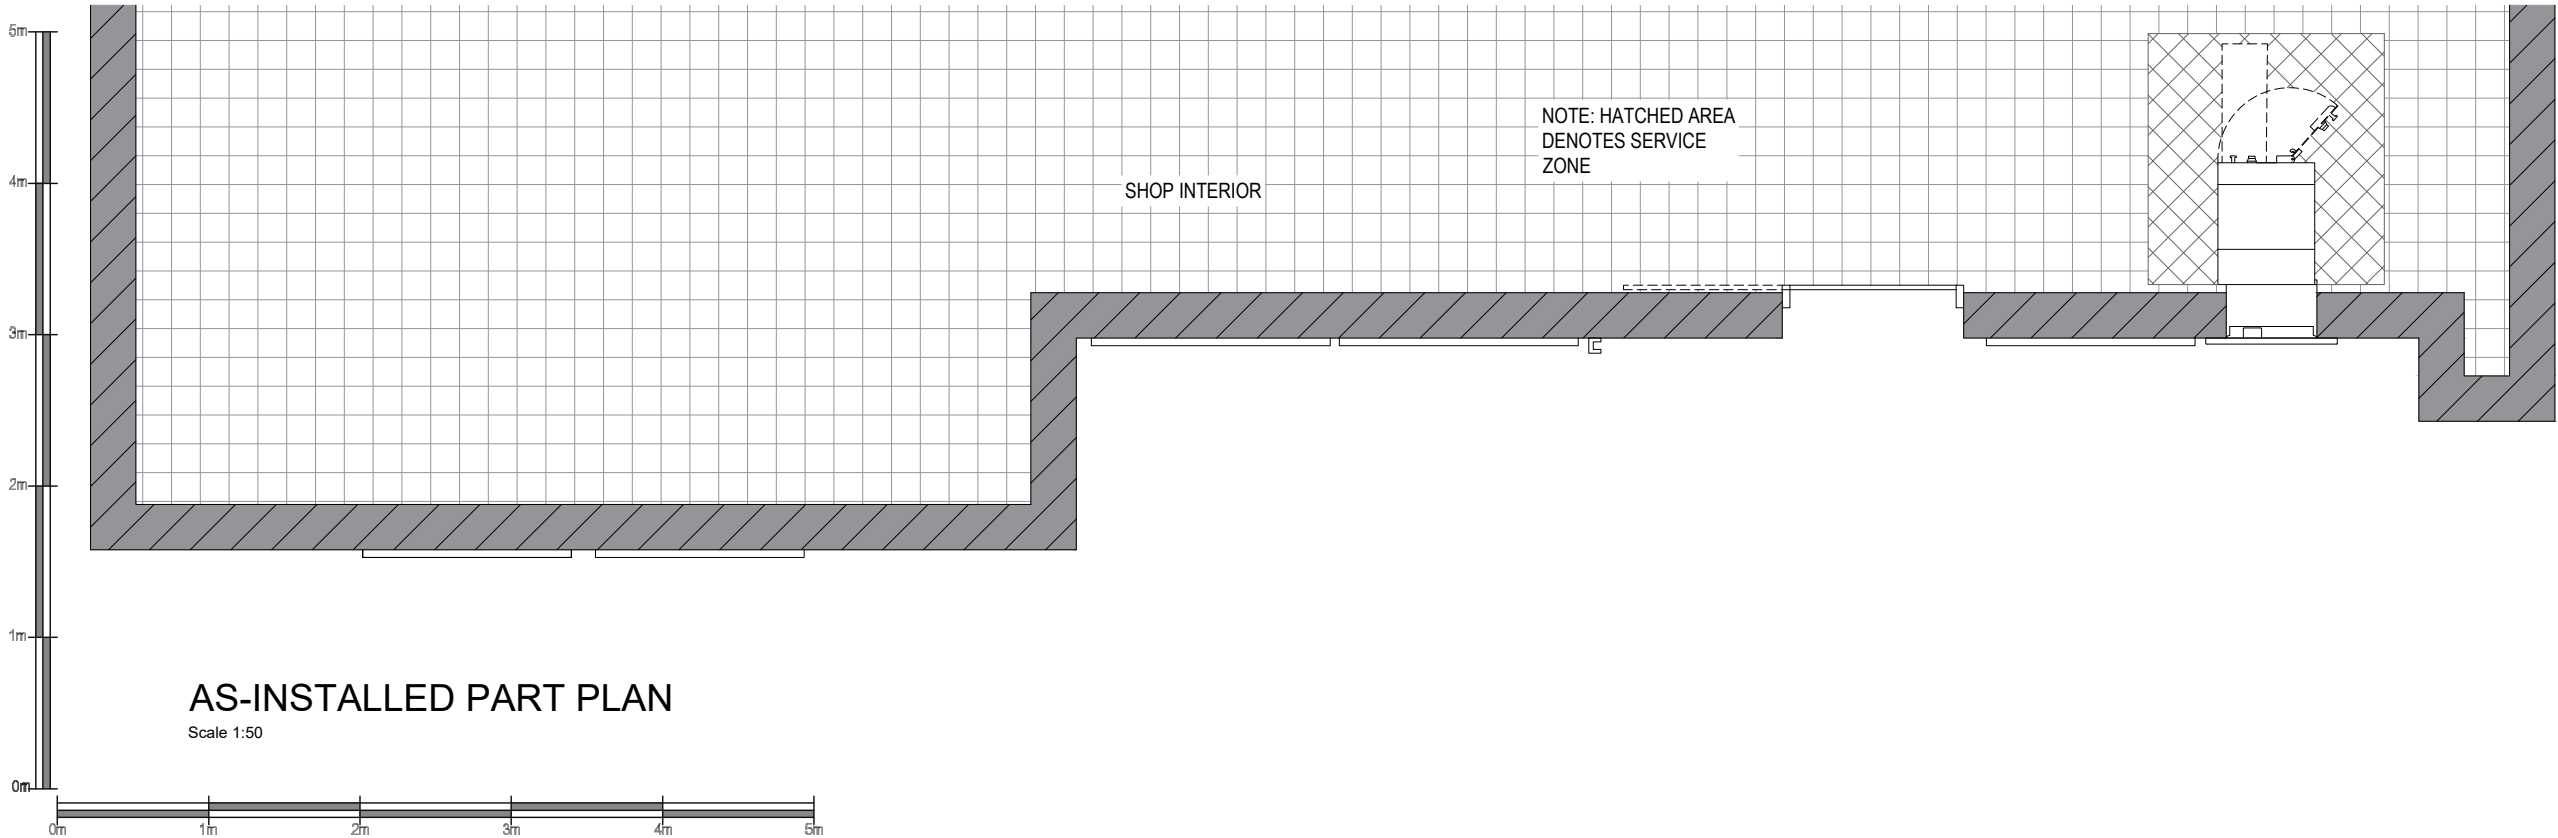


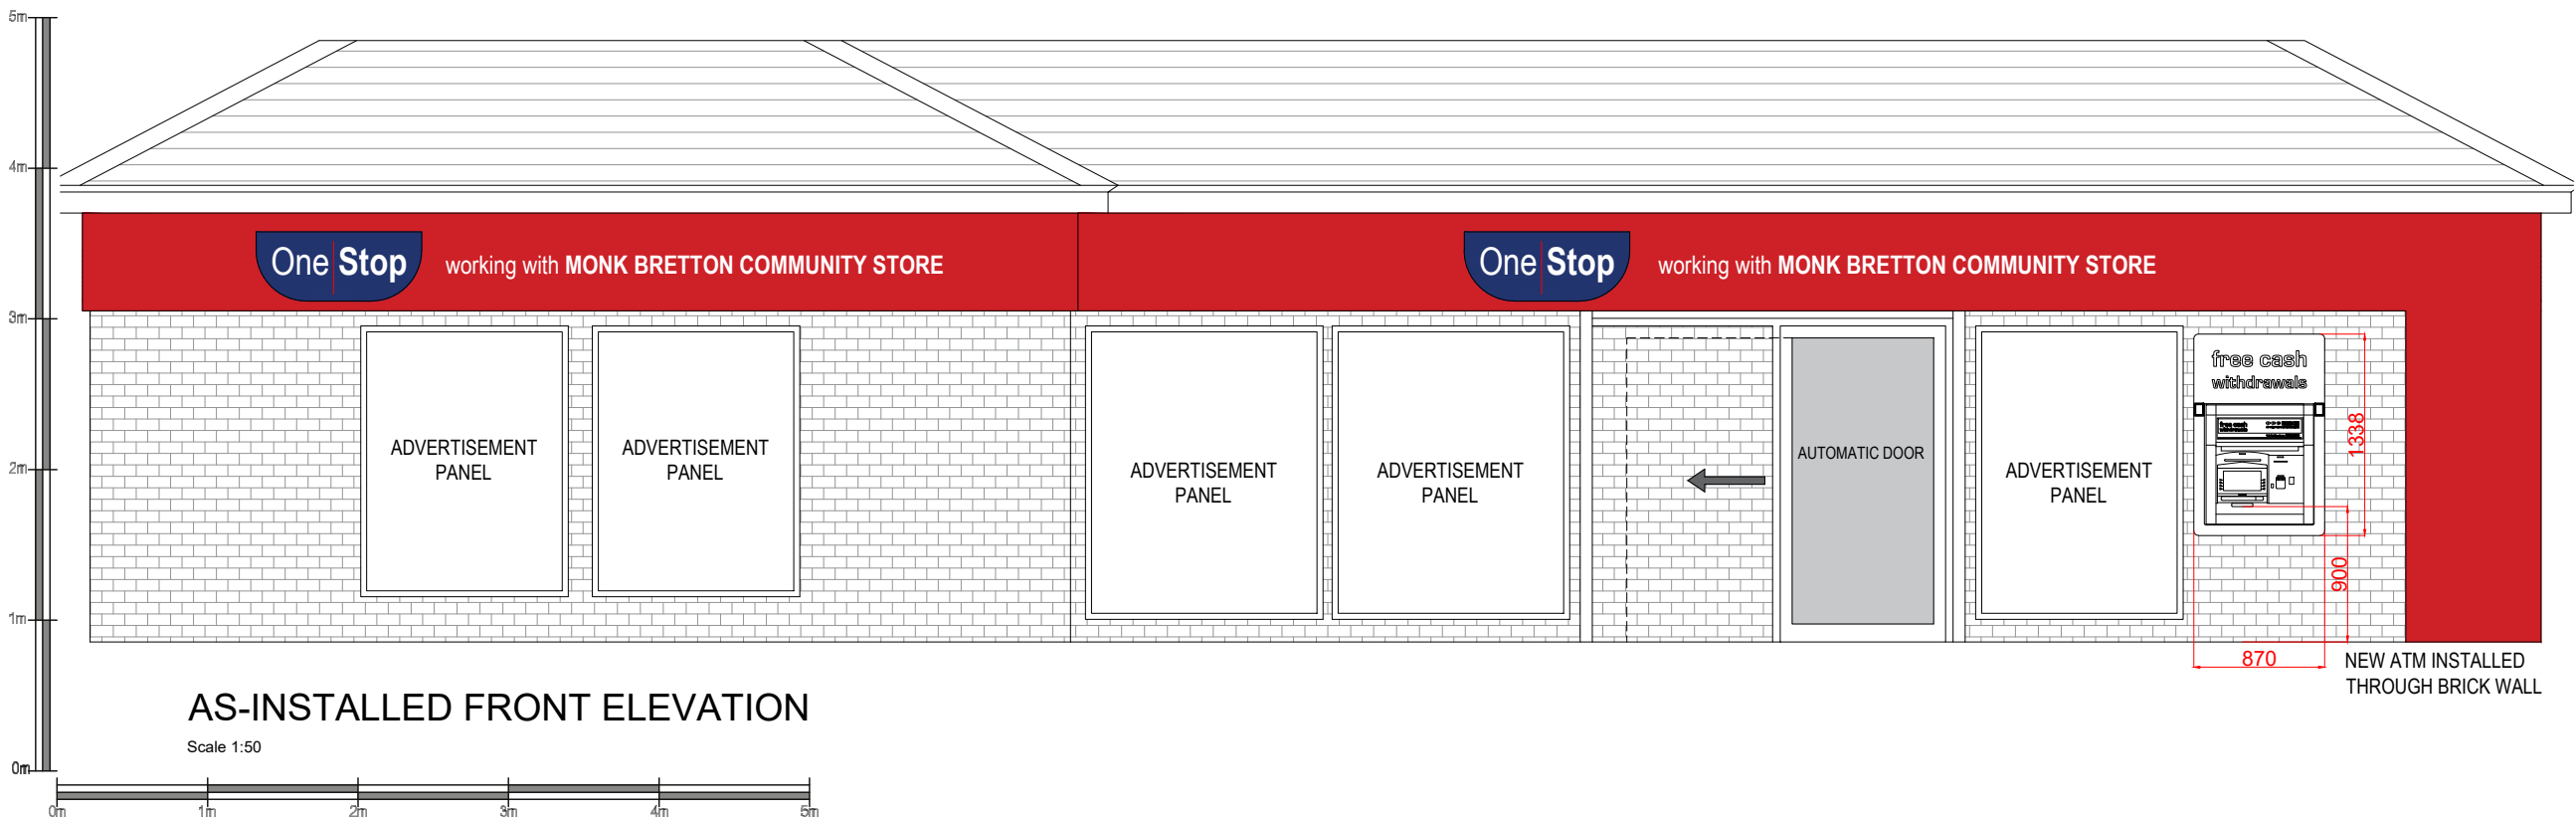

Date:	Comments:	By:
-------	-----------	-----

GENERAL NOTES:
1) All dimensions in millimeters unless otherwise stated.

Site:
One Stop,
14 Fish Dam Lane
Monkberatton,
Barnsley,
S71 2PX

Drawing Title:
As-Installed Plan and Elevation

Ref: T019812_AI	Date: 13/03/2020	Rev:
Scale: 1:50	Paper: A3	Date Rev: