



IMPORTANT NOTE:
ALL DIMENSIONS AND LEVELS SHOWN ON THIS DRAWING ARE TO BE CHECKED BY THE CONTRACTOR MANUFACTURER PRIOR TO THE COMMENCEMENT OF ANY WORKS ON SITE OR THE MANUFACTURE OF ANY SITE COMPONENTS.
THIS DRAWING IS NOT TO BE SCALED.
DIMENSIONS ARE INDICATED IN MILLIMETRES UNLESS CLEARLY STATED OTHERWISE.
COPYRIGHT OF THIS DRAWING BELONGS SOLELY TO CUBE PSL.
LIMITATIONS & THIRD PARTY CLAUSE:
WHERE PARTS OF THE PROPERTY WERE COVERED OR INACCESSIBLE AT TIME OF SURVEY POSITIONS OF ELEMENTS ARE MARKED 'ASSUMED' ACCORDINGLY.

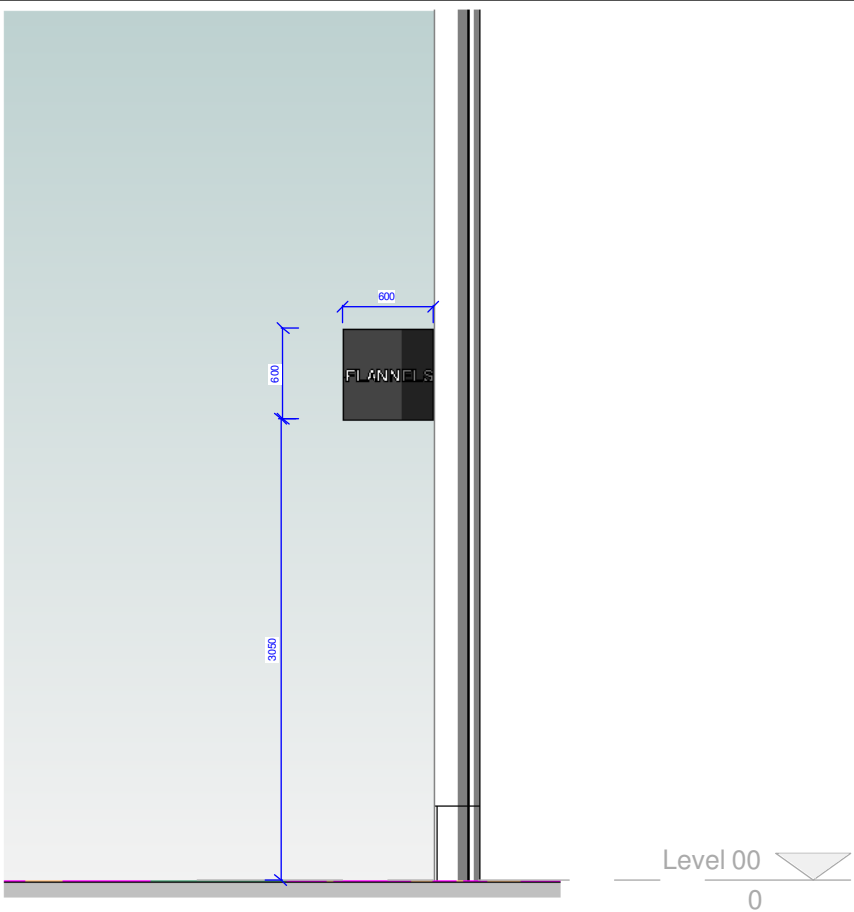


PROPOSED BUS STOP SIGN
Scale: 1 : 50



PROPOSED SHOPFRONT ELEVATION
Scale: 1 : 50

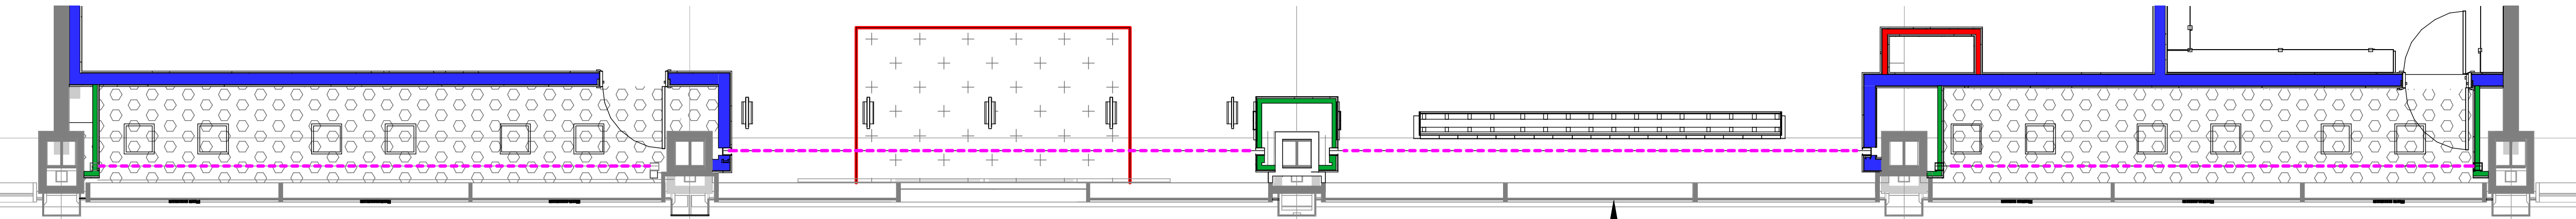

PROPOSED SHOPFRONT PLAN VIEW
Scale: 1 : 50

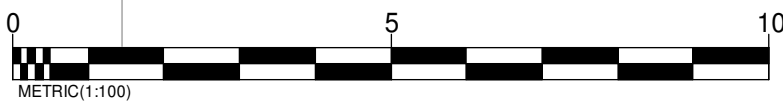

MSU4
MAIN ENTRANCE SLIDING
DOUBLE DOORS

EXISTING
MAIN ENTRANCE SLIDING
DOUBLE DOORS REPLACED
WITH NEW GLAZING

DRAWING UPDATED TO ARGENT SHOPFRONT PROPOSALS 08.04.22

J	Updated to 'AS BUILT'	12.10.22	SF
I	Updated window beds to Argent's details	09.08.22	SF
H	Updated shopfront as per PM instruction	06.07.22	SF
G	Updated shopfront as per PM instructions	16.05.22	sf
F	Updated shopfront to Argent drawings (06.05.22)	12.05.22	sf
E	Proposed CCTV location amended	27.04.22	II
D	Shopfront glazing amended to suit glazing manufacturer drawing	21.04.22	II
C	Shopfront updated per Argent shopfront proposals	13.04.22	II
REV	DESCRIPTION	DATE	BY

CLIENT
Fraser's Group
PROJECT
UNIT MSU4
THE GLASS WORKS , BARNESLEY
DRAWING TITLE
PROPOSED SHOPFRONT ELEVATION

DRAWN BY II **DATE** 29.07.21
CHECKED BY DR **SCALE** 1 : 50 @ A1
DRAWING NO. CPS 20 122 104 J

TENDER

cube.
Project Management | Building Surveyors
Heritage Consultants | Design Services
502 Birchwood One | Dewhurst Road | Warrington | WA3 7GB
t: 01925 831 710
e: admin@cube-psl.co.uk | w: www.cube-psl.co.uk