


North Elevation 1:100



South Elevation 1:100



West Elevation 1:100

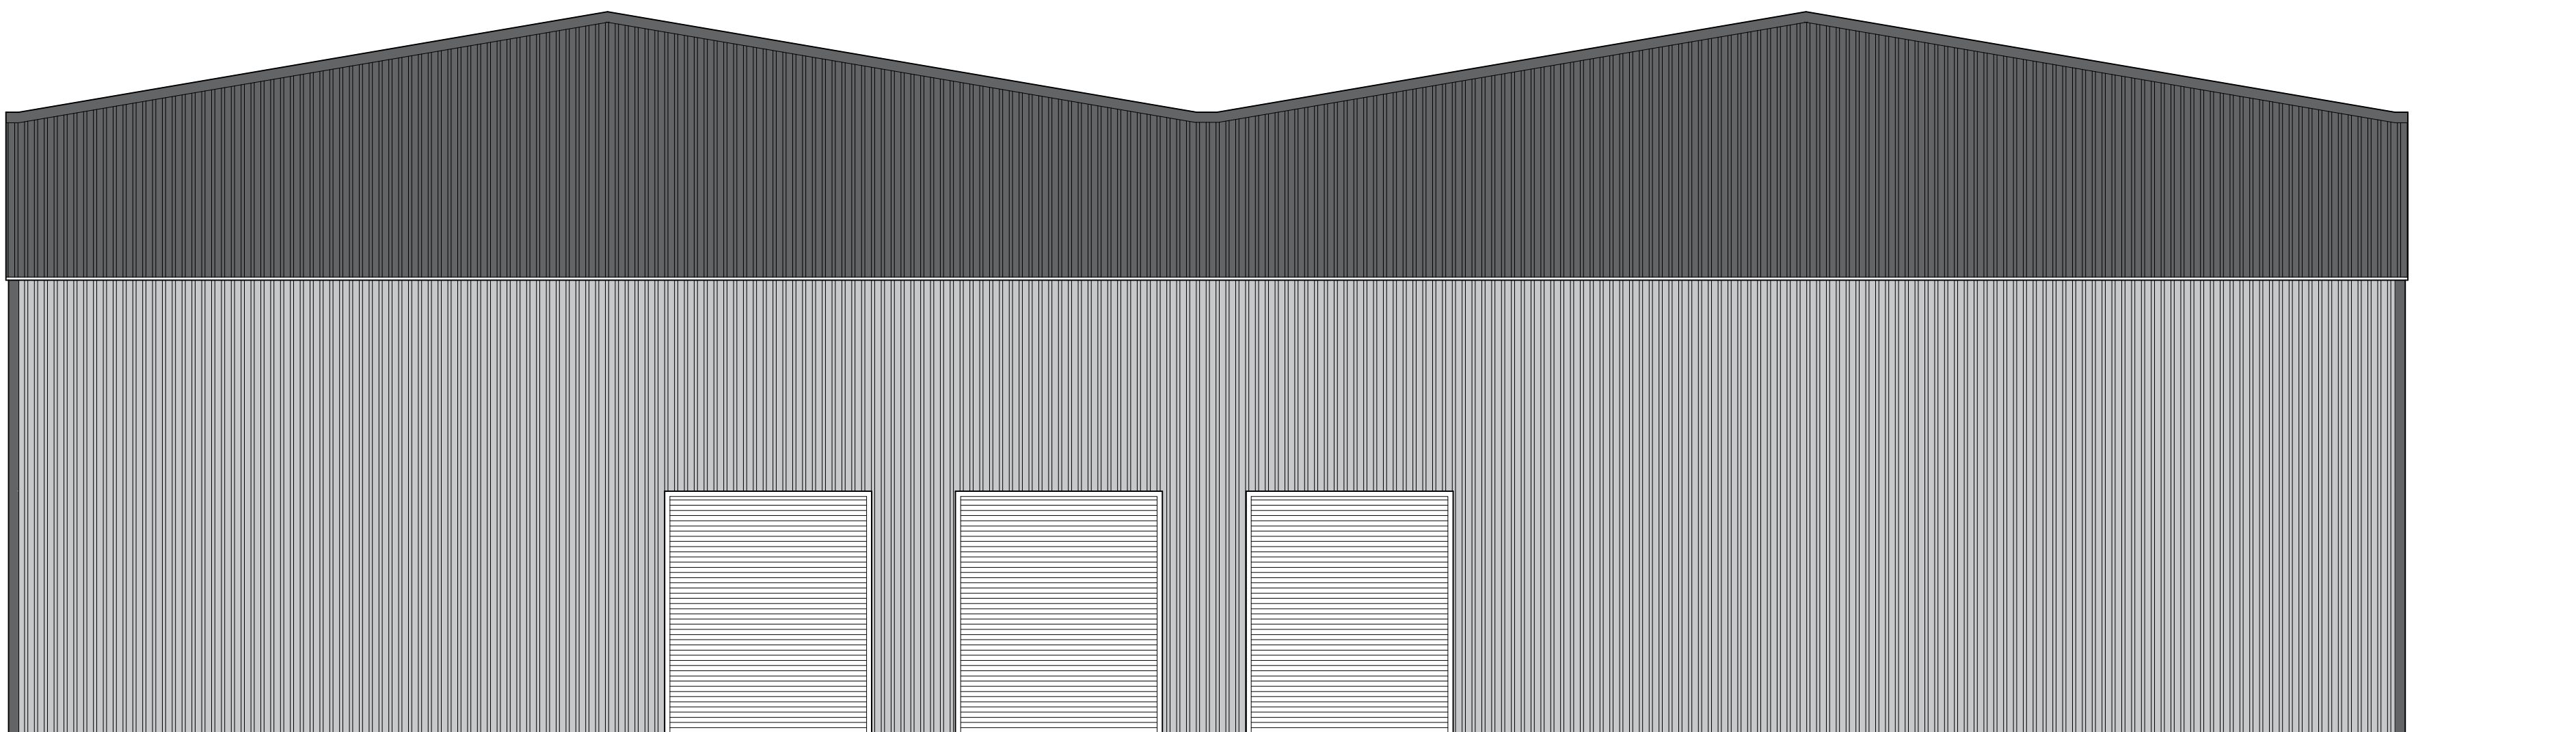

East Elevation 1:100

MaxDesign[®]

Architecture | Planning | Consultancy

Armstrong House, First Avenue, Doncaster, DN9 3GA

t: 01302 867509

e: design@maxdesignconsultancy.co.uk

m: 07734 939 044

w: maxdesignconsultancy.co.uk

status:

As Built

client:

lazarus

project:

Everil Gate, Barnsley

title:

Unit 1 Elevations

scale:

1:100@A0

date:

APR 2021

project no.:

2172

drawn:

MJ

number:

010

rev:

-