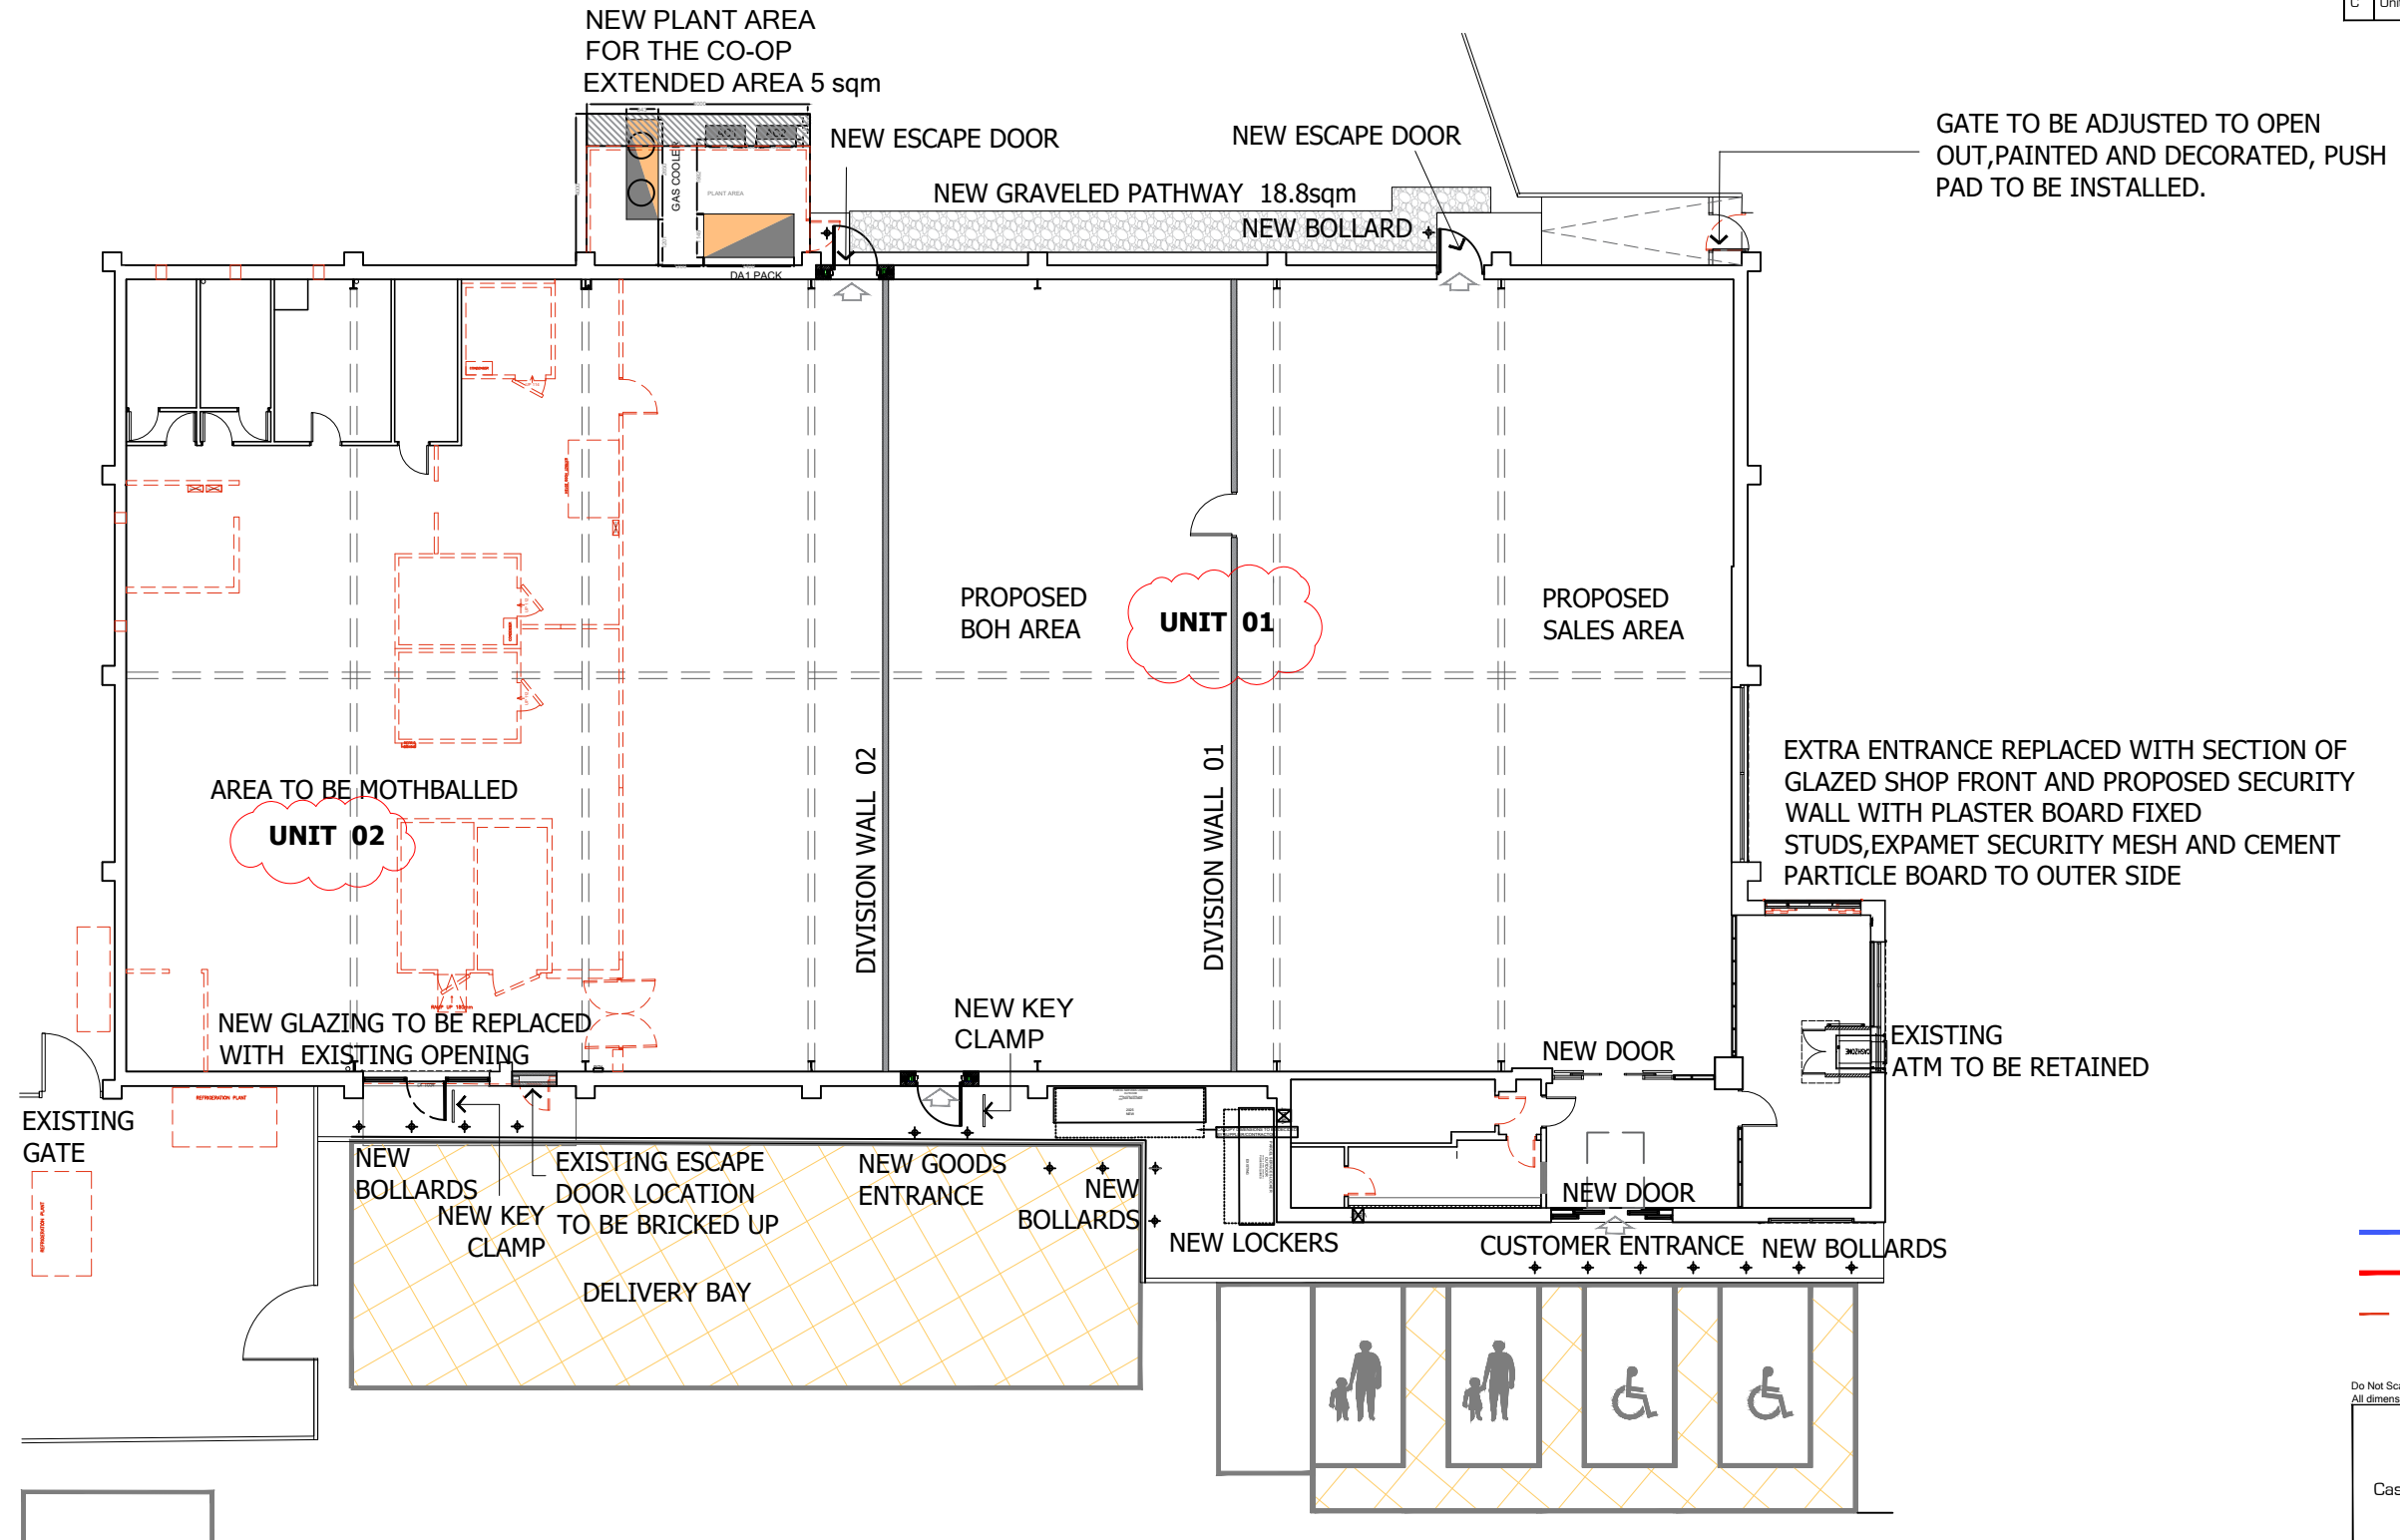



Revision	Date	By	Chk.
A	North point amended	25.11.27	MW
B	New graveled pathway amended and area marked up Area marked up for extended area to the plant	25.12.17	MW
C	Units no added	26.03.05	MW

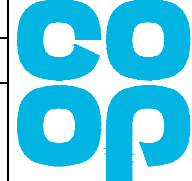
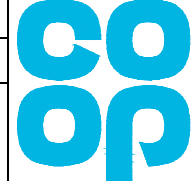


- Ownership Boundary
- Planning Boundary
- - - Downtakings/Removals

Do Not Scale Dimensions from Drawings.
All dimensions to be verified on site, and any discrepancy to be notified to the Architect.



AMCA ARCHITECTS
Castlecroft Business Centre Tom Johnston Road
Dundee DD4 8XD
T: 01382 774111 F: 01382 739382
mail@amcaarchitect.co.uk

Drawn by MW	Date NOV2025	
Checked by -	Scale 1:200@A3	
Job High Street Royston South Yorkshire S71 4RF		
Drawing PROPOSED BUILDING PLAN		
Co-operative Proj No. 0000	AMCA Job No. 4170	
CAD Ref: 4170_Royston_construction.dwg		



PROPOSED BUILDING PLAN - SCALE 1:200 @A3