


Site Plan as Built 1:500

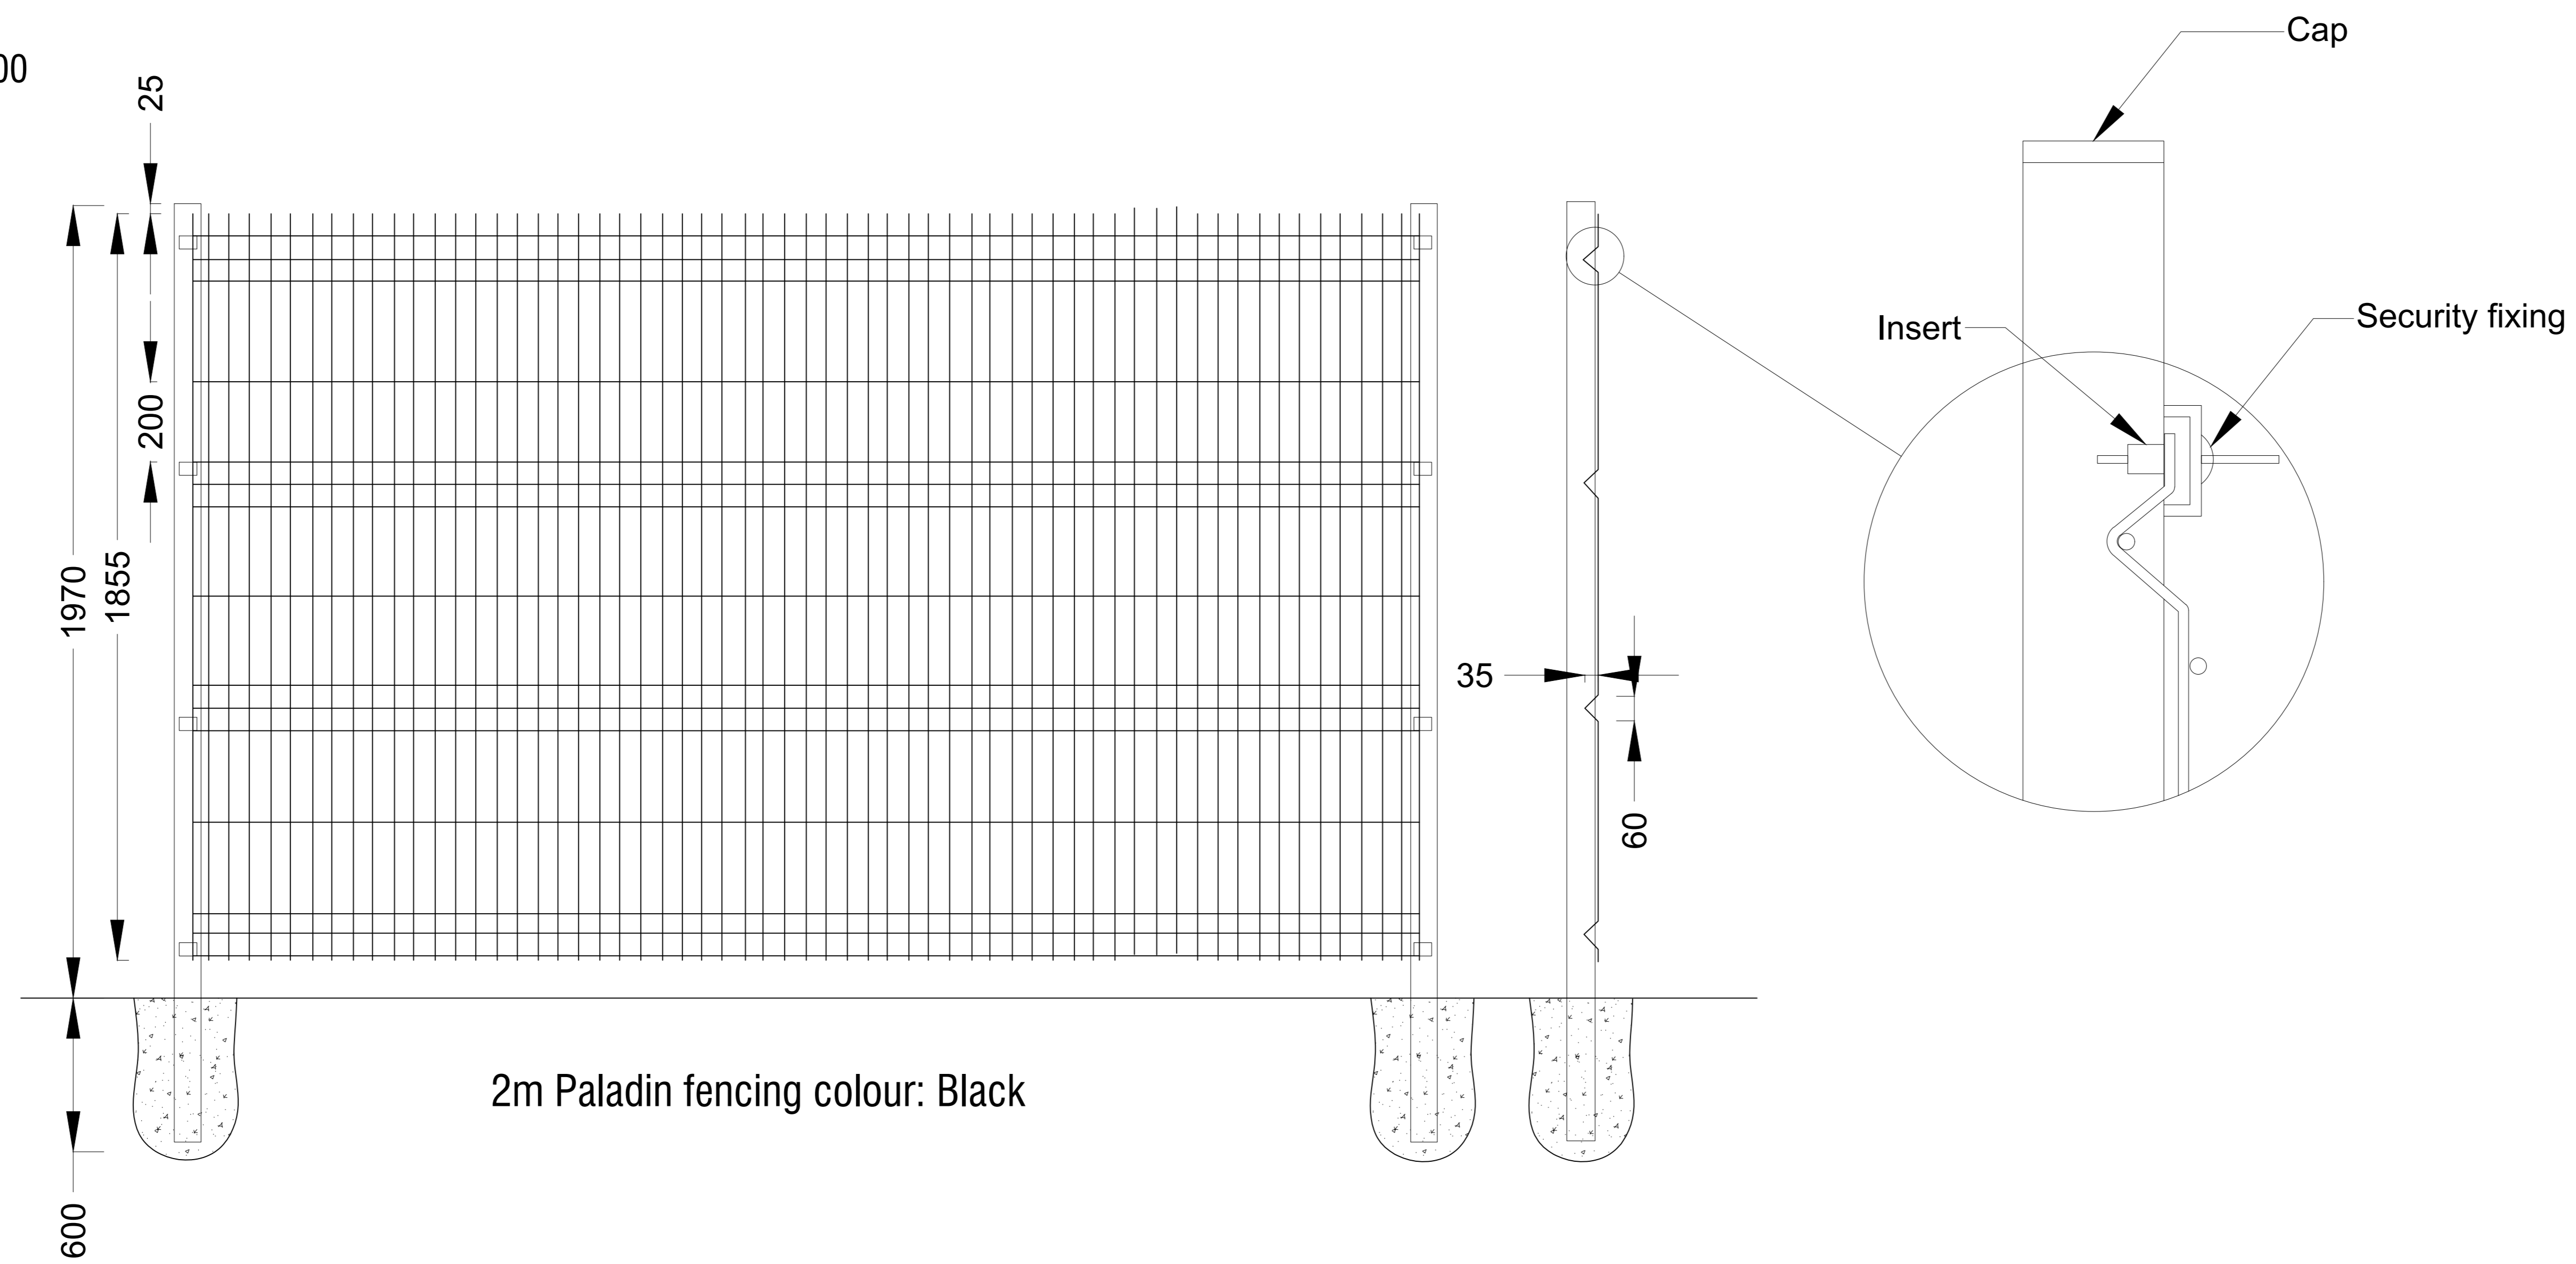

Fencing detail 1:10

<b>MaxDesign</b> <sup>®</sup>			
Architecture   Planning   Consultancy			
Armstrong House, First Avenue, Doncaster, DN9 3GA			
t: 01502 867509		m: 07734 938 044	
e: design@maxdesignconsultancy.co.uk		w: maxdesignconsultancy.co.uk	
status: <b>As Built</b>			
client: lazarus			
project: Everil Gate, Barnsley			
title: Boundary treatment			
scale: 1:500@A0		date: APR 2021	
project no.: 2172	drawn: MJ	number: 011	rev: -