



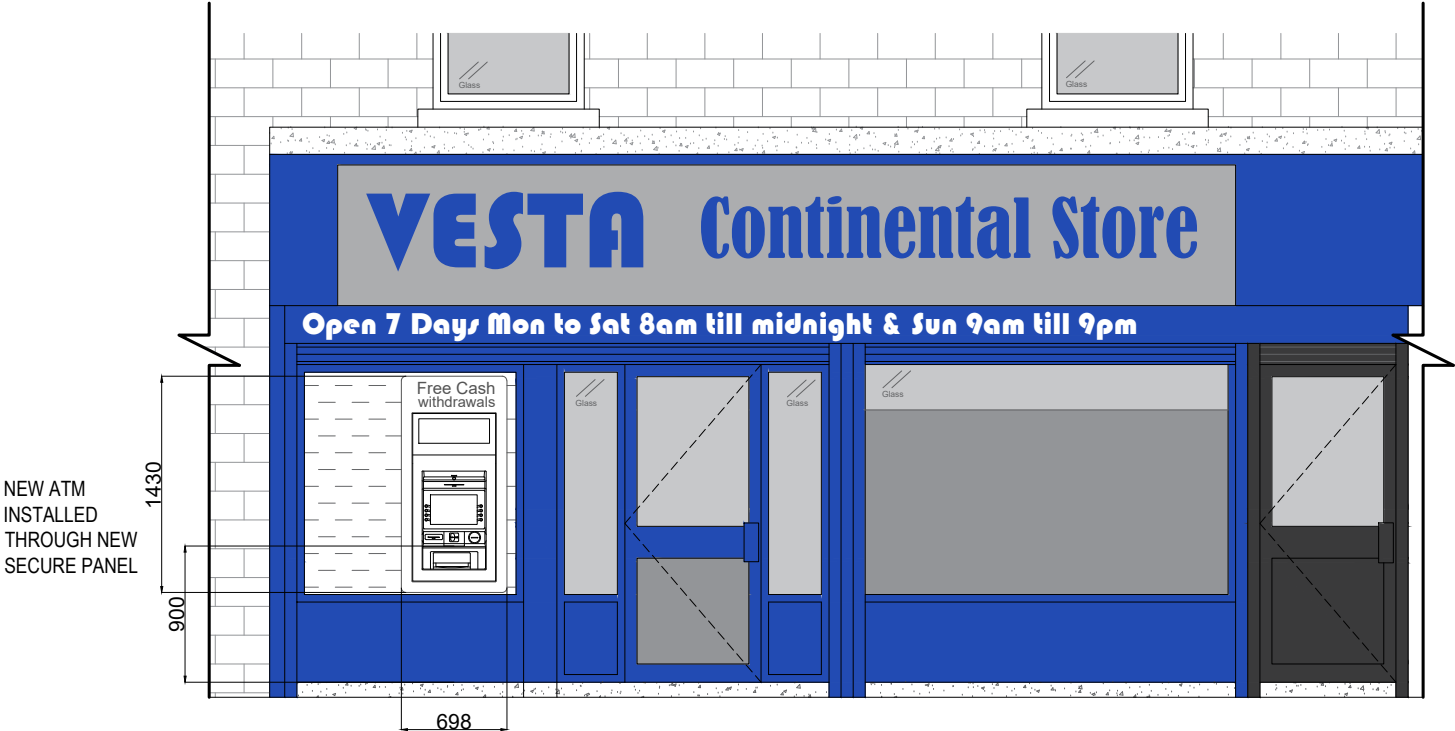

AS-INSTALLED FRONT ELEVATION

Scale 1:50

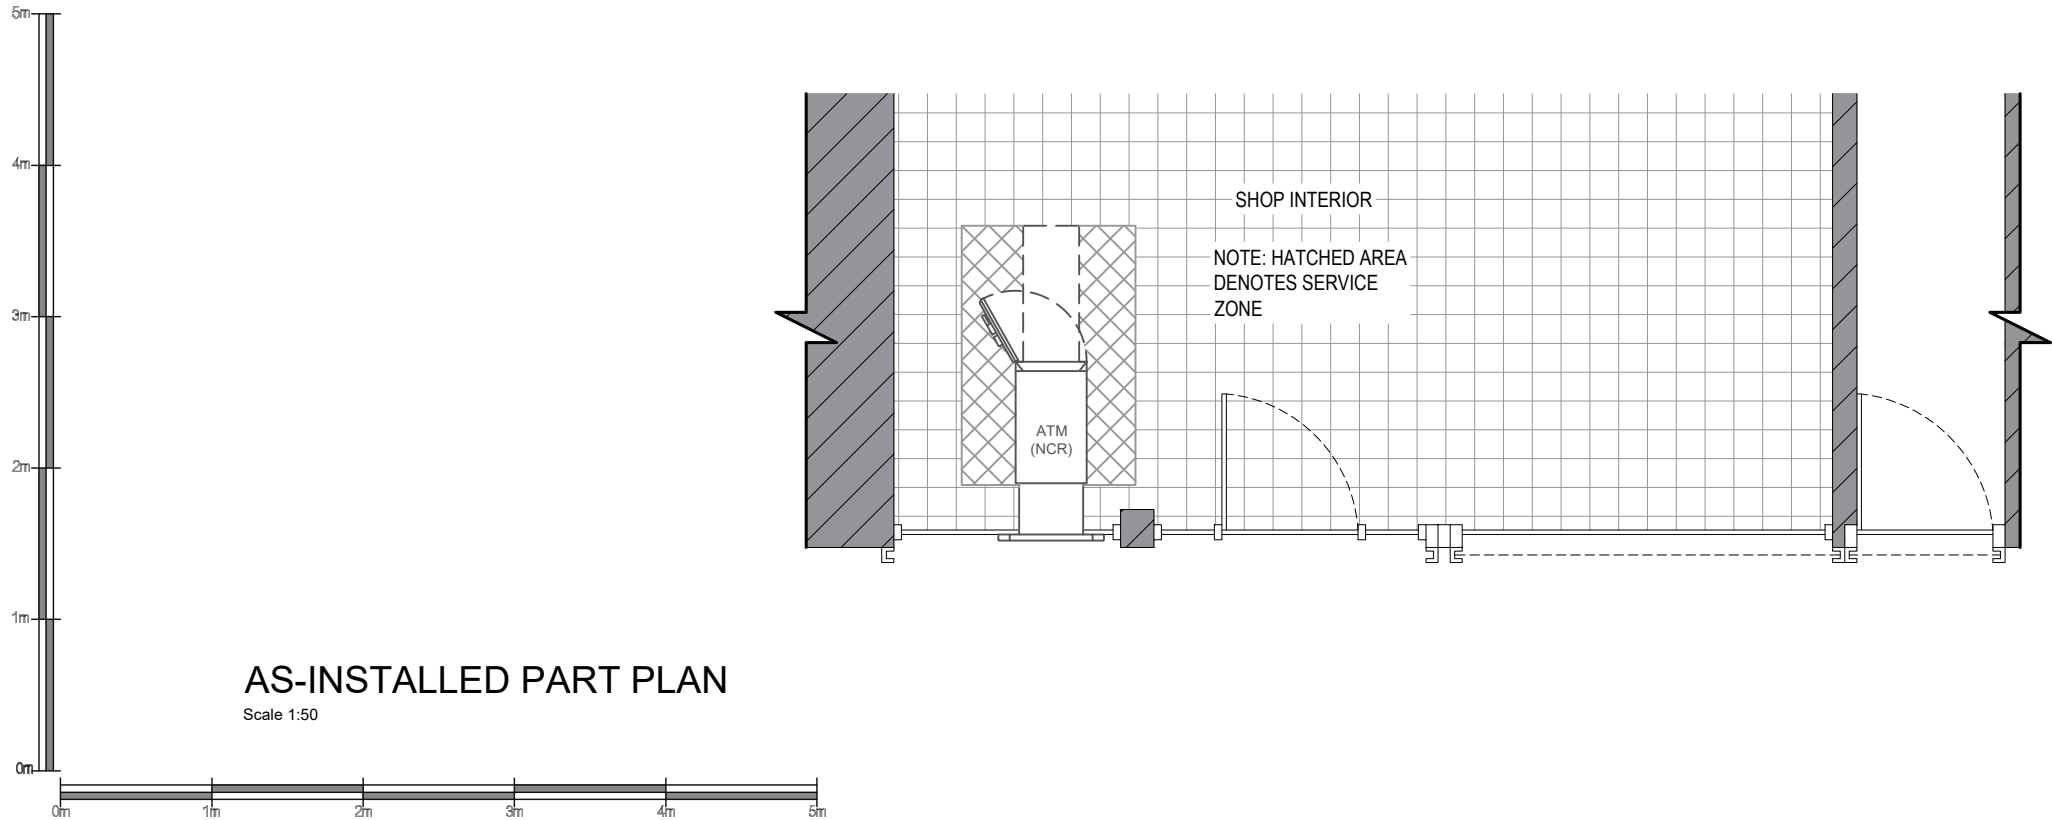

AS-INSTALLED PART PLAN

Scale 1:50

Date:	Comments:	By:
-------	-----------	-----

GENERAL NOTES:
1) All dimensions in millimeters unless otherwise stated.

Site:
Vesta Continental,
59-61 High Street,
Wombwell,
Barnsley,
S73 8HS

Drawing Title:
As-Installed Plan and Elevation

Ref:	Date: 14/06/2018	Rev:
Scale: 1:50	Paper: A3	Date Rev: