




**9 PADDOCK CLOSE
BARNSELY
S75 6LH**

OS Mastermap
25 January 2012, ID: BW1-00122974
maps.blackwell.co.uk

1:1250 scale print at A4, Centre: 433389 E, 410459 N
©Crown Copyright. Licence no. 100041040




BLACKWELL'S
www.blackwellmapping.co.uk
TEL: 0114 268 7658
maps.sheffield@blackwell.co.uk

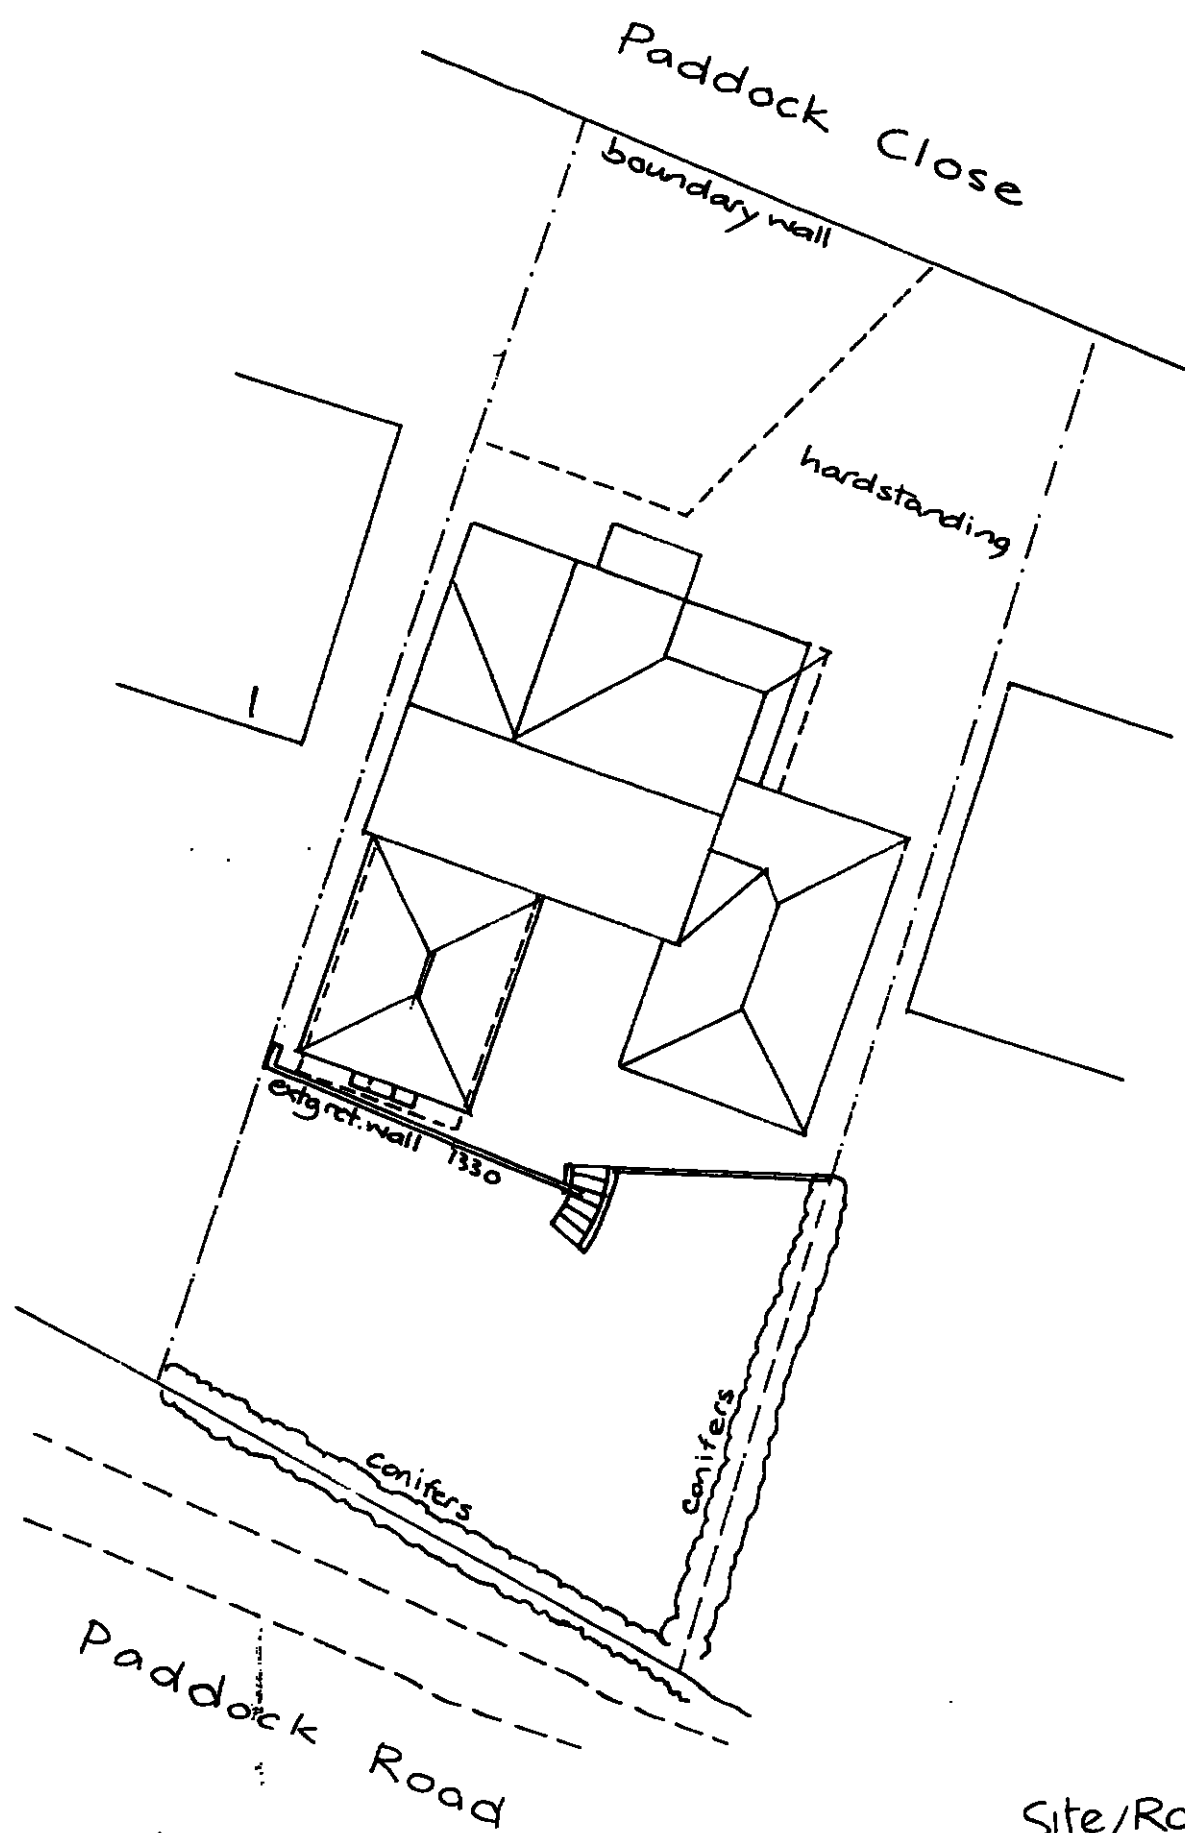



Revised June'12
Size approved - 6.500 x 4.500
as built - 6.000 x 4.750

Site/Roof plan
1:200

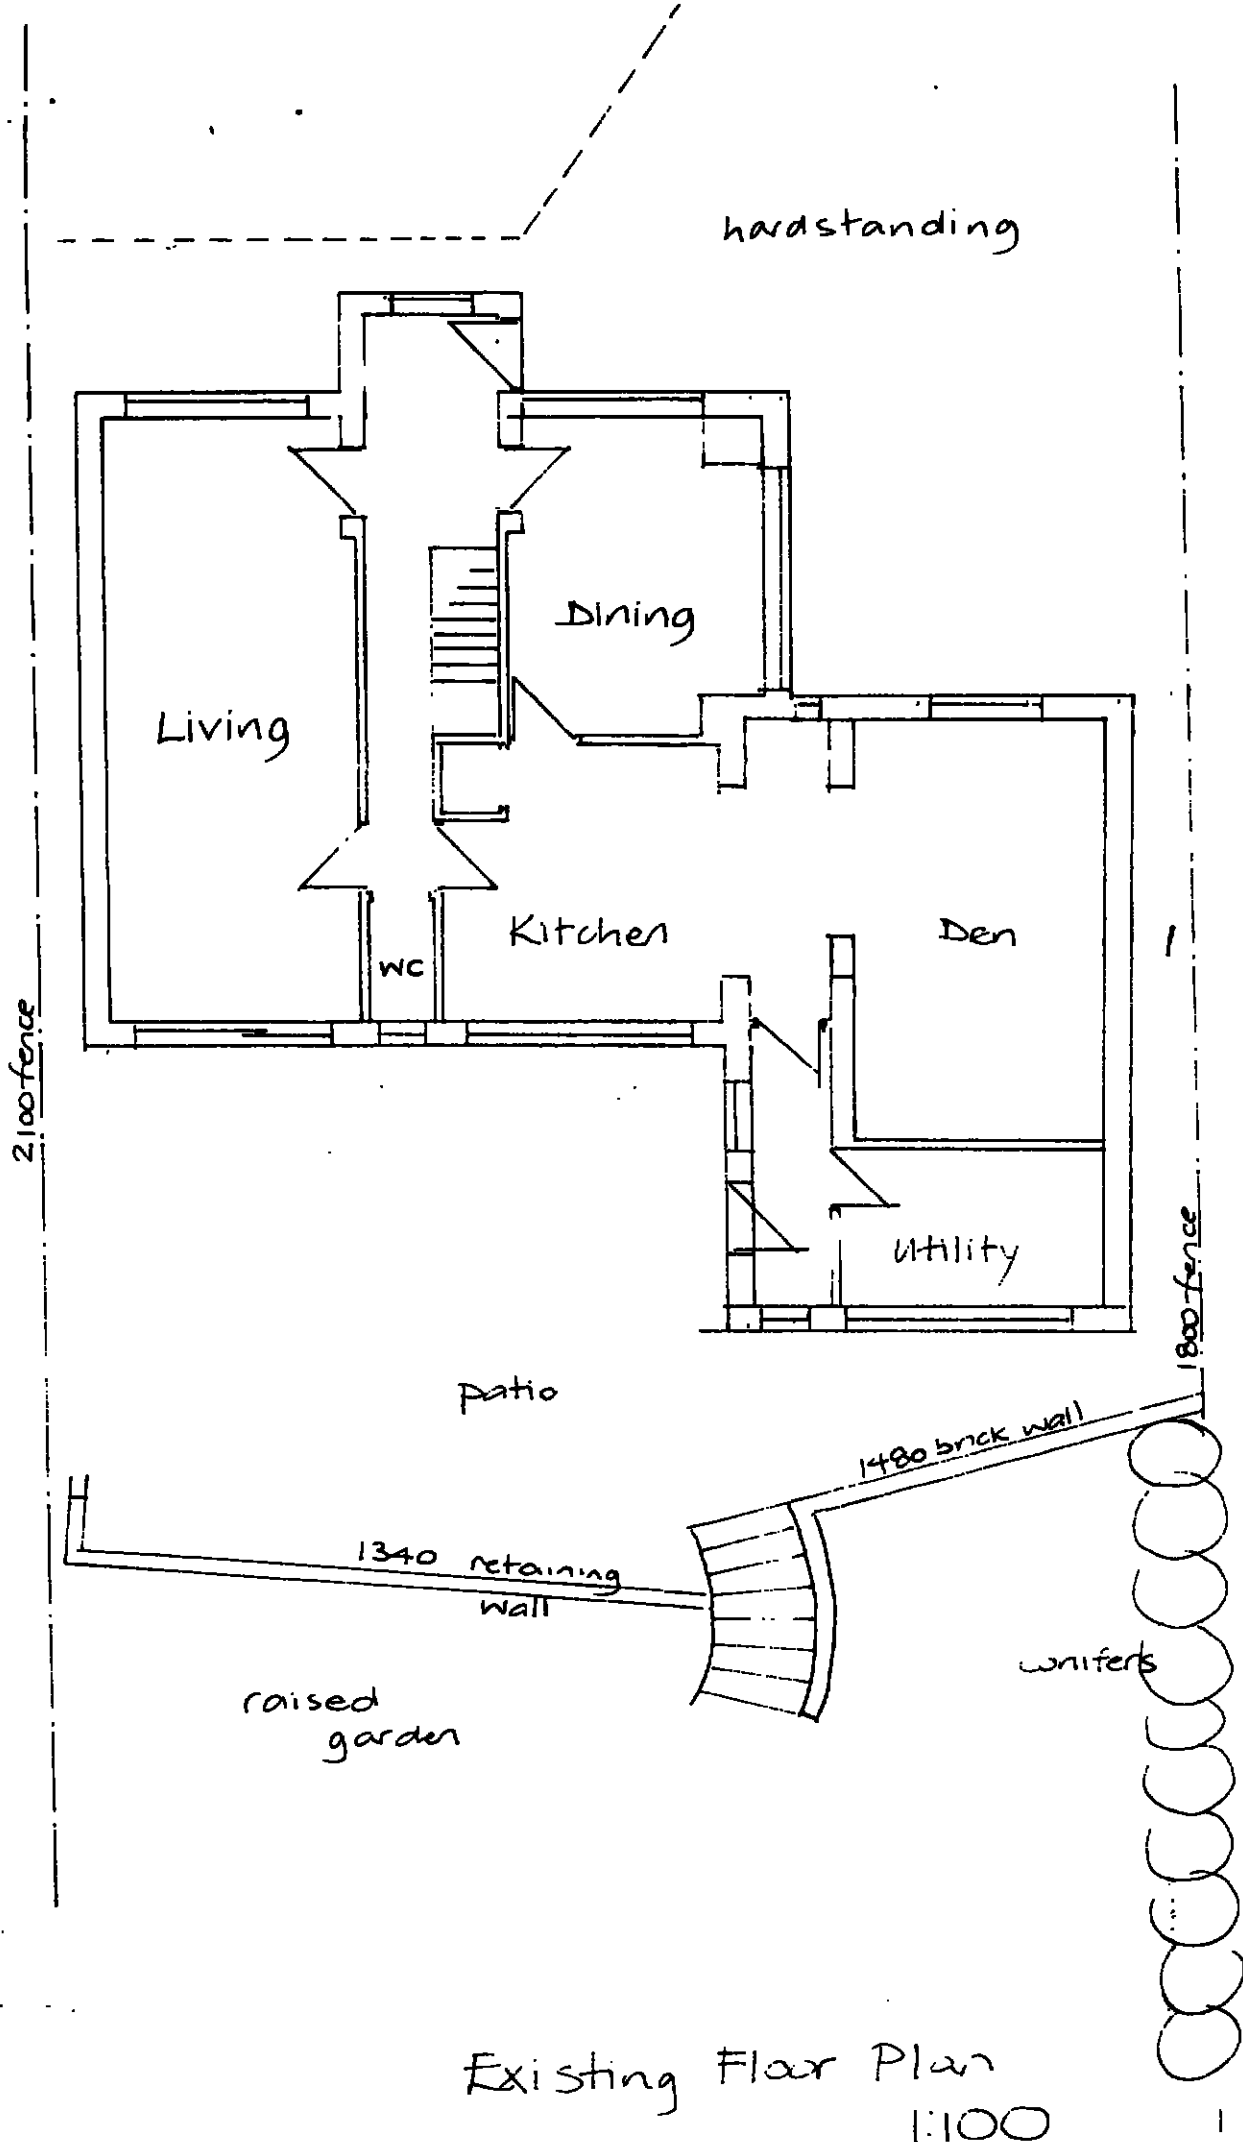


Existing Floor Plan
1:100

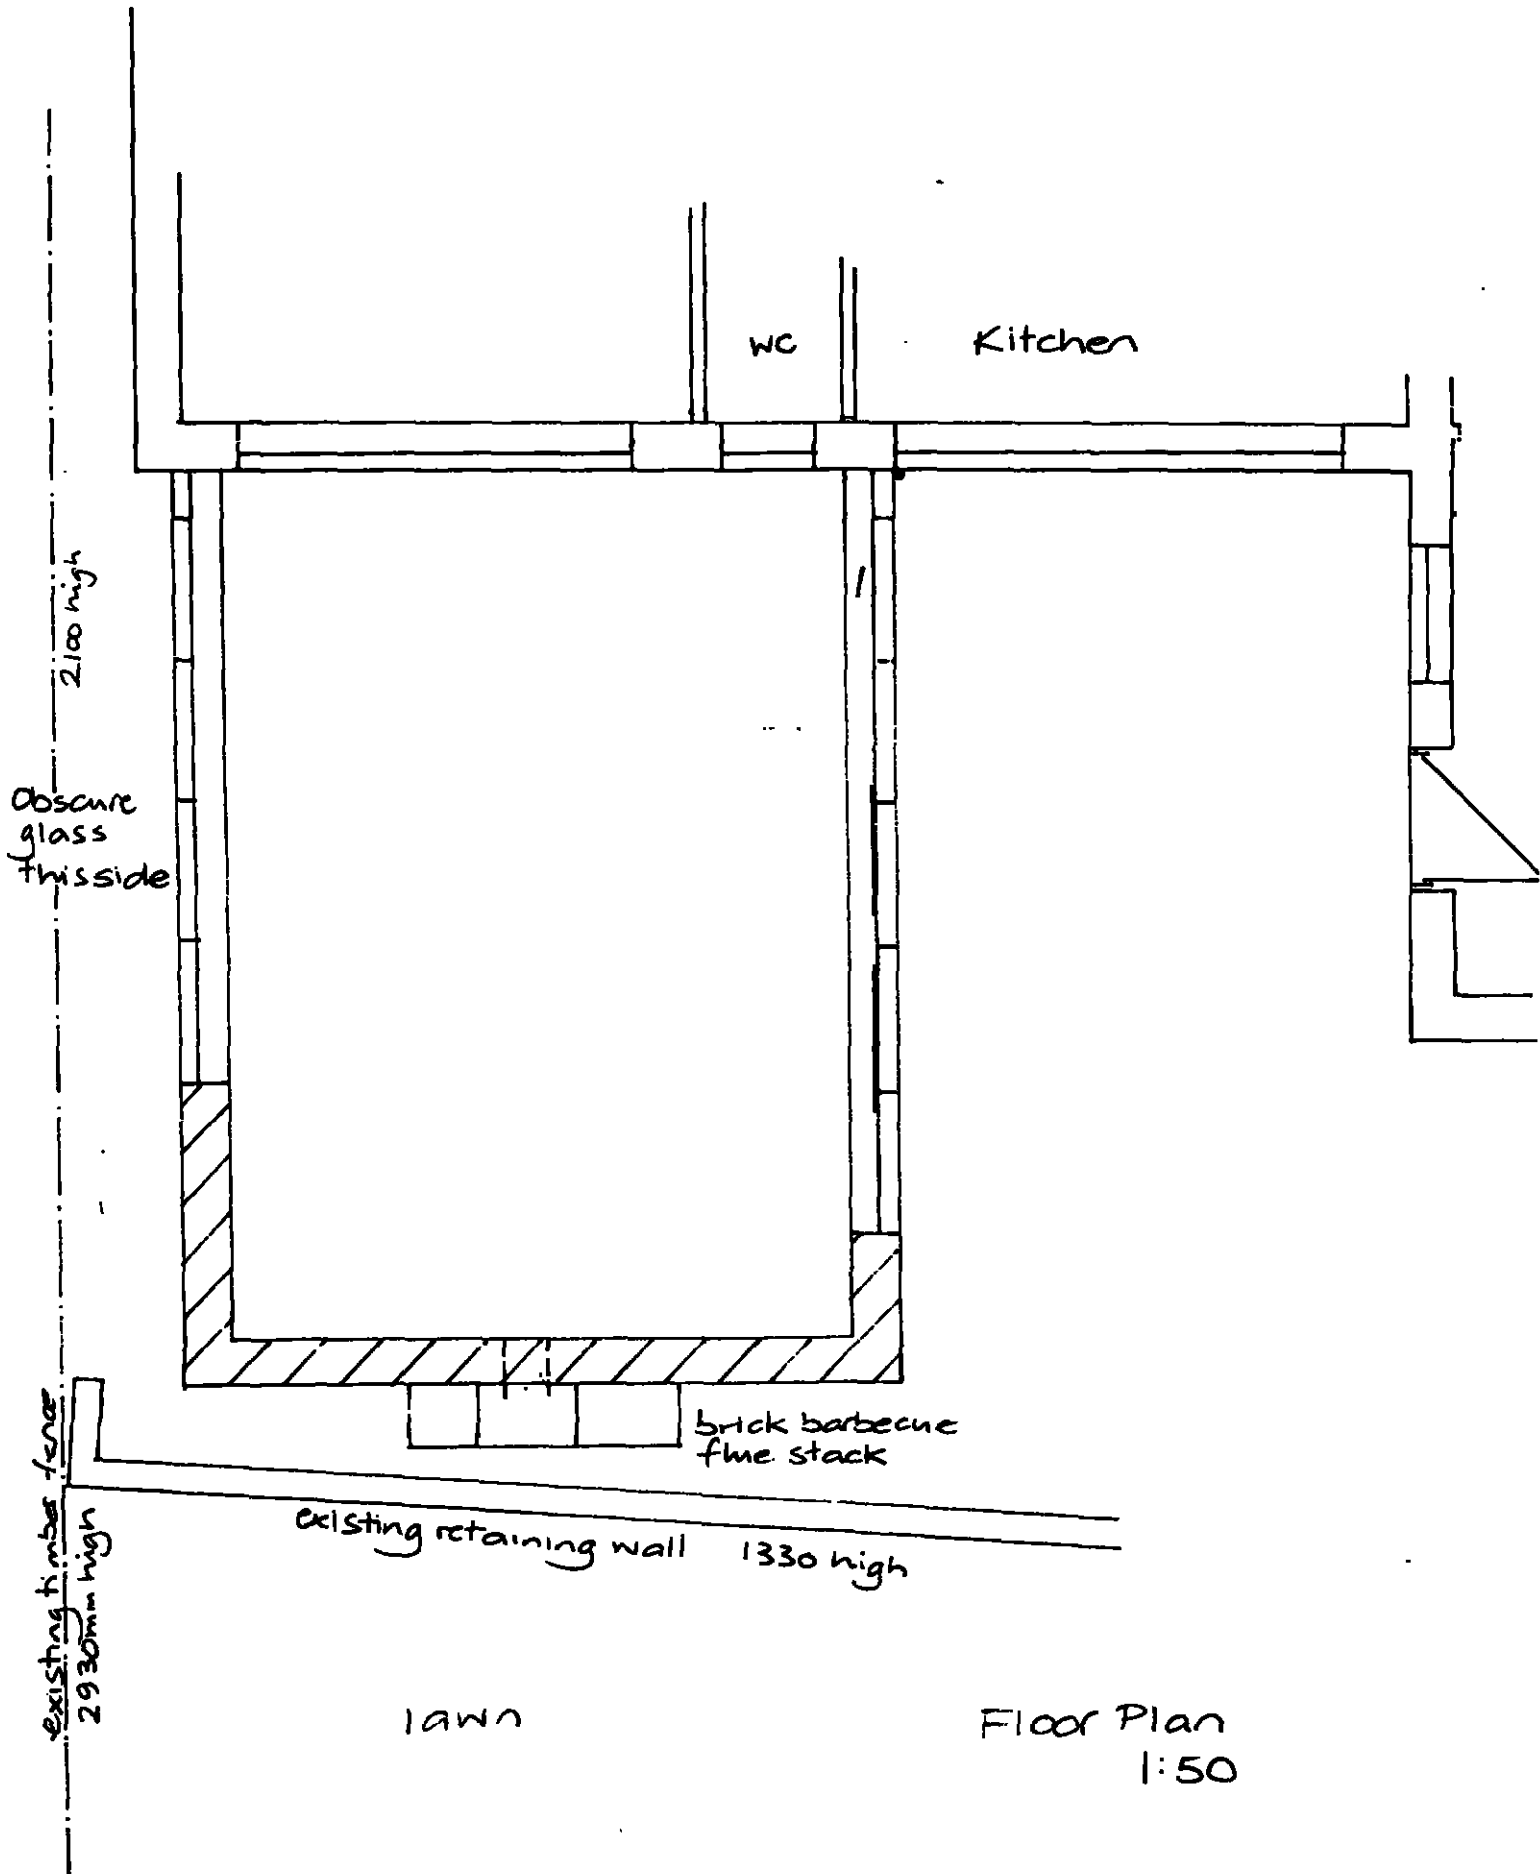


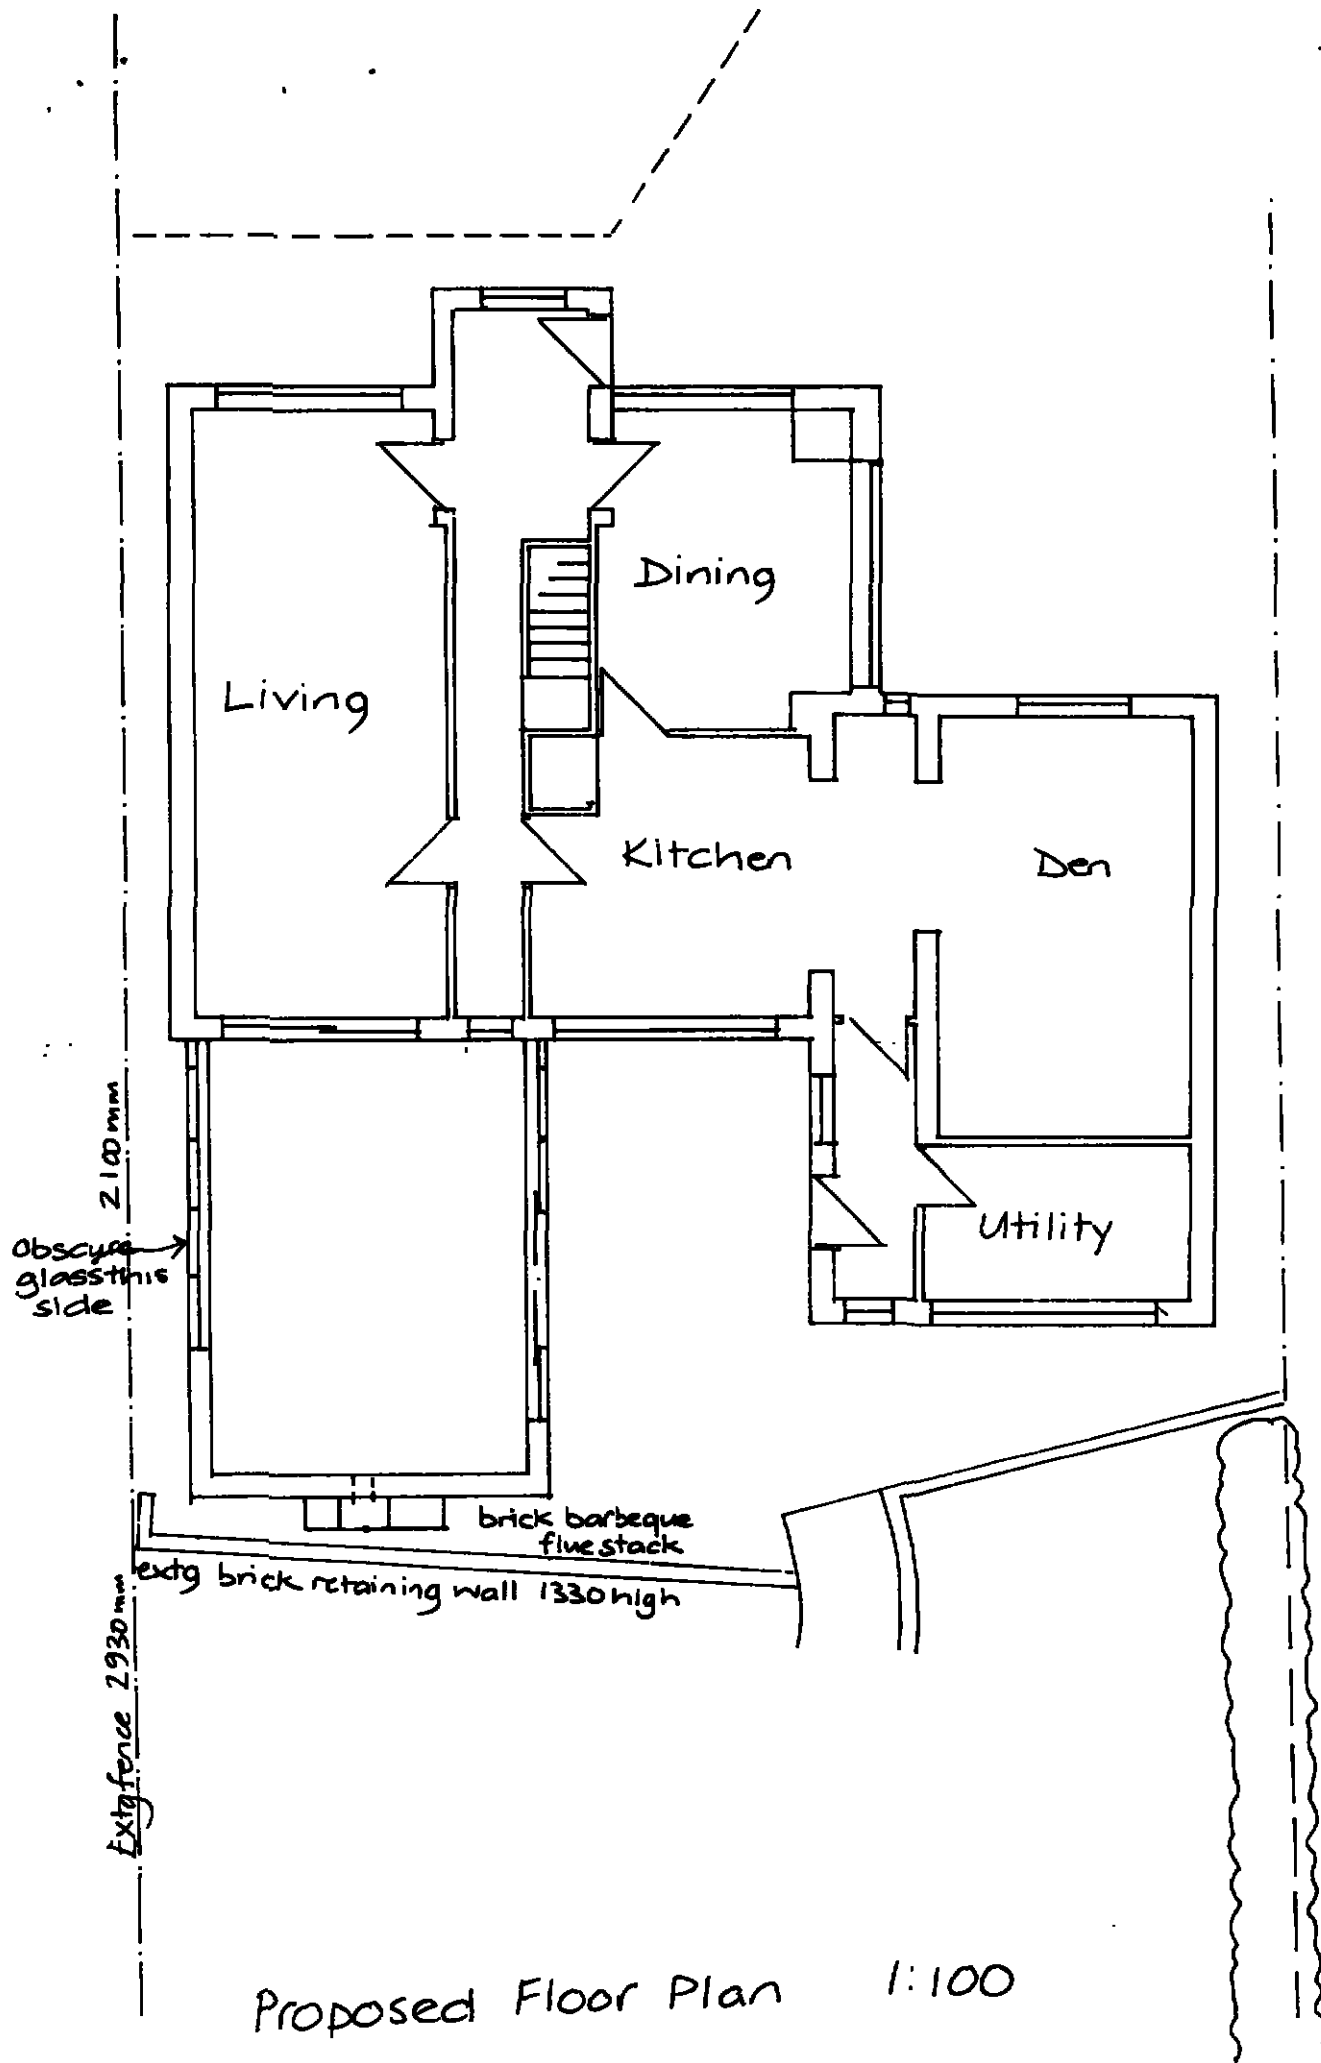


Revised June '12
 AS approved 6500x4500 As built 6000x4750

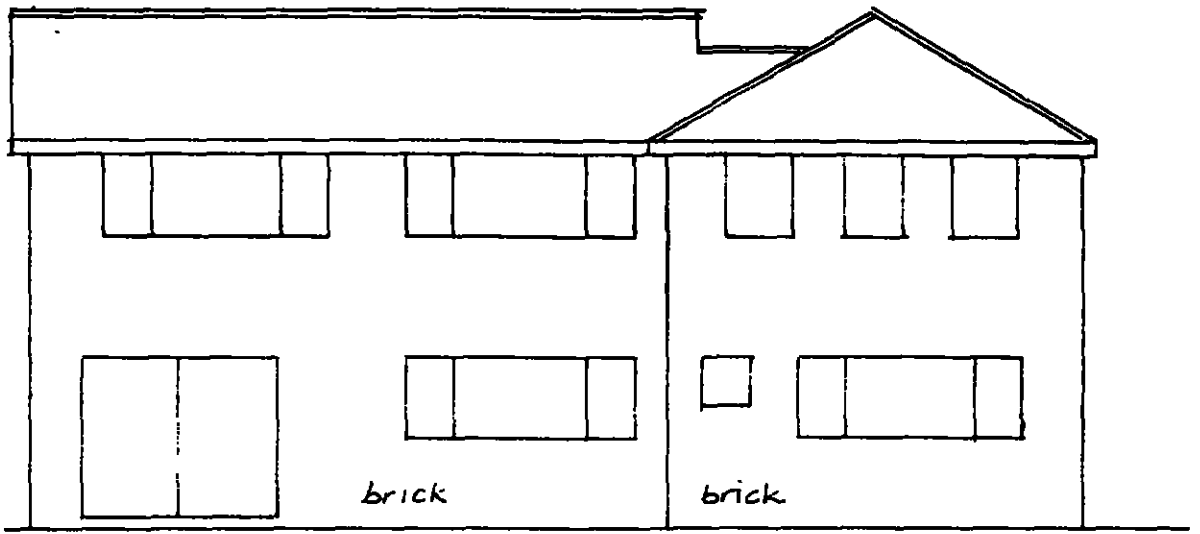

Existing Rear

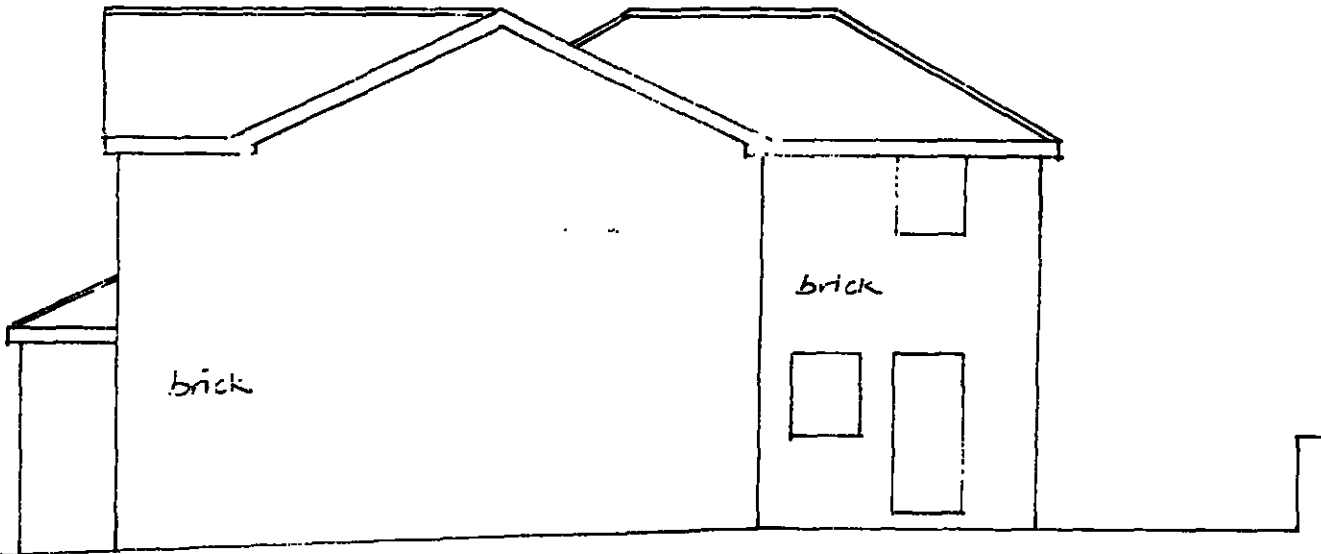

Existing Side

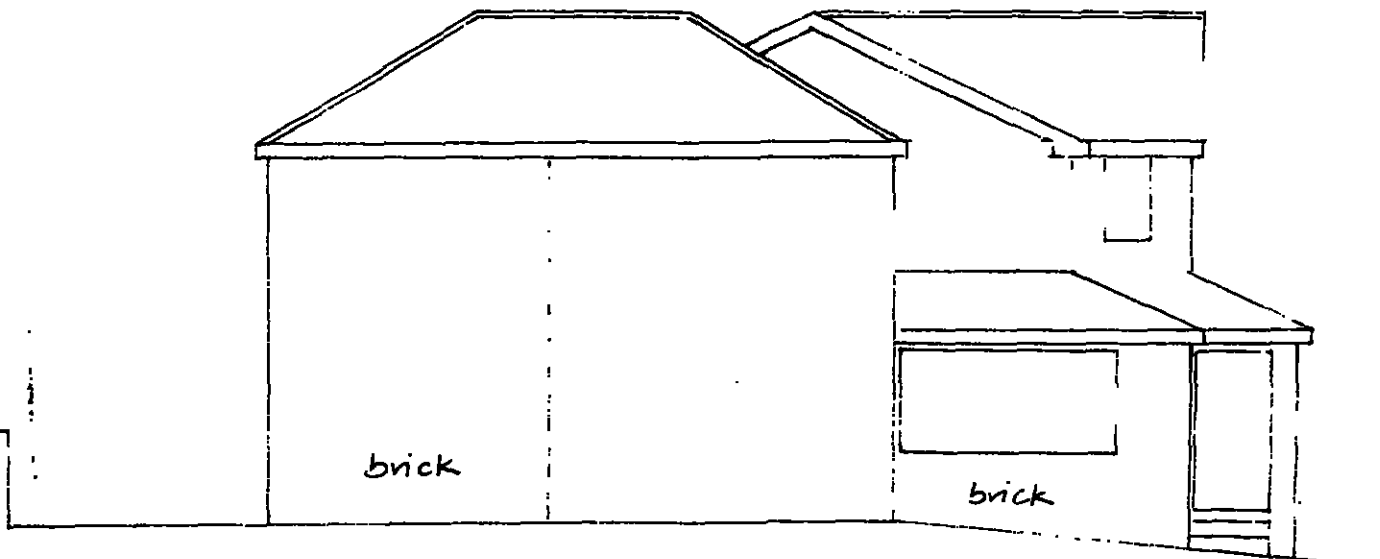


Existing Side

1:100


Revised June '12

AS approved 6.500 x 4.500


AS built 6.000 x 4.750

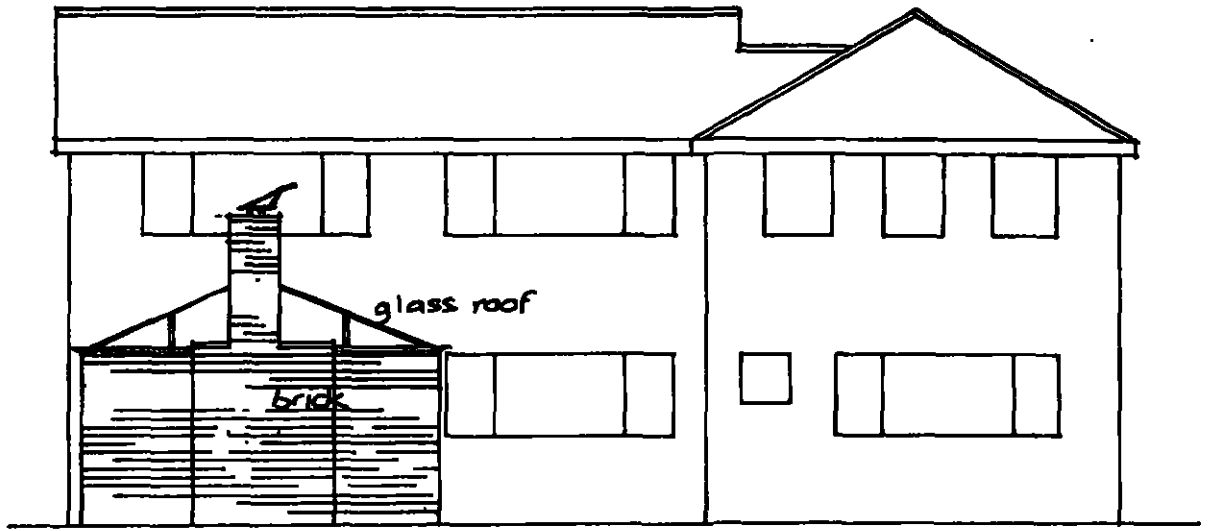

Proposed Rear

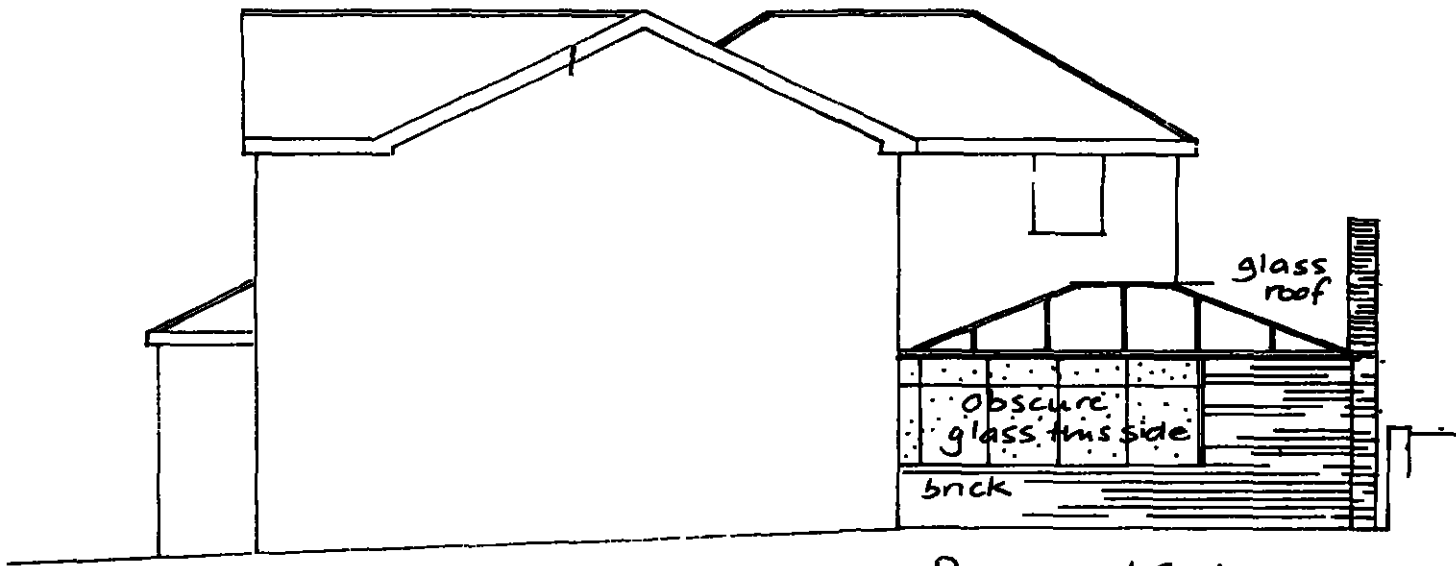

Proposed Side

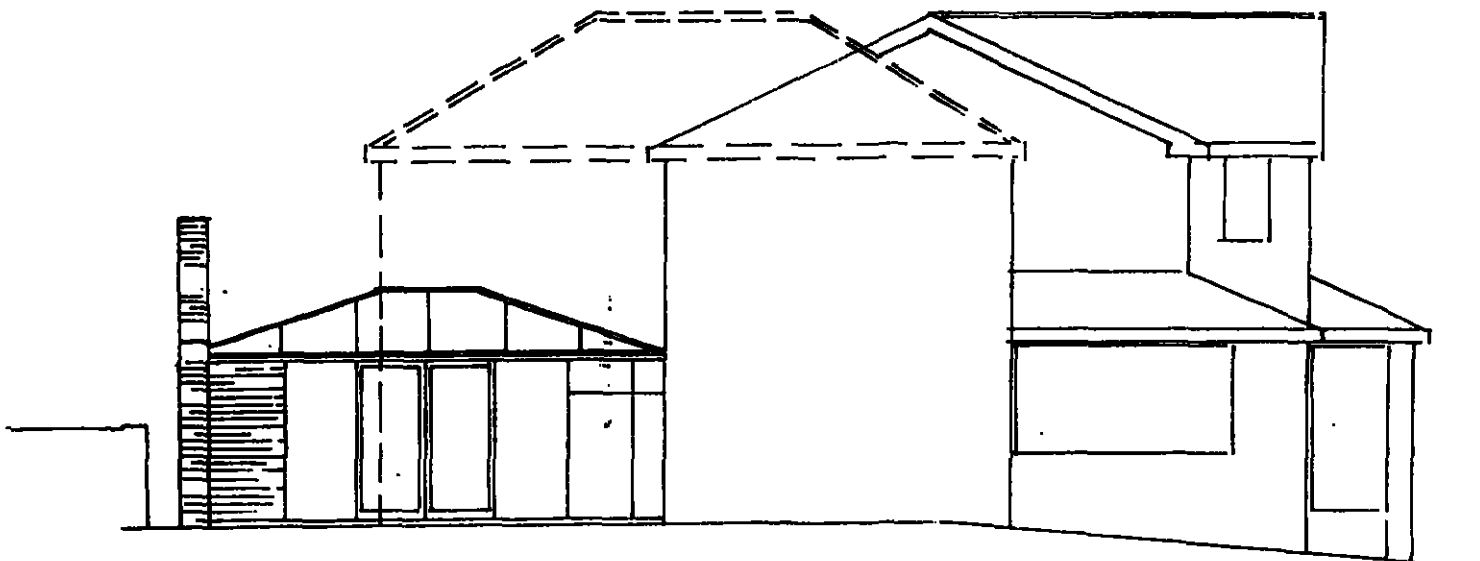

Proposed Side

1:100