
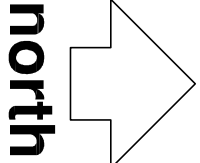


REVISIONS			
A	03/11/14	DS	The red line boundary associated to the relevant residential property
B	27/01/15	DS	Red line boundary amended

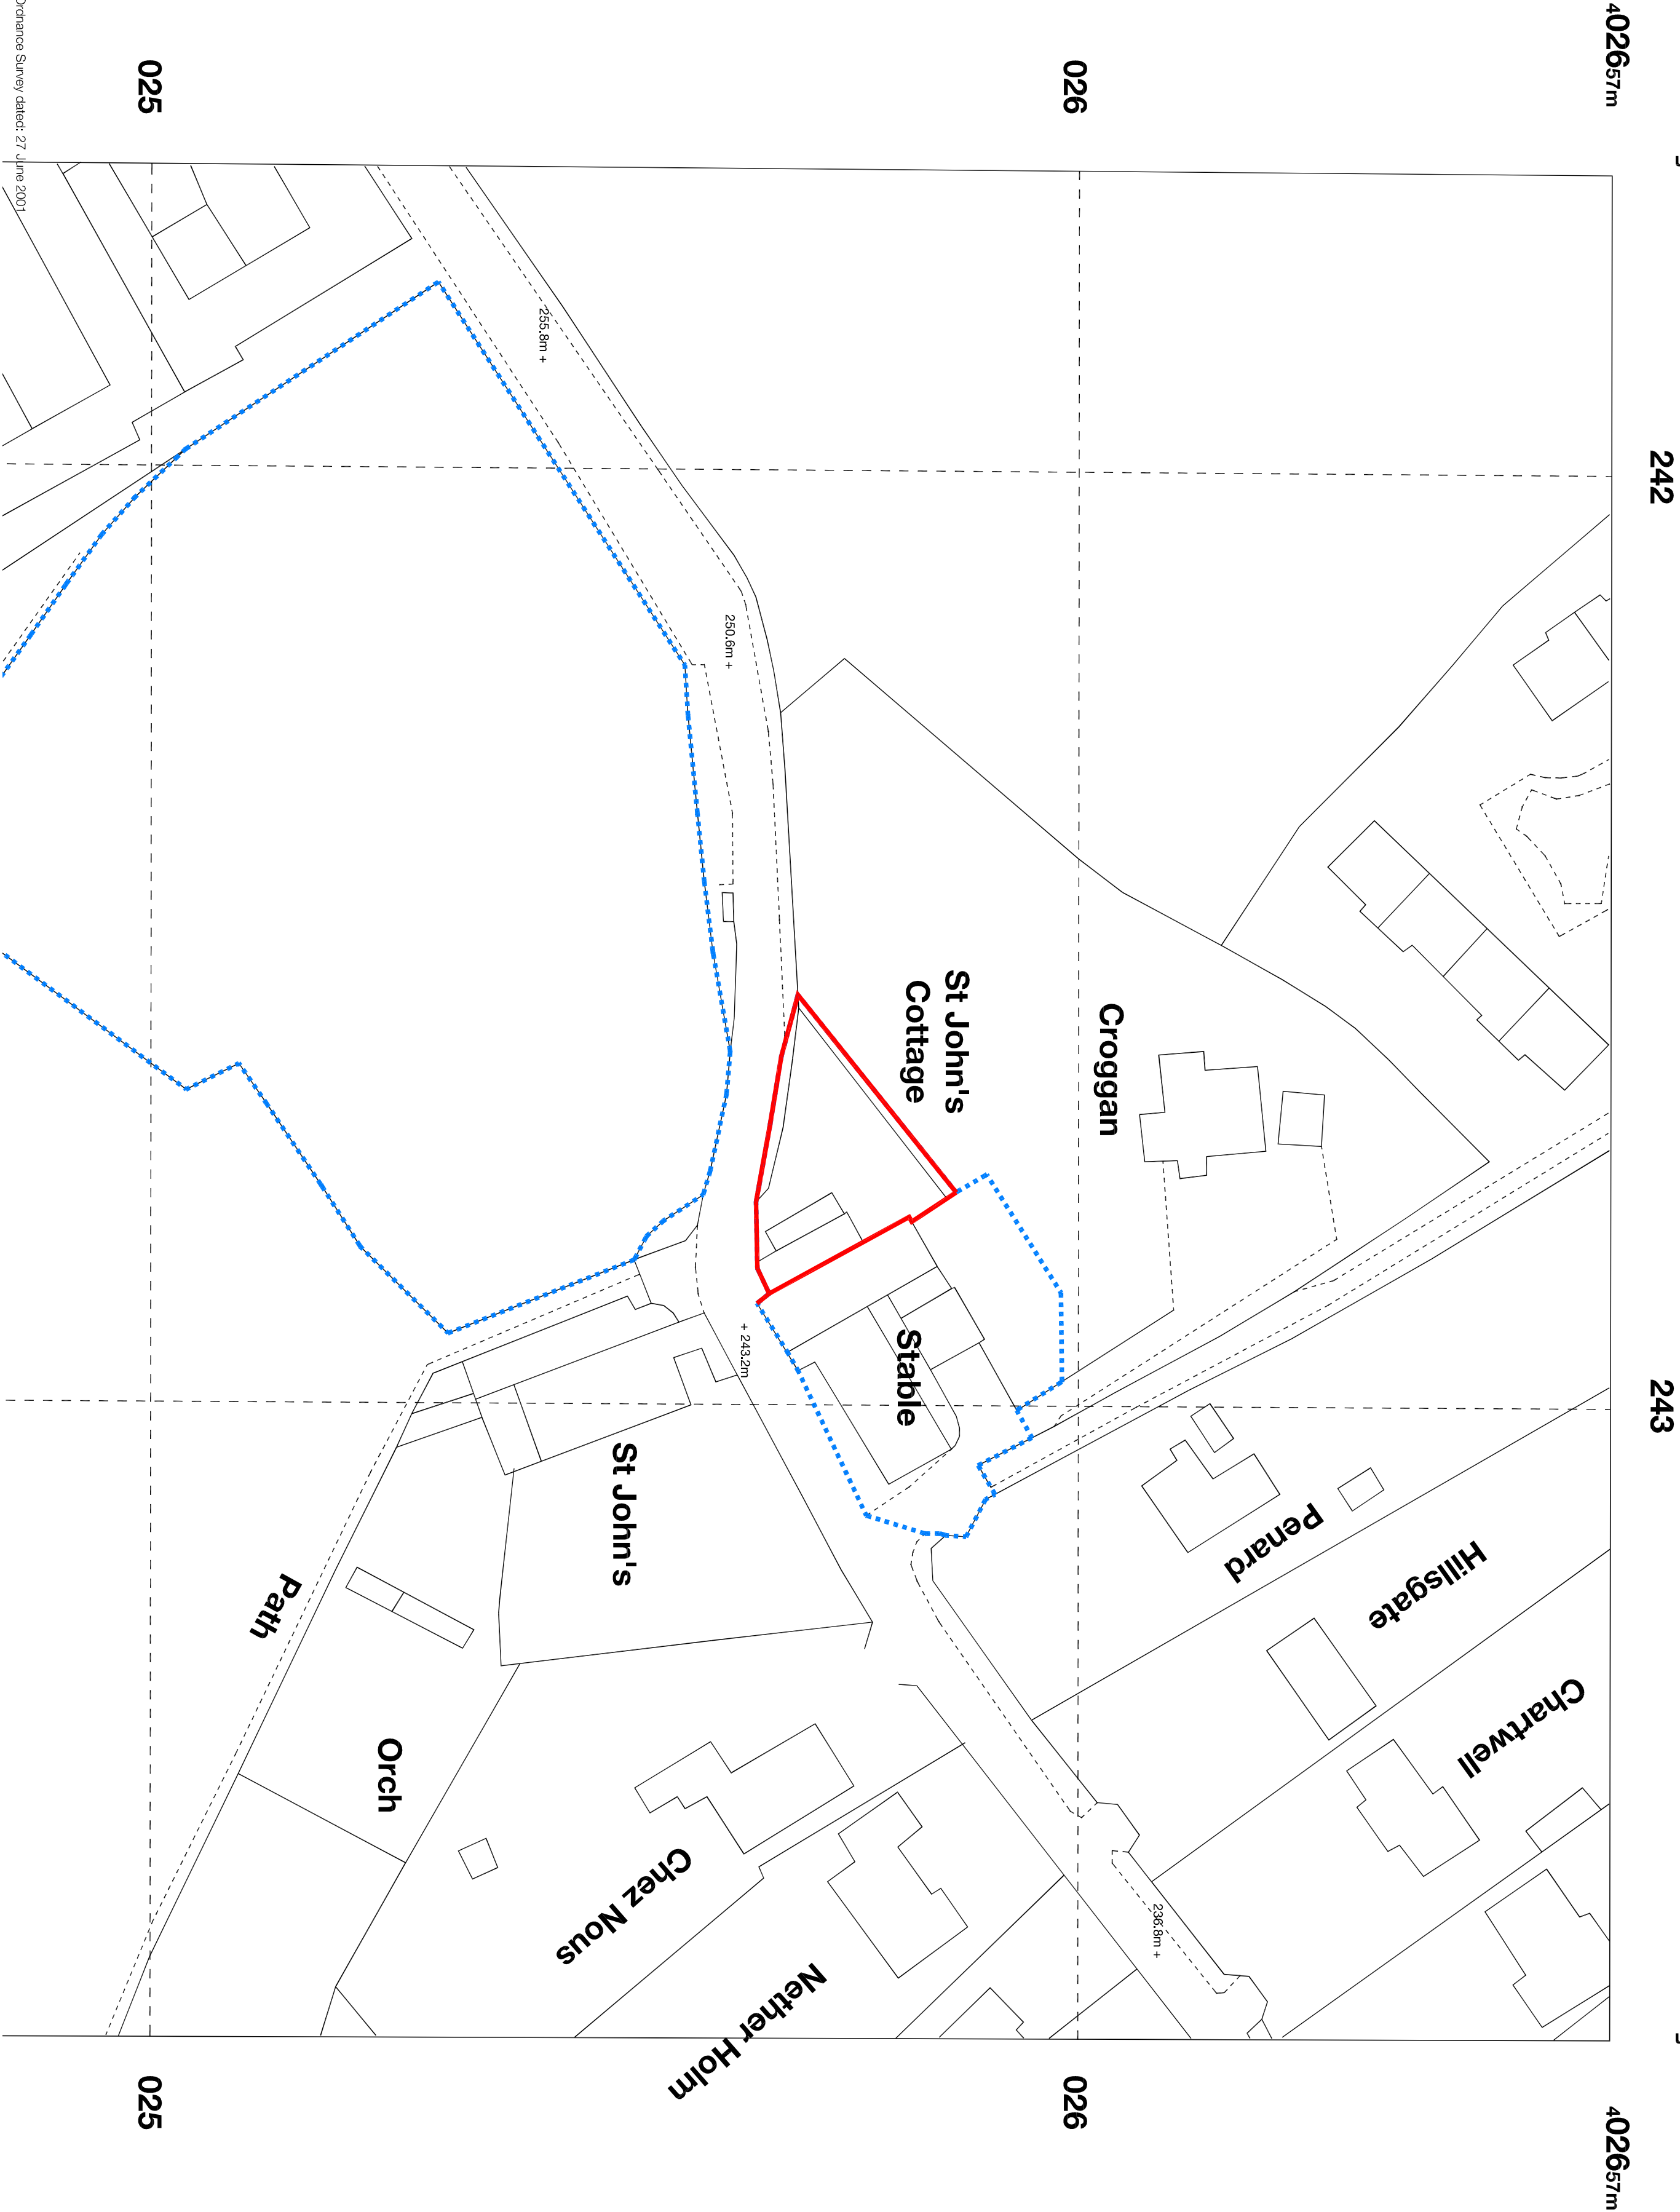

north

PROJECT
ST JOHN'S COTTAGE, CHAPEL
LANE, PENISTONE, SHEFFIELD

TITLE
SITE LOCATION PLAN

SCALE	DATE
1:500 @ A2	12/08/14
DRAWN	REVIEWED
DS	DS
DRAWING NO	REVISION
101	B
FILE PATH	