



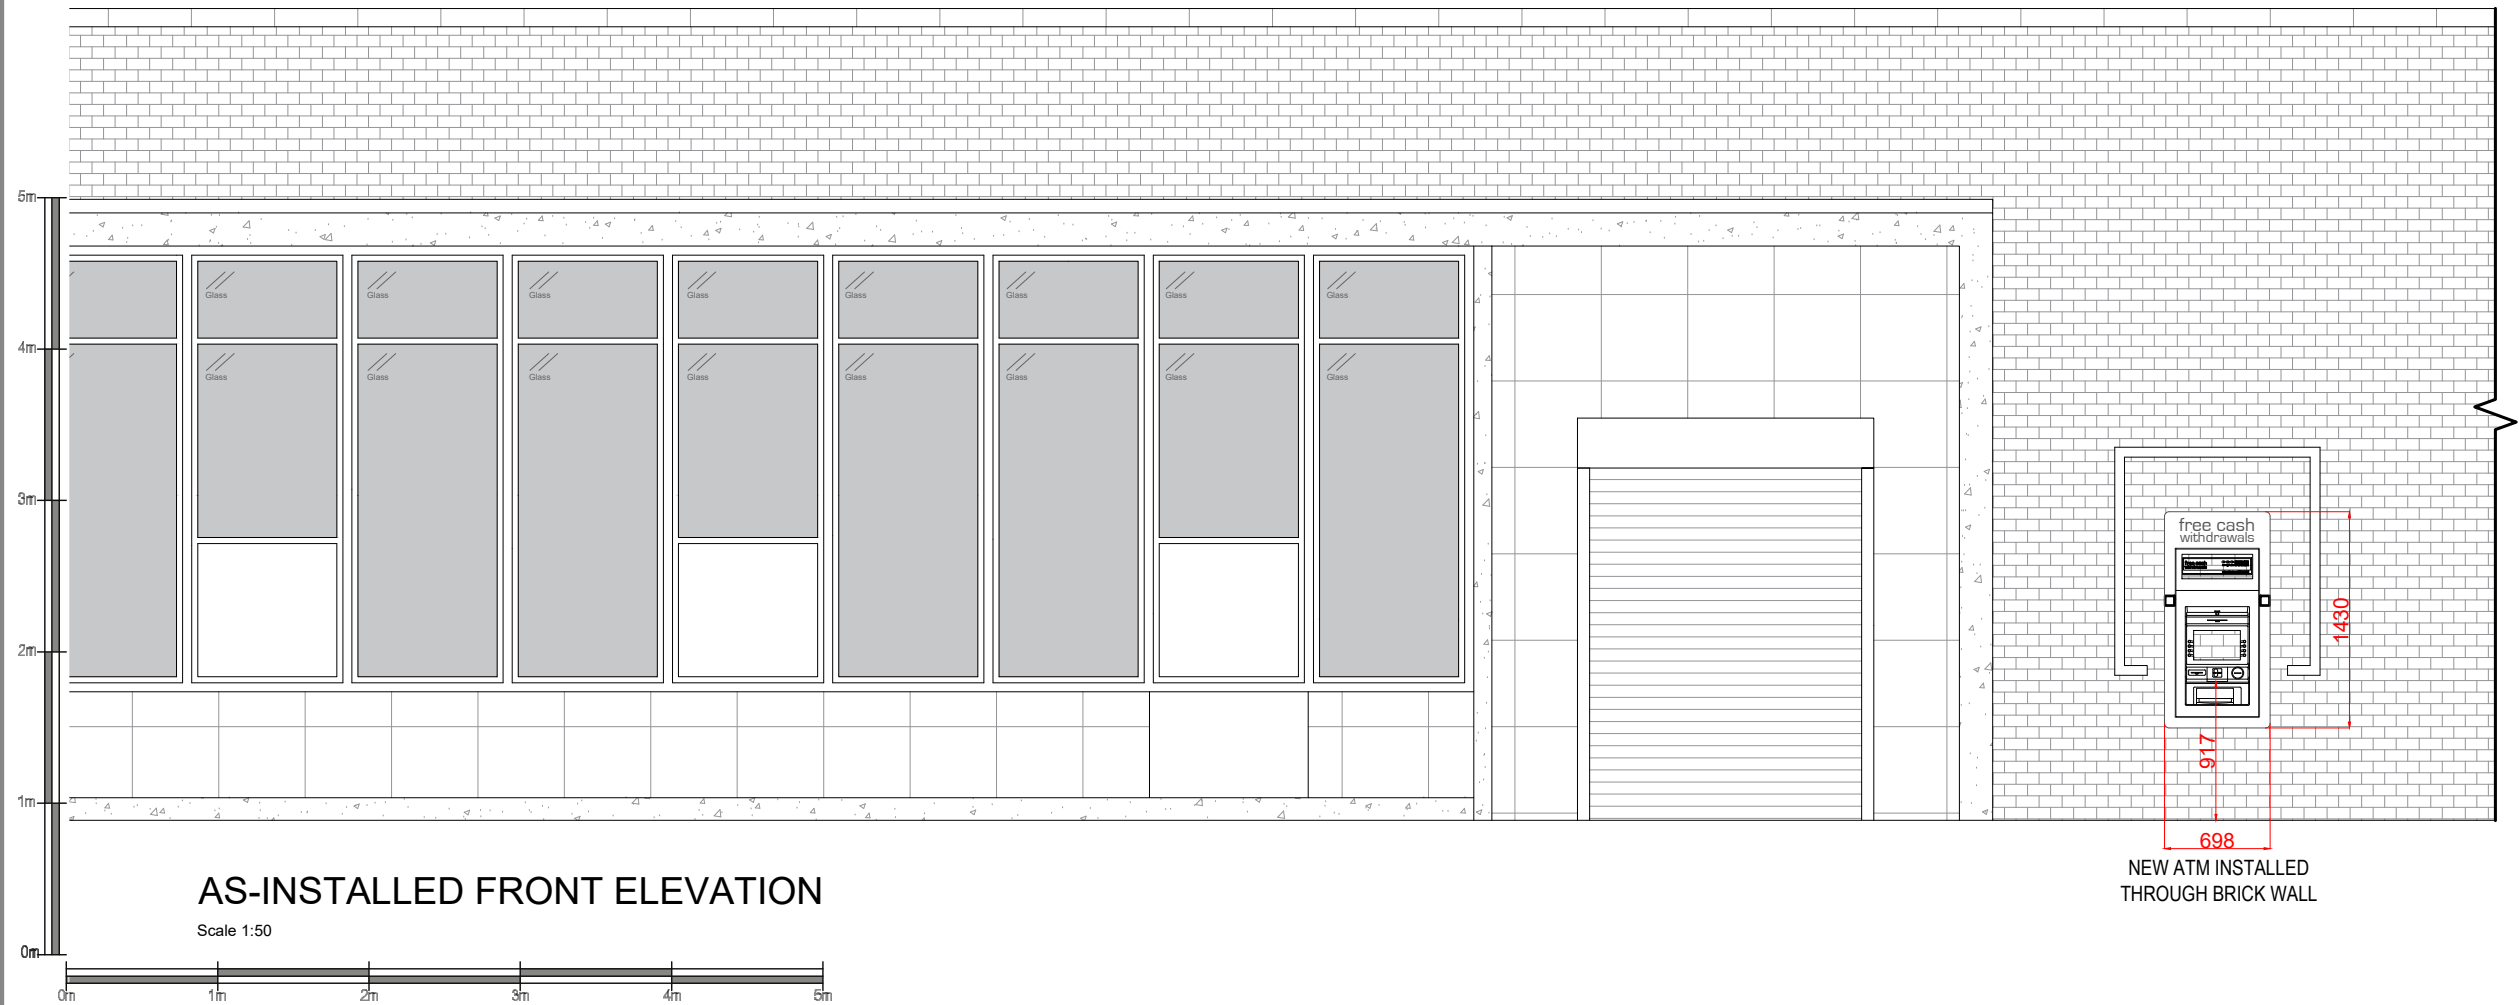

AS-INSTALLED FRONT ELEVATION

Scale 1:50

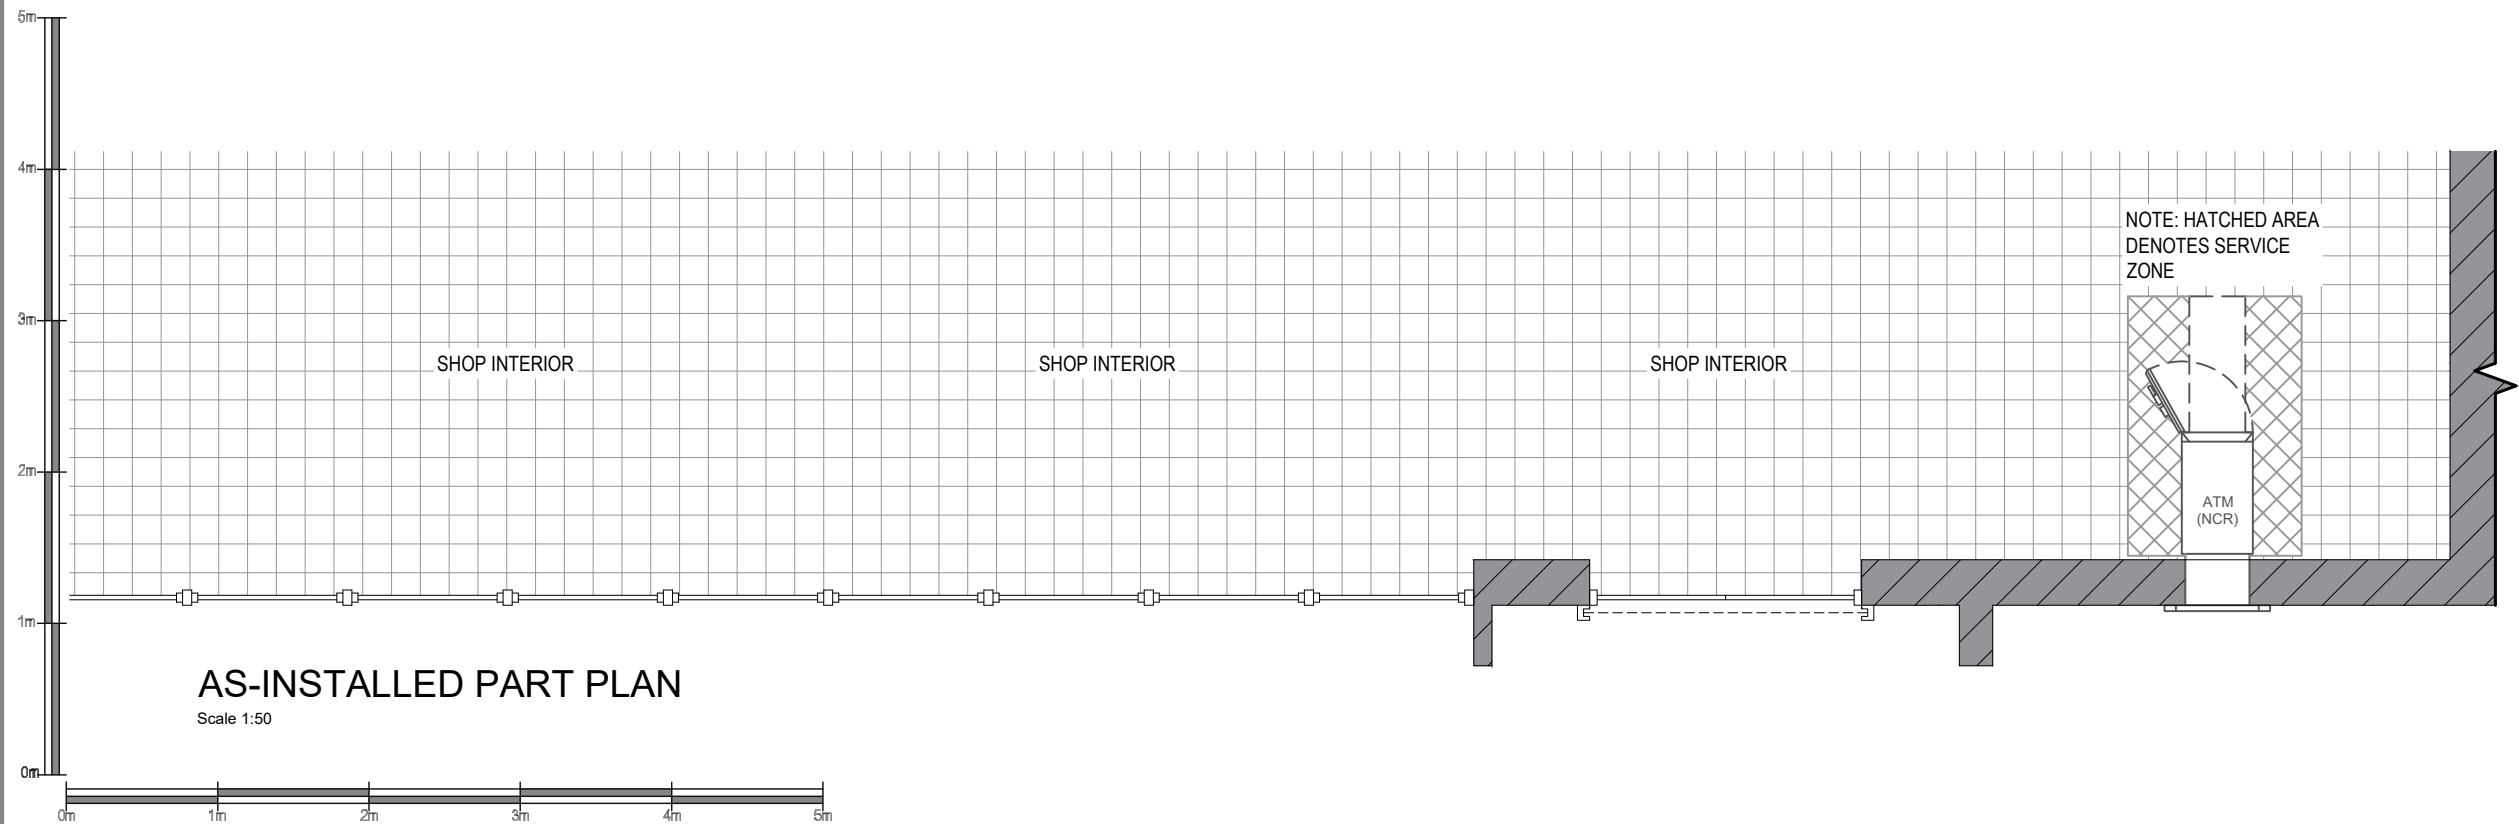

AS-INSTALLED PART PLAN

Scale 1:50

Date:	Comments:	By:
-------	-----------	-----

GENERAL NOTES:
1) All dimensions in millimeters unless otherwise stated.

Site:
Magical Moments,
34 High Street,
Wombwell,
Barnsley,
S73 8AA

Drawing Title:
As-Installed Plan and Elevation

Ref: T020832_AI	Date: 15/03/2022	Rev:
Scale: 1:50	Paper: A3	Date Rev: