


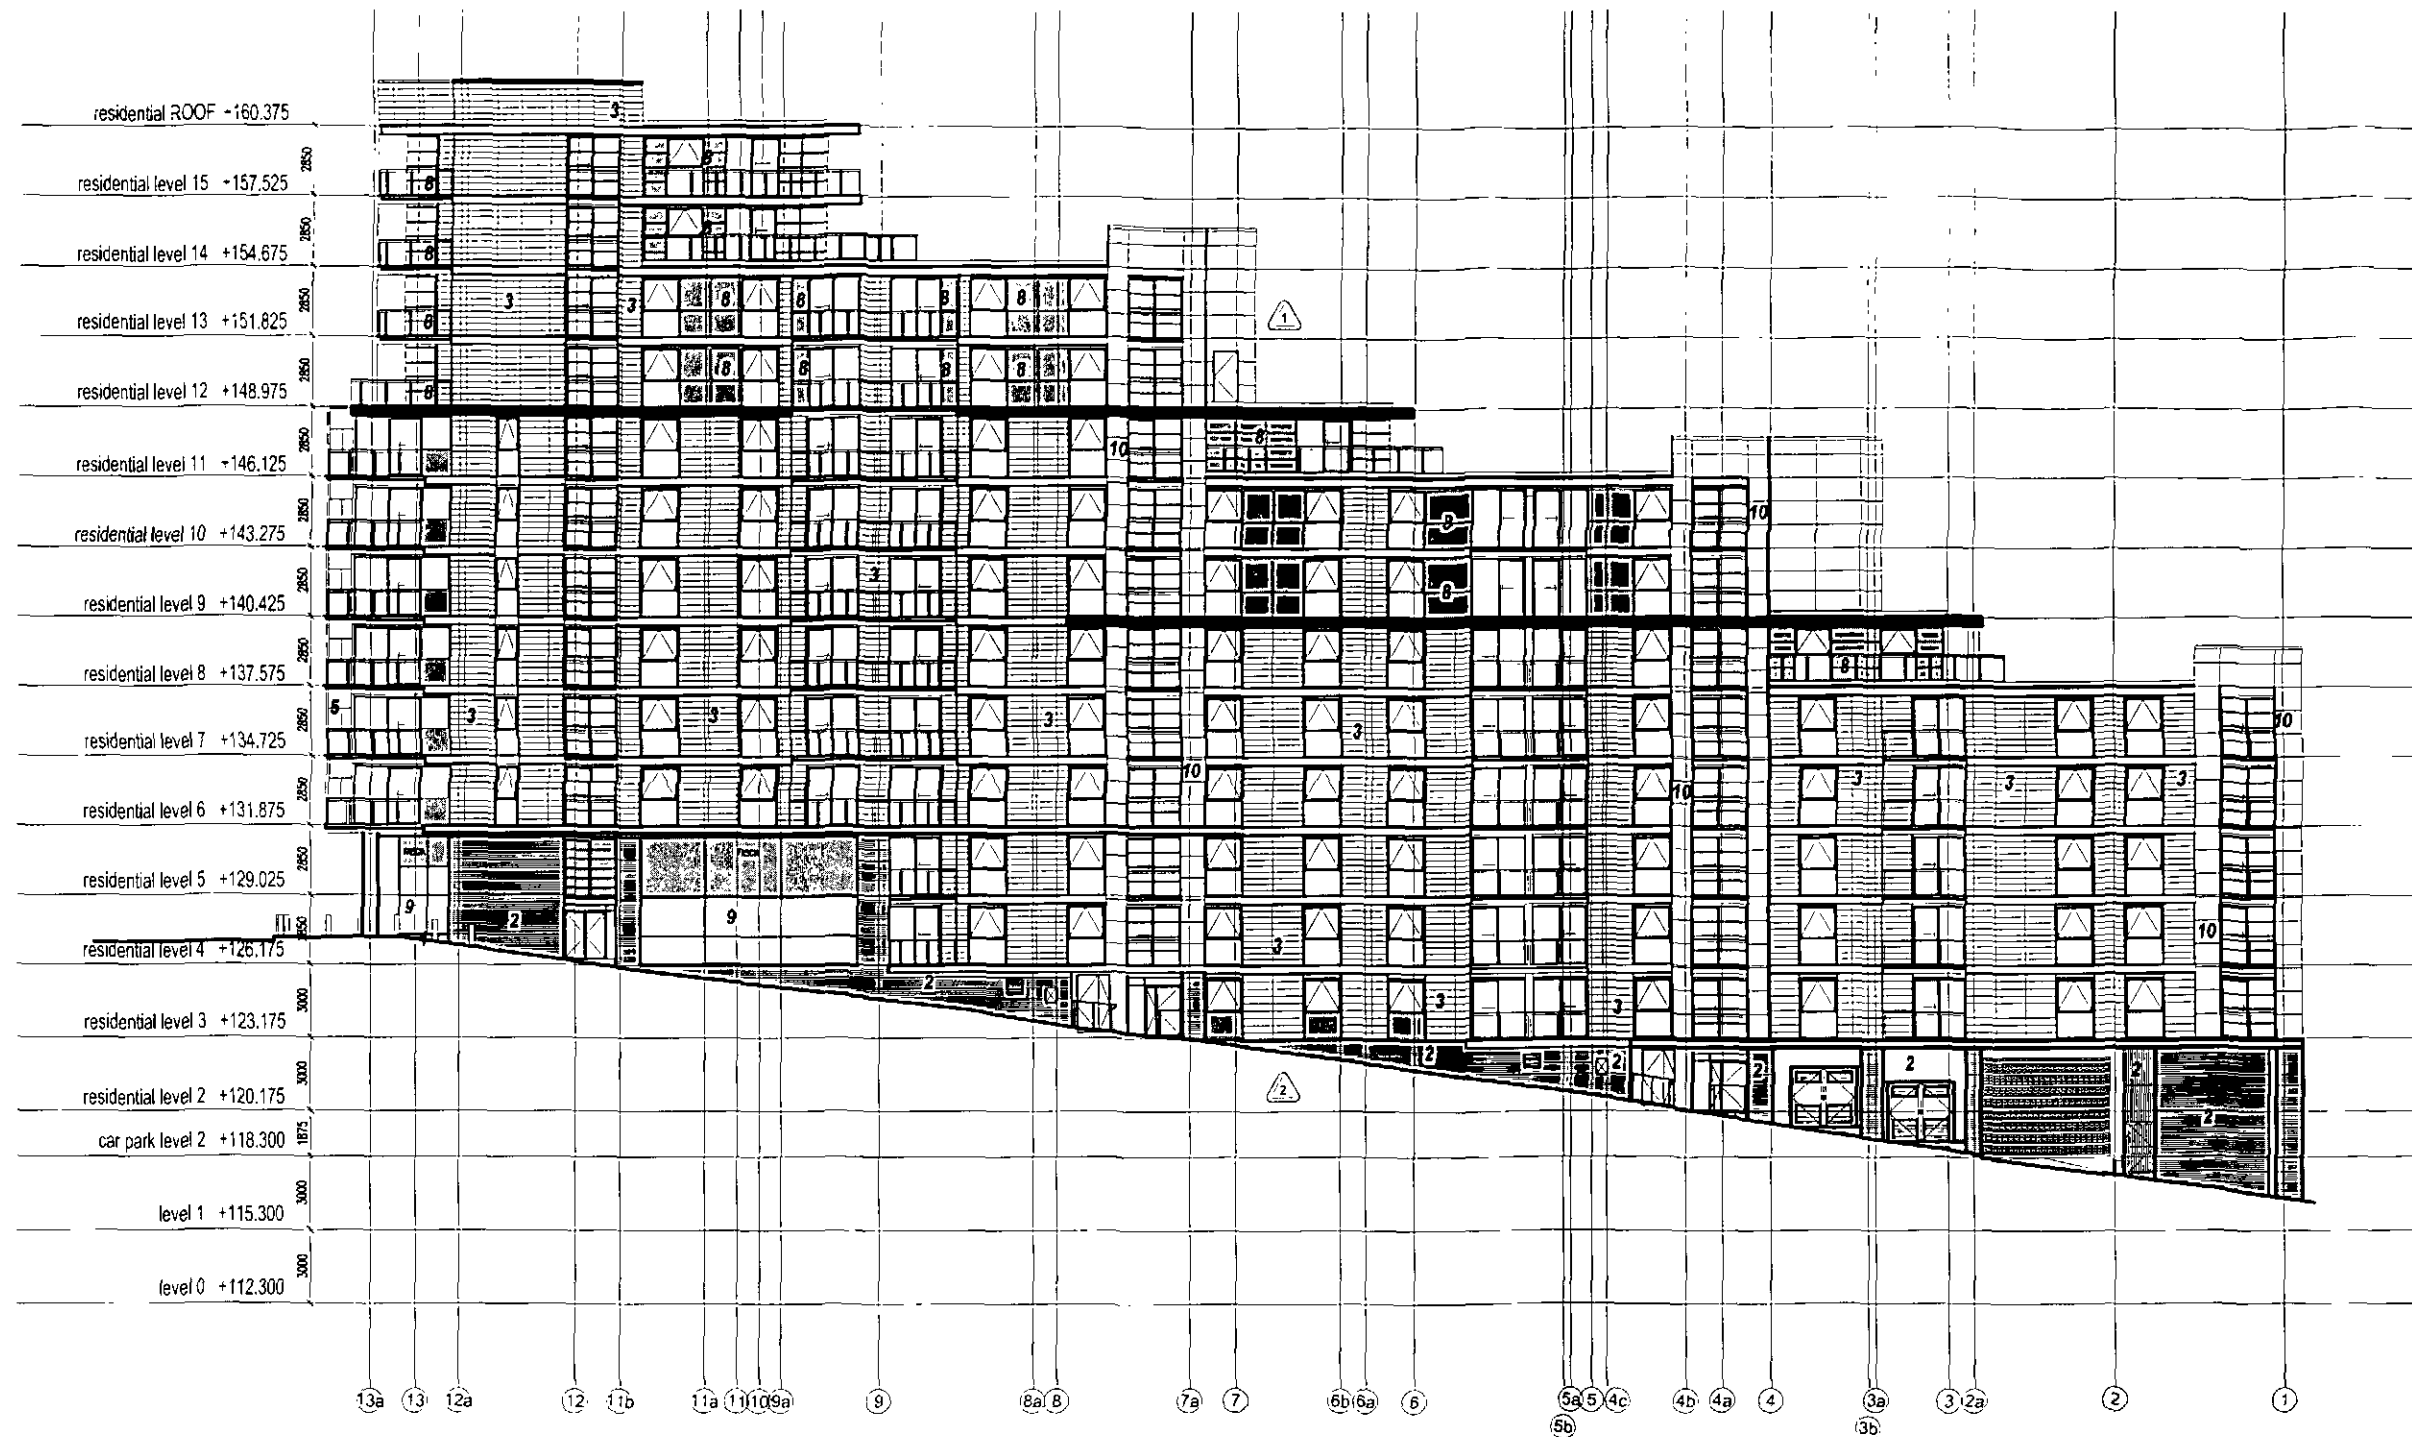


ELEVATION ONE, FITZWILLIAM STREET

- MATERIALS KEY**
- WINDOWS -**
COLOUR COATED ALUMINIUM FRAMED IN DARK GREY (RAL 7043),
WITH ANTI-SUN GREEN TINTED SELF-CLEANING GLASS. FOR
WIDTH OF WINDOWS REFER TO FLOOR PLANS
- MATERIALS -**
1. LAGUNAITE FACING MASONRY: MIDNIGHT GRANTITE
400x215mm FACE
 2. INCECOSA ANTI-RADIATE FACING BRICK (215x102.5x65mm)
WITH 10mm RECESSED BLACK MORTAR BED
 3. KERATON OR SIMILAR APPROVED CERAMIC RAINSCREEN
IN TERRACOTTA - HEIGHT OF TILE: 300mm AT LEVEL 3
250mm AT LEVEL 4-15
 4. FAIRFACED BLOCKWORK
 5. STEEL PANEL SYSTEM WITH RECESSED JOINTS IN CORUS
PRISMA PEGASUS
 6. STEEL LOUVERS BY COLT OR SIMILAR APPROVED TO BIN
STORES IN RAL 7043
 7. STEEL FRAMED CAFE BAR A3 UNIT WITH FULL HEIGHT
GLAZING IN POWDER COATED ALUMINIUM FRAMEWORK
WITH EITHER STANDING SEAM ROOFING OR SECAM GREEN
ROOF SYSTEM
 8. PENTHOUSE UNITS WITH FULL HEIGHT GLAZING SYSTEM
WITH COMBINATION OF CLEAR AND INSULATED OBSCURE
GLASS "LOOK-A-LIKE" PANELS
 9. A1/A3 UNITS - SHELL SPACE ONLY WITH GLAZED
SHOPFRONTS TO SUIT TENANT REQUIREMENTS
 10. LIFT TOWERS EXPRESSED IN CORUS PRISMA METALLIC
SILVER STEEL SYSTEM PANEL

- RISK IDENTIFICATION**
Wherever possible, unnecessary risk is removed out of the project
during the design process. Where a residual risk is assessed to be
unacceptable, the risk will be managed and controlled on the relevant
drawings with this notation and a brief description of the risk and
relevant control measures.
- Residual Risk:**
Windows above 1.8m above ground level - Risk associated with
access for cleaning.
- Control Measures:**
All windows (other than those accessible from balconies) are
fitted with their outer pane being self-cleaning glass
(CleanTech). Regularly inspecting the regularity with which they
require to be cleaned. However, they WILL require occasional
manual cleaning. Scheduled access required - Access
to be agreed.
- Residual Risk:**
Windows above 1.8m of ground level - Risk associated with
cleaning.
- Control Measures:**
All windows (other than those accessible from balconies) are
fitted with their outer pane being self-cleaning glass
(CleanTech). Regularly inspecting the regularity with which they
require to be cleaned. However, they WILL require occasional
manual cleaning. To be performed with telescopic pressure pole
from ground level if possible.

NOTE:
Windows are generally designed to allow for cleaning
by suitably qualified and experienced window cleaning
operatives, employed by management company. They
are to work strictly in accordance with a safe method
of work as prepared by the cleaning company. The
method of work is to cover each individual type of
cleaning operation and planned specifically for the
residential windows.

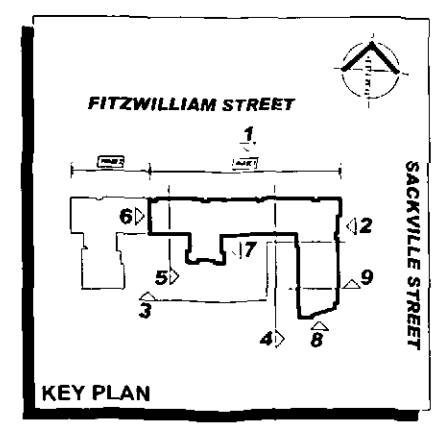

W 45 BUILT ISSUE 21 01 10

AS BUILT

SAXIS
ARCHITECTURE

TALBOT CHAMBERS 2 NORTH CHURCH STREET SHEFFIELD S1 2DH
TEL 0114 2490964 FAX 0114 2490960 www.saxisarchitecture.com


GATEWAY PLAZA
BARNSELEY

QUEST
RESIDENTIAL ELEVATION 1
FITZWILLIAM STREET

SCALE	DATE	DRAWN	CHECKED
AT ISSUE: 1:100	1:300	JUNE 2004	AXIS

DRAWING NUMBER: 22058/RES/22 W

© COPYRIGHT EXISTS ON THE DESIGN AND INFORMATION SHOWN ON THIS DRAWING.
The Copyright must be verified all dimensions on site before making any drawings
or commencing work of any kind. No dimensions to be scaled from this drawing.

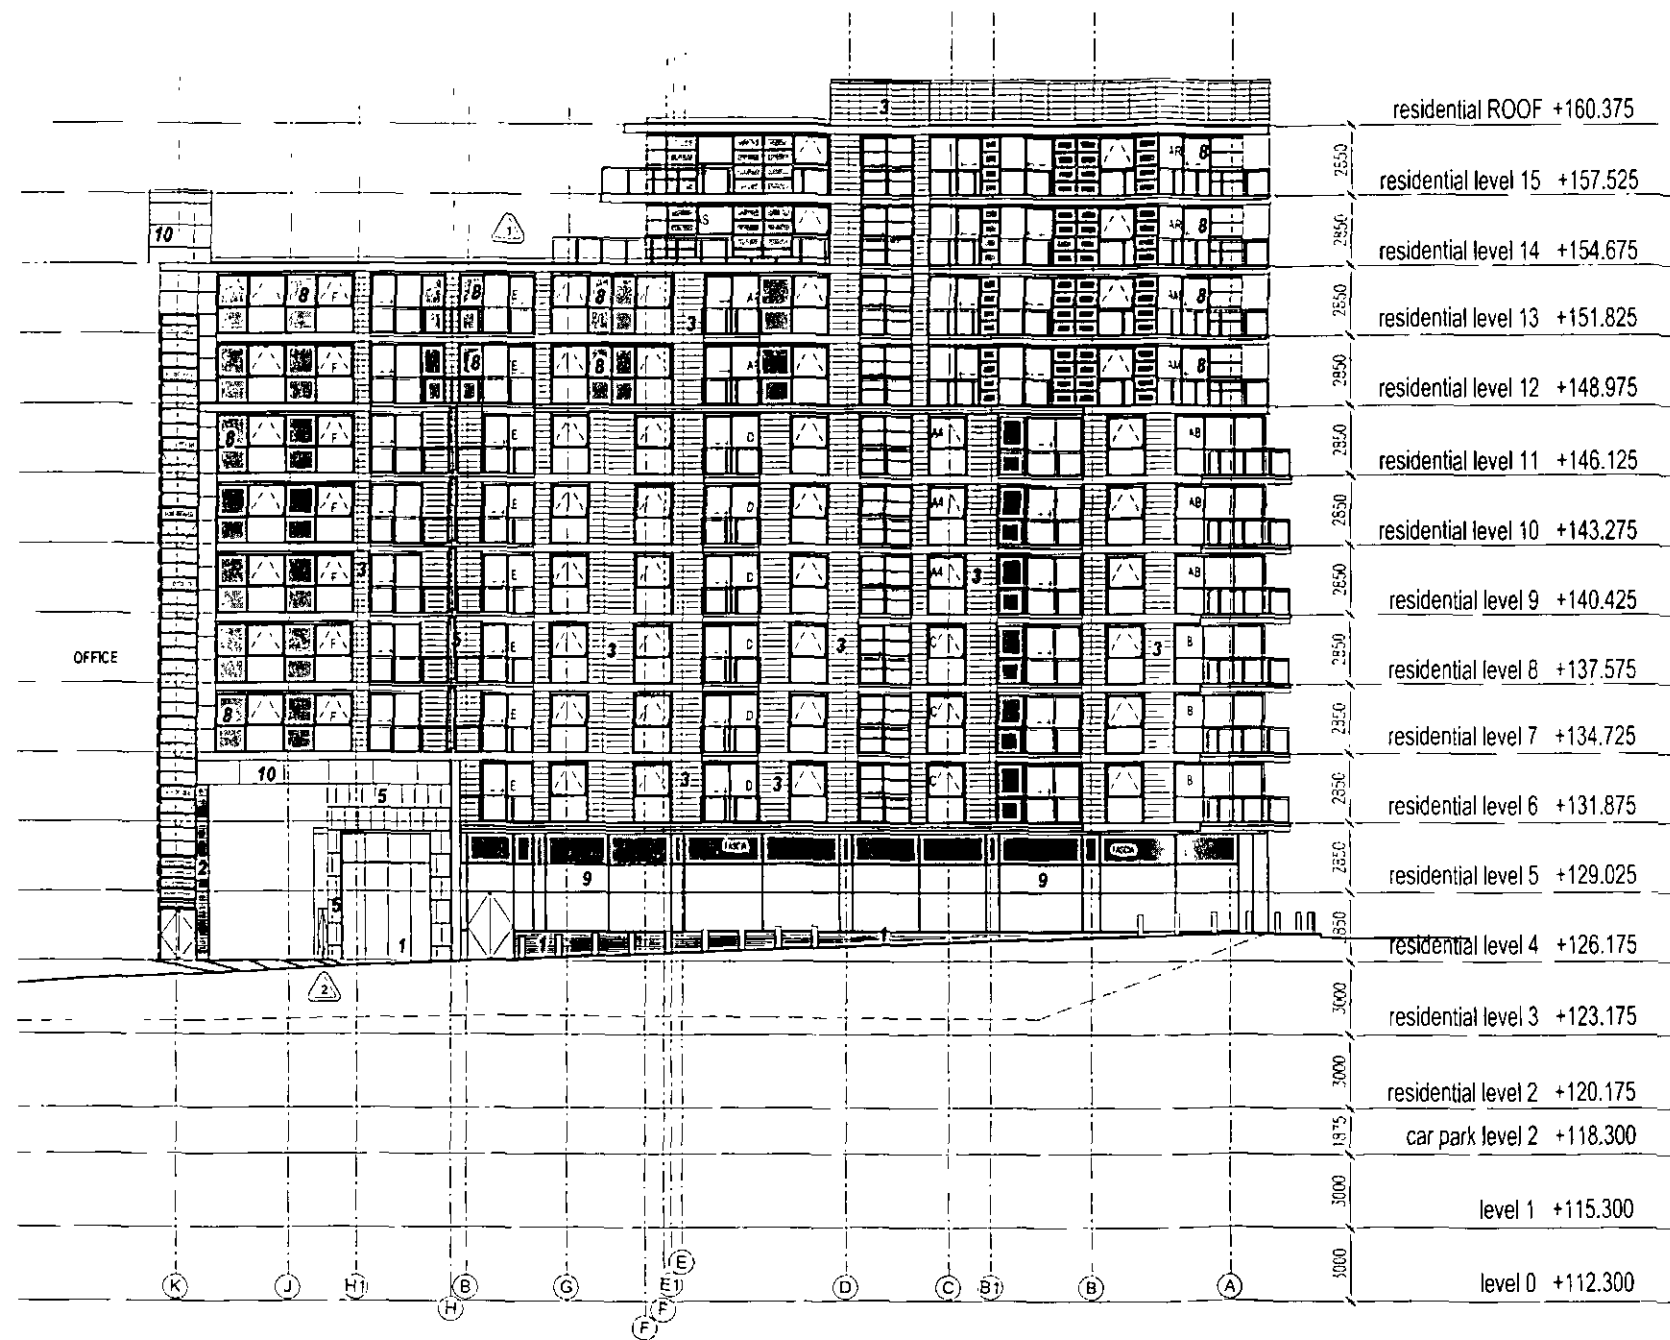

ELEVATION TWO, SACKVILLE STREET

MATERIALS KEY

WINDOWS -
COLOUR COATED ALUMINIUM FRAMED IN DARY GREY (RAL 7043) WITH ANTI-SUN GREEN TINTED SELF-CLEANING GLASS. FOR WIDTH OF WINDOWS REFER TO FLOOR PLANS

MATERIALS -

1. LAGNACITE FACING MASONRY MEDIUM GRANITE 400/215mm FACE
2. INCECOSA ANTI-RACITE FACING BRICK (215/102 565mm) WITH 10mm RECESSED BLACK MORTAR BED
3. KERATWIN OR SIMILAR APPROVED CERAMIC RAINSCREEN IN TERRACOTTA HEIGHT OF TILE 300mm AT LEVEL 3 250mm AT LEVEL 4-5
4. FAIRFACED BLOCKWORK
5. STEEL PANEL SYSTEM WITH RECESSED JOINTS IN CORUS PRISMA PEGASUS
6. STEEL LOUVERS BY COLT OR SIMILAR APPROVED TO BAN STORES IN RAL 7043
7. STEEL FRAMED CAFE BAR/AT UNIT WITH FULL HEIGHT GLAZING IN POWDER COATED ALUMINIUM FRAMEWORK WITH EITHER STANDING SEAM ROOFING OR SEAM GREEN ROOF SYSTEM
8. PENT-HOUSE LANTS WITH FULL HEIGHT GLAZING SYSTEM WITH COMBINATION OF CLEAR AND INSULATED OBSCURE GLASS 'LOOK-A-LIKE' PANELS
9. A103 UNITS - SHELL SPACE ONLY WITH GLAZED SHOPFRONTS TO SUIT TENANT REQUIREMENTS
10. LIFT TOWERS EXPRESSED IN CORUS PRISMA METALLIC SILVER STEEL SYSTEM PANEL

RISK IDENTIFICATION

Wherever possible, unnecessary risk is designed out of the proposal during the design process. Where a residual risk is present in the design, the risk is identified and described in the relevant drawings with this number and a brief description of the risk and relevant control measures.

1	Residual Risk: Windows above 15m above ground level - Risk is associated with access for cleaning.
	Control Measures: All windows (other than those accessible from balconies) are fitted with their outer pane using self-cleaning glass (ClearShield), thereby reducing the frequency with which they require to be cleaned. However, they WILL require a seasonal manual cleaning. Scheduled access equipment required - Access to be sought.
2	Residual Risk: Windows within 15m of ground level - Risk is associated with cleaning.
	Control Measures: All windows (other than those accessible from balconies) are fitted with their outer pane using self-cleaning glass (ClearShield), thereby reducing the frequency with which they require to be cleaned. However, they WILL require to be cleaned manually. To be performed with inspection platform safe from ground level by specialist.

NOTE:
Windows are generally designed to allow for cleaning by suitably qualified and experienced window cleaning operatives, employed by management company. They are to work strictly in accordance with a safe method of work as prepared by the cleaning company. The method of work is to cover each individual type of cleaning operation and planned specifically for the residential windows.

U AS BUILT ISSUE 21.01.10

AS BUILT

SAXIS
ARCHITECTURE

TALBOT CHAMBERS 2 NORTH CHURCH STREET SHEFFIELD S1 2DH
TEL: 0114 2480004 FAX: 0114 2480000 www.saxisarchitecture.com


GATEWAY PLAZA
BARNLEY


QUEST
RESIDENTIAL ELEVATION 2
SACKVILLE STREET

SCALE	DATE	DRAWN	CHECKED
A1 ISSUE: 1:150	A3 ISSUE: 1:300	JUNE 2004	AUS

DRAWINGS IN A3 OR A4

22058/RES/23 U

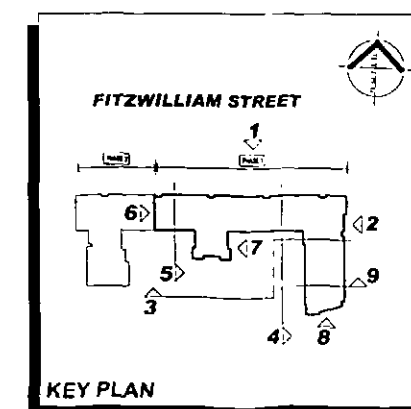

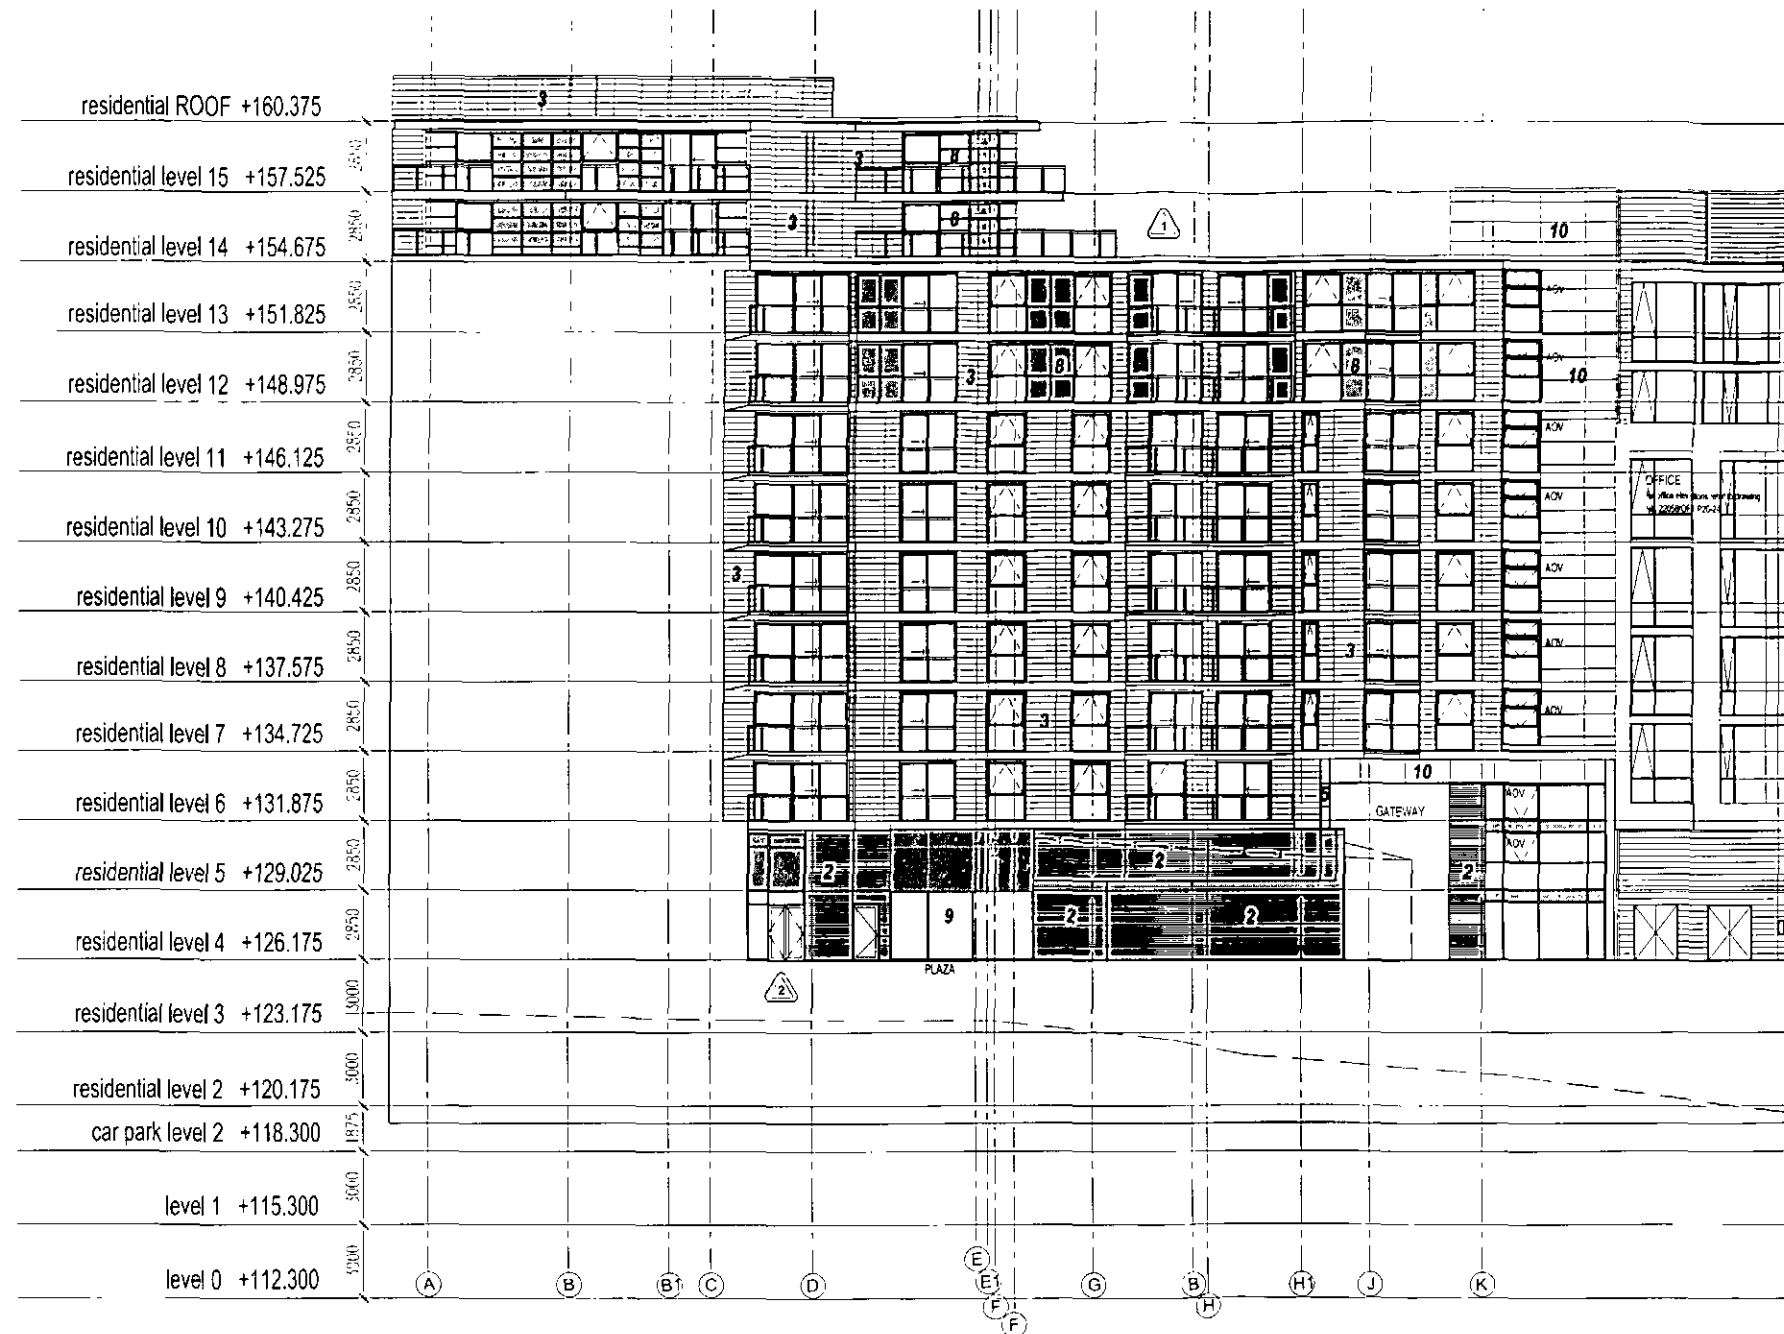


ELEVATION FOUR, PLAZA ENTRANCE








MATERIALS KEY	
WINDOWS -	
COLOUR COATED ALUMINIUM FRAMED IN DARK GREY, RAL 7043	
WITH ANTI SUN GREEN TINTED SELF-CLEANING GLASS, F30	
WIDTH OF WINDOWS REFER TO FLOOR PLANS	
MATERIALS -	
1.	LACONITE FACING MASONRY, MIDNIGHT GRANITE AGGREGATE FACE
2.	INCECOSA ANTI-RACITE FACING BRICK, 2 1/2 x 102 x 65mm, WITH 10mm RECESSED BLACK MORTAR BED
3.	KERATWIN OR SIMILAR APPROVED CERAMIC RAINSCREEN IN TERRACOTTA, HEIGHT OF TILE, 300mm AT LEVEL 3, 250mm AT LEVEL 4-15
4.	FAIRFACED BLOCKWORK
5.	STEEL PANEL SYSTEM WITH RECESSED JOINTS IN CORUS PRISMA PEGASUS
6.	STEEL LOUVERS BY COLT OR SIMILAR APPROVED TO BIN STORES IN RAL 7043
7.	STEEL FRAMED CAFÉ BAR/3 UNIT WITH FULL HEIGHT GLAZING IN POWDER COATED ALUMINIUM FRAMEWORK WITH EITHER STANDING SEAM ROOFING OR SEDUM GREEN ROOF SYSTEM
8.	PENTHOUSE UNITS WITH FULL HEIGHT GLAZING SYSTEM WITH COMBINATION OF CLEAR AND INSULATED OBSCURE GLASS "LOOK-A-LIKE" PANELS
9.	ALIAS UNITS - SHELL SPACE ONLY WITH GLAZED SHOPFRONTS TO SUIT TENANT REQUIREMENTS
10.	LIFT TOWERS EXPRESSED BY CORUS PRISMA METALLIC SILVER STEEL SYSTEM PANEL

RISK IDENTIFICATION	
	Risk of Injury: Windows above 10m above ground level - Risks associated with access to cleaning
	Control Measures: All windows (other than those in a multi-story building) are fitted with their own self-cleaning glass. (CleanShield) technology ensuring the self-cleaning glass may require to be cleaned - however, they will require occasional manual cleaning. Specialist access is required - advice to be sought.
	Risk of Fall: Windows within 10m of ground level - Risks associated with cleaning
	Control Measures: All windows (other than those in a multi-story building) are fitted with their own self-cleaning glass. (CleanShield) technology ensuring the self-cleaning glass may require to be cleaned - however, they will require occasional manual cleaning. To be performed with telescopic pressure pole from ground level by specialist.

NOTE:
Windows are generally designed to allow for cleaning by suitably qualified and experienced window cleaning operatives, employed by management company. They are to work strictly in accordance with a safe method of work as prepared by the cleaning company. The method of work is to cover each individual type of cleaning operation and planned specifically for the residential windows.

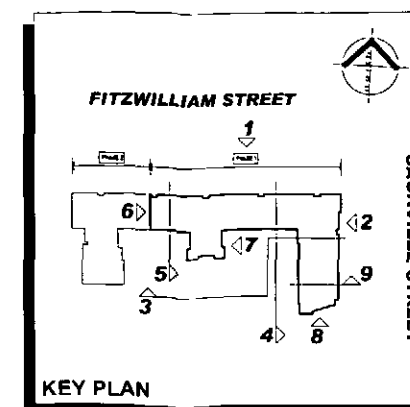

D. AS BUILT ISSUE		21/01/10
AS BUILT		
SAXIS		
ARCHITECTURE		
TALBOT CHAMBERS 2 NORTH CHURCH STREET SHEFFIELD S1 2DN		
TEL 0114 2490846 FAX 0114 2490888 www.saxis-architecture.com		
GATEWAY PLAZA		
BARNLEY		
QUEST		
RESIDENTIAL ELEVATION 4		
PLAZA		
SCALE	DATE	DRAWN
1:150	1300	20/11/2007
DRAWING NUMBER	REF	15/01/10
22058/RES/25		E

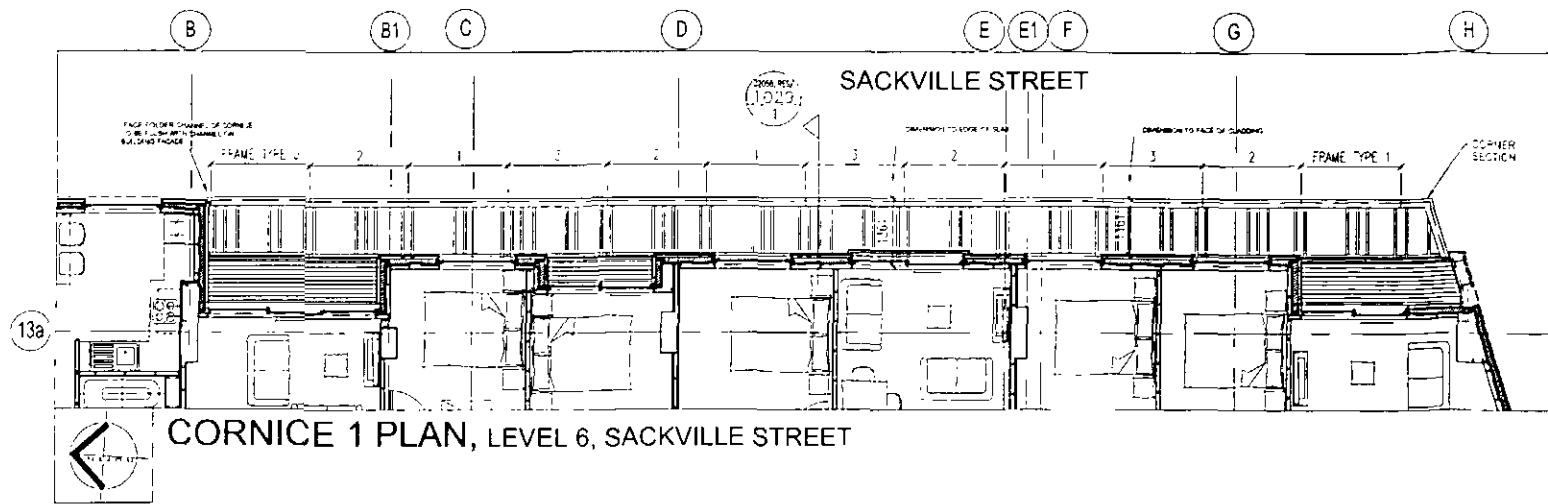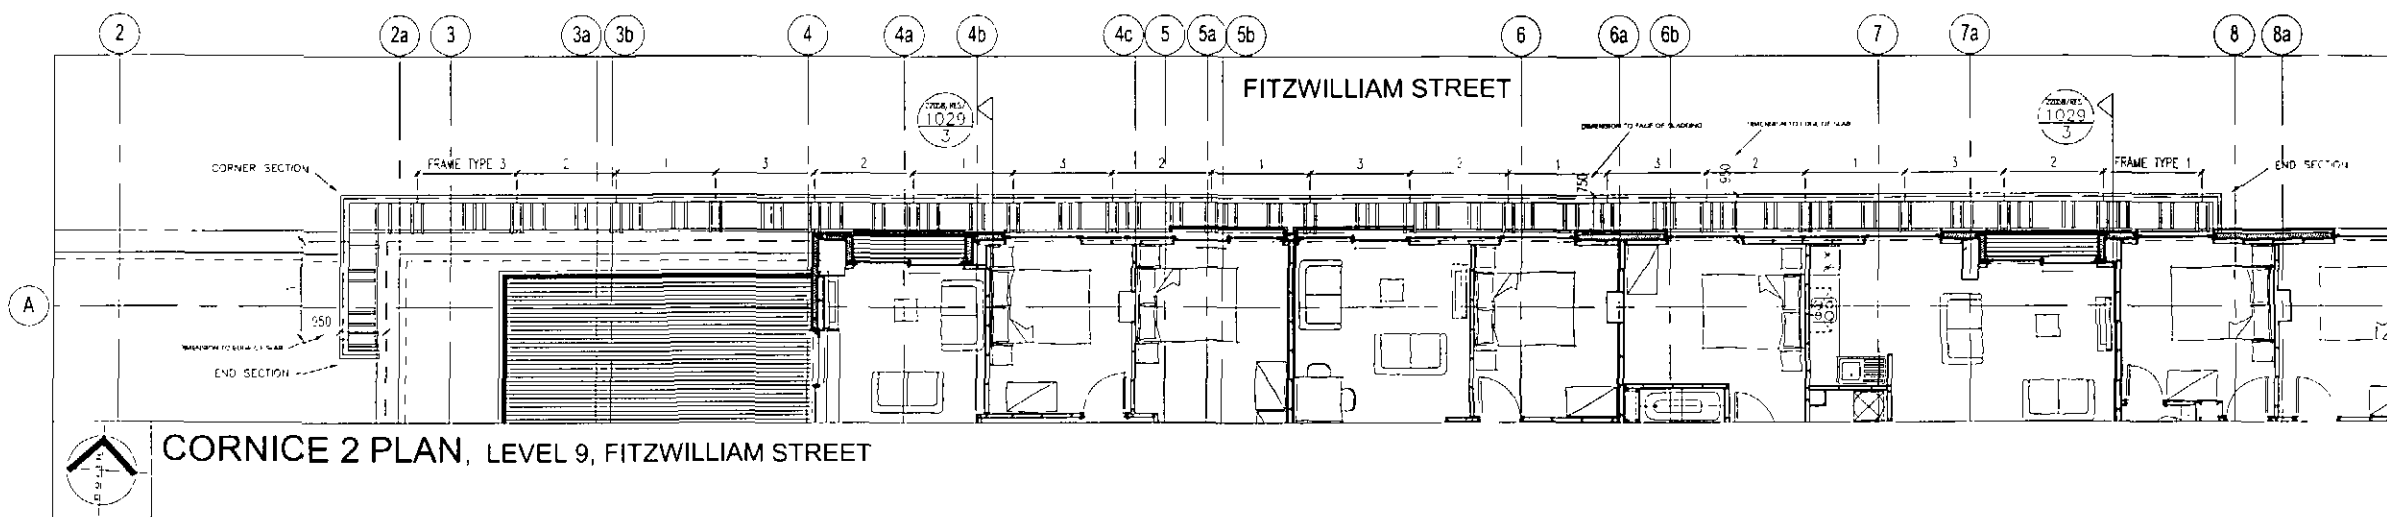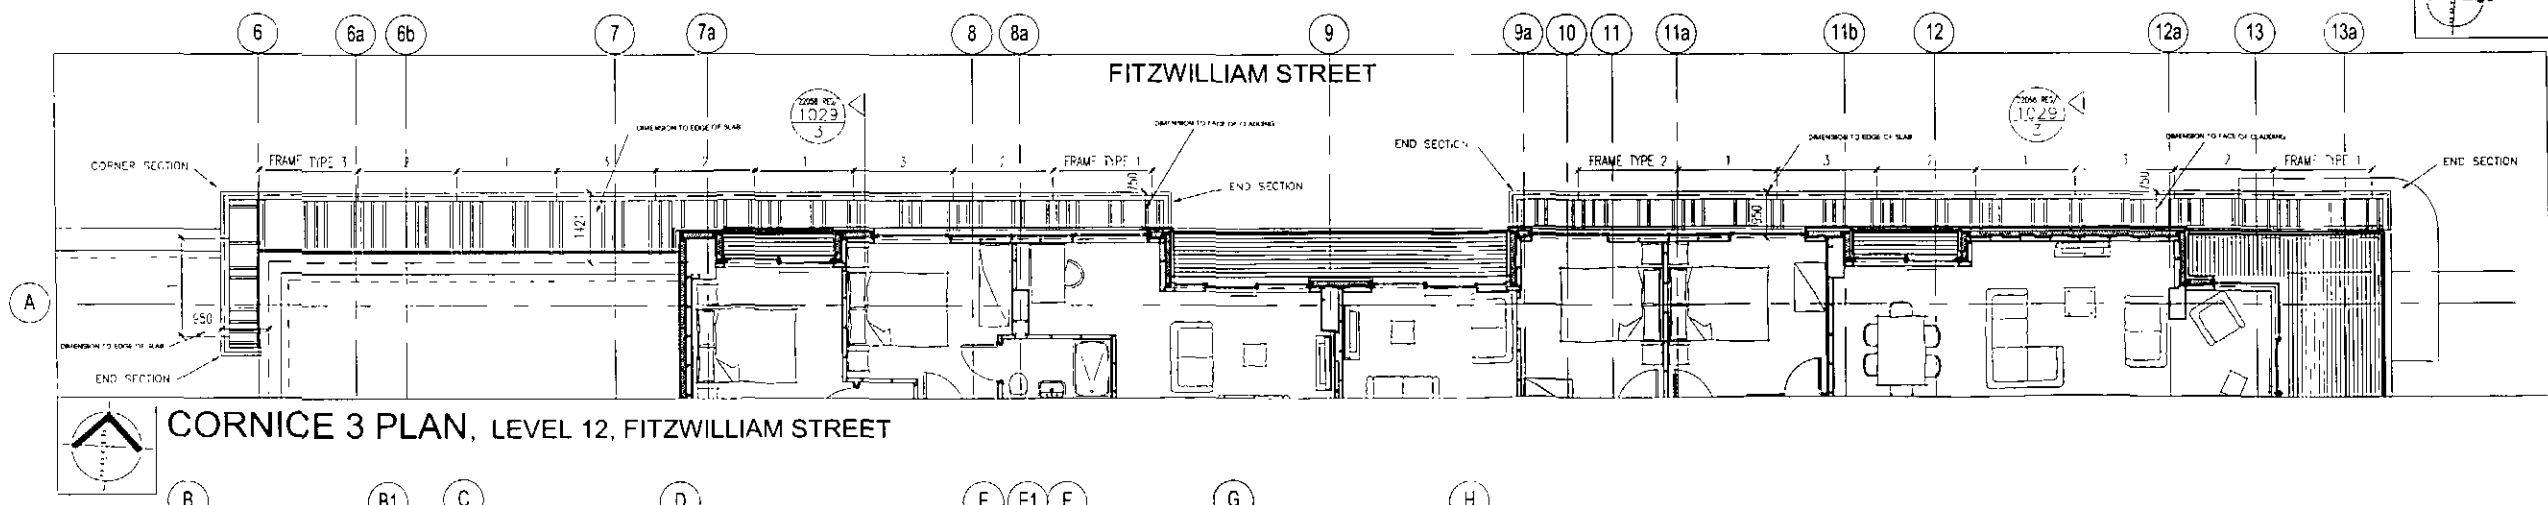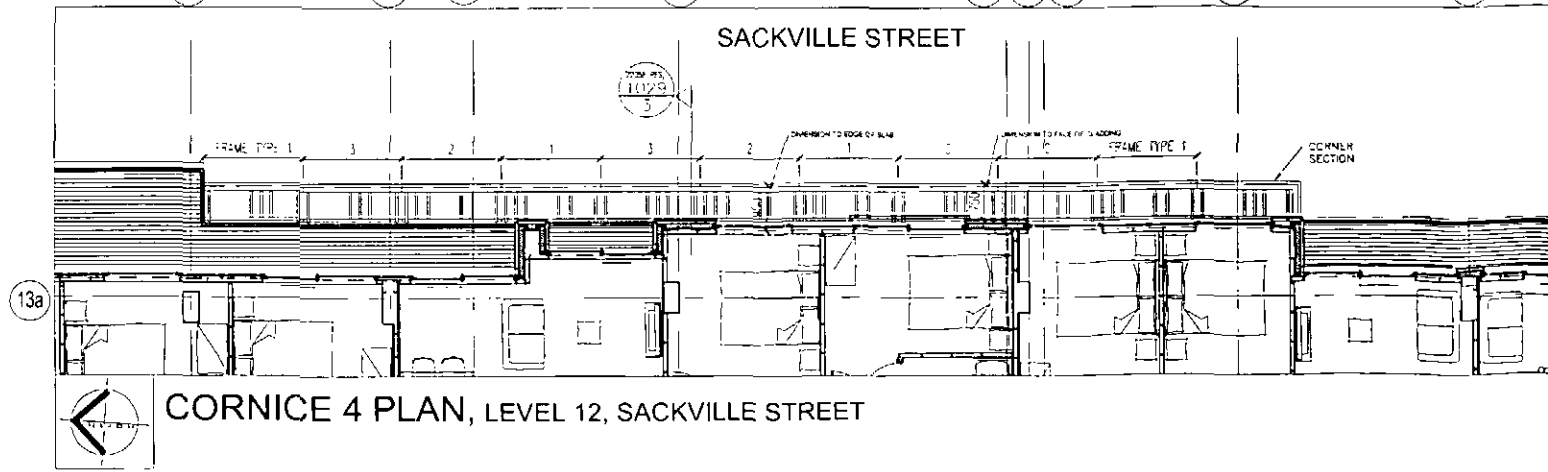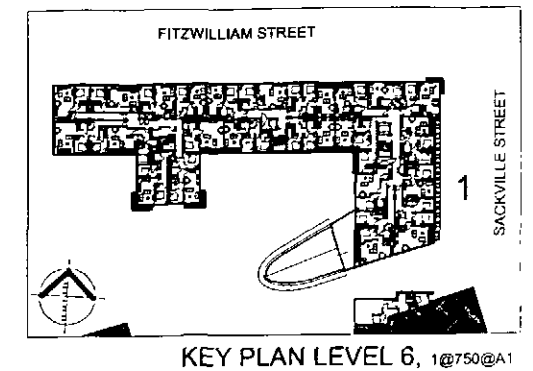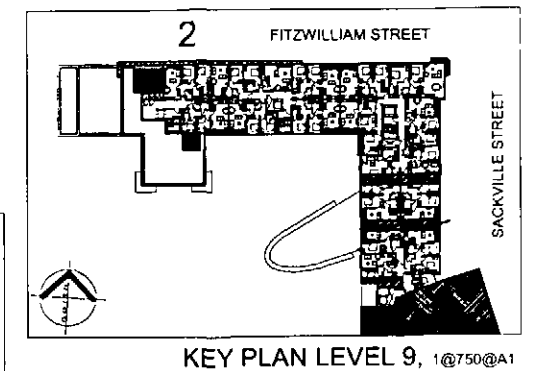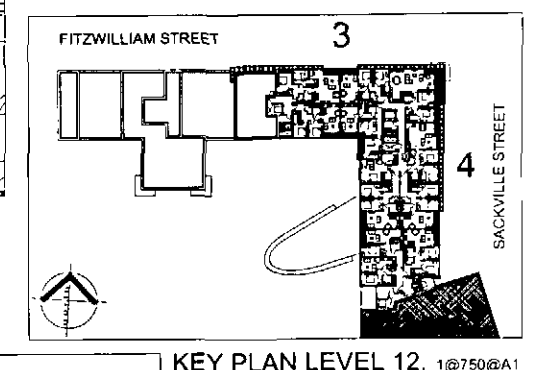

FOR DISCUSSION

A X I S
ARCHITECTURE

TALBOT CHAMBERS 2 NORTH CHURCH STREET SHEFFIELD S1 2DH
TEL 0114 2490844 FAX 0114 2490800 WWW.AXISARCHITECT.CO.UK


GATEWAY PLAZA
BARNSELEY
QUEST
RESIDENTIAL
CORNICE LAYOUTS
LEVEL 6, 9 & 12

SCALE	DATE	DRAWN	CHECKED
A1 ISSUE: 1:75	A3 ISSUE: 1:150	26 08 09	JA


DRAWINGS 18/8/09

22058/RES/82


© COPYRIGHT EXISTS ON THE DESIGN AND INFORMATION SHOWN ON THIS DRAWING.
The Contractor must verify all dimensions on site before making any drawings or commencing work of any kind. No dimensions to be scaled from this drawing.

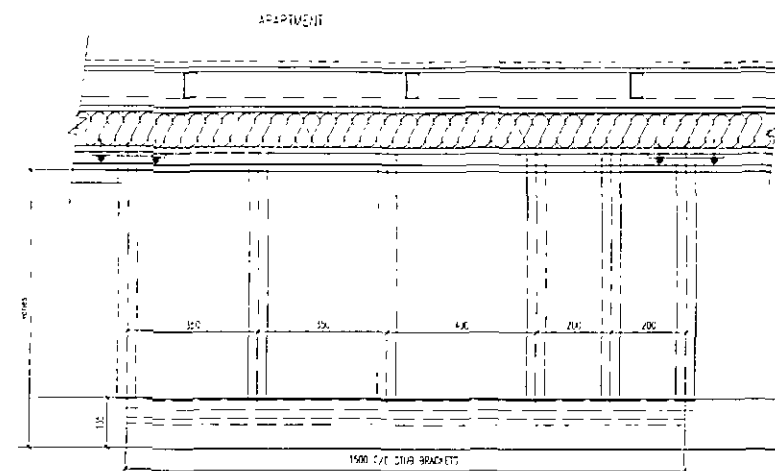


CORNICE FRAME TYPE 3

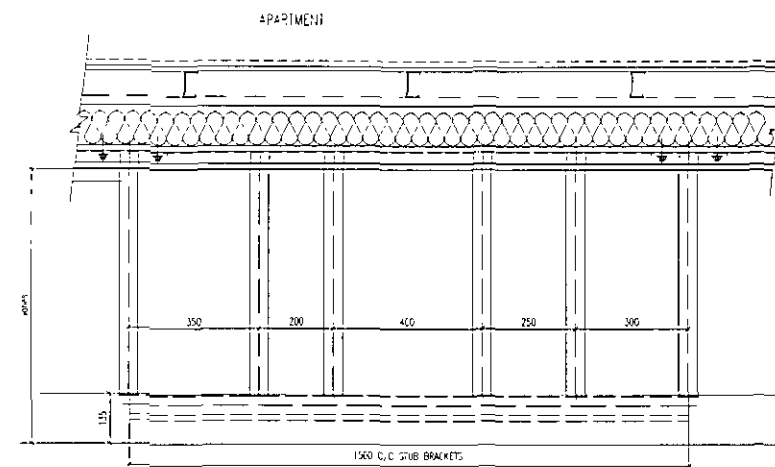


CORNICE FRAME TYPE 2

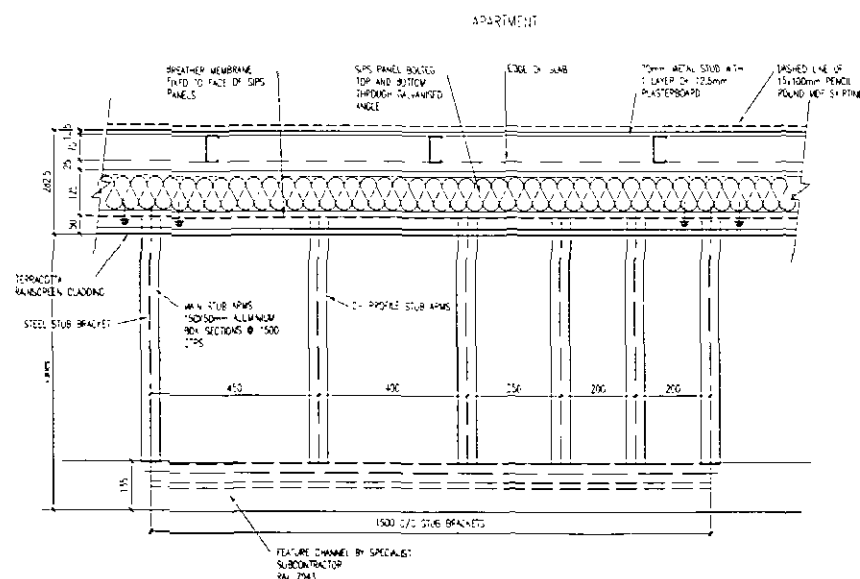


CORNICE FRAME TYPE 1

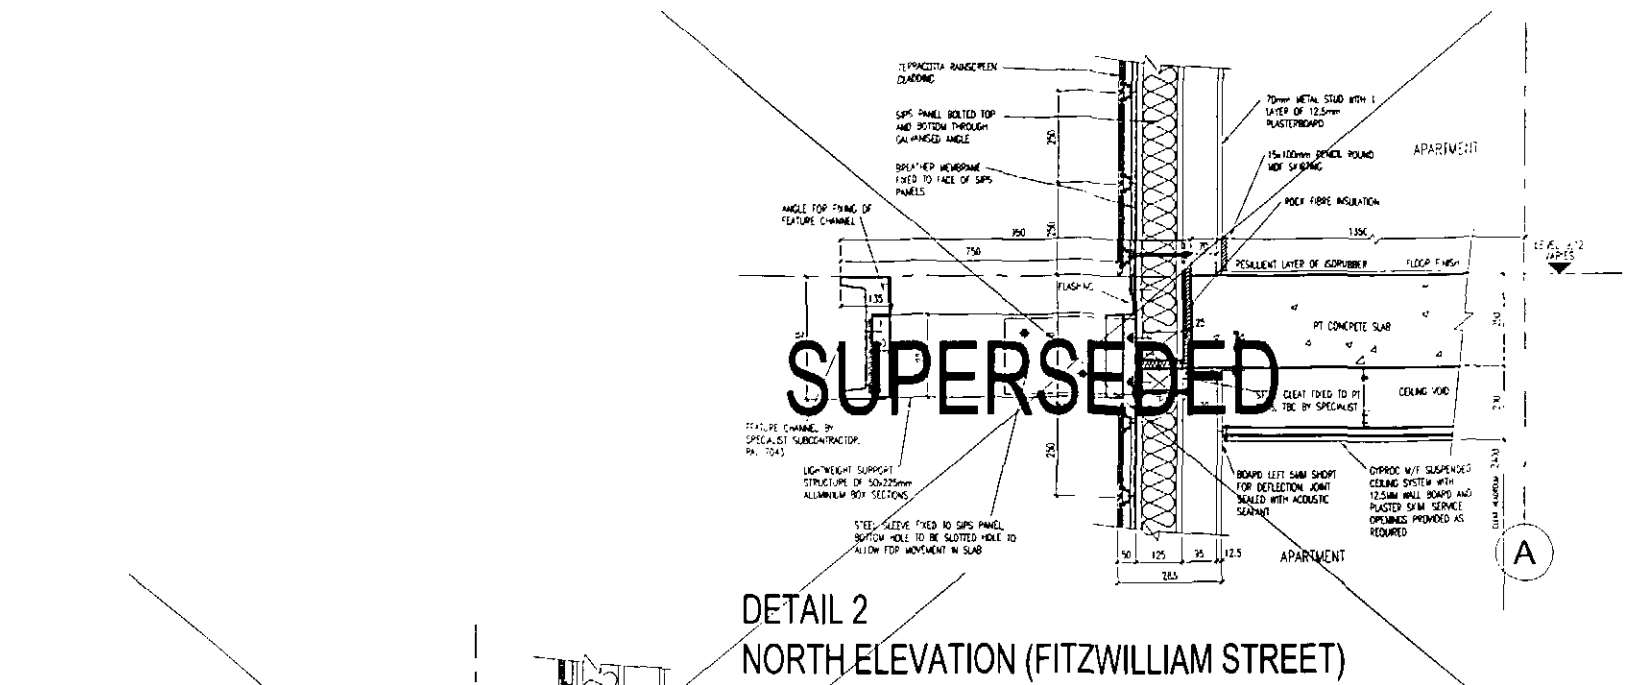


DETAIL 2
NORTH ELEVATION (FITZWILLIAM STREET)

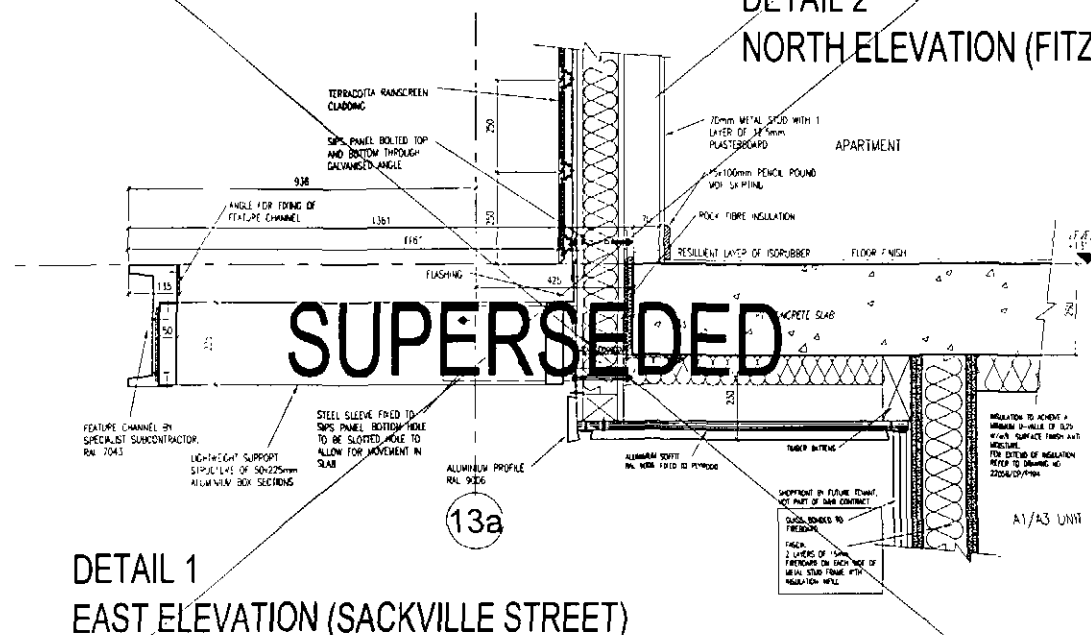

DETAIL 1
EAST ELEVATION (SACKVILLE STREET)

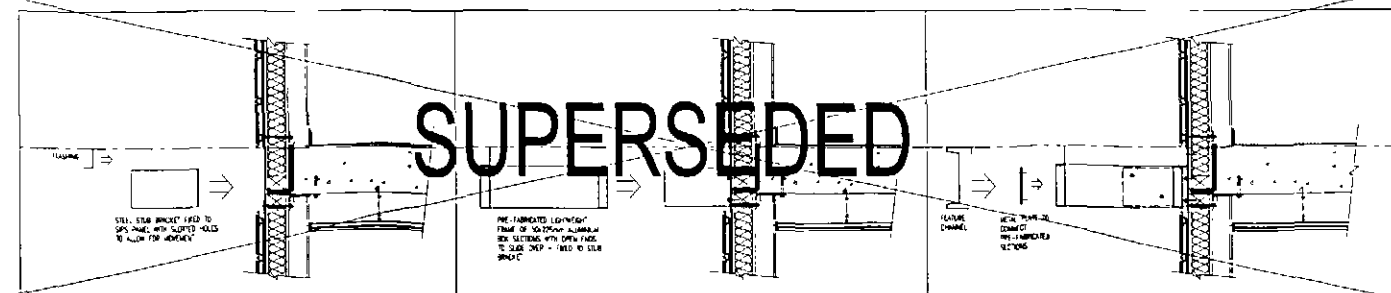

TYPICAL FIXING PRINCIPLES 1:15@A1

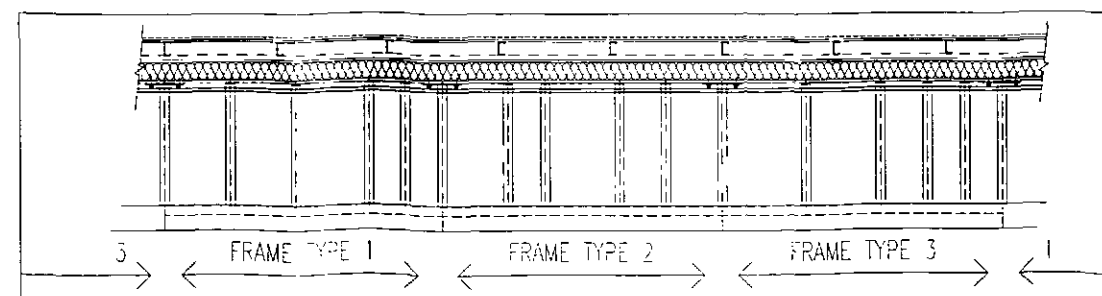

TYPICAL LAYOUT PRINCIPLES 1:20@A1

- G - SETTING OUT AMENDED IN LINE WITH SUBCONTRACTORS DETAILS 07 12 09
- F - SETTING OUT AMENDED TO SUIT 1500mm STUD CENTRES 23 10 09
- E - SETTING OUT AMENDED TO SUIT 1500mm MODULES 21 10 09
- D - FIXING PLATES TO SLABS AMENDED 17 09 09
- C - AMENDED AS OPTION 1 28 08 09
- B - CORNICE DETAILS AMENDED, PLANS AND FIXING PRINCIPLES ADDED 25 08 09
- A - EXTERNAL CLADDING AND INTERNAL LINING AMENDED, CORNICE IN ABSENCE, ISSUED FOR CONSTRUCTION 03 08 09



TALBOT CHAMBERS 2 NORTH CHURCH STREET SHEFFIELD S1 2JH
TEL 0114 2460844 FAX 0114 2460395 www.axisarchitecture.co.uk

GATEWAY PLAZA
BARNLEY
QUEST PROPERTY
RESIDENTIAL
TYPICAL CORNICE DETAILS

OPTION 1		SCALE	DATE	DRAWN	CHECKED
A1 ISSUE:	A3 ISSUE:	1:10	13 08 08	JUN	
DRAWING NUMBER		REV A10 ON			

22058/RES/1029A G