



Ground floor layout.

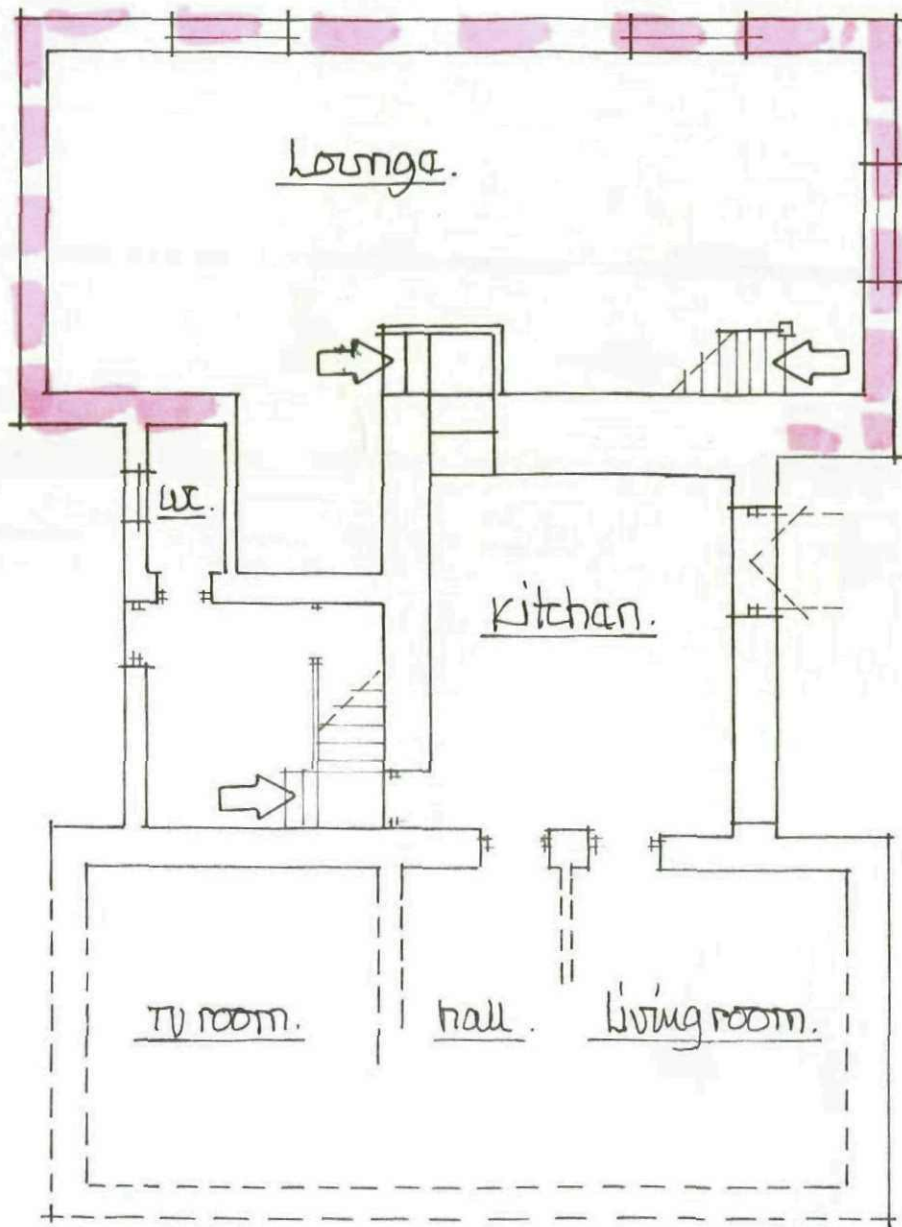

elevation from Rothercroft.

* note the existing two storey ext'n on site is shortly to be replaced by the two storey ext'n shown in red - facing materials are to be reclaimed during demolition *

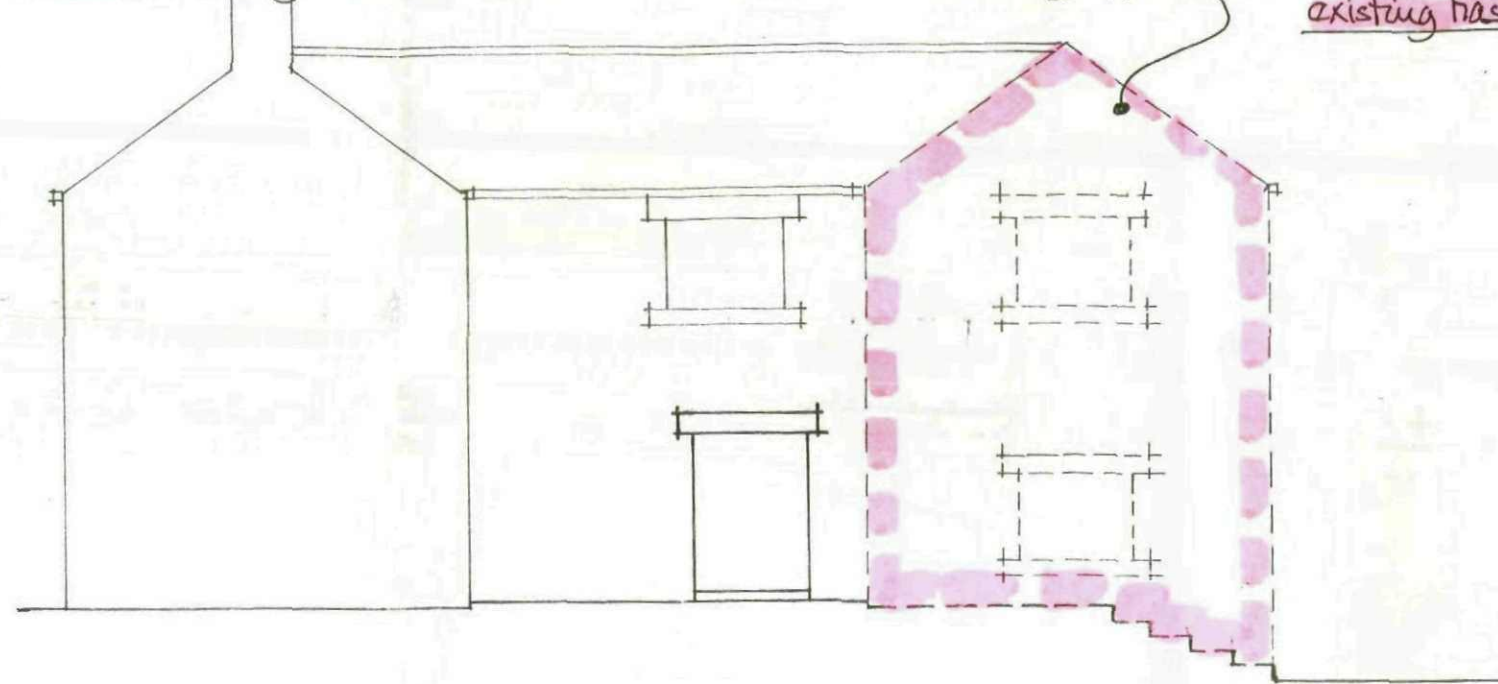

Scale 1:100m.


* previously approved ext'n to be commenced shortly after existing has been demolished *

BERNESLAI HOMES
E-POST ROOM


02 MAY 2012

Received By:
No of Pages:
PHOTOCOPY/ORIGINAL

side projection from rear garden.

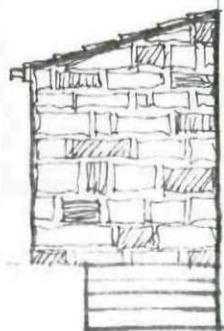

side projection from front garden.

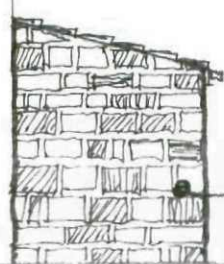


matching reclaimed coursed stone walls + cills.


matching door/windows

matching colour textured tiles

elevation from Rothercroft as proposed.

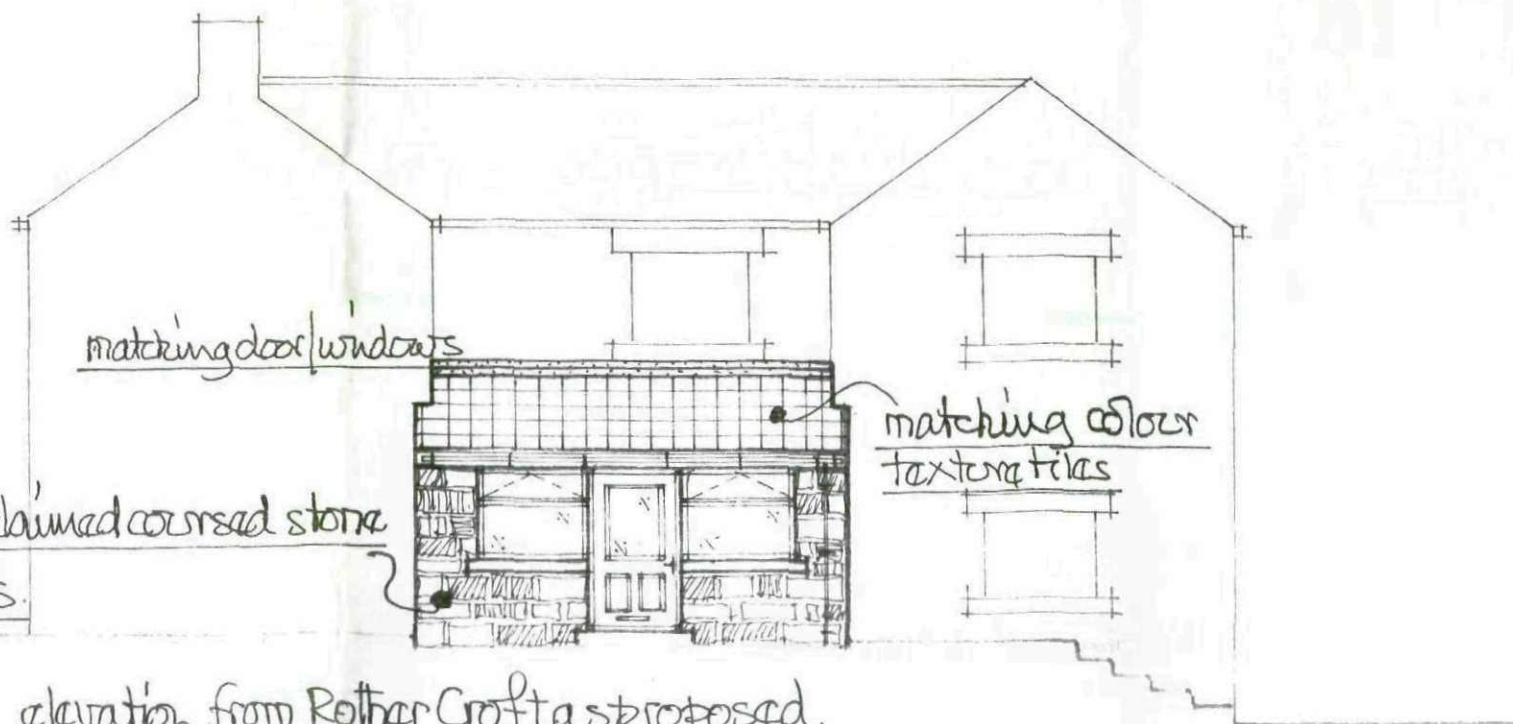

Ground floor layout.

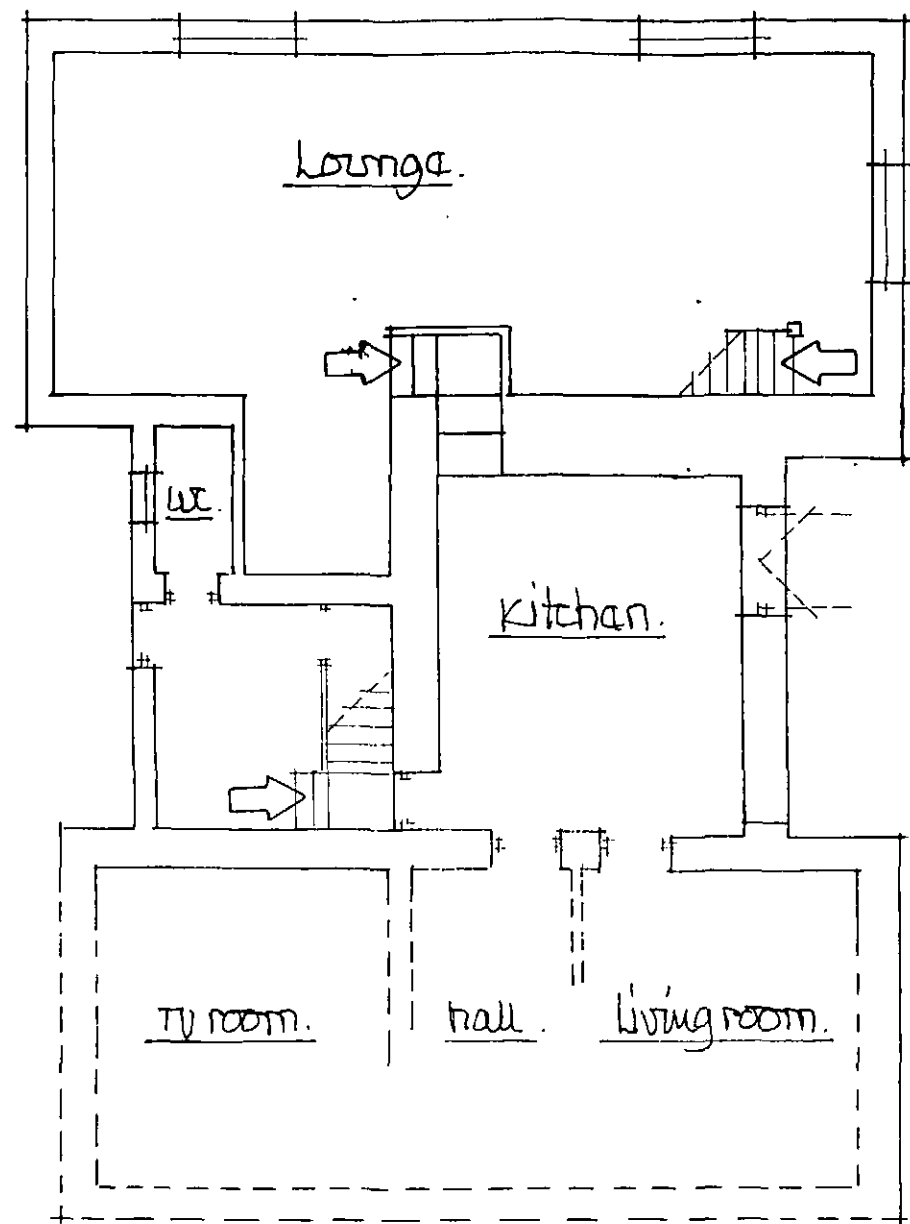


elevation from Rotharcroft.


* note the existing two storey ext'n on site is shortly to be replaced by the two storey ext'n shown in red - facing materials are to be reclaimed during demolition *

Scale 1:100m.


* previously approved ext'n to be commenced shortly after existing has been demolished *

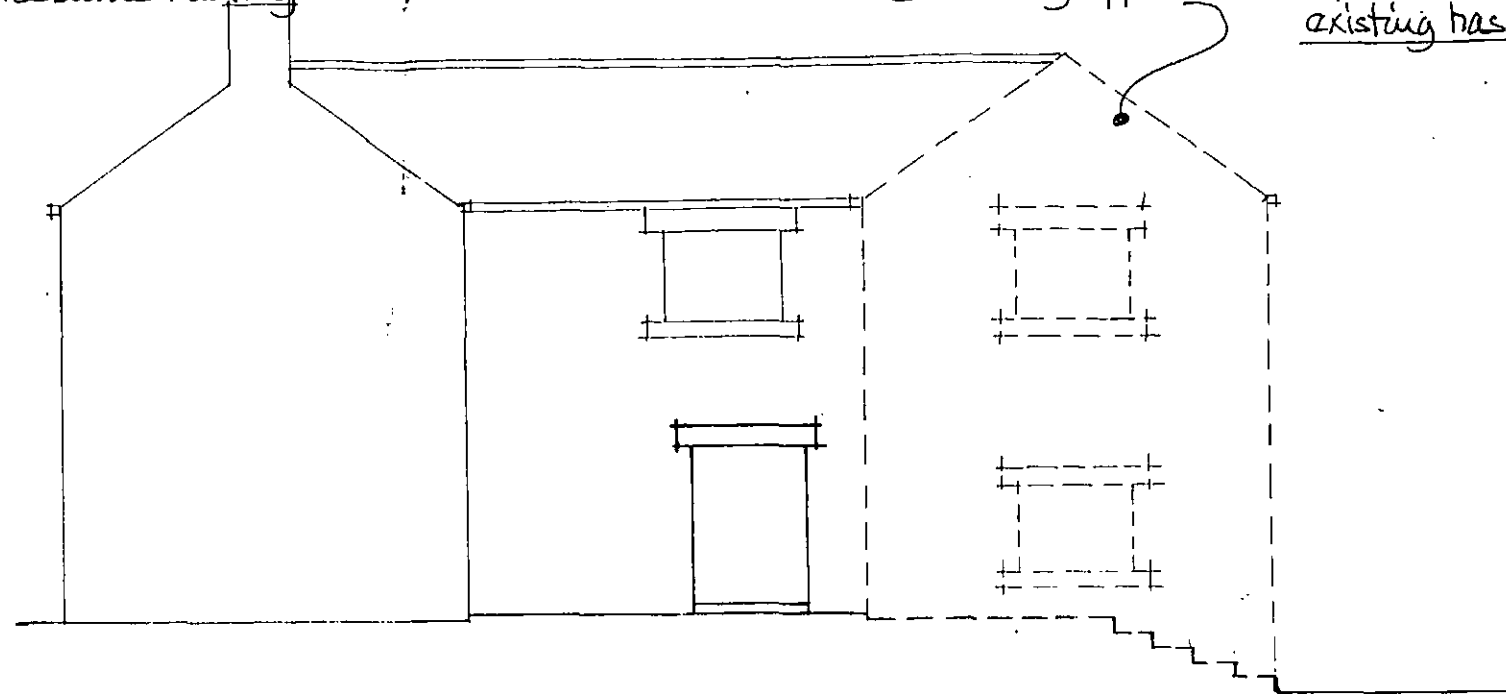

side projection from rear garden.

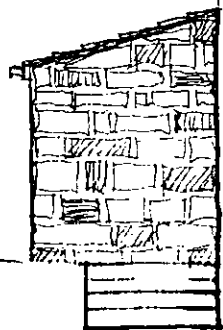

side projection from front garden.

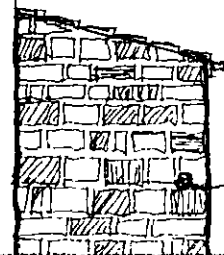

matching reclaimed coursed stone walls + cills

matching door/windows

matching colour textured tiles

elevation from Rotharcroft as proposed.

