



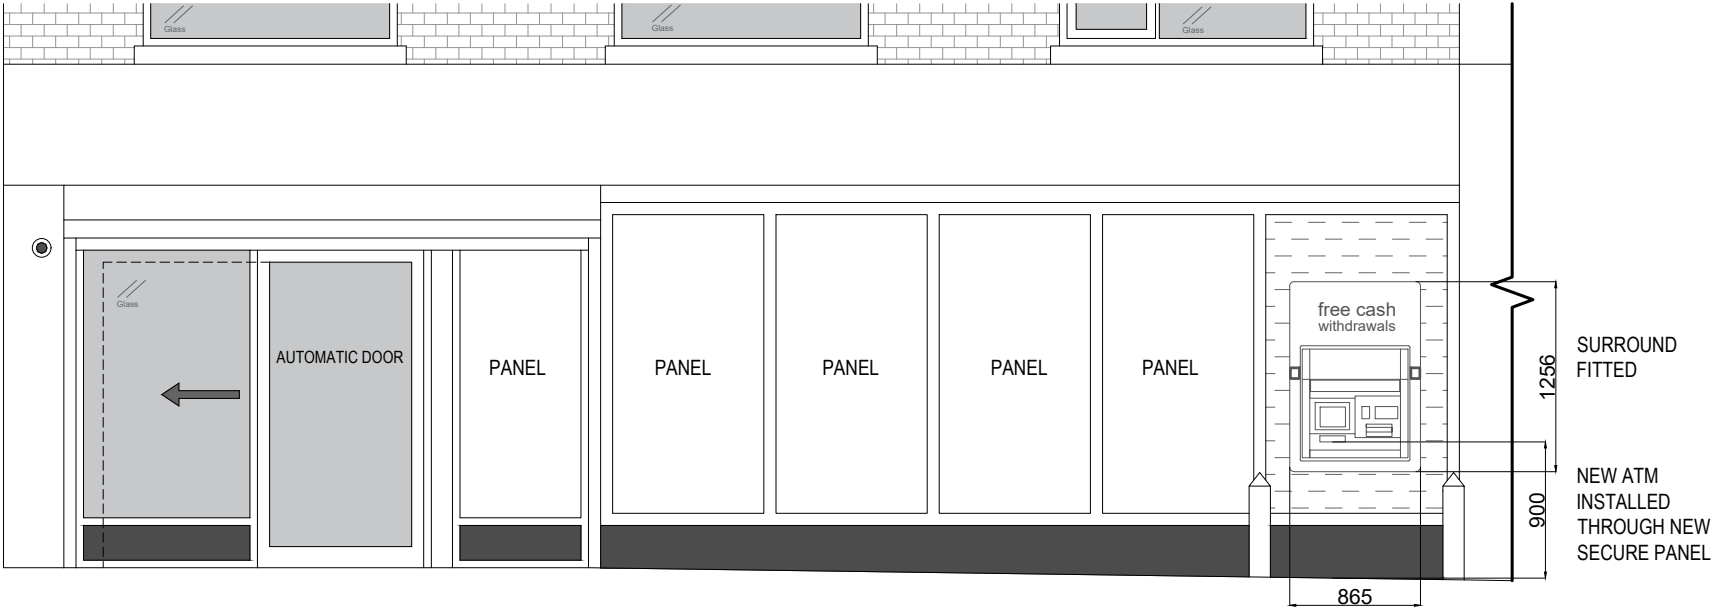

AS-INSTALLED FRONT ELEVATION

Scale 1:50

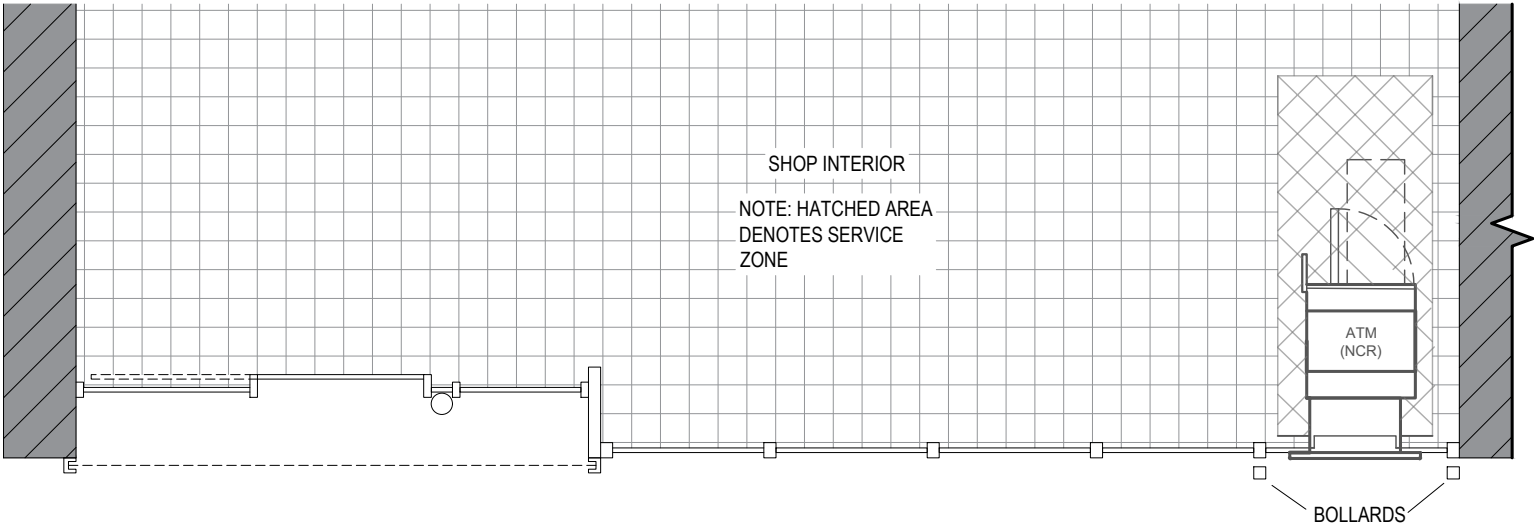

AS-INSTALLED PART PLAN

Scale 1:50

Date: Comments: By:

GENERAL NOTES:
1) All dimensions in millimeters unless otherwise stated.

Site:
One Stop Royston,
125-127 Midland Road,
Royston,
Barnsley

Drawing Title:
As-Installed Plan and Elevation

Ref: 3473483 _AI	Date: 25/06/2019	Rev:
Scale: 1:50	Paper: A3	Date Rev: 06/08/2019