





FRONT ELEVATION






SIDE ELEVATION

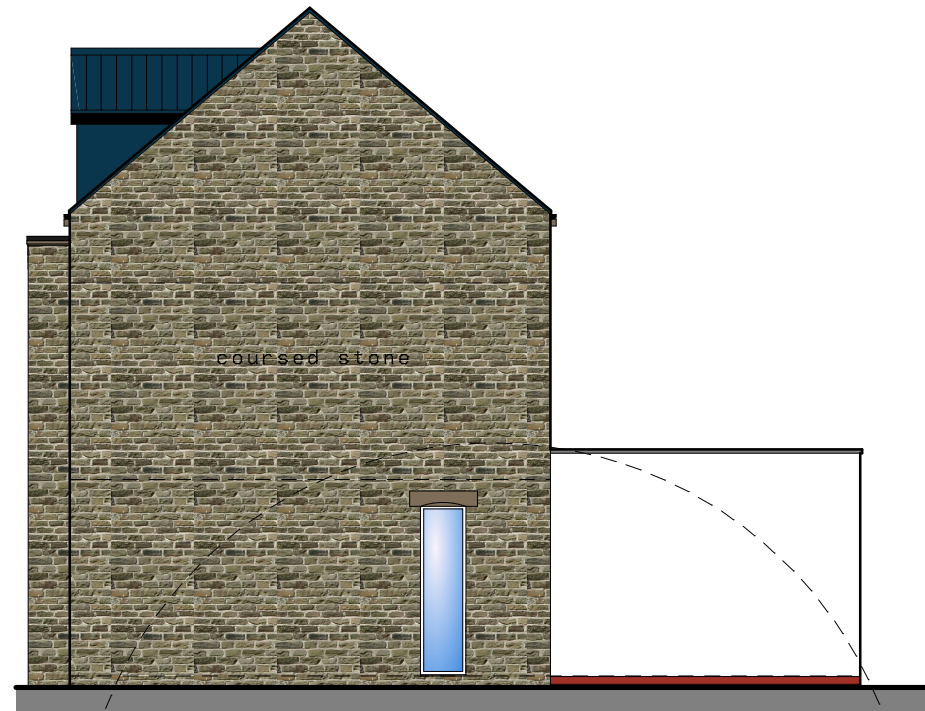



REAR ELEVATION

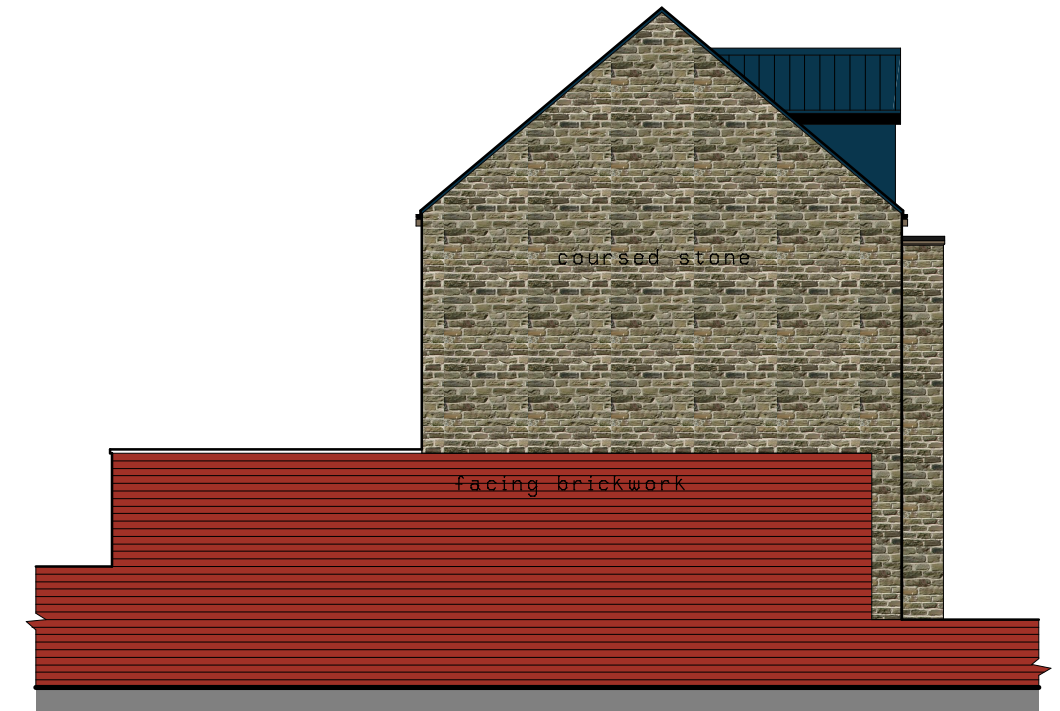


SIDE ELEVATION

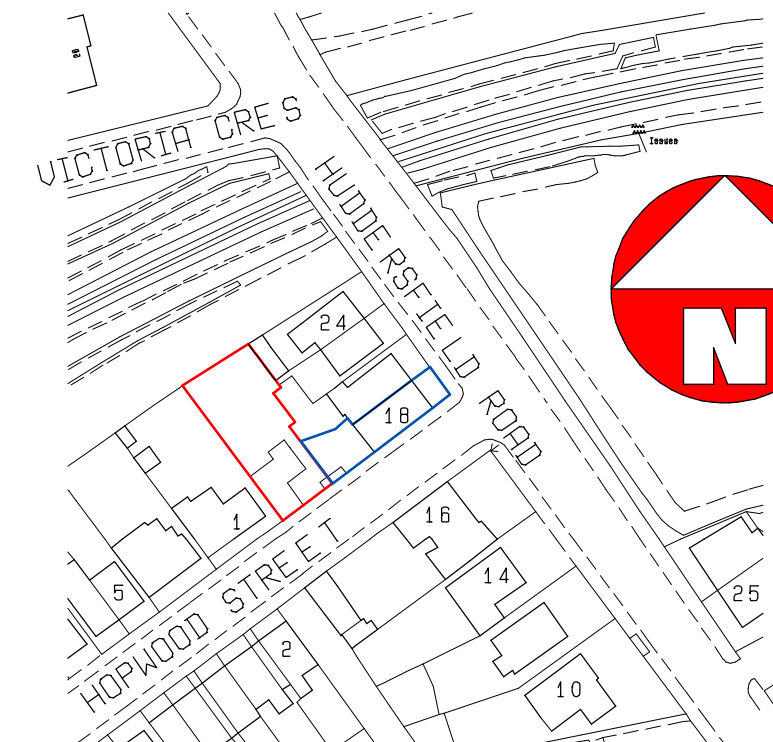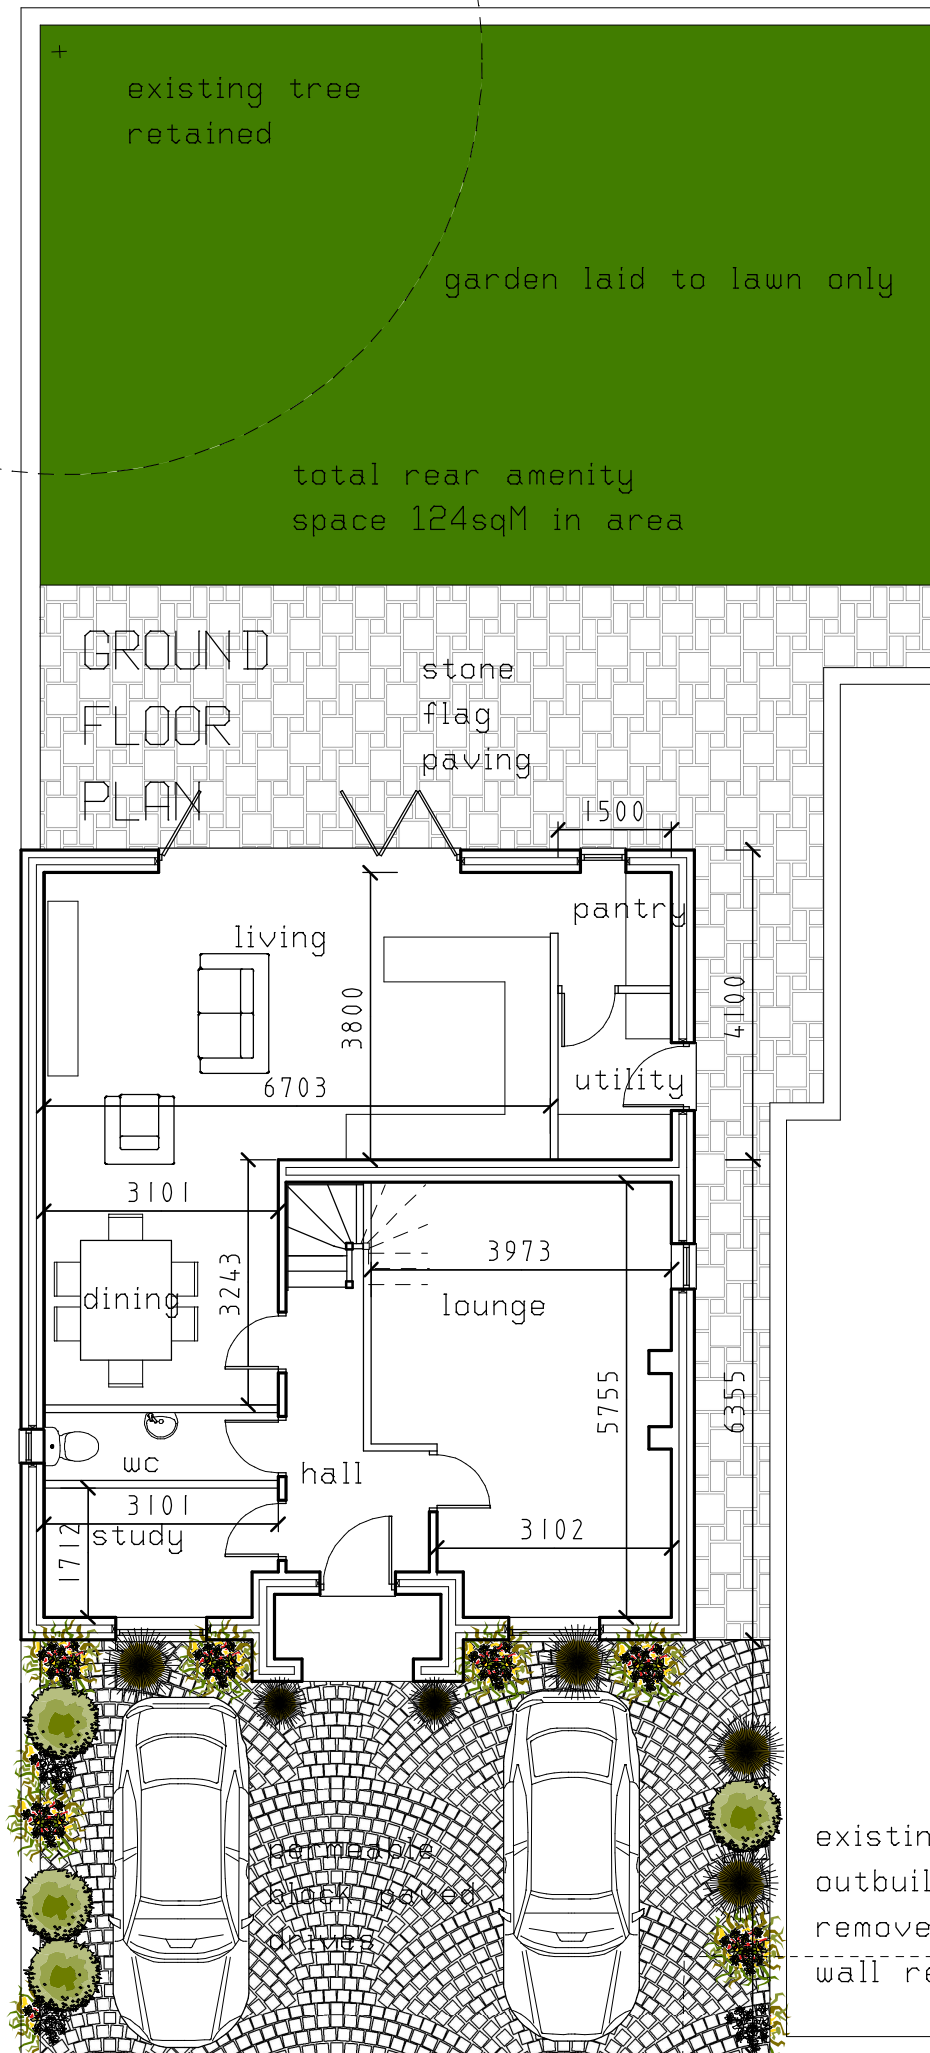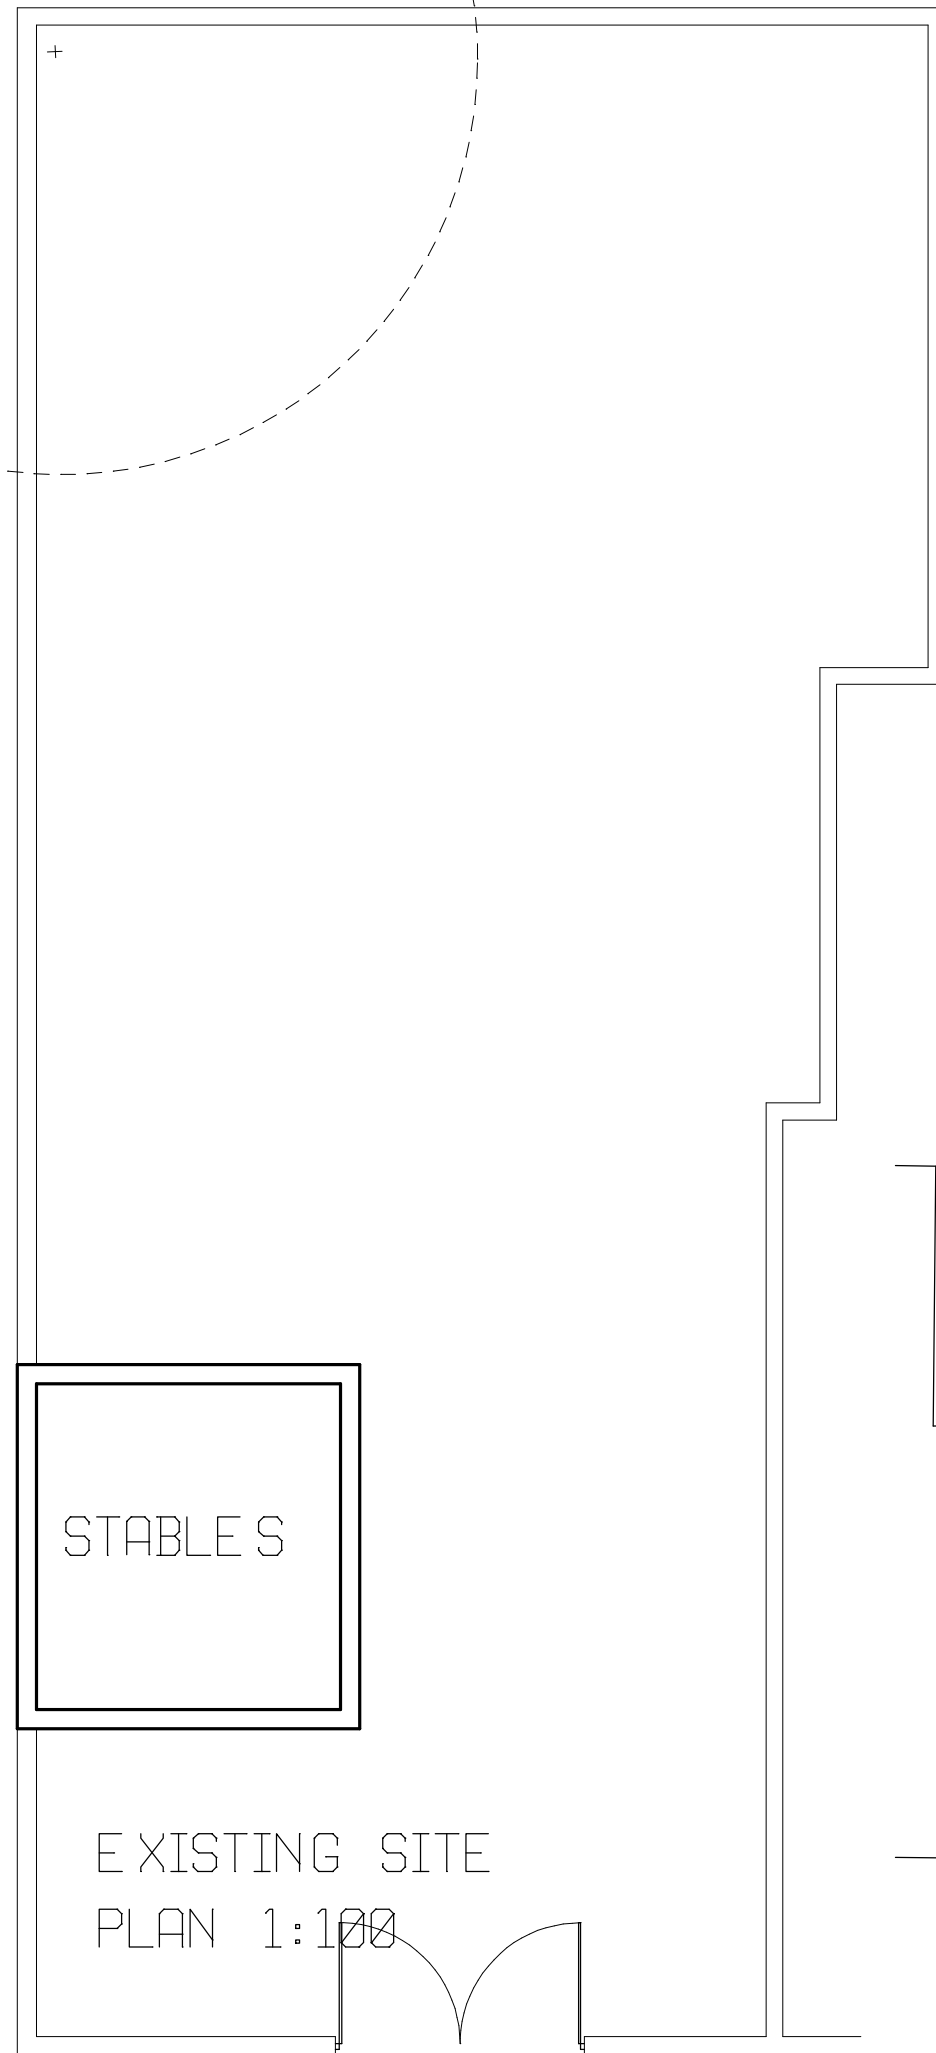


location plan 1:1250

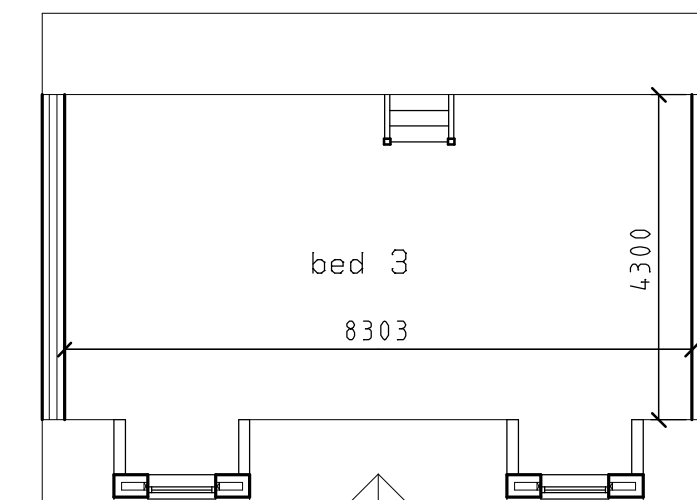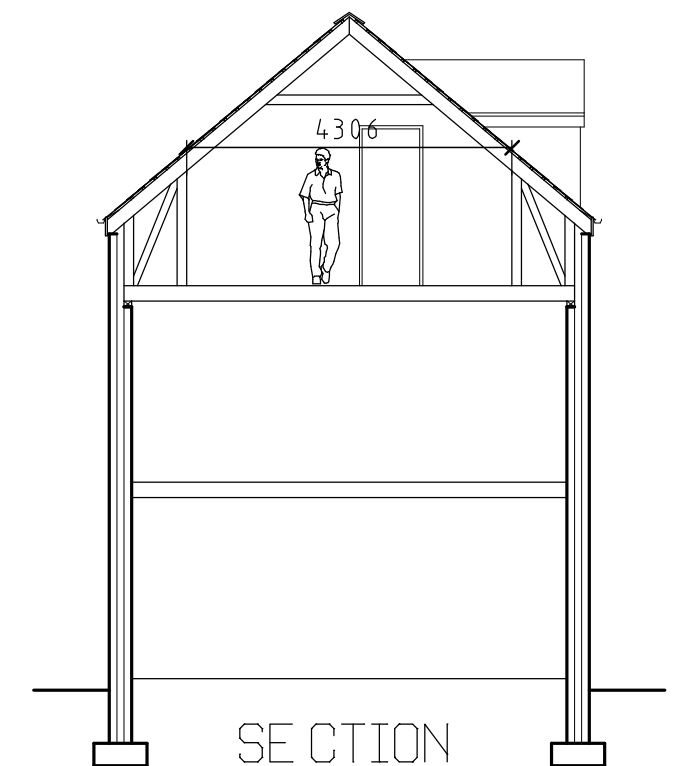

2nd FLOOR PLAN

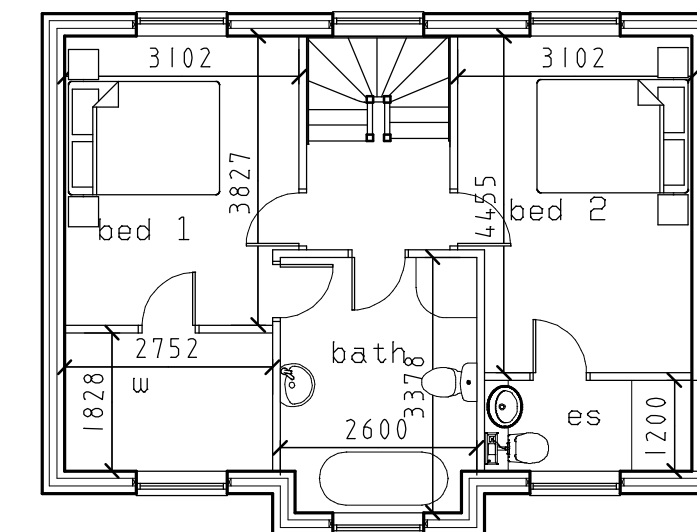

FIRST FLOOR PLAN

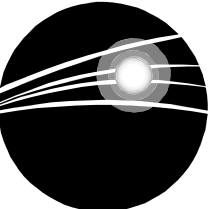CLIENT			MR S MARSDEN		
TITLE					
AS BUILT PLANS					
1A HOPWOOD STREET					
BARNSELEY					
S70 2BW					
					
ANDY CUDWORTH ARCHITECTURE					
The Bungalow Dance Lane Crane Moor Sheffield S35 7AW 07931 365804 andycudworth@yahoo.com					
SCALE		DATE		DRAWN	
1:100		FEB 20		AMC	
DRWG No				REV	
SMHS-220-1				N/A	
This drawing is the sole property of the author (A Cudworth) and will not be used, copied in whole or in part, by any other individual, company or organisation without the consent of the author. All dimensions to be checked on site & not scaled from any drawing.					