
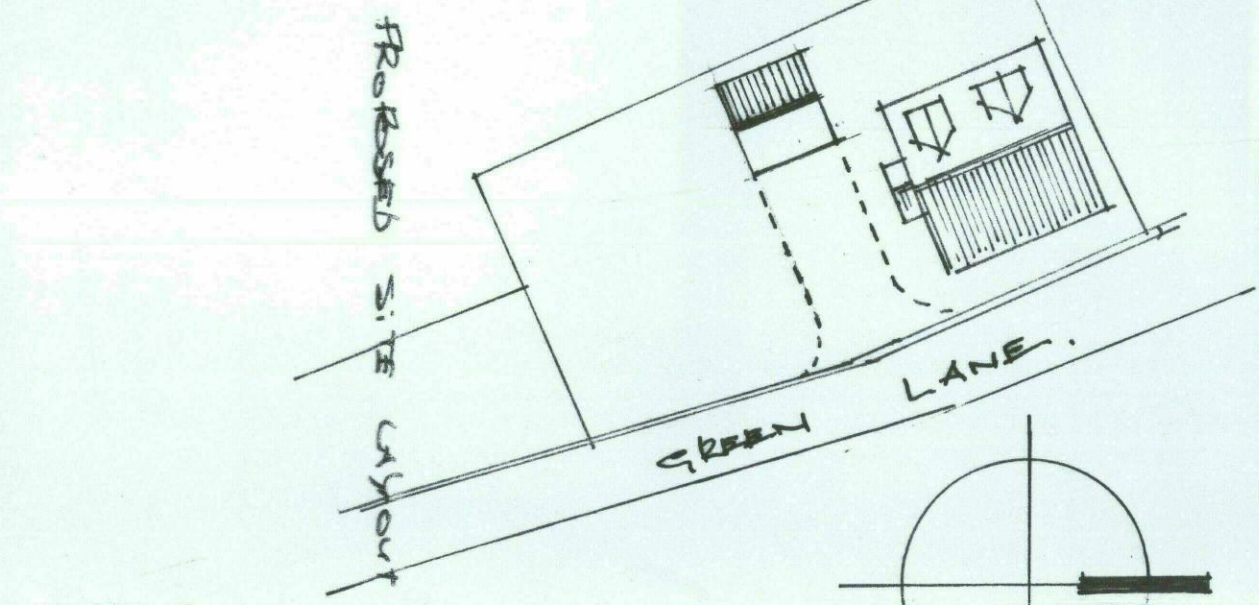
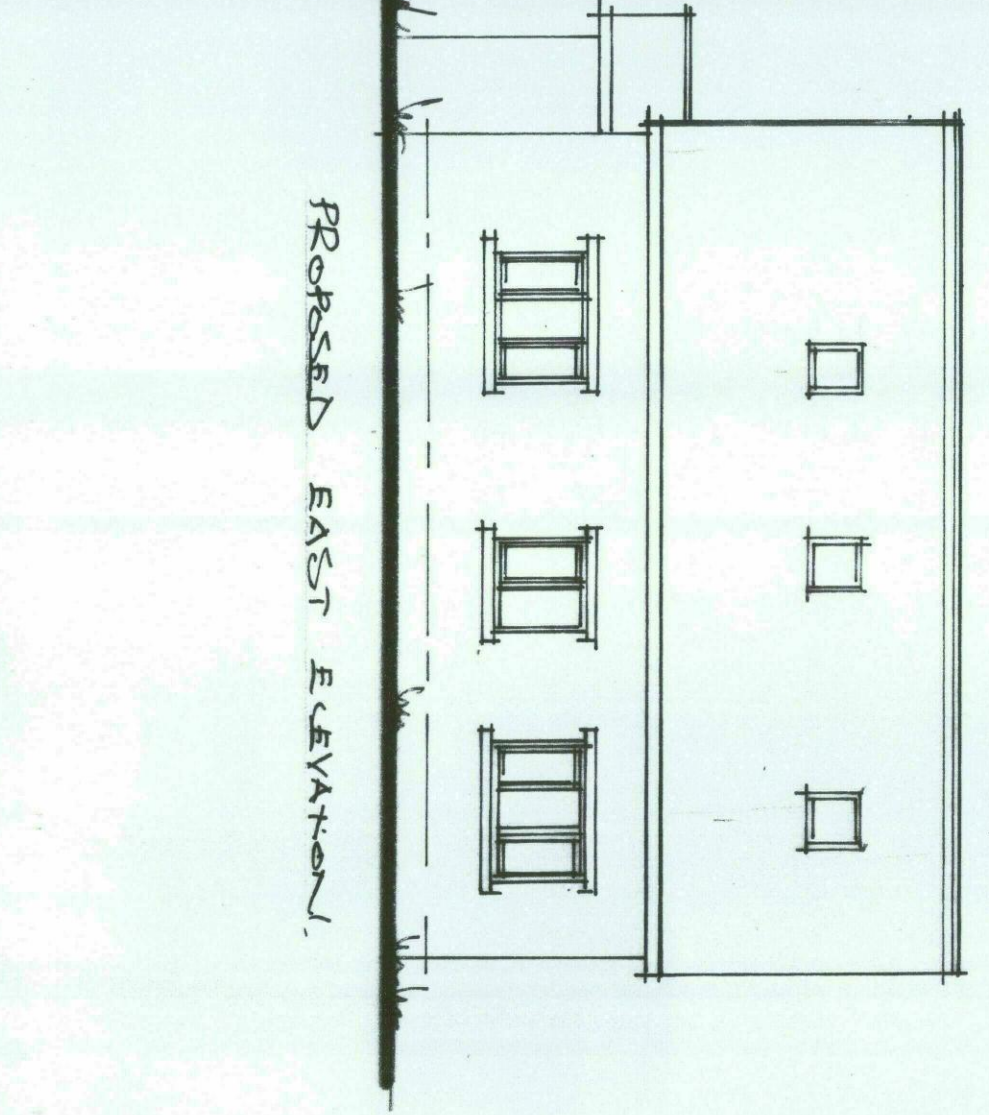
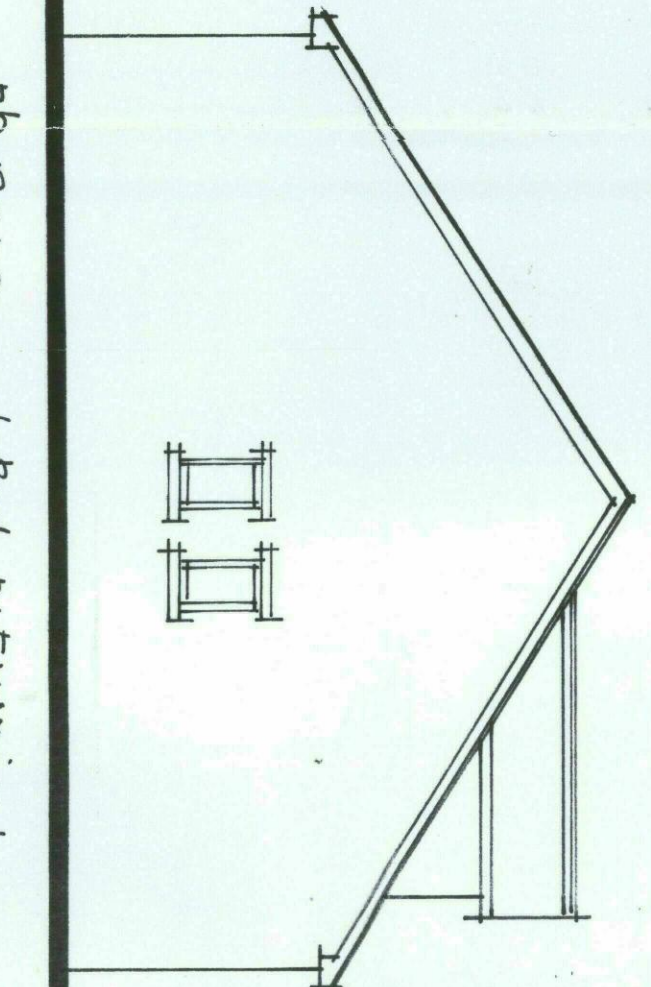
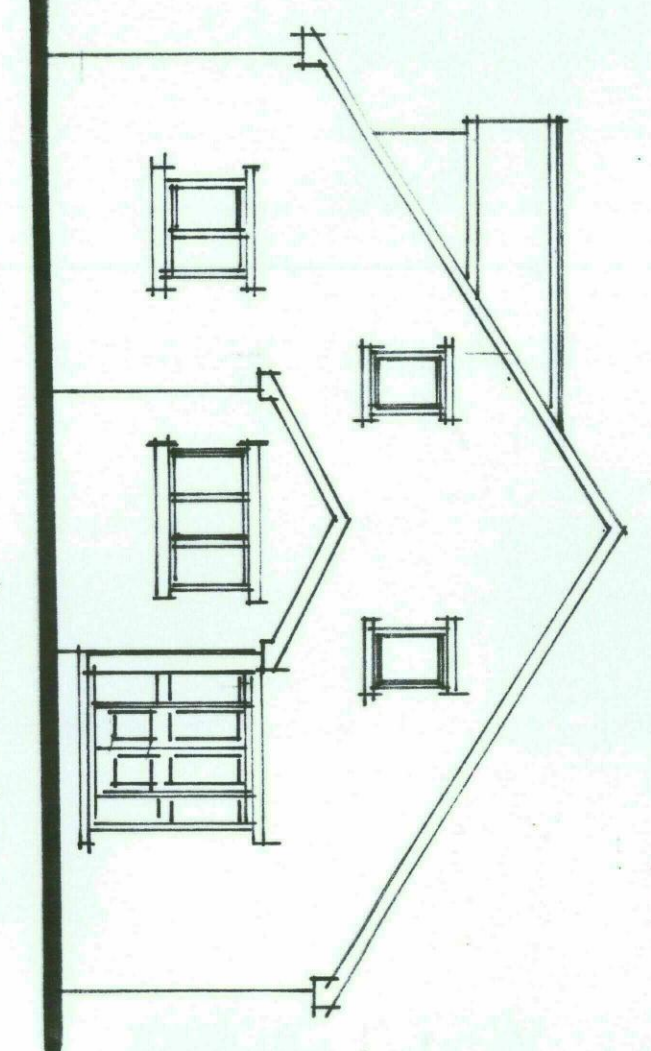
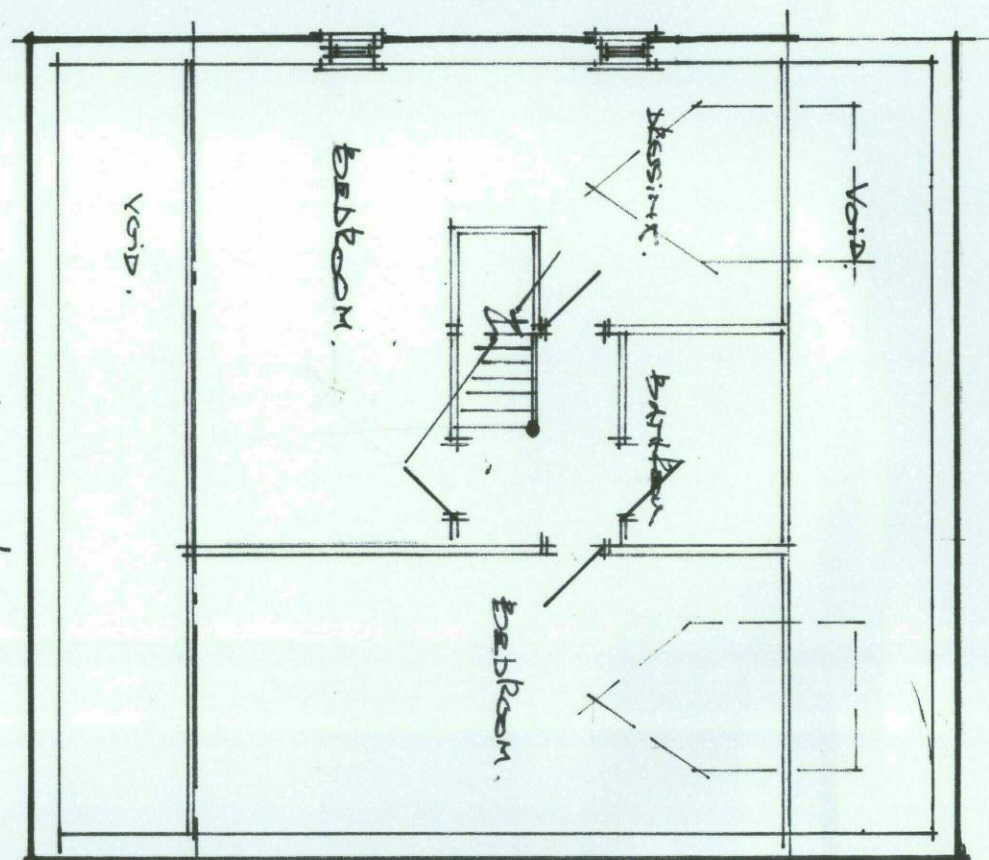
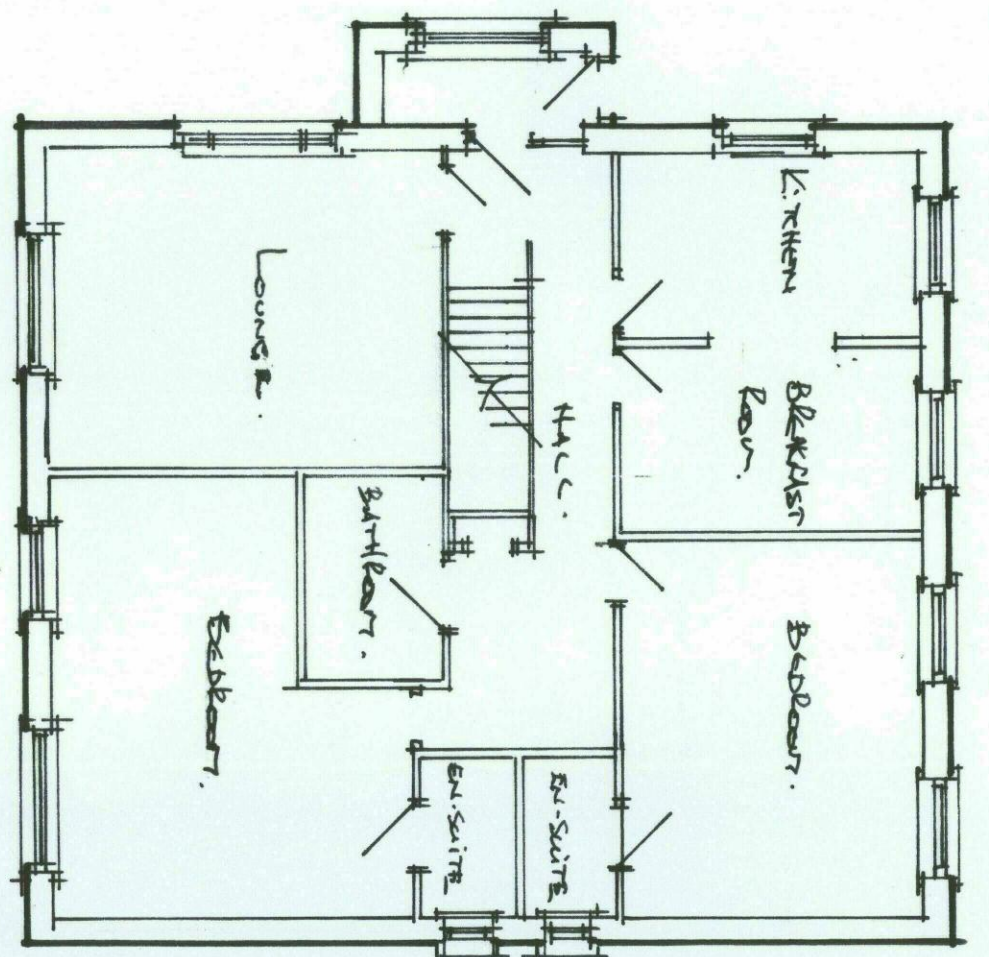
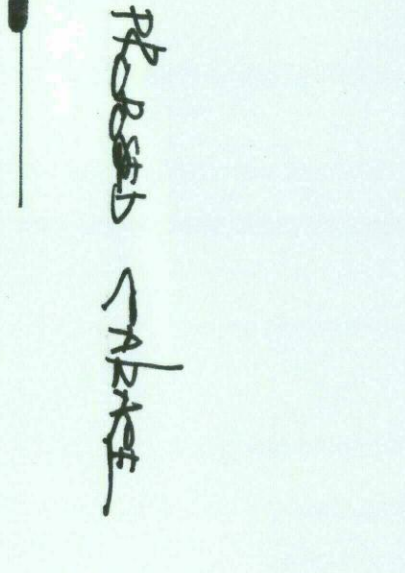
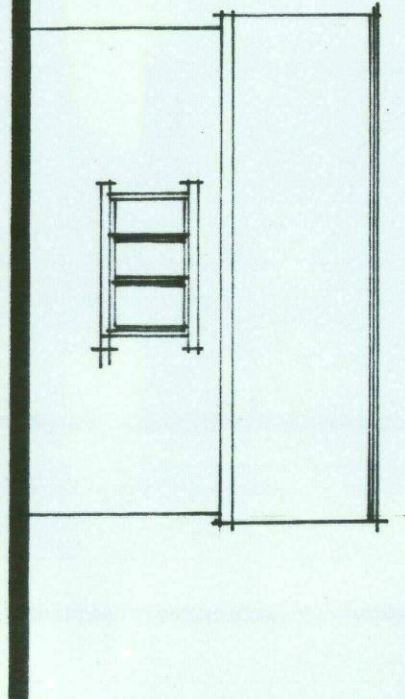
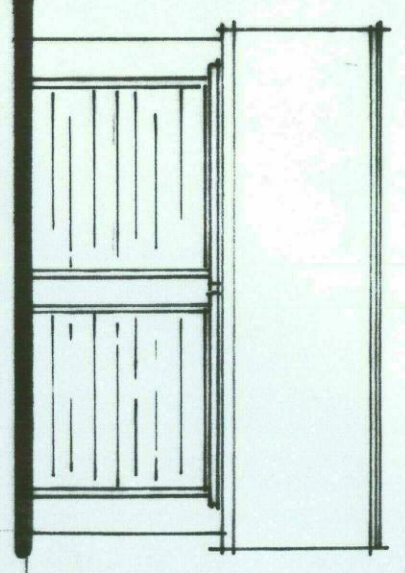
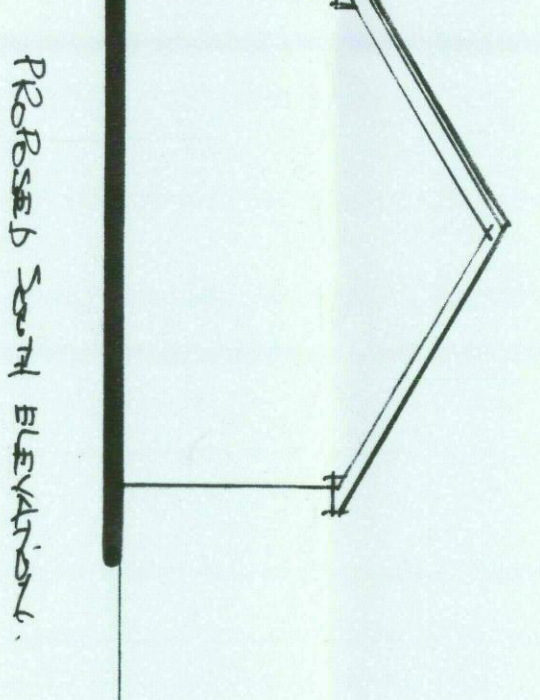
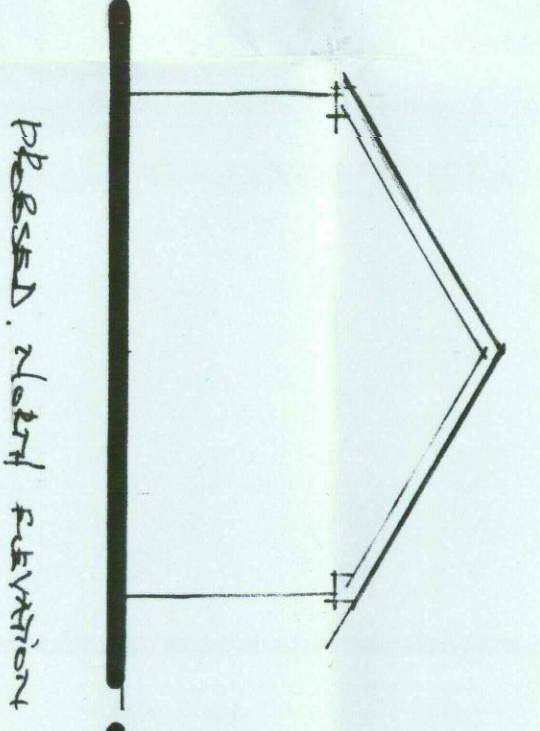
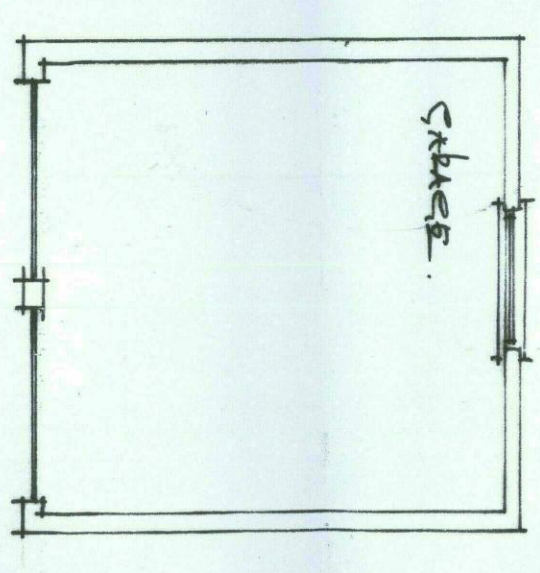
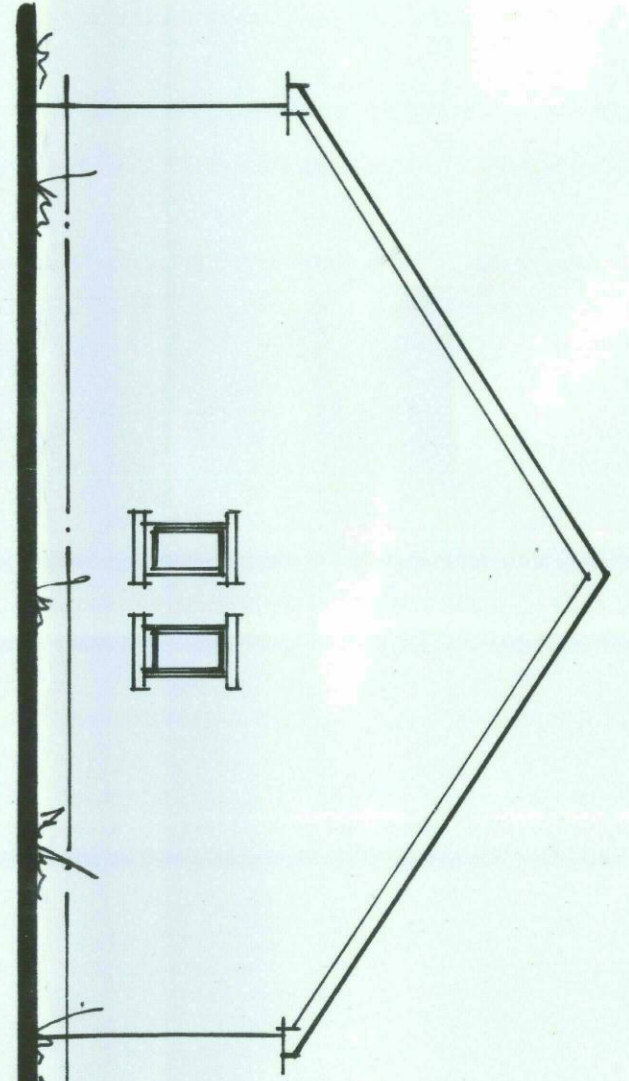
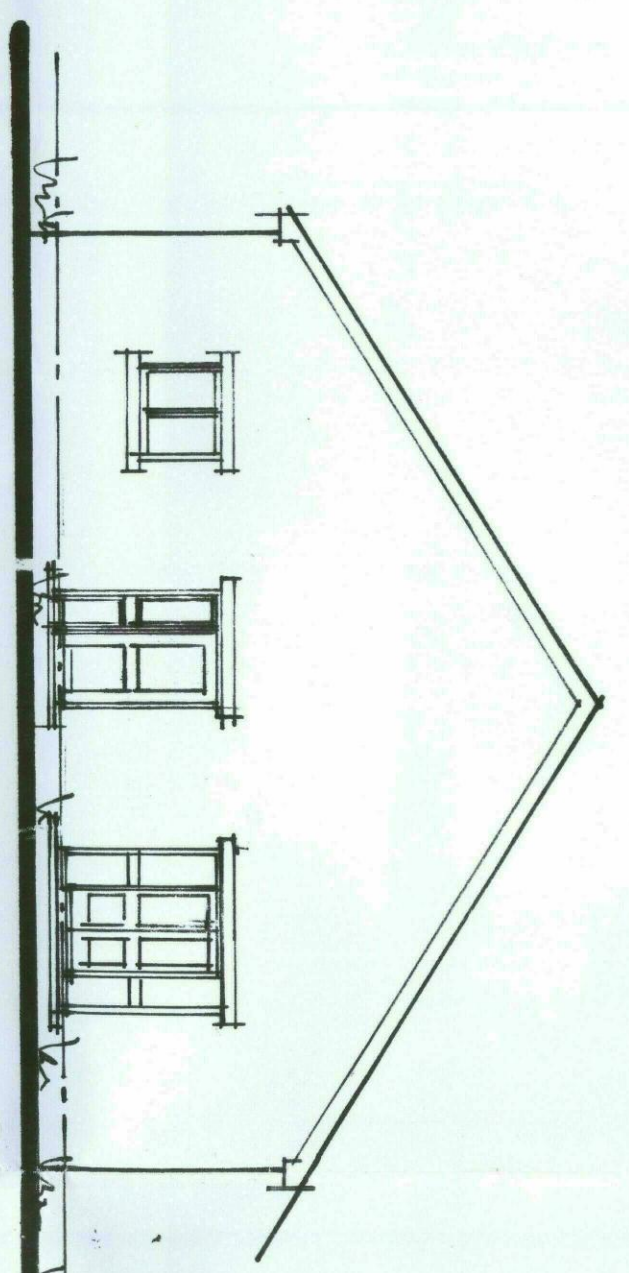
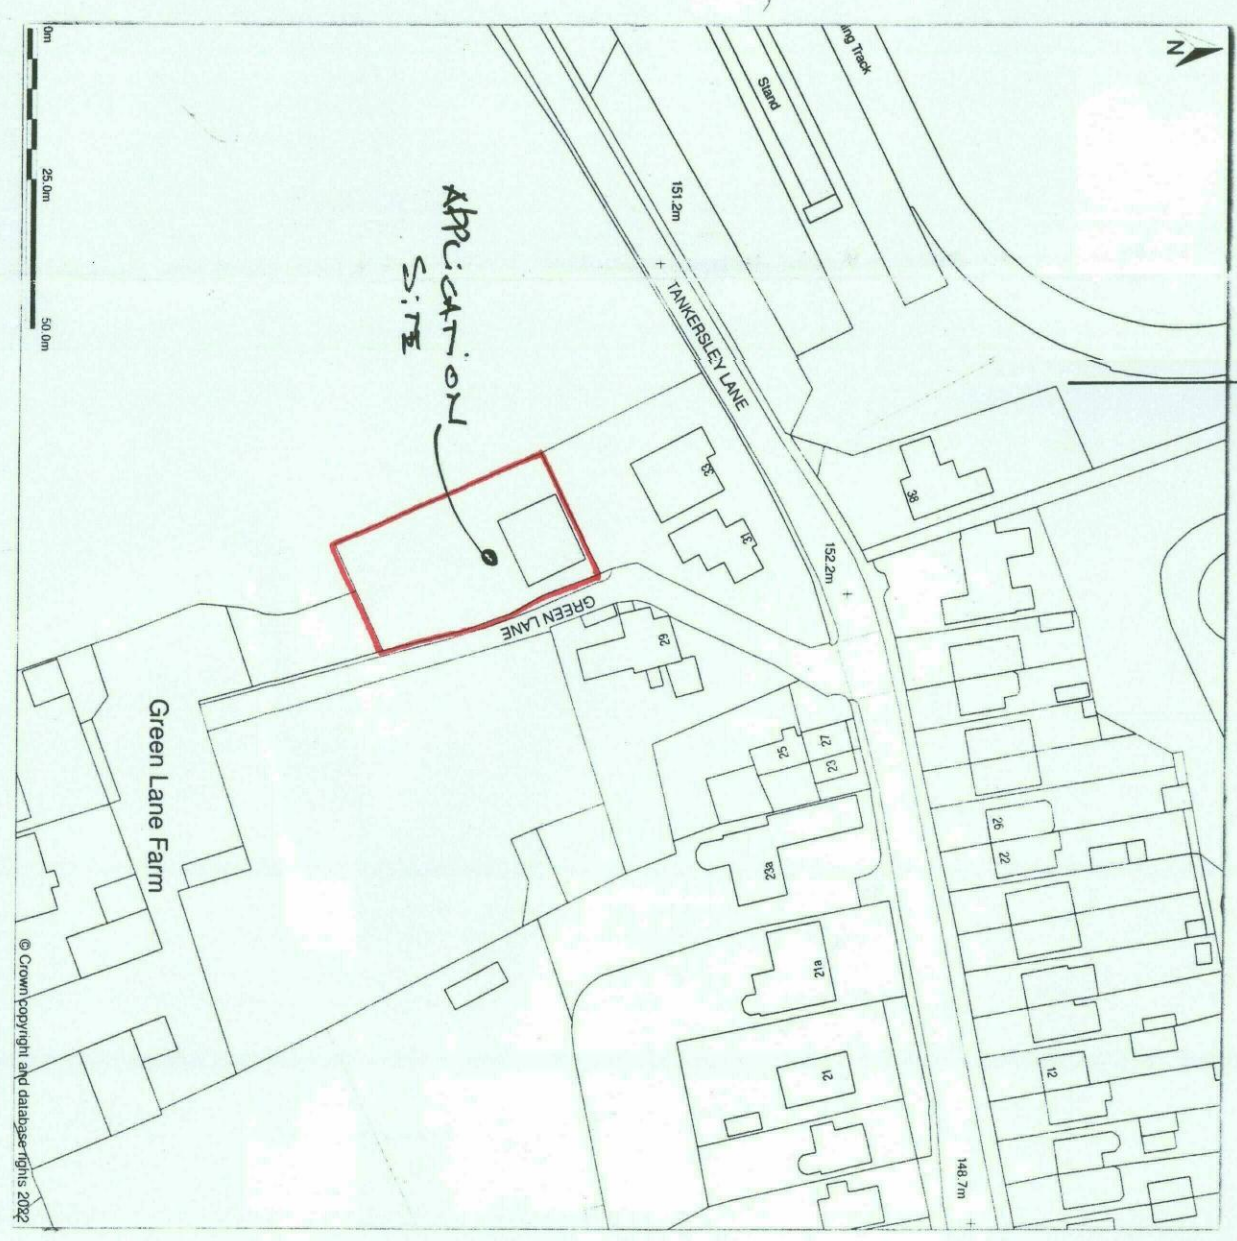


'AS BUILT'

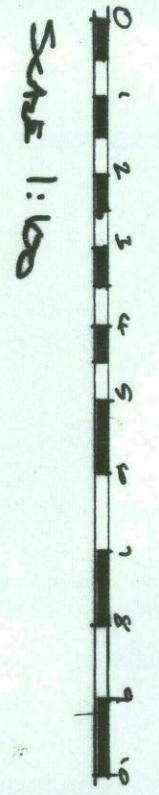

Proposal: Retention of as built dwelling to include the construction of 2 no new dormer windows/rooflights and the erection of a detached garage

Location- Land adjacent 31 Green Lane, off Tankersley Lane, Tankersley, Barnsley, S74 0DT

Location- Land adjacent 31 Green Lane, off Tankersley Lane, Tankersley, Barnsley, S74 0DT

DRAWING NO: PB22/56 drawing no.1 Rev'd.

DATE: June 2022

Plan B Planning & Design Consultant
12 Chestnut Drive
HOLME ON SPALDING MOOR
Nr York
YO43 4HW
Tel: 01430 860632 Mob: 0781 4009227