



Revision	Date	By	Chk.
A	North point amended	25.11.27	MW
B	New graveled pathway amended and area marked up Area marked up for extended area to the plant	25.12.17	MW



- Ownership Boundary
- Planning Boundary
- - - Downtakings/Removals

Do Not Scale Dimensions from Drawings.  
All dimensions to be verified on site, and any discrepancy to be notified to the Architect.

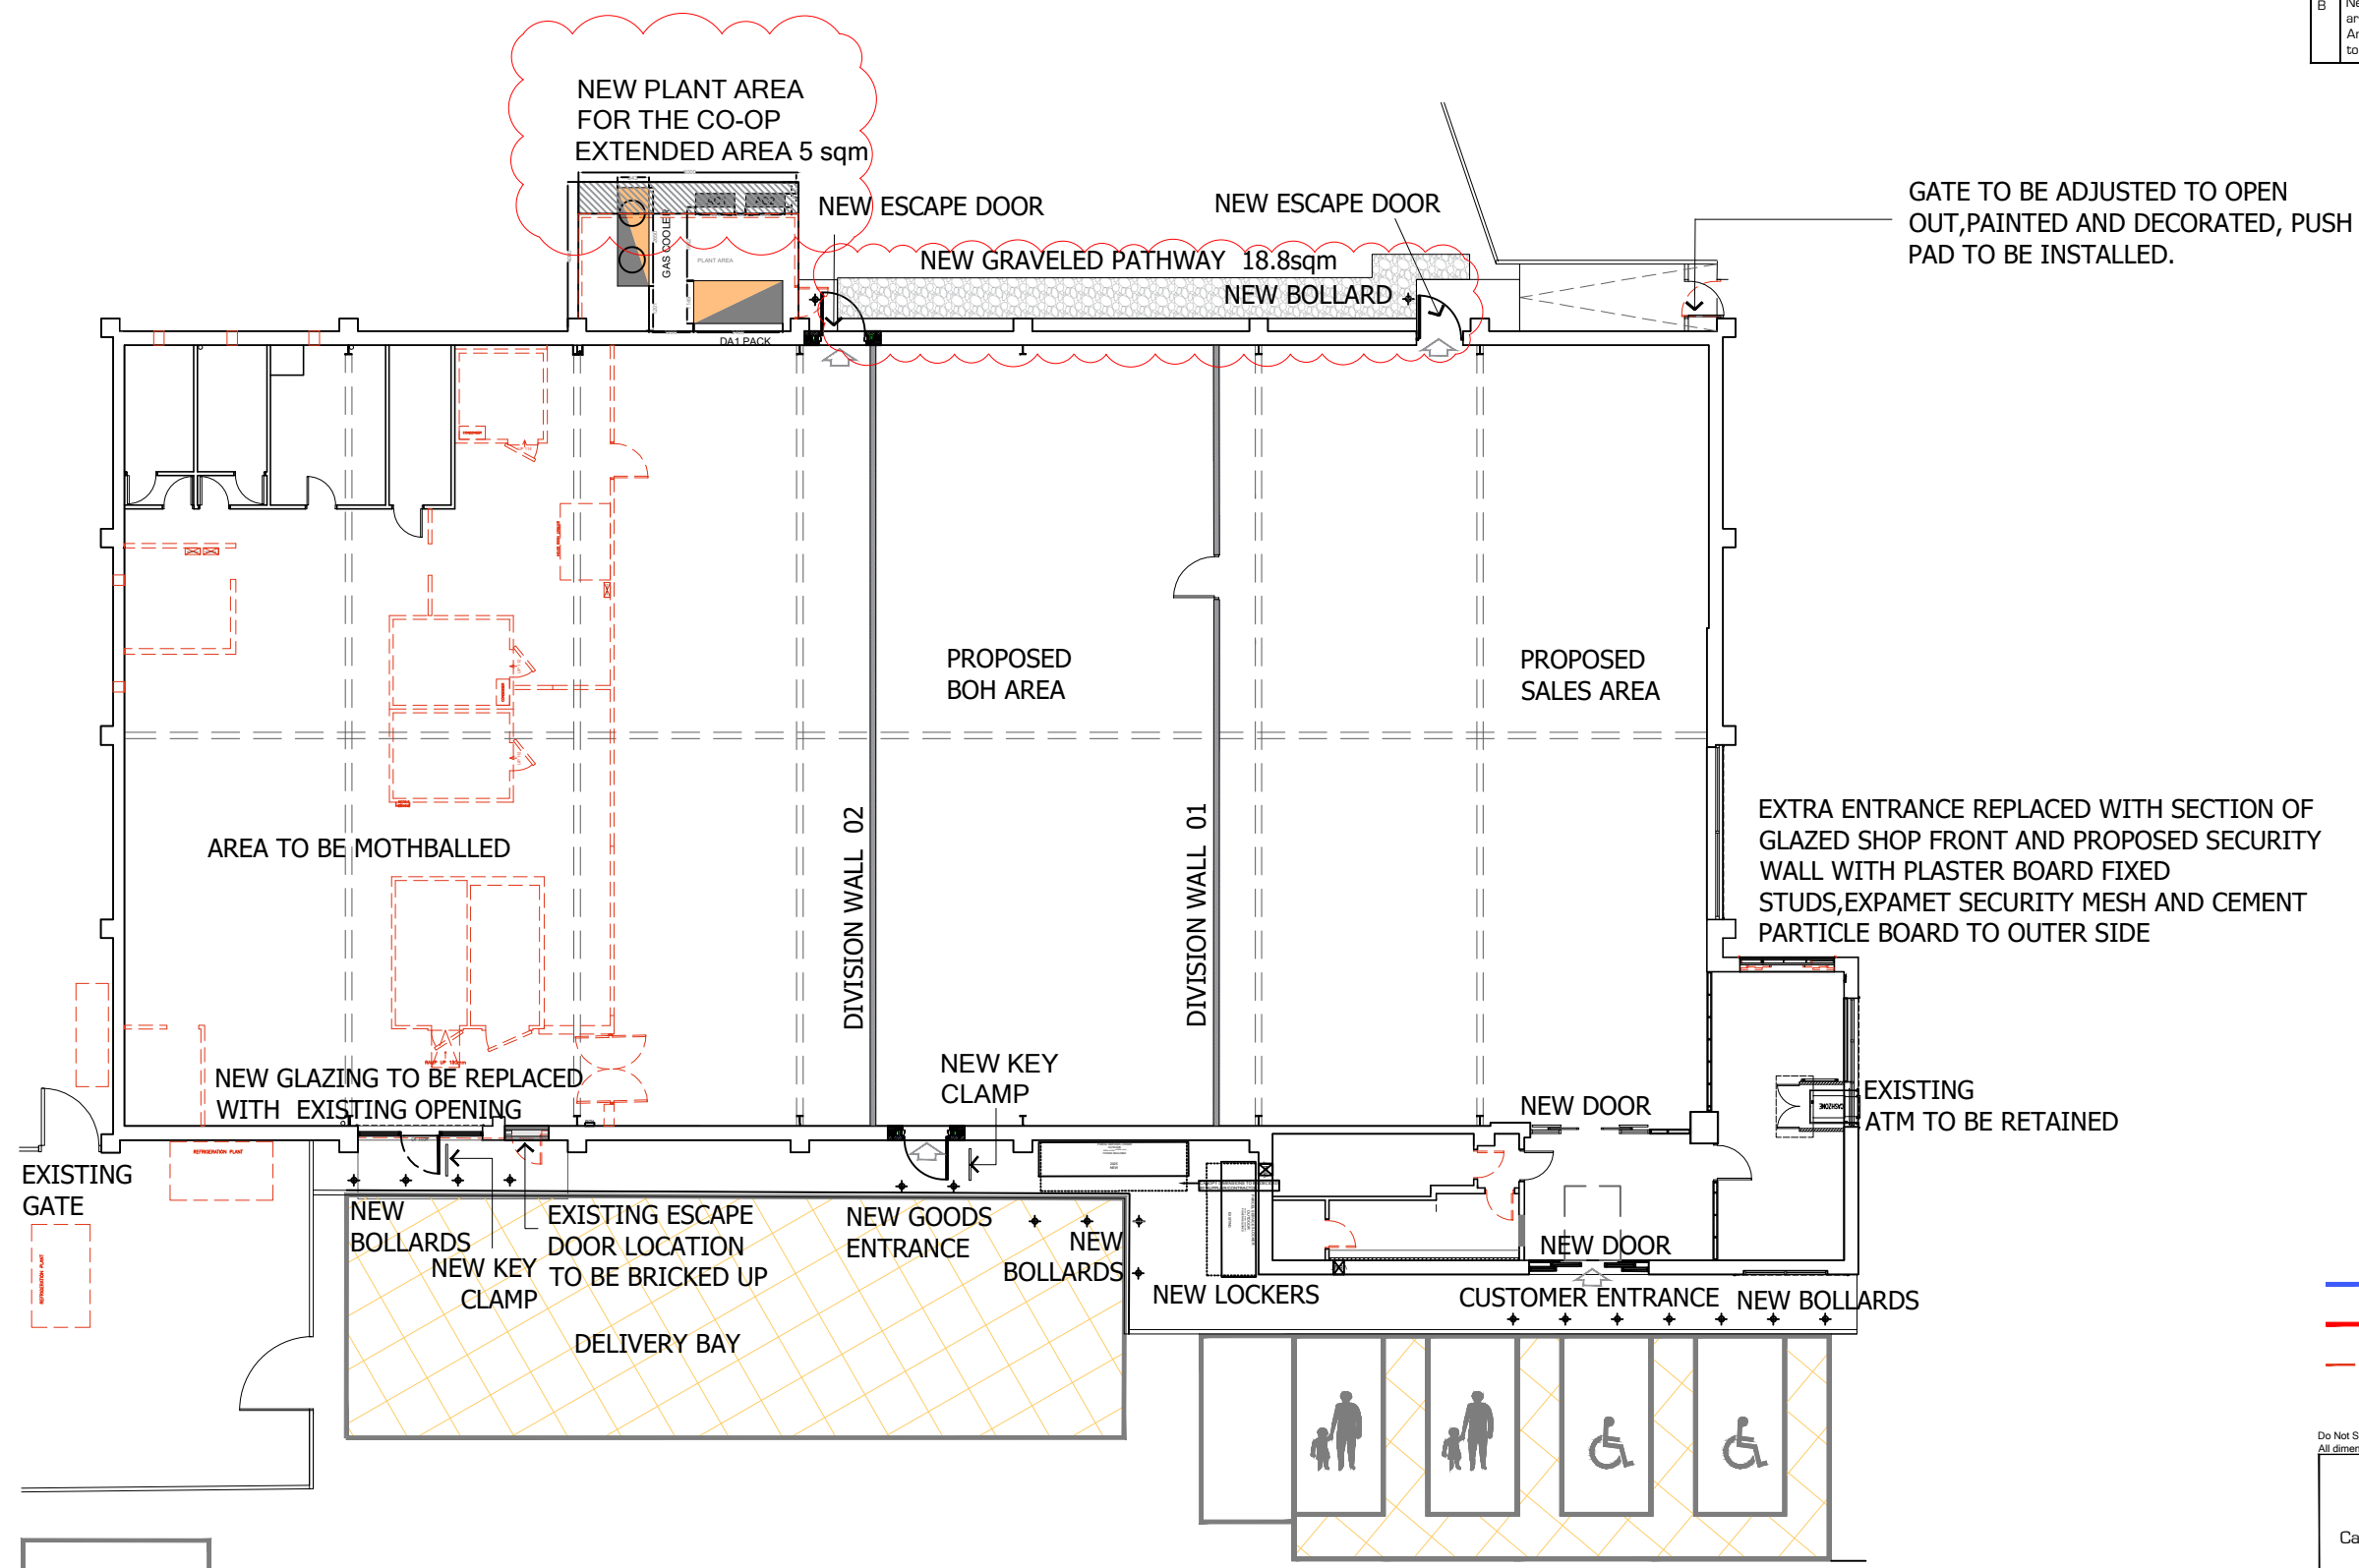

**AMCA ARCHITECTS**  
Castlecroft Business Centre Tom Johnston Road  
Dundee DD4 8XD  
T: 01382 774111 F: 01382 739382  
mail@amcaarchitect.co.uk

Drawn by MW	Date NOV2025	
Checked by -	Scale 1:200@A3	
Job High Street Royston South Yorkshire S71 4RF		
Drawing PROPOSED BUILDING PLAN		
Co-operative Proj No. 0000	AMCA Job No. 4170	
CAD Ref: 4170_Royston_construction.dwg		Rev. B



**PROPOSED BUILDING PLAN - SCALE 1:200 @A3**