


Date:	Comments:	By:
-------	-----------	-----

GENERAL NOTES:
1) All dimensions in millimeters unless otherwise stated.

Site:
Globus,
18-20 Doncaster Road,
Barnsley,
S70 1TH


Drawing Title:
As-Installed Plan and Elevation

Ref:	Date: 31/05/2018	Rev:
Scale: 1:50	Paper: A3	Date Rev:

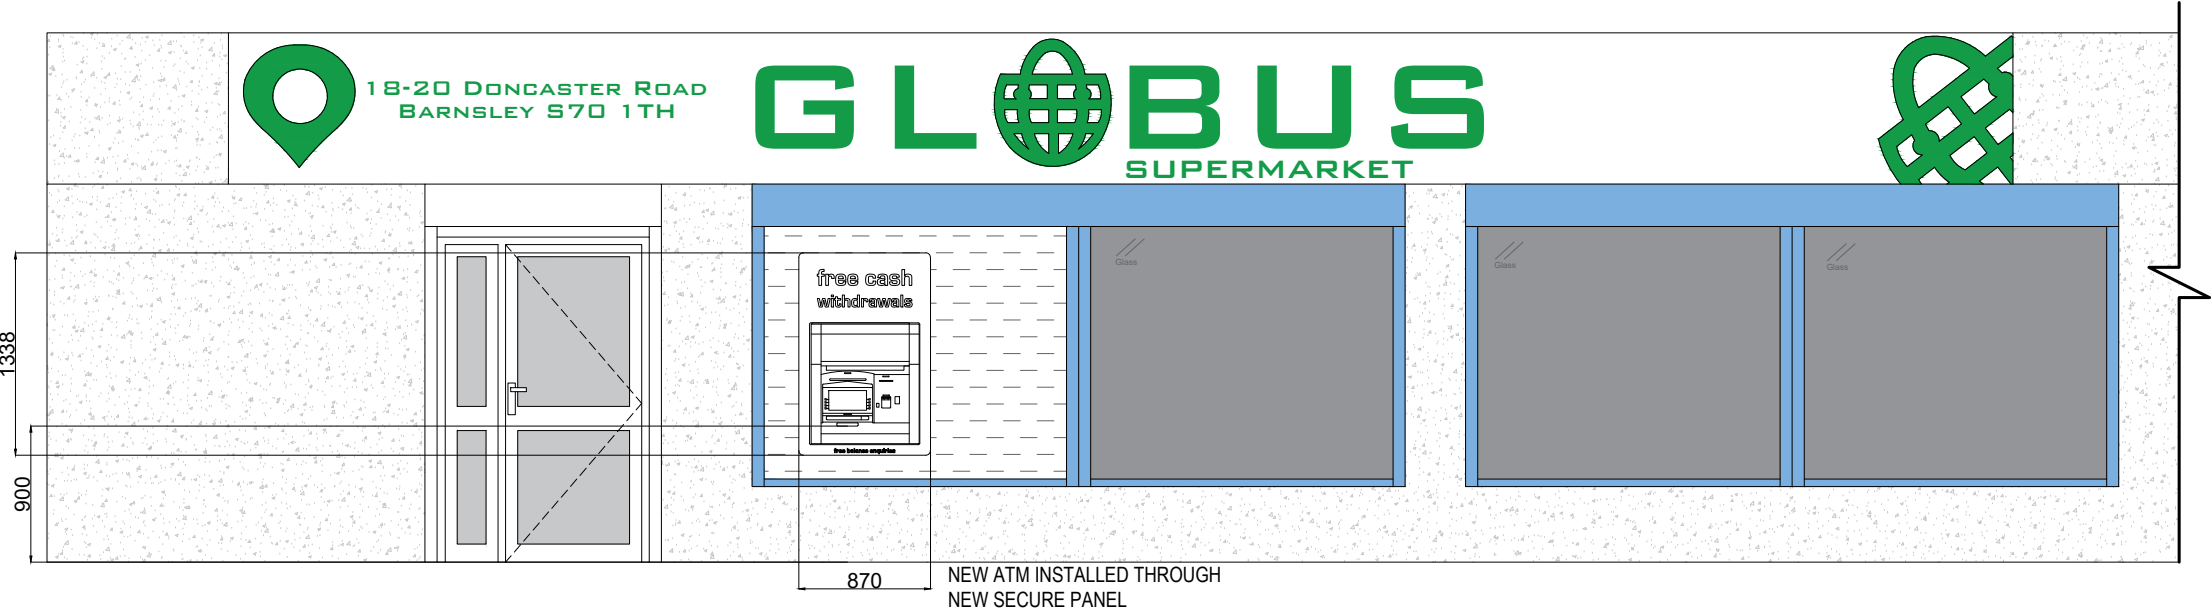

AS-INSTALLED FRONT ELEVATION

Scale 1:50

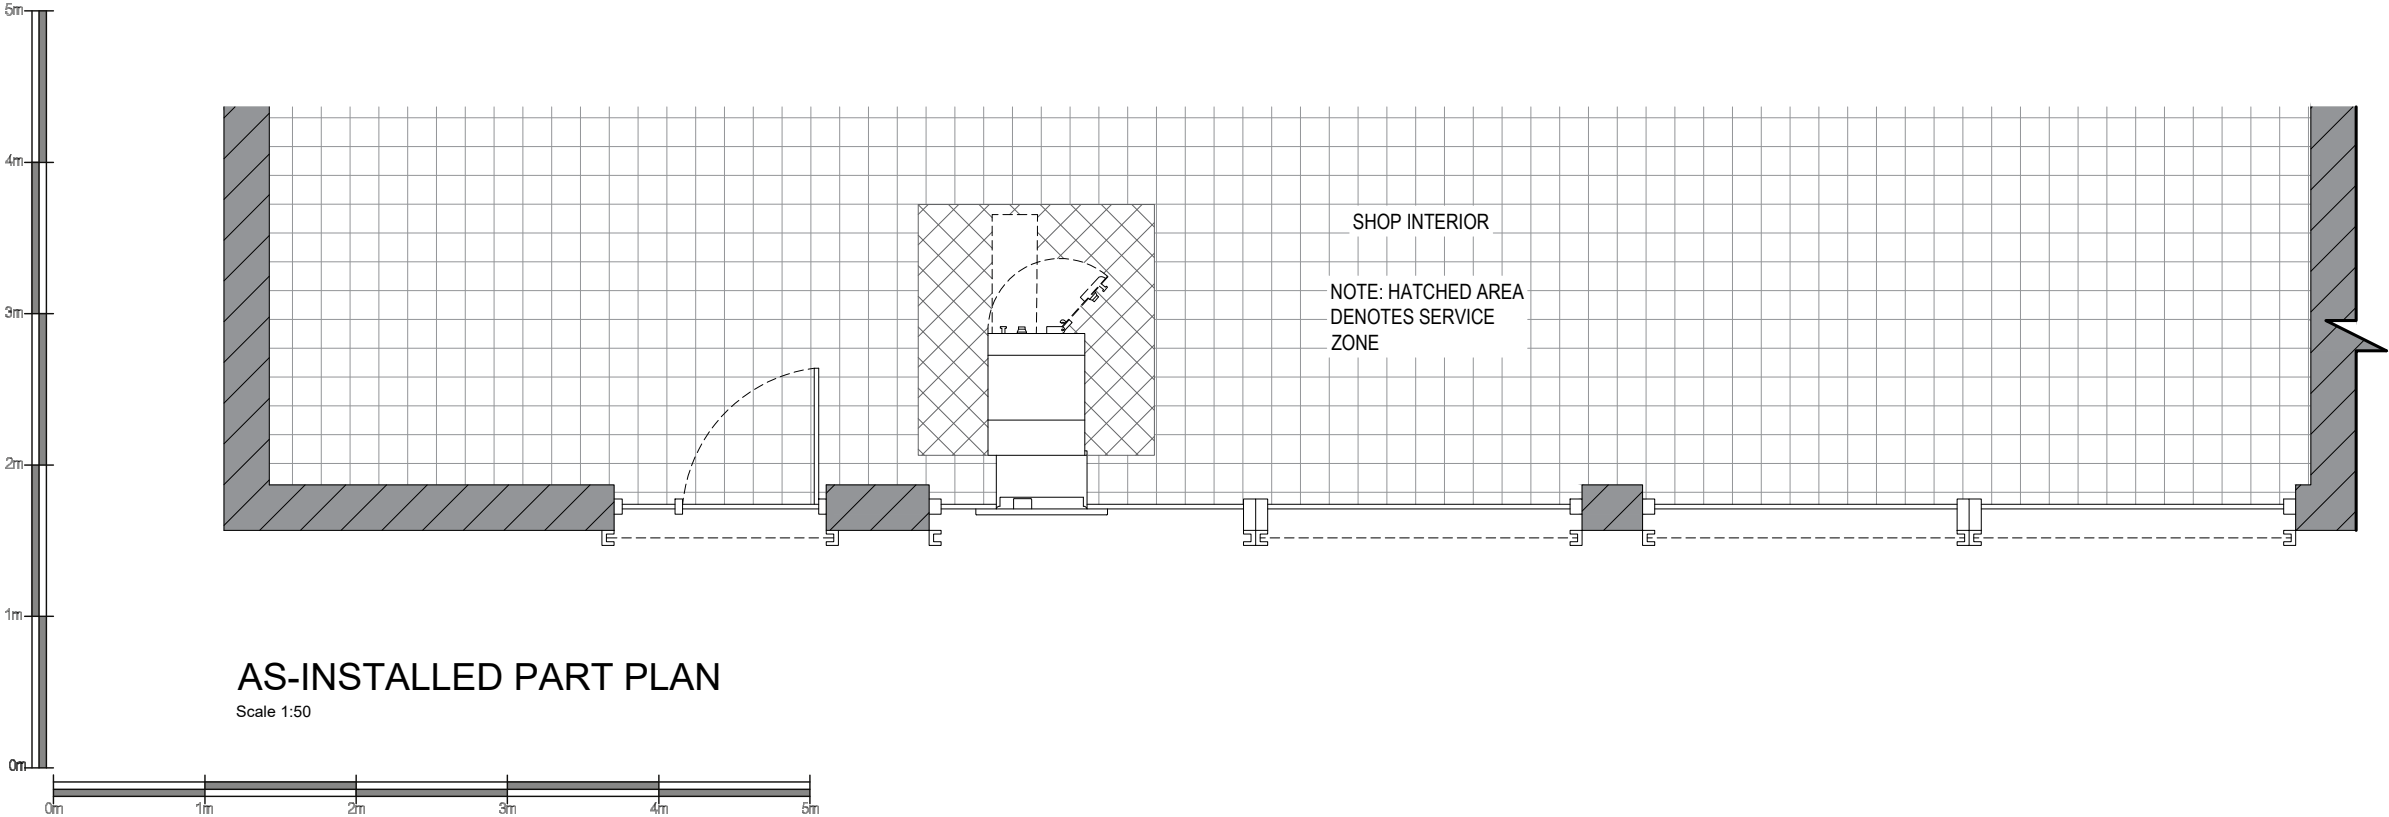

AS-INSTALLED PART PLAN

Scale 1:50