



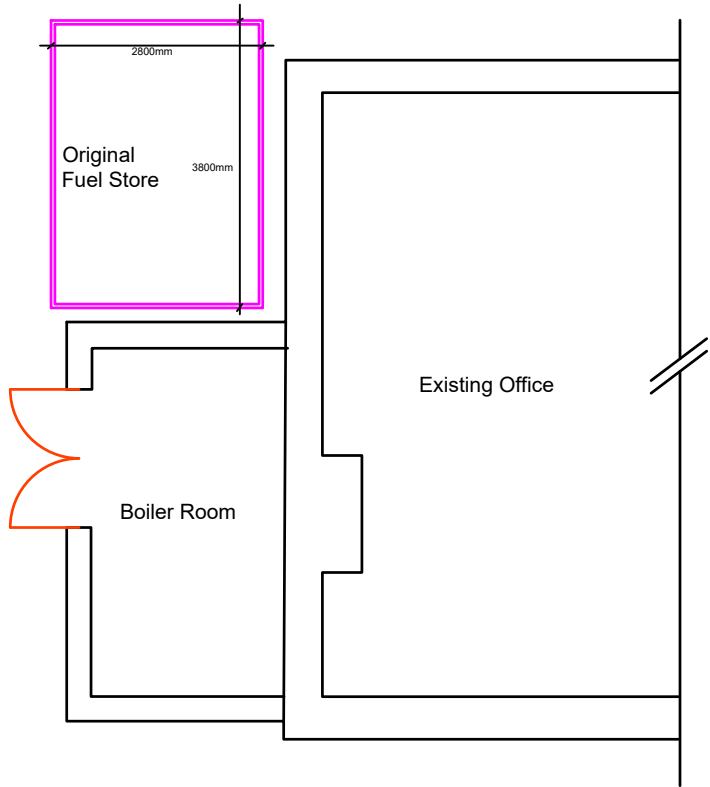

Original Fuel Store

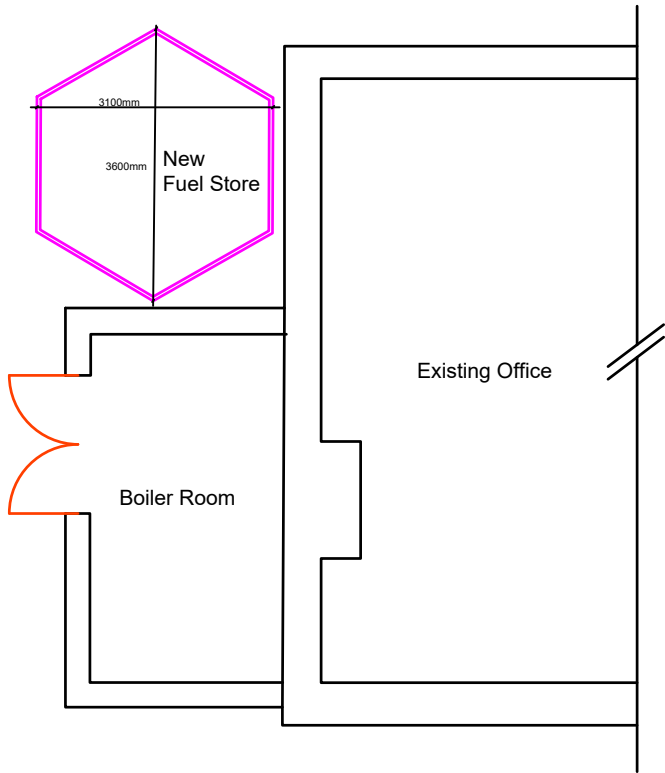

New Fuel Store



General Notes

DO NOT SCALE

Figures dimensions shall be taken in preference to scaled dimensions and any discrepancies or errors are to be referred to the Designer. Contractors, sub-contractors and suppliers must verify all dimensions on site before commencing work or making any fabrication drawings.

Drawing Issue Notes :

Rev

Issue Date

Revision Notes:

A

Project

Deame Valley - Fuel Store

Property Ref

Deame Valley

Drawing Title

Replacement Fuel Store

Revision	Date	June 2021
	Scale	A3 @ 1:100
Drawing No.	Drawn	CE
	Checked	

Preliminary		For Approval	
Planning Issue	X	Building Reg. Issue	
Tender Issue		Construction Issue	
As Built		Furniture Layout Issue	