




west elevation from garden of No 16

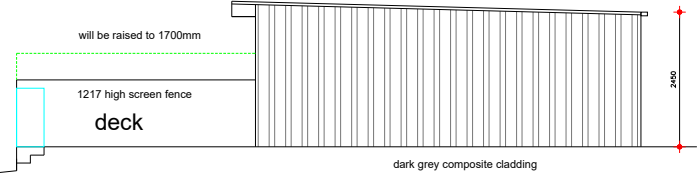


south elevation from NO 14

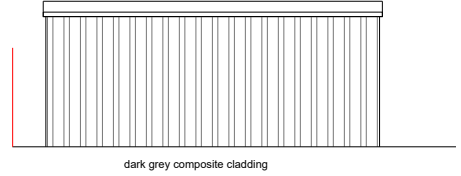

east elevation from rear

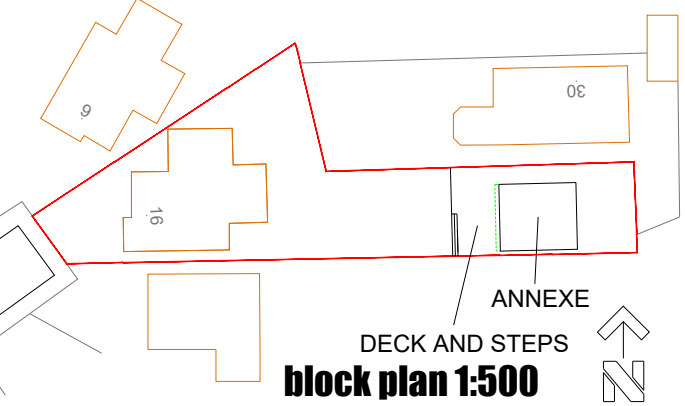


block plan 1:500


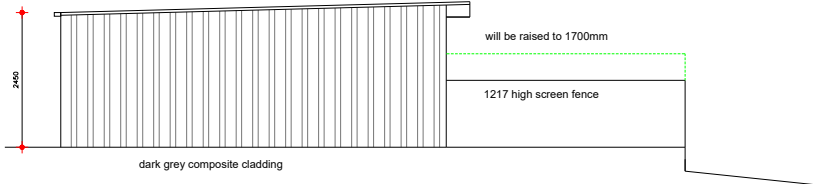


north elevation from NO 30

floor plan 1:100

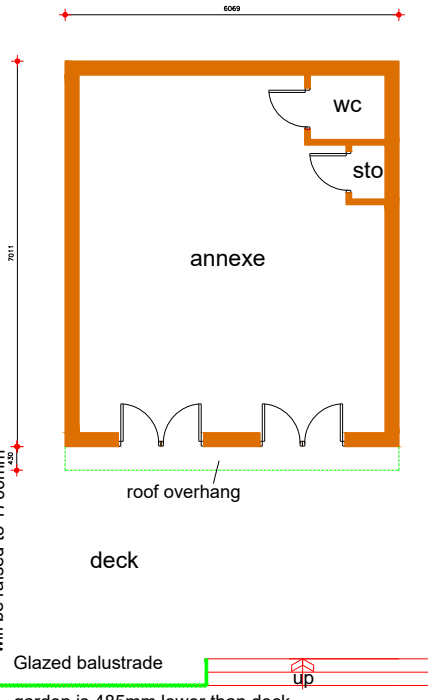

roof plan 1:100

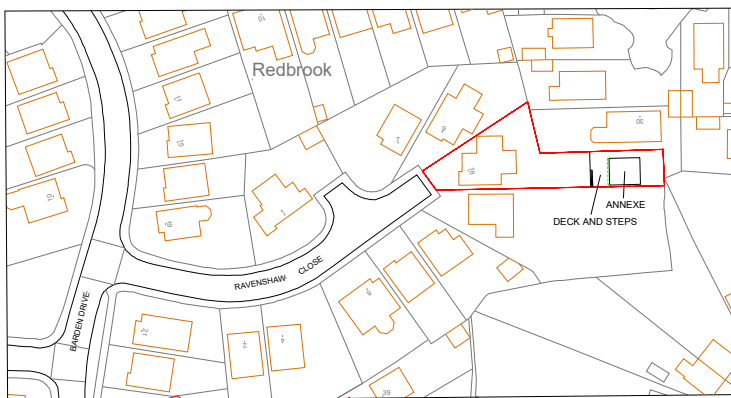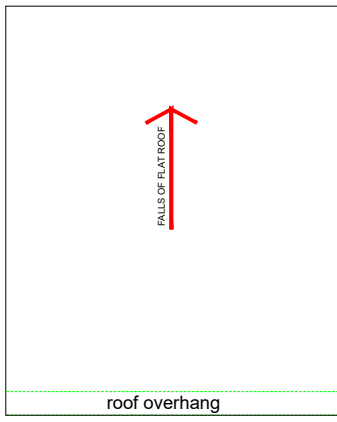

location plan 1:1250

J MURRAY ARCHITECTURE
 4 BROOKSIDE CLOSE, HACKENTHORPE
 SHEFFIELD S12 4LE 0114 247 0602

TITLE
 retrospective consent for
 detached annexe in garden
 16 Ravenshaw Close
 Bamsley S75 2QS
 CLIENT Mr & Mrs J Clarke

As built plans

DATE 31/10/2024 SCALE 1:1250+1:500

DRAWING No.
 c/24/01

REVISION | | | | |