



MR & MRS CHRIS BATLEY


13 BELL BANK VIEW,
BARNSLEY. S705HS

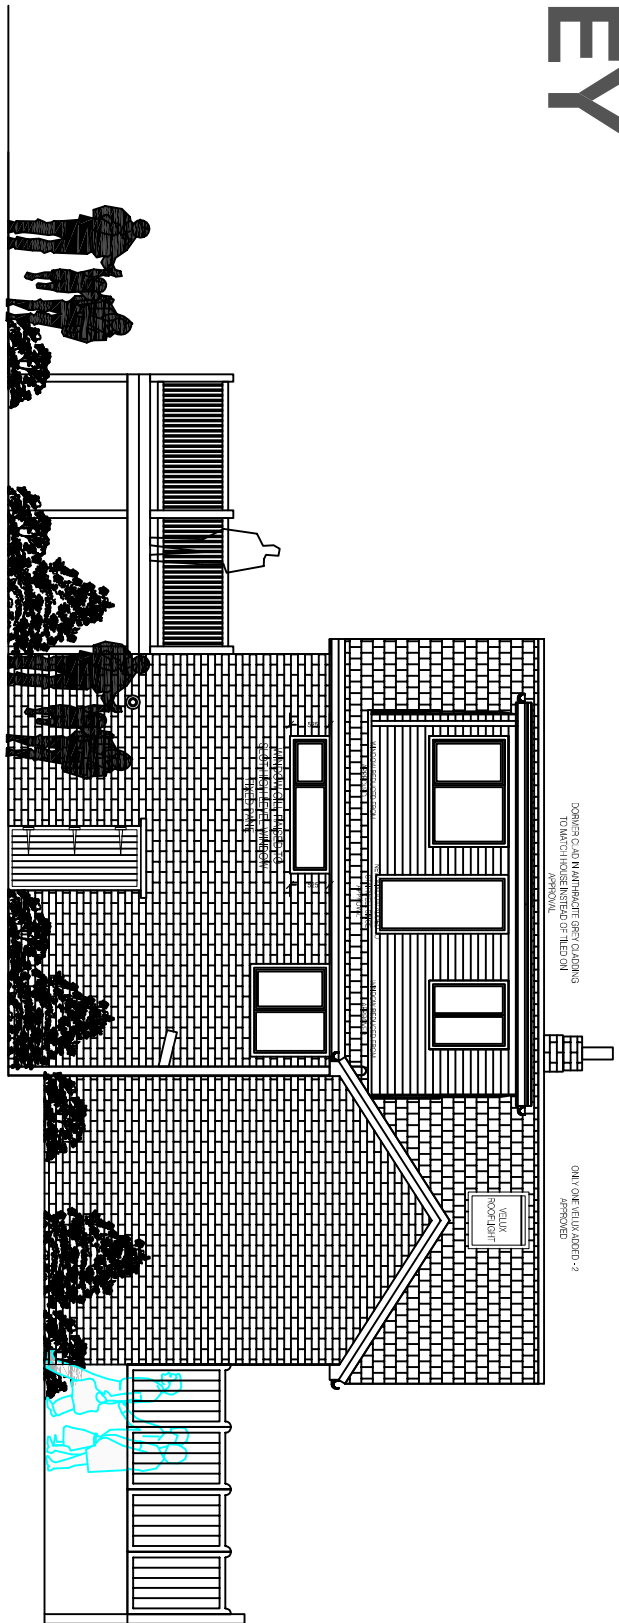



Proposed Rear Elevation

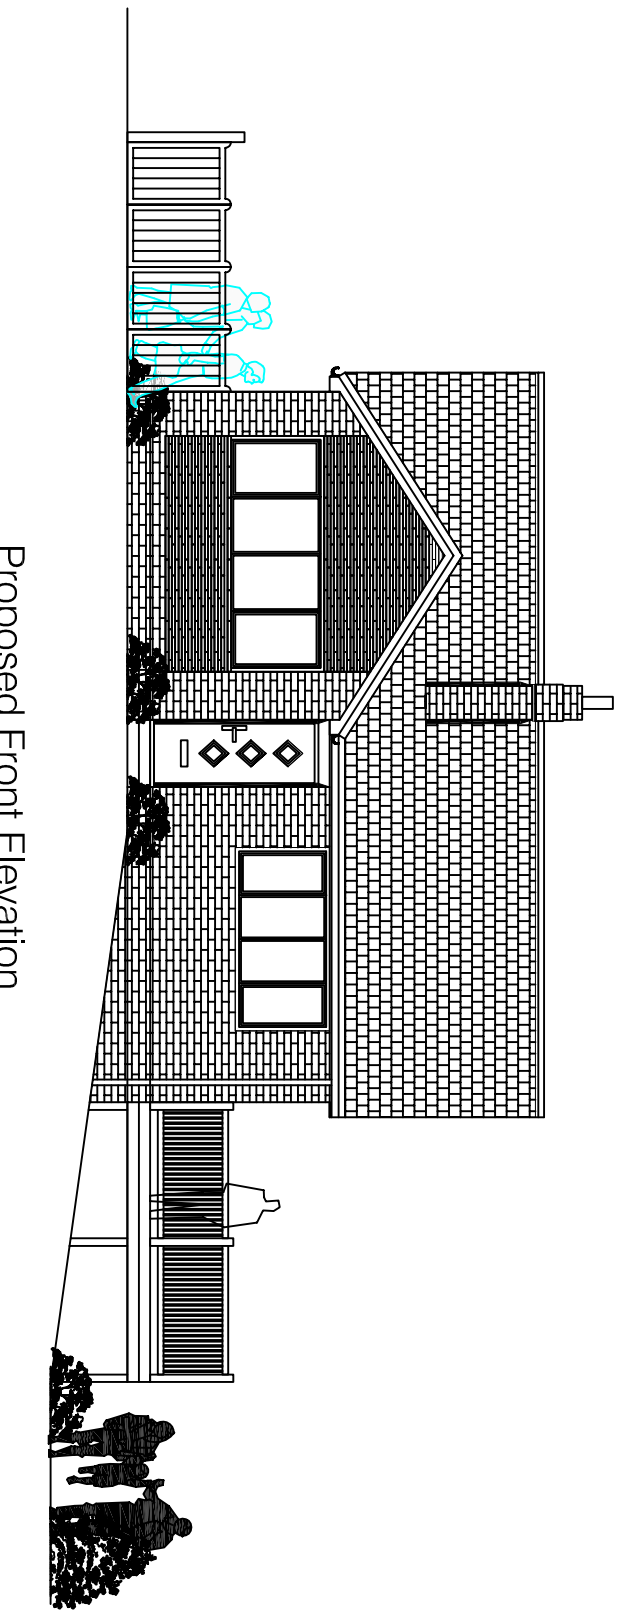


Proposed Front Elevation

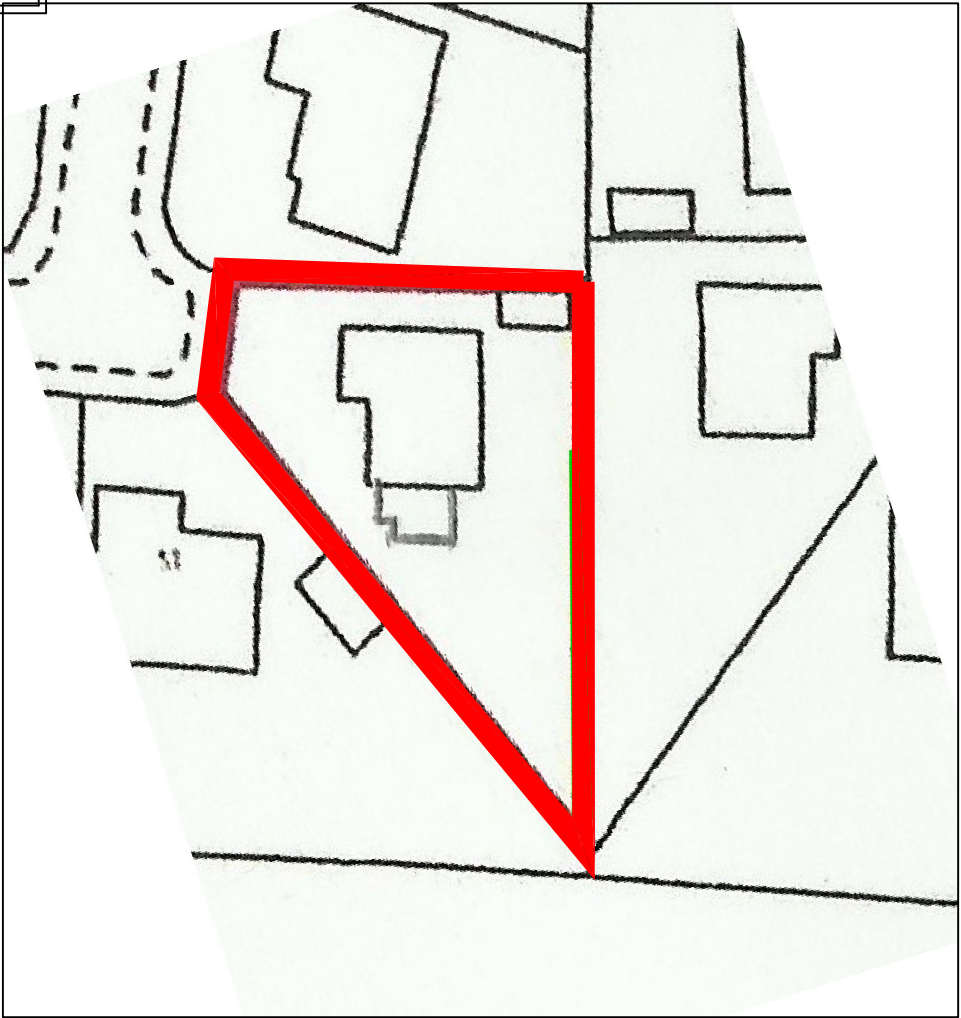


Site location plan
@1:500 scale

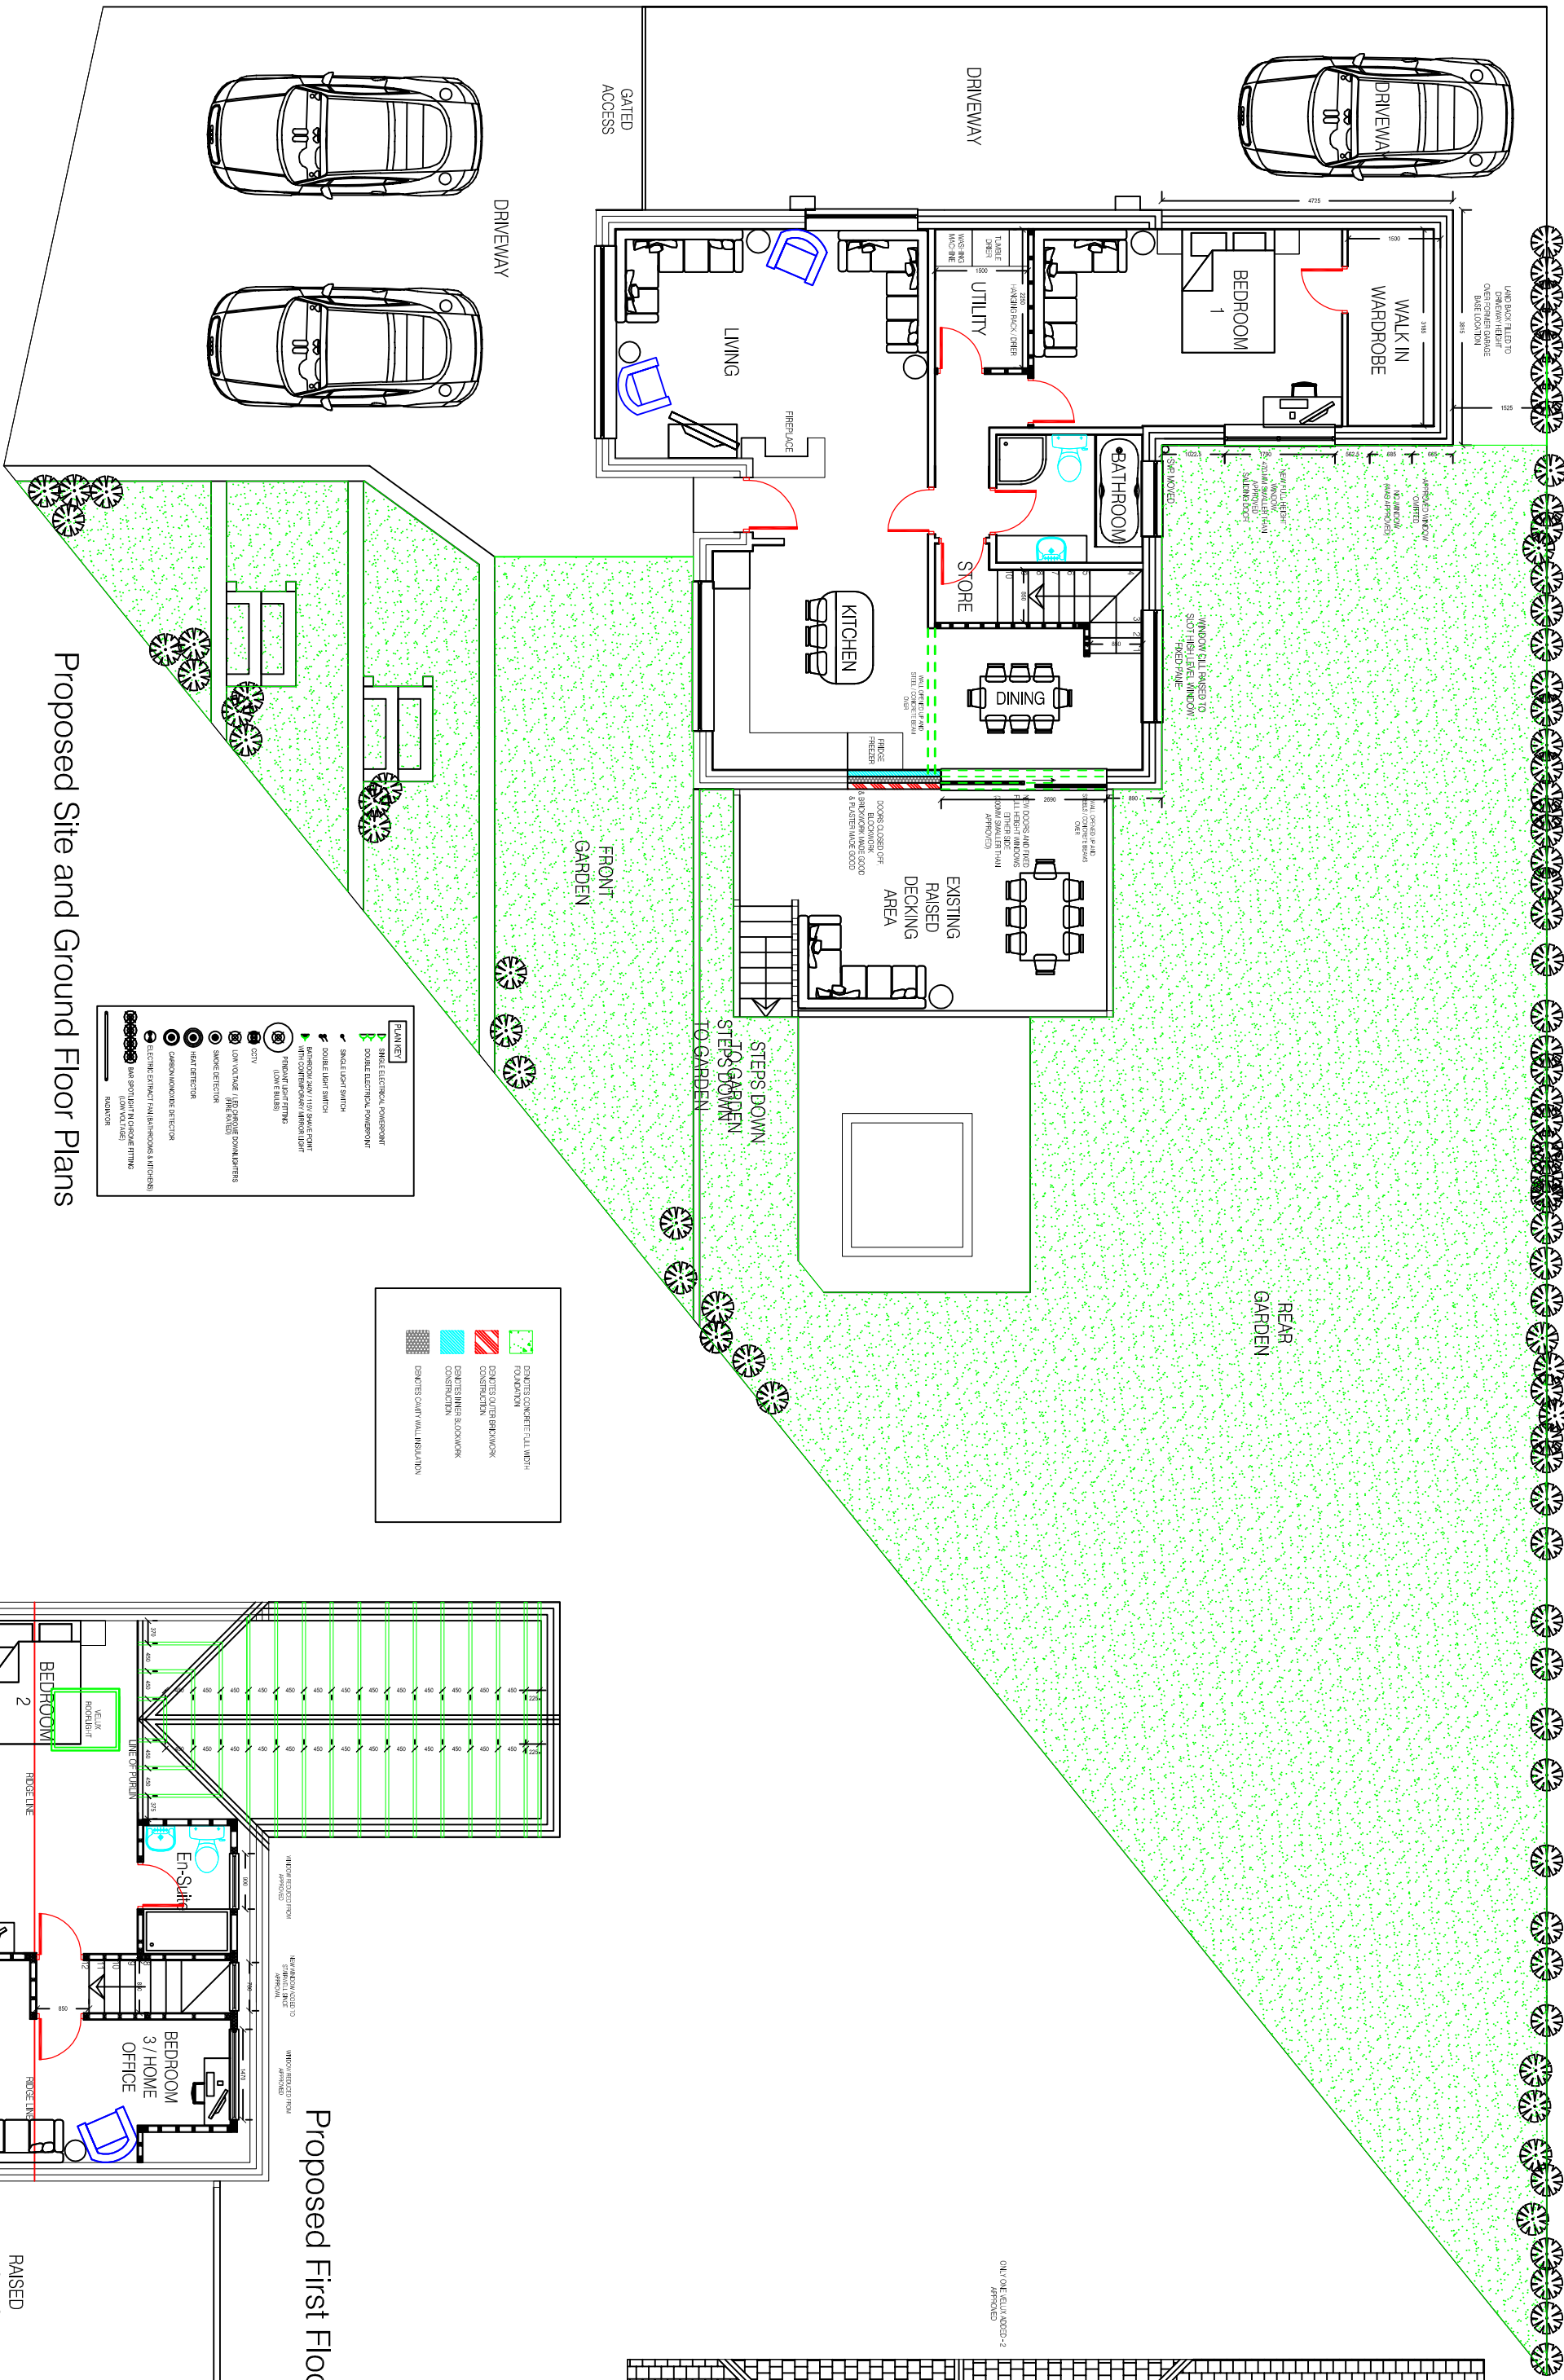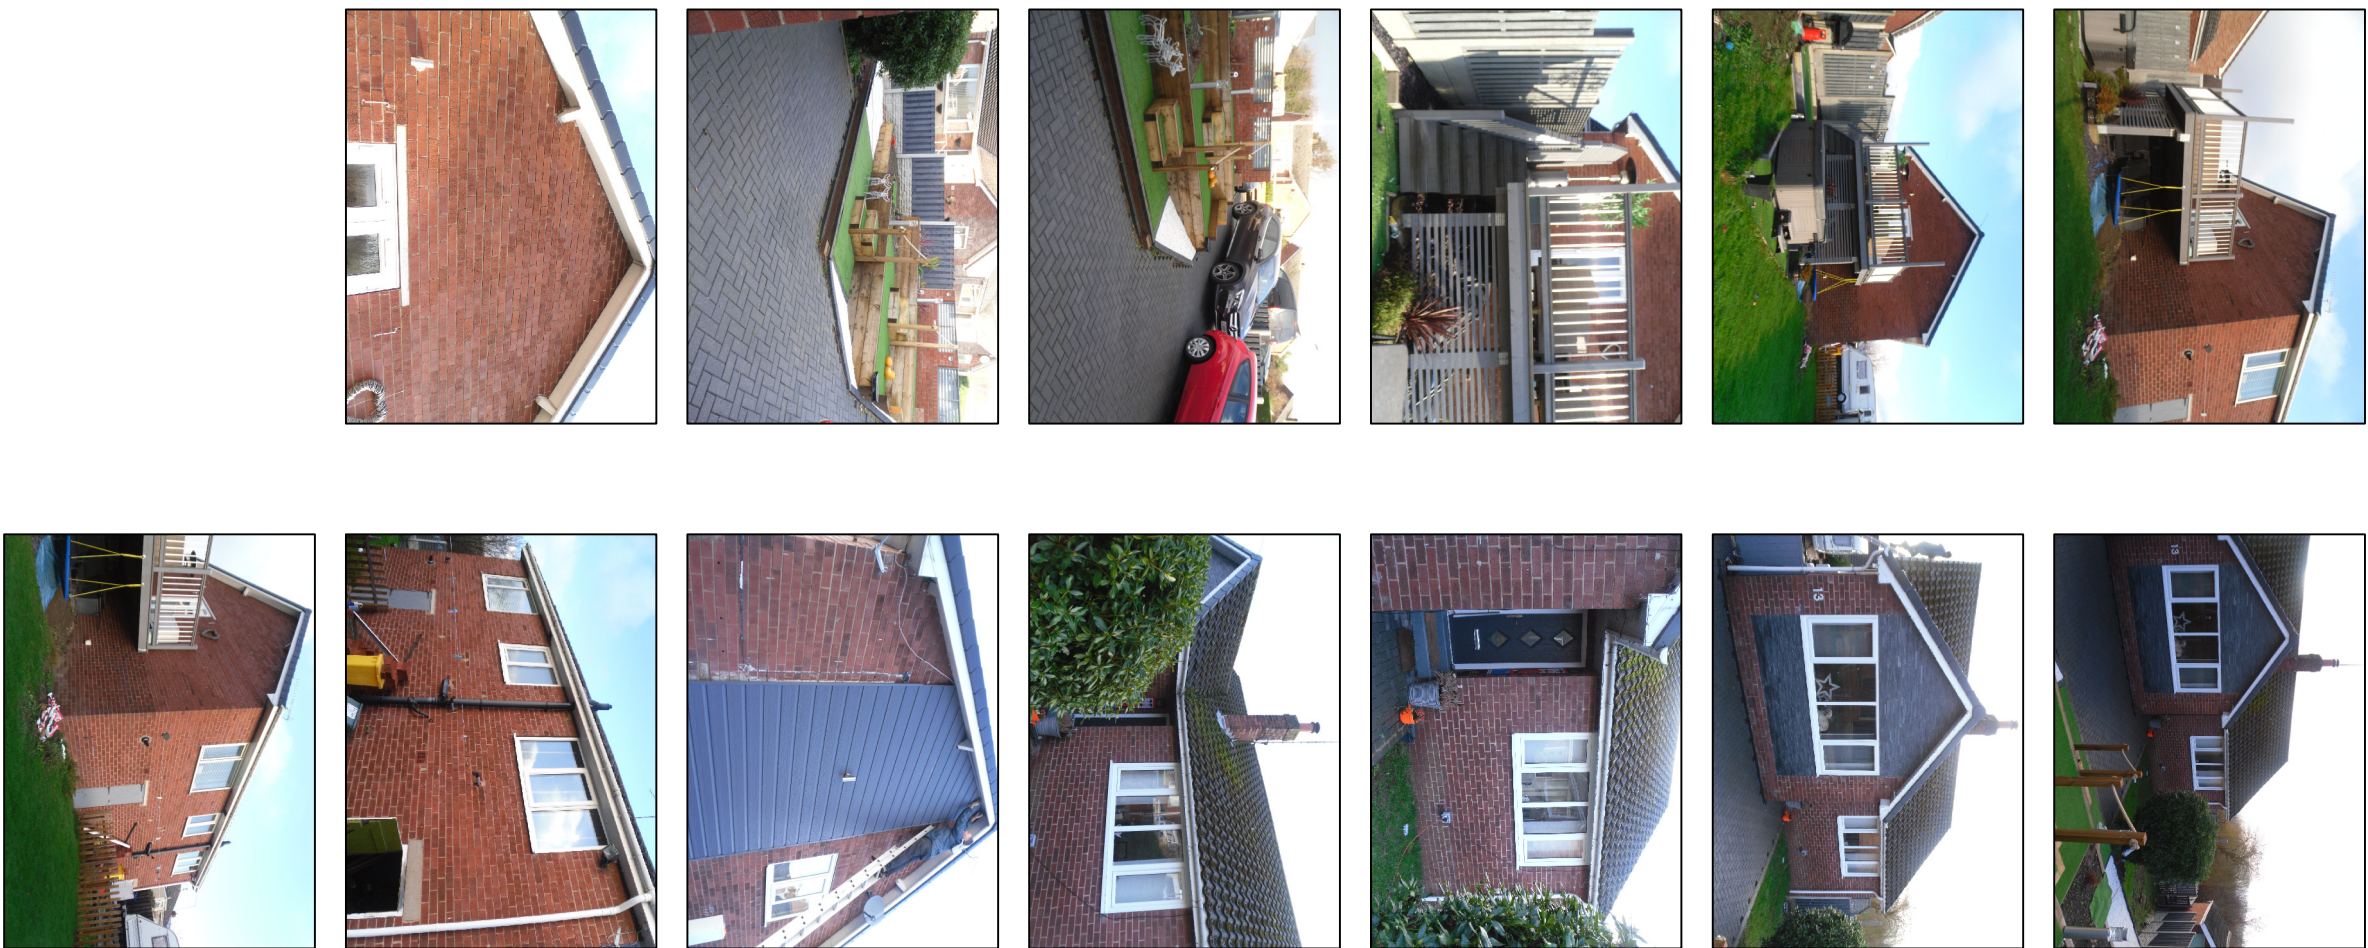


Proposed Site and Ground Floor Plans

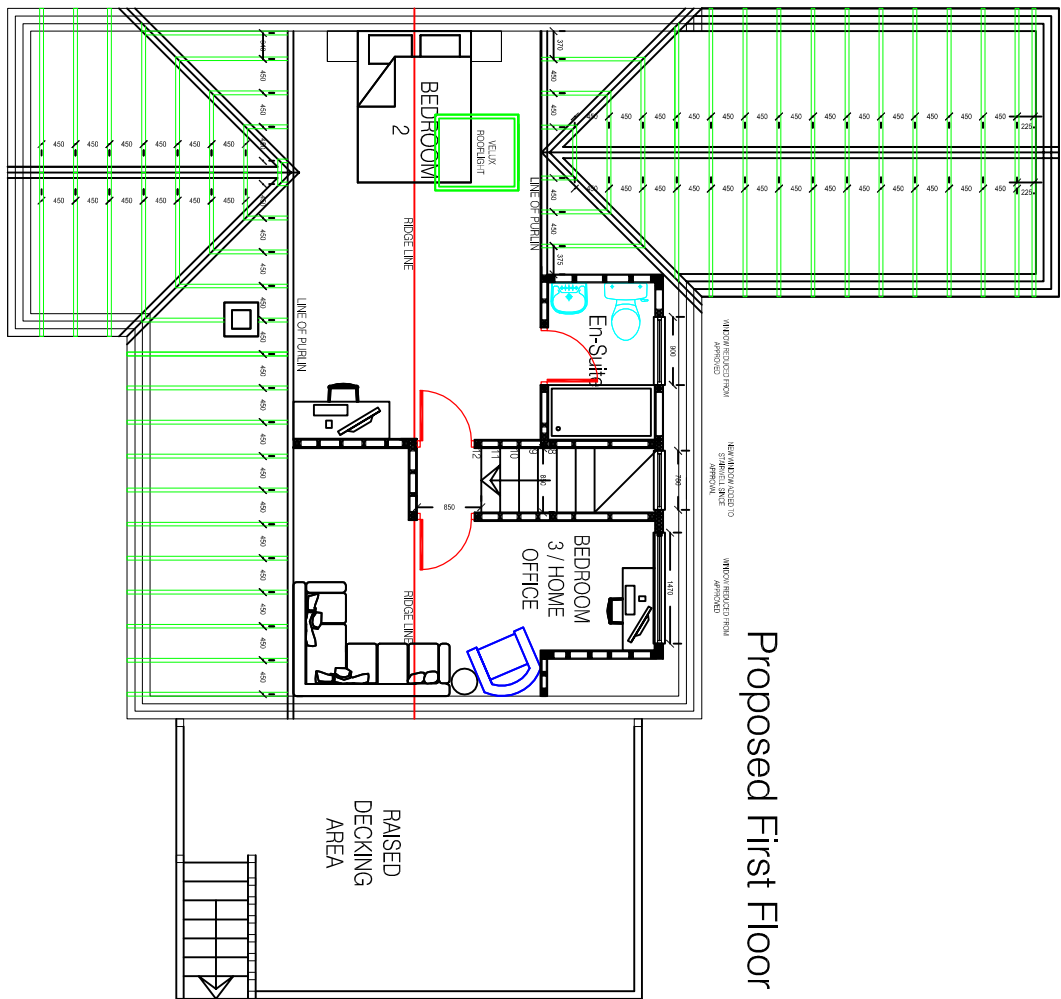


Proposed First Floor Plan

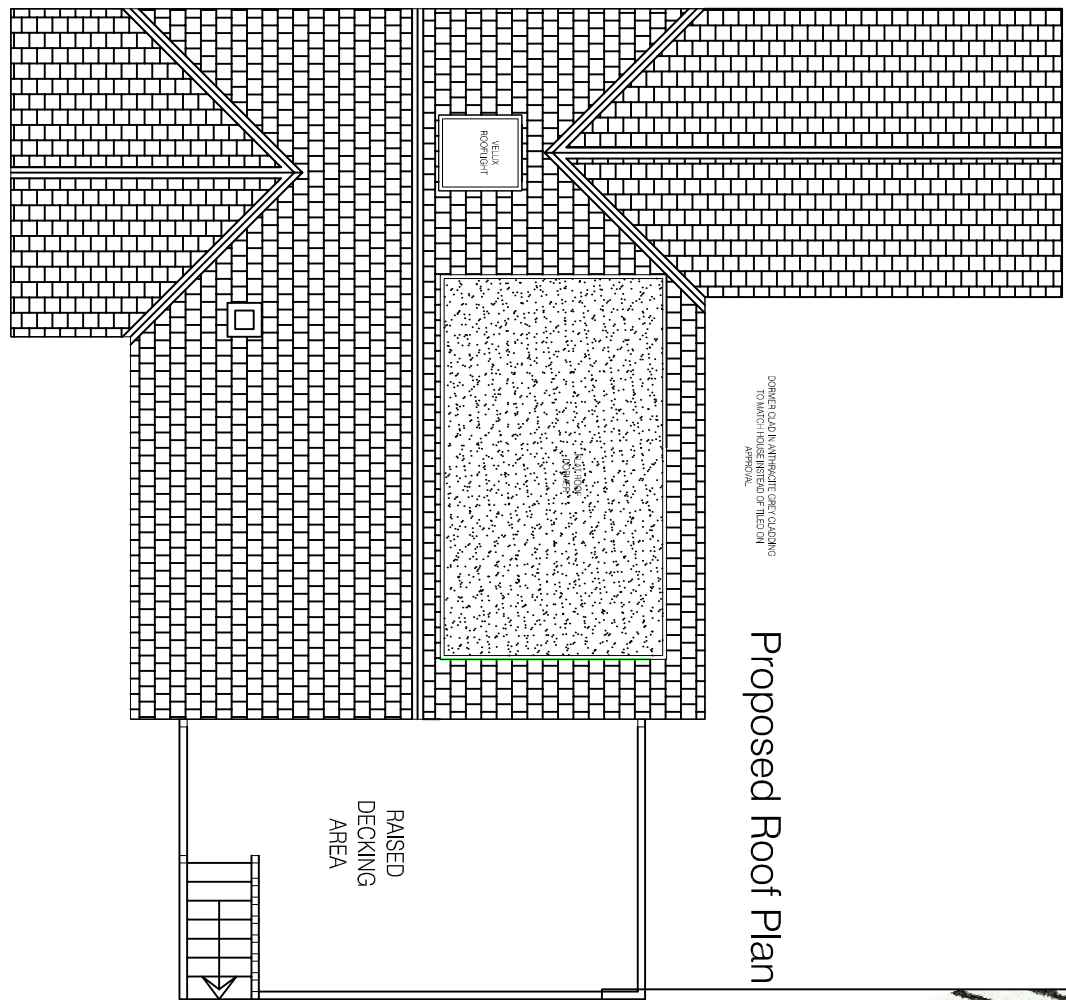


Proposed Roof Plan

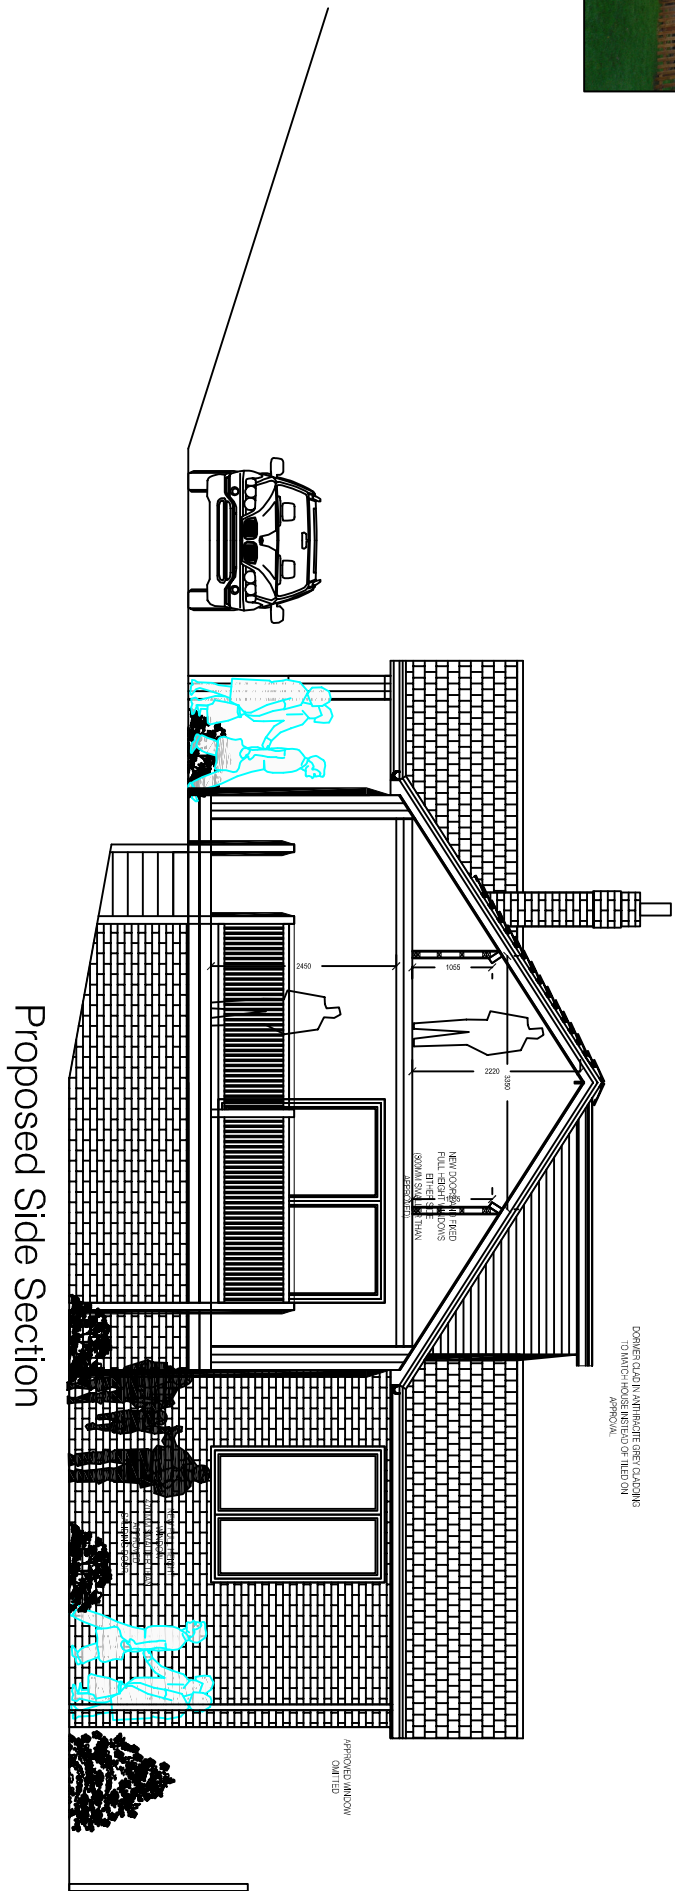

Proposed Side Section

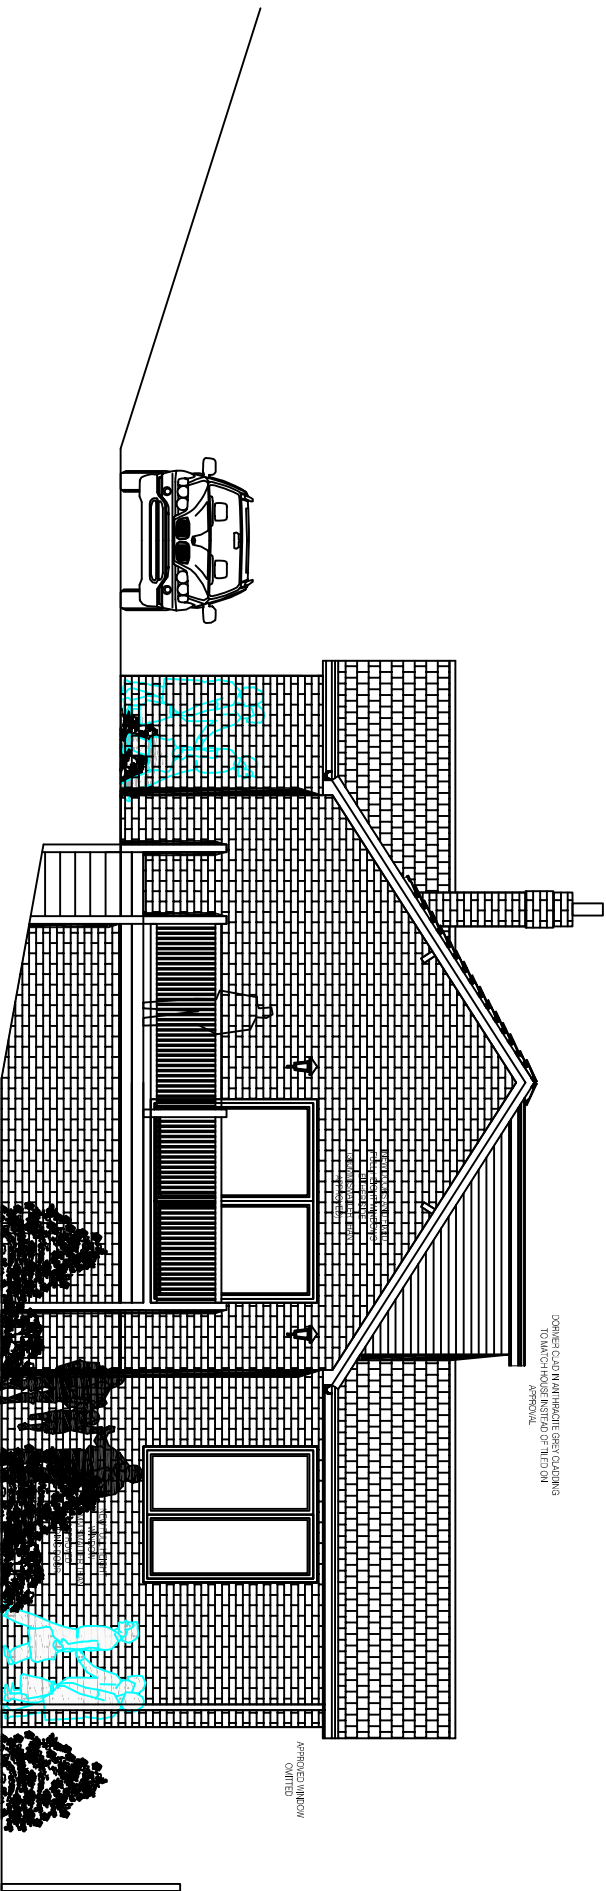

Proposed Side Elevation

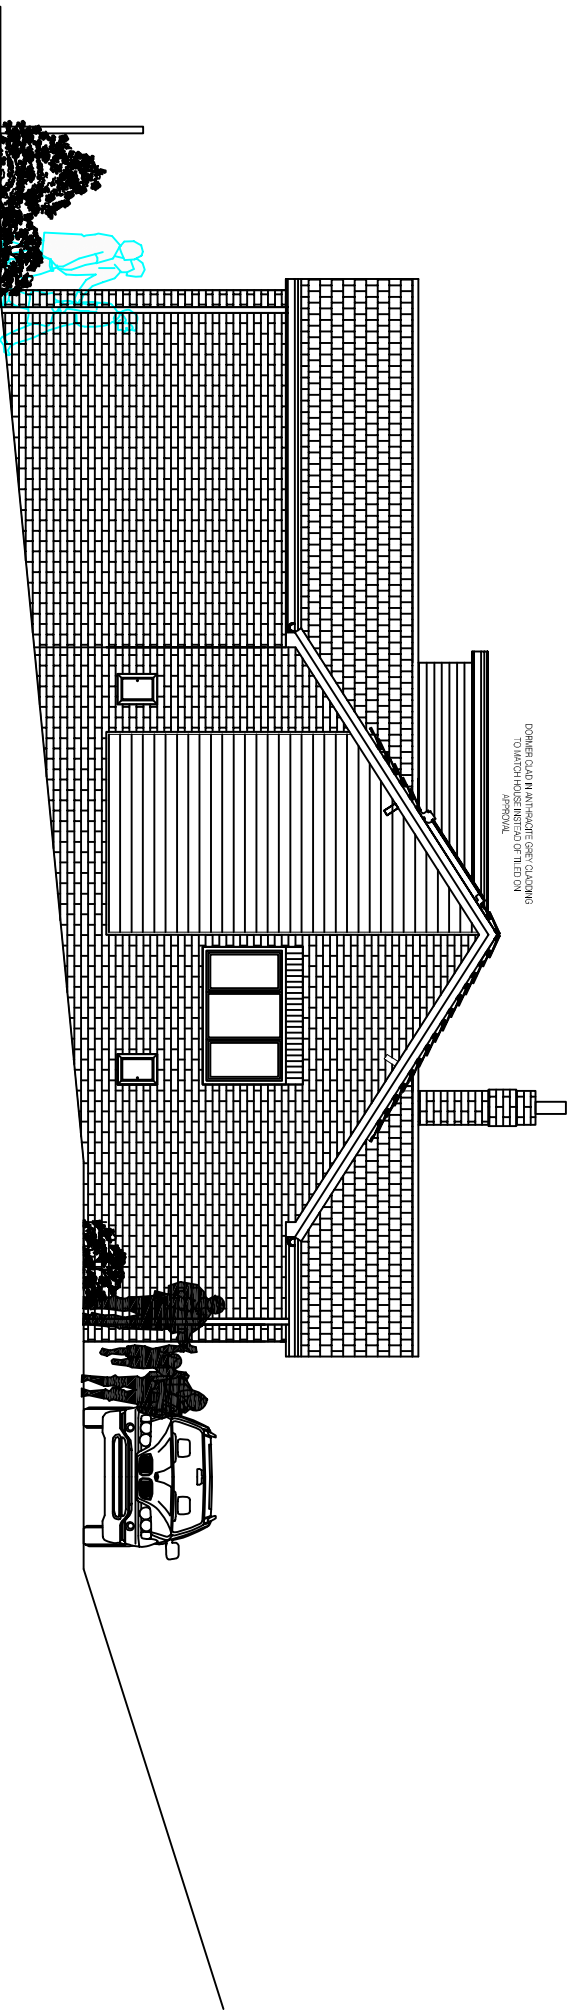

Proposed Side Elevation

REVISION B - AS BUILT
WINDOW AND DOOR REDUCTIONS
AS WELL AS VELUX CHANGE/
REDUCTION AND DORMER CLADDIN
IN ANTHRACITE INSTEAD OF TILED

- Architectural design
- Planning & Building Regulations
- Landscape architecture
- 3D Visualisation & model making

CLIENT
MR. CHRIS. BATLEY

13 BELL BANK VIEW
BARNLSLEY. S70.5HS

DRAWING OF
PROPOSED. EXTENSION. TO DWELLING
SINGLE. TO. REAR. PORCH. ALTERATIONS
LOFT. CONVERSION. WITH. DORMERS
ALONG. WITH. INTERNAL. ALTERATIONS
PROPOSED. PLANS&ELEV. & SITE

drawing no	rev	date
DWG-002	A	NOV-21
scale	drawn	checked by
1:100@.A1	SMT	CB
		checked date
		NOV-21