


ALLOW FOR SUITABLE GROUNDS FOR THE INSTALLATION OF NEW OVERHEAD DOOR HEATER

2nd. INTERNAL ACCESS HATCHES ARE REQUIRED TO BE INSTALLED INTO THE BUILDING TO ACCESS THE ROOF AND TO PROVIDE A MEANS OF EGRESS ON FASCIA SIGN OVERHAUL AND SERVICE EXISTING INTERNAL ROLLER SHUTTER

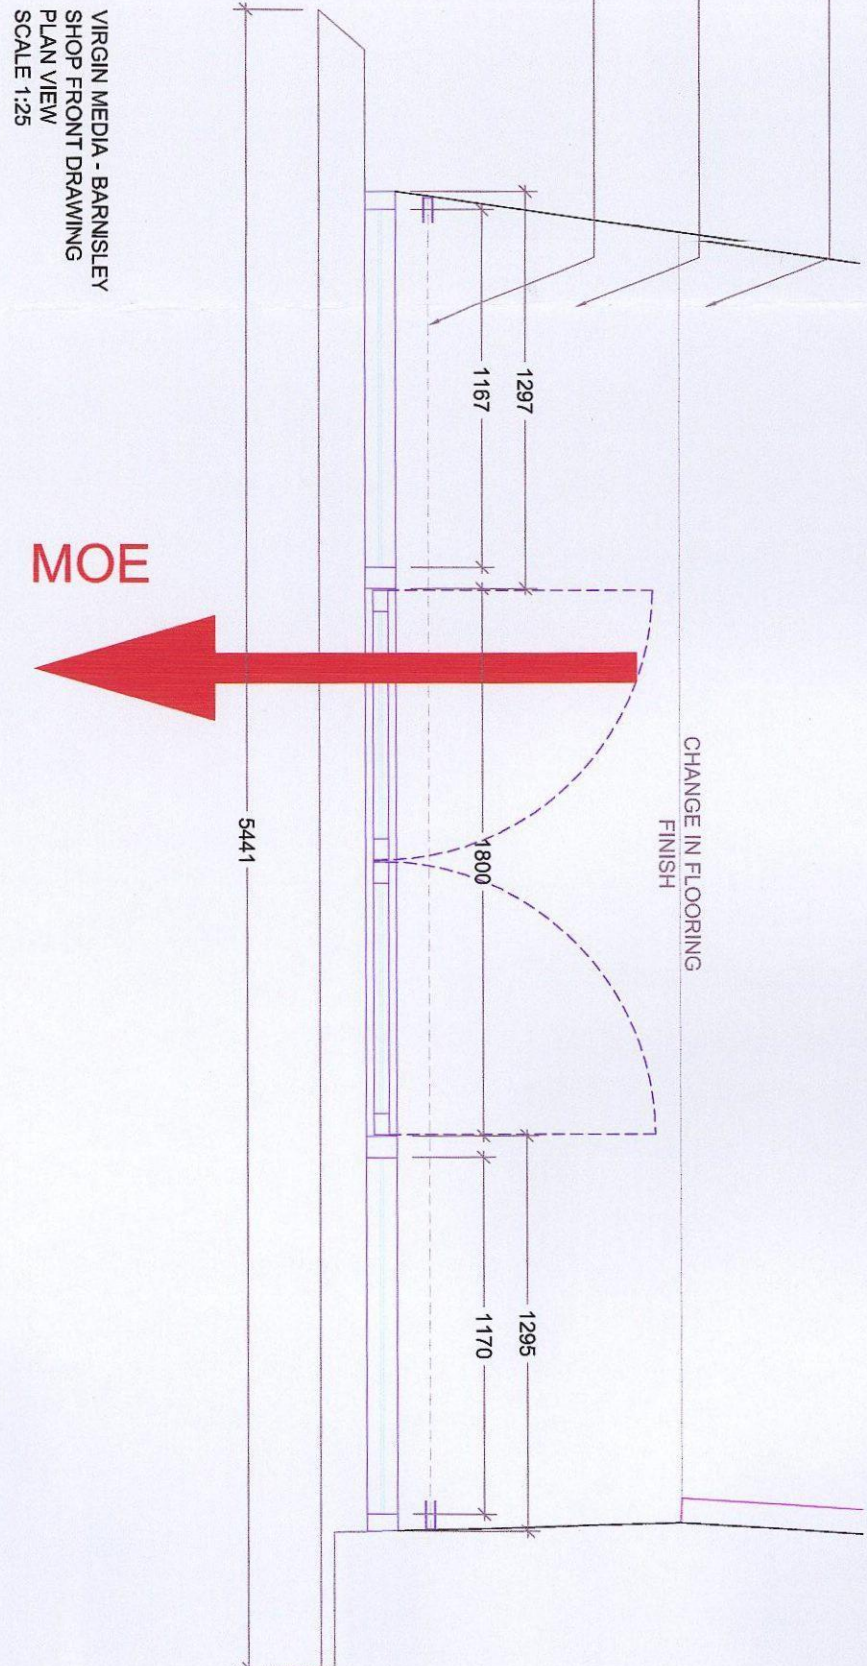

VIRGIN MEDIA - BARNESLEY SHOP FRONT DRAWING PLAN VIEW SCALE 1:25

NEW VIRGIN MEDIA BRANDED BUS STOP SIGN TO BE INSTALLED ONTO FASCIA SIGN AS EXISTING

NOTE: BUS STOP WILL BE A FOLDED ALUMINIUM BOX FINISHED IN RED TO RAL REFERENCE 3020 WITH THE VIRGIN MEDIA LOGO AND TEXT FINISHED IN GRAY ON A ROLLER COAT AND FINISHED THROUGH FRONT FACE OF TRAY

NOTE: VIRGIN MEDIA LOGO AND TEXT ONLY TO BE ILLUMINATED SUPPLY AND INSTALL ANTI PIGEON SPIKES TO TOP OF FASCIA SIGN

NEW VIRGIN MEDIA BRANDED FASCIA SIGN TRAY TO BE INSTALLED ABOVE EXISTING SHOP FRONT

NOTE: FASCIA WILL BE A FOLDED ALUMINIUM TRAY FINISHED IN RED TO RAL REFERENCE 3020 WITH THE VIRGIN MEDIA LOGO AND TEXT FINISHED IN GRAY ON A ROLLER COAT AND FINISHED THROUGH FRONT FACE OF TRAY

NOTE: VIRGIN MEDIA LOGO AND TEXT ONLY TO BE ILLUMINATED SUPPLY AND INSTALL ANTI PIGEON SPIKES TO TOP OF FASCIA SIGN

DOTTED LINE DENOTES THE HEIGHT OF INTERNAL BLINDHEAD THAT SITS OVER SHOP FRONT FRAME WORK AND GLAZING VINYL ON FRONT FACE OF GLAZING TO BE REPLACED WITH WHITE VINYL AND TO LINE THROUGH WITH RAIL ABOVE DOOR

VIRGIN MEDIA WINDOW MANIFESTATIONS TO BE INSTALLED TO AT HEIGHTS ILLUSTRATED ON DRAWINGS

NOTE: WINDOW MANIFESTATIONS BASED ON NEW LOGO

SUPPLY NEW LOCK BARRELS TO ELECTRIC SHUTTER SWITCHES (INTERNAL & EXTERNAL) SUPPLY 6mm KEYS

EXISTING FINISH ON SHOP FRONT TO BE RETAINED TOUCHED IN WHERE APPROPRIATE


NOTE: ALL EXISTING SHOP FRONT LOCKS ARE TO BE REPLACED WITH SHUTTER CONTROL BOX

REPLACE ALL EXISTING GREY TILES FORMING PART OF SHOP FRONT WITH BLACK CERAMIC TILES


INSTALL NEW SS THRESHOLD STRIP ACROSS DOUBLE DOOR ENTRANCE

INTERNALLY POSITIONED DIGITAL POS SCREEN SHOWN AS RED DOTTED LINE - SUPPLIED BY ESPRIMO THIS IS SHOWN WITHOUT LED BACKLIGHT


VIRGIN MEDIA - BARNESLEY SHOP FRONT DRAWING FRONT ELEVATION SCALE 1:25

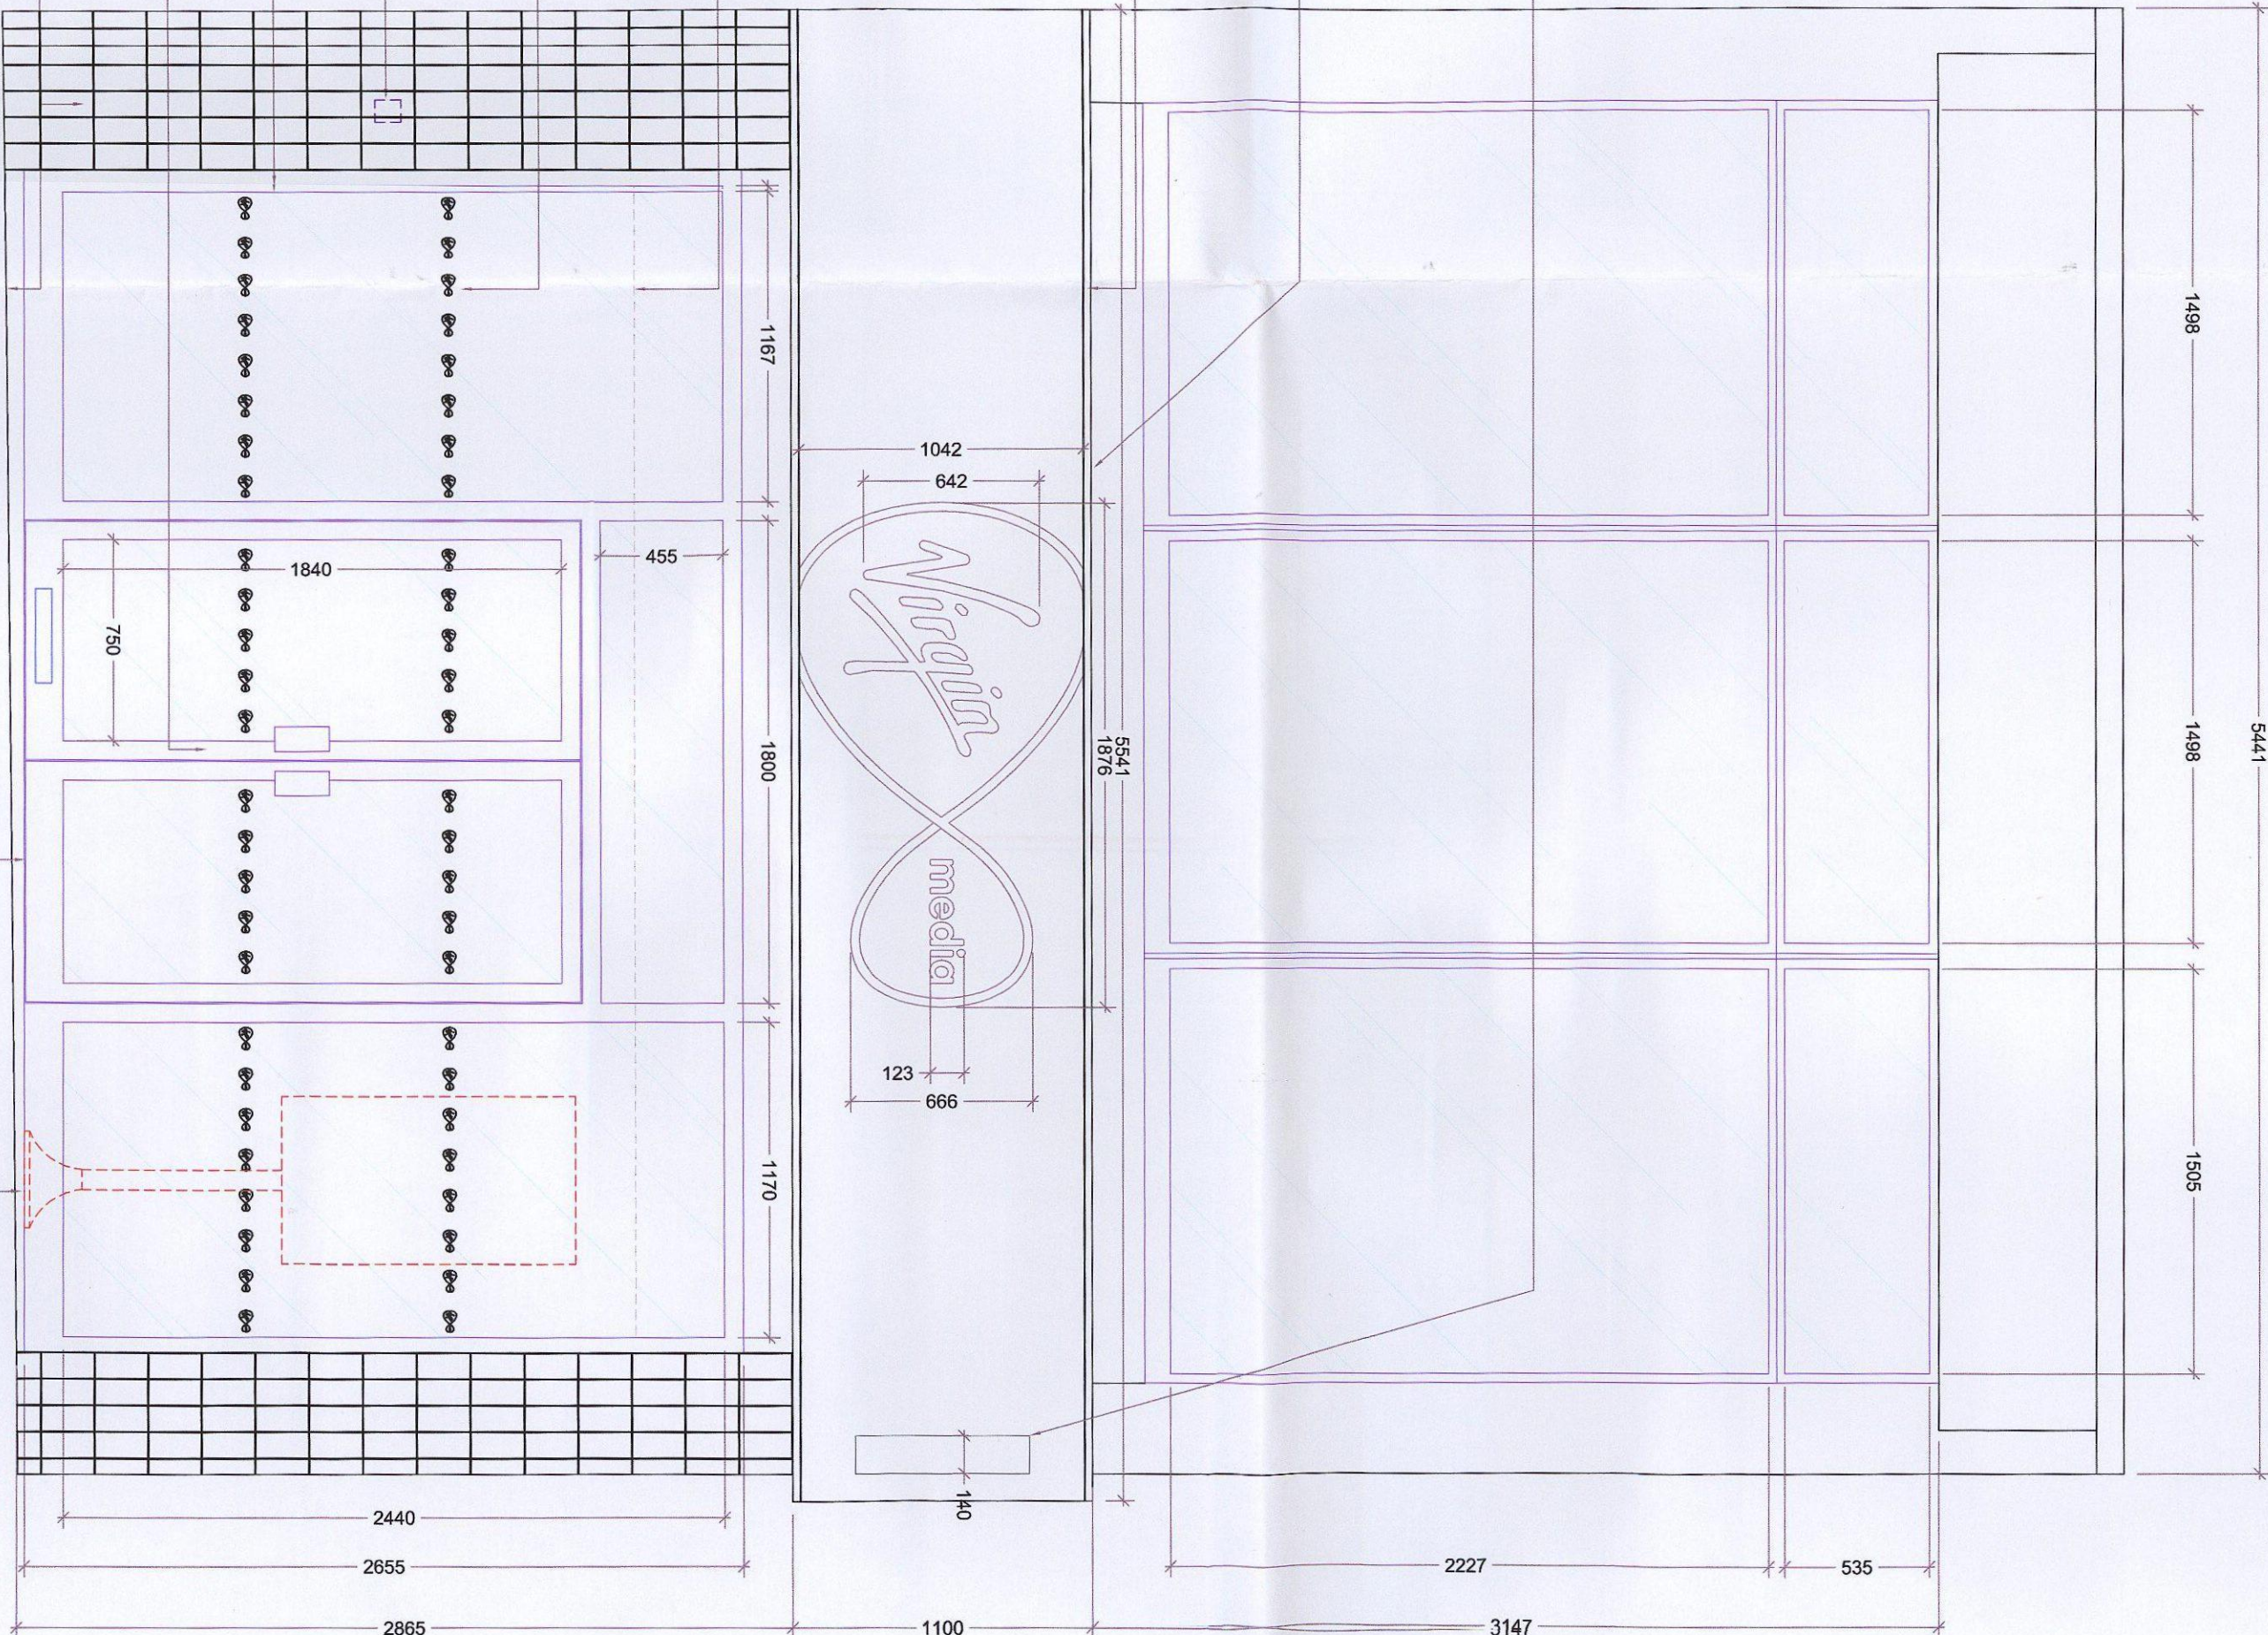



VIRGIN MEDIA - BARNESLEY SHOP FRONT DRAWING SIDE/SECTIONAL ELEVATION SCALE 1:25

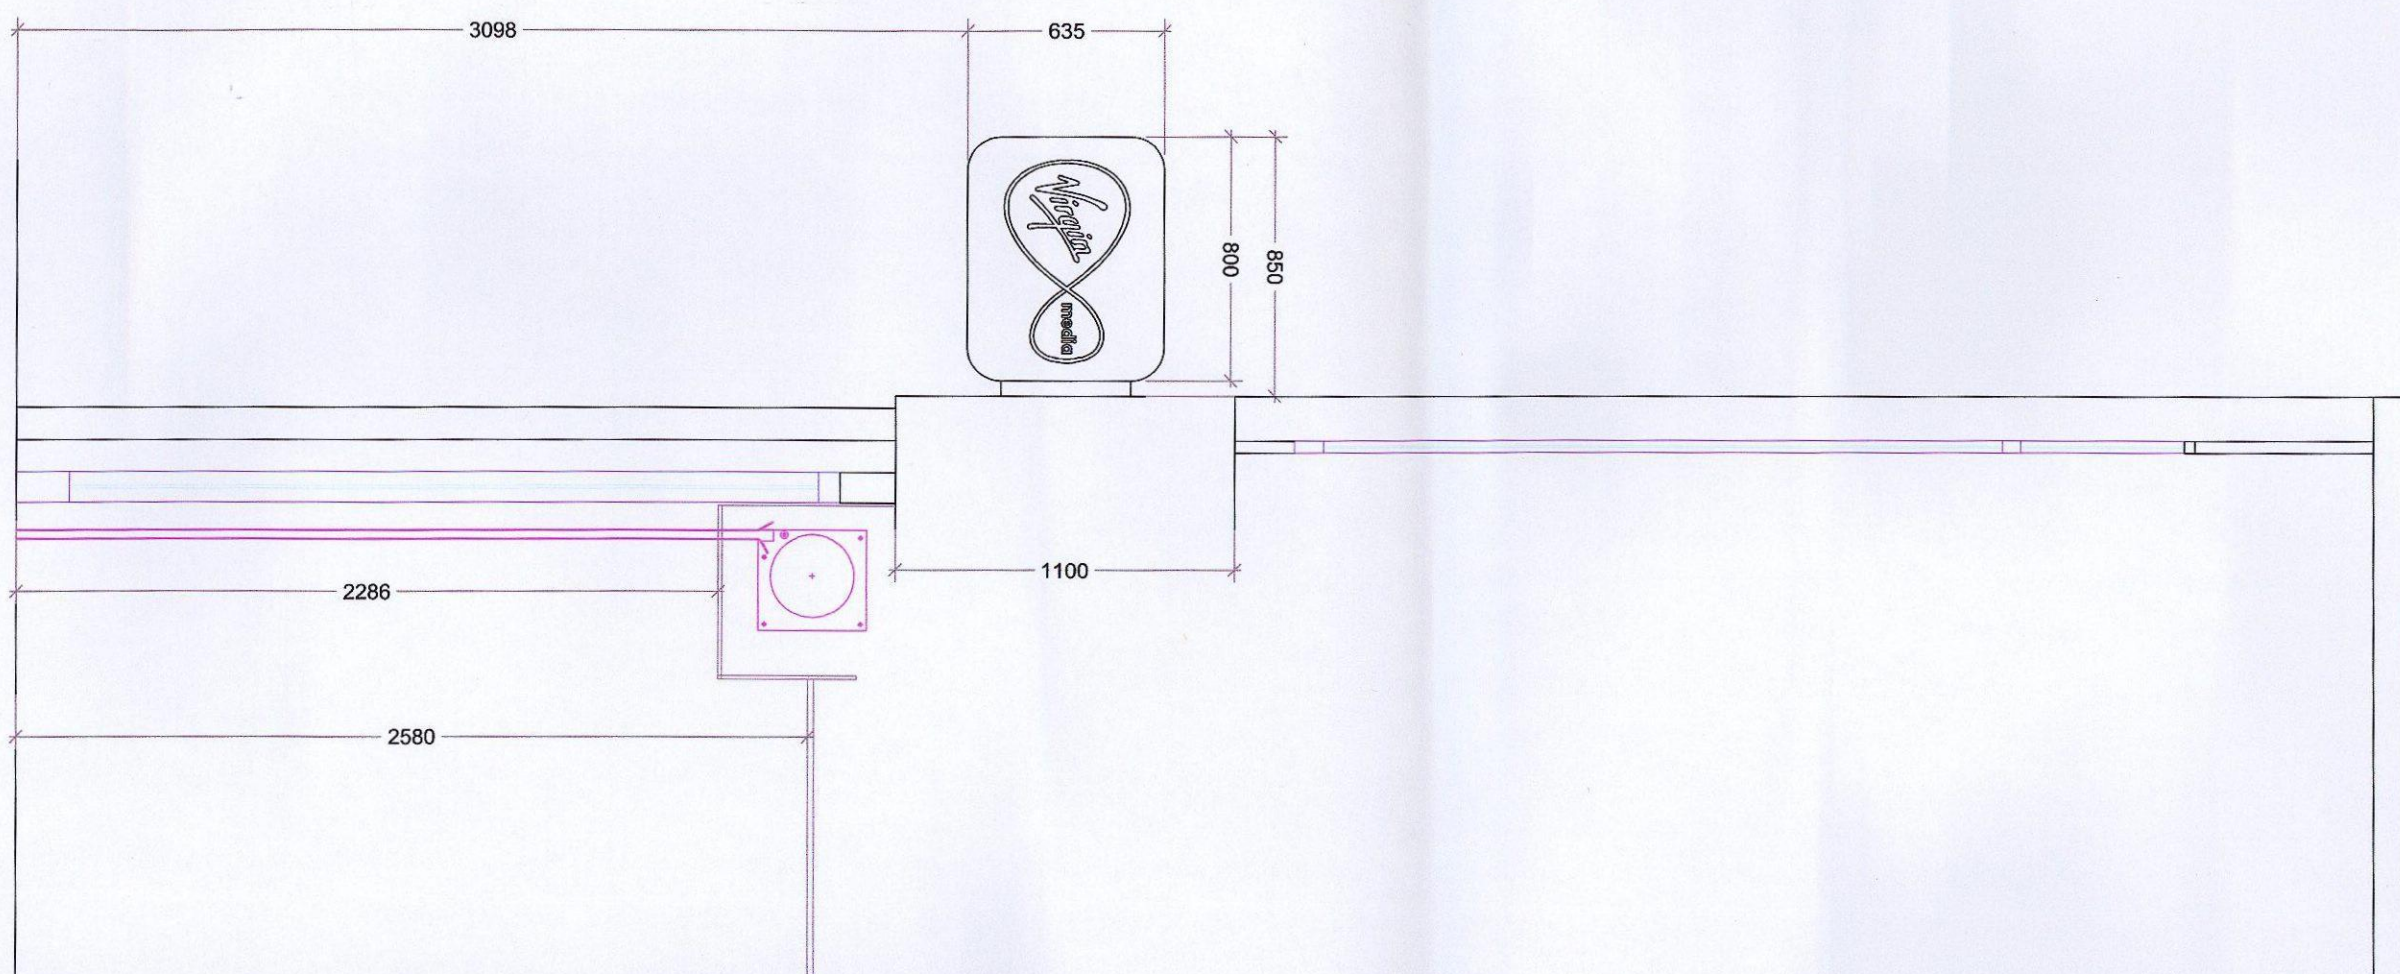

VIRGIN MEDIA BARNESLEY PROPOSED NEW FASCIA SIGN FRONT ELEVATION SCALE 1:25

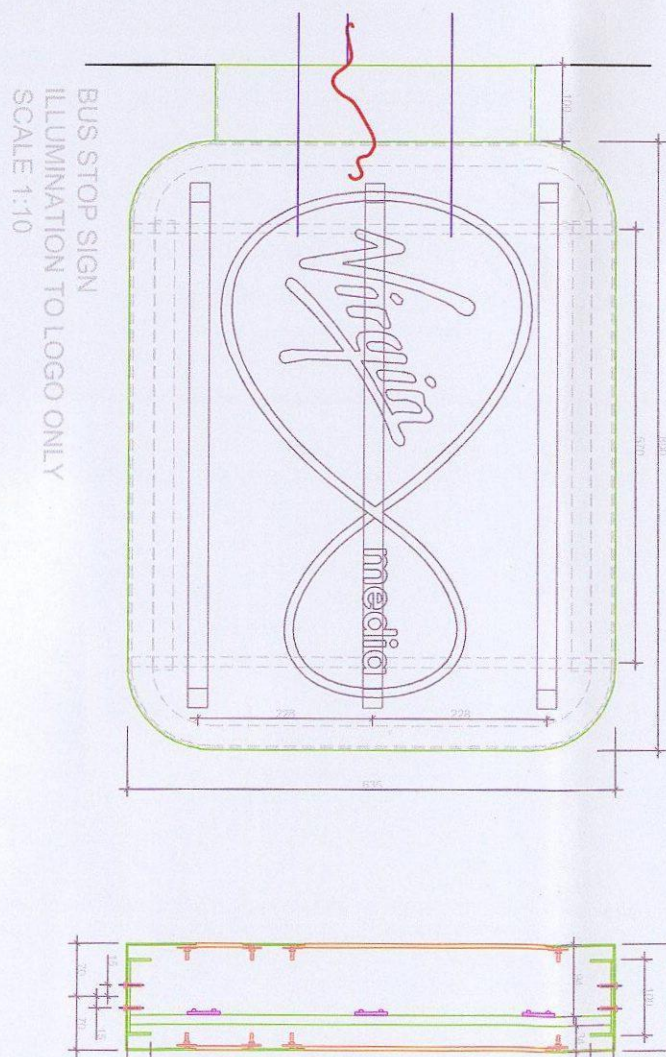

BUS STOP SIGN ILLUMINATION TO LOGO ONLY SCALE 1:10

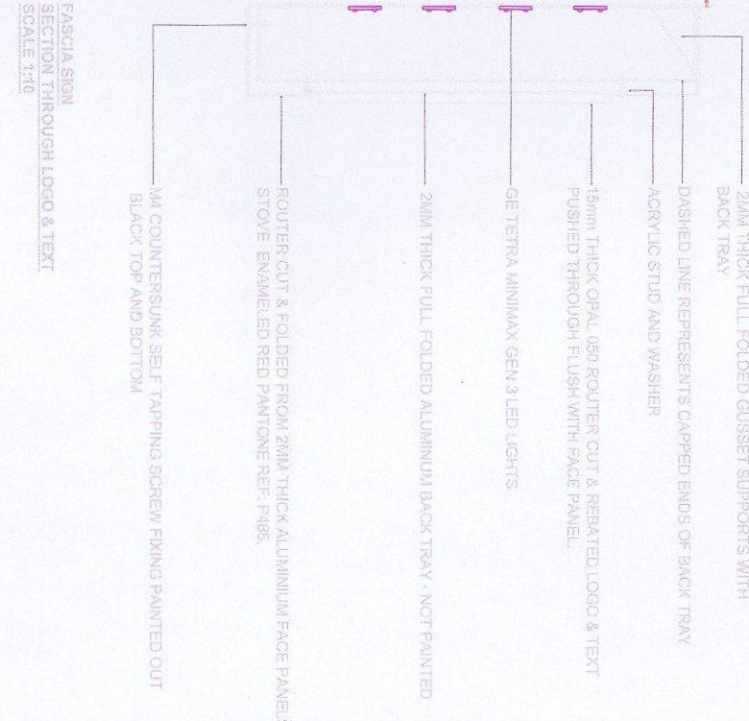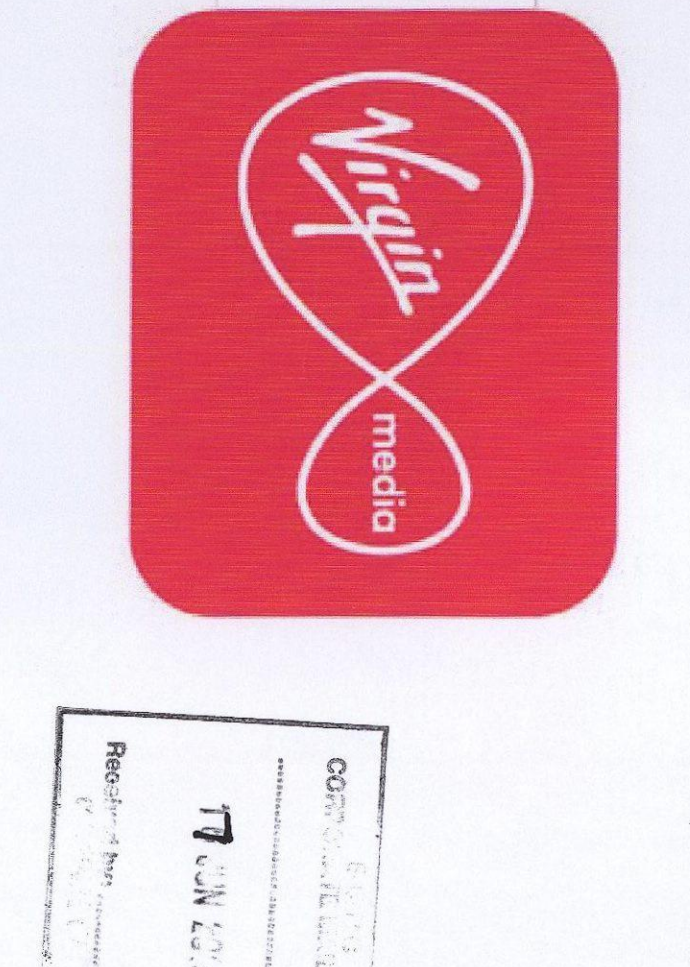

Client	VirGIN MEDIA	Project	VirGIN MEDIA BARNESLEY SHOP FRONT DRAWING
Status	AS BUILT	Drawn by	CG
Date	16.05.15	Scale	1:25 @ A1
Rev	CG	Shop front notation amended. Tiles added to DWG.	
Rev	CG	Shop front notation amended.	
Rev	INT	Shop front detail amended.	
Rev	INT	Details	
Date	14.04.15		
Date	14.04.15		