


Side (S.East) Elevation
As Proposed

Front (N.East) Elevation
As Proposed

Side (N.West) Elevation
As Proposed

Rear (S.West) Elevation
As Proposed

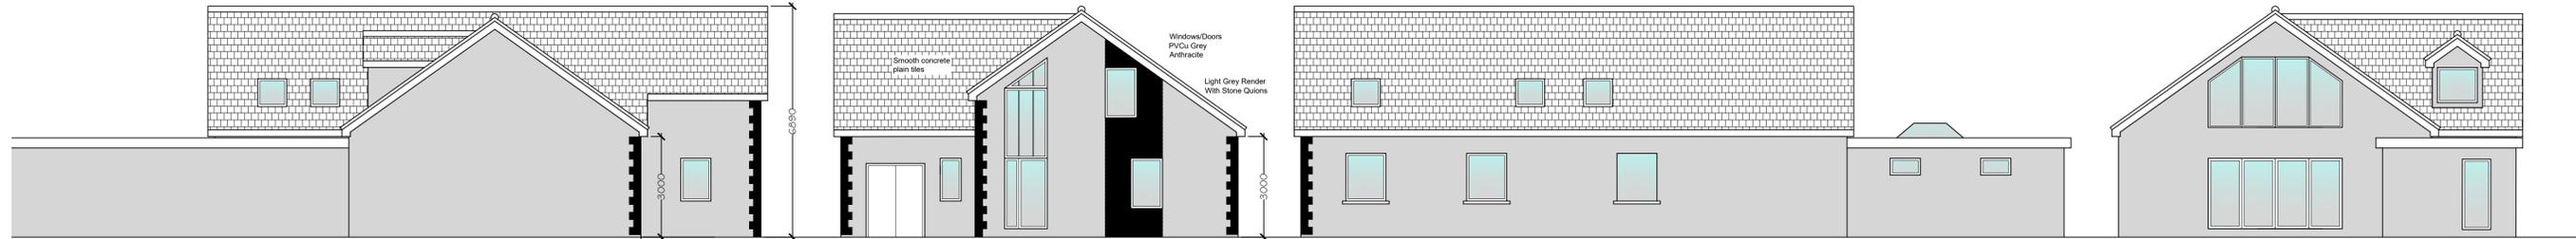


Side (S.East) Elevation
As Approved

Front (N.East) Elevation
As Approved

Side (N.West) Elevation
As Approved

Rear (S.West) Elevation
As Approved

0 0.51m 2m 5m
1:100

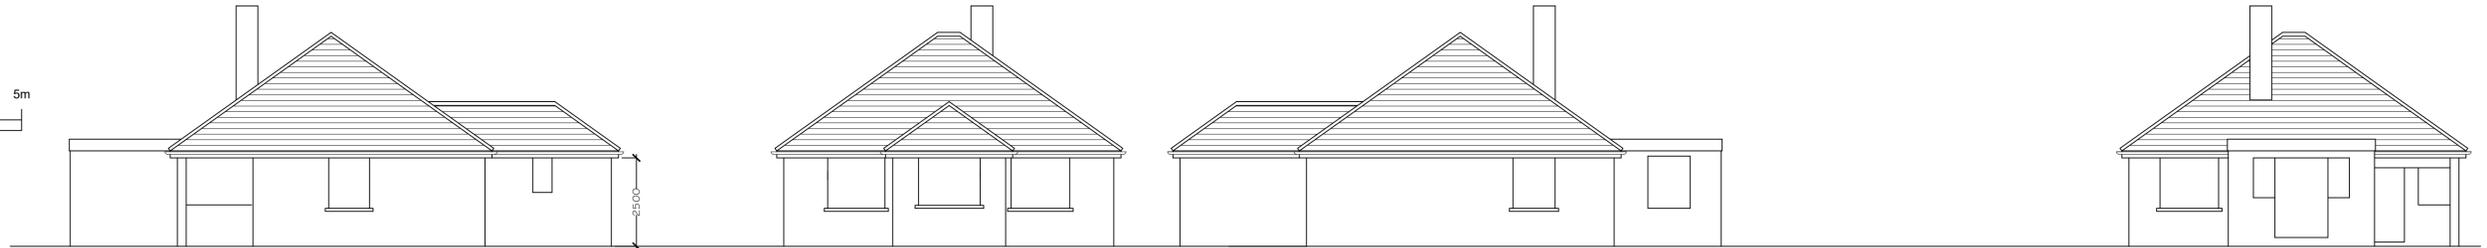

Side Elevation
As Existing

Front (N.East) Elevation
As Existing

Side (N.West) Elevation
As Existing

Rear (S.West) Elevation
As Existing


Best and Easiest Planning Site




Bungalow, 128, Intake Lane, Gawber, Barnsley, S75 2HX




is bounded by: 432556.31, 406820.27, 432697.74, 406961.69 (at a scale of 1:1250), OSGridRef: SE3262 689. The representation of a road, track or path is no indication of features as lines is no evidence of a property boundary.
© 2019 from the Ordnance Survey National Geographic Database and incorporating surveyed revision available at this date. Reproduction in whole or part is prohibited without the permission of Ordnance Survey. Ordnance Survey is a licensed Ordnance Survey partner (100053143). Unique plan reference: 400393X.
The OS Symbols are registered trademarks of Ordnance Survey, the national mapping agency of Great Britain. Buy A Plan logo, pdf design and the www.bouys.com logo.

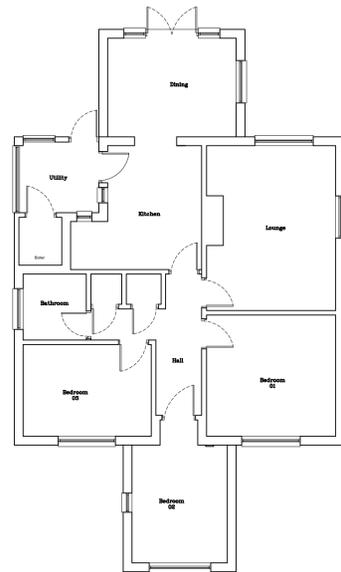

Ground Floor Plan
As Existing

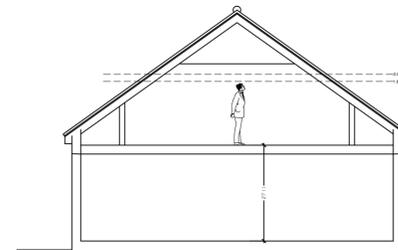

Section
As Proposed

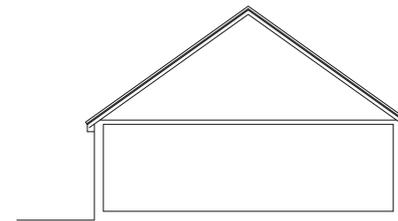

Section
As Existing

0 10m 20m 50m
1:1250

Location Plan



Phone 0113 8314 079 Email info@ckdesign.co.uk
www.ckarchitectural.co.uk
15 Queens Square, LS2 8AJ Leeds
Commercial/Residential, Extensions, Roof Conversions
New Builds, Site Layouts, Site/Project Management etc.

CLIENT
Mr & Mrs Sutton
128 Intake Lane
Barnsley
S75 2HX

PROJECT TITLE
Amendment to Approved Proposed
Roof Lift with Front, Side and Rear
Extensions

DRAWING TITLE
Existing & Proposed Elevations
Existing Floor and Location Plan

DRAWING PHASE
 Design
 Planning
 Preliminary Building Regulations
 Building Regulations
 Construction
 As Built

SCALE	DATE	DRN	
Various @ A1	13/02/19	CPL	
DATE	NOTES	BY	REV
13/02/19	Planning Submission	CL	A
03/05/19	Planning Amendments	CL	B
13/08/19	Amendments to approval application	CL	C

Project no:
S75-1417

Drawing no:
001

Rev
C